

TEMPORARY 100mm WHITE LINE, PAINT
 DURABLE 100mm WHITE LINE, THERMOPLASTIC
 STA 2+560 TO 2+573 SOLID RT NO PARKING
 STA 2+560 TO 2+586 SOLID LT EDGE LINE
 STA 2+588 TO 2+594 SOLID RT NO PARKING
 STA 2+588 TO 2+688 SOLID LT EDGE LINE
 STA 2+594 TO 2+606 SOLID RT PARKING
 STA 2+613 TO 2+626 SOLID RT PARKING
 STA 2+633 TO 2+645 SOLID RT PARKING
 STA 2+651 TO 2+657 SOLID RT PARKING
 STA 2+657 TO 2+682 SOLID RT EDGE LINE
 STA 2+682 TO 2+688 SOLID RT NO PARKING
 STA 2+686 TO 2+689 SOLID LT EDGE LINE (PLEASANT ST)
 STA 2+689 TO 2+693 SOLID LT EDGE LINE (PLEASANT ST)
 STA 2+691 TO 2+698 SOLID RT NO PARKING
 STA 2+695 TO 2+720 SOLID LT EDGE LINE
 STA 2+698 TO 2+720 SOLID RT EDGE LINE & NO PARKING

TEMPORARY 600mm STOP BAR, PAINT
 DURABLE 600mm STOP BAR, TYPE 1 TAPE
 STA 2+690 LT (PLEASANT ST)
 TEMPORARY LETTER OR SYMBOL, PAINT
 DURABLE LETTER OR SYMBOL, TYPE 1 TAPE
 STA 2+688 LT - "STOP" (PLEASANT ST)
 TEMPORARY CROSSWALK MARKING, PAINT
 STA 2+574 TO 2+587 RT
 STA 2+587 LT TO RT
 SAT 2+689 TO 2+690 LT TO RT
 STA 2+689 TO 2+695 LT


CONSTRUCT SIDEWALK RAMP
 W/DETECTABLE WARNING SURFACE (RED)
 STA 2+574 RT (CONCRETE PAD)
 STA 2+587 LT (TYPE 2)
 STA 2+587 RT (TYPE 1)
 STA 2+689 LT (CONCRETE LANDING)
 STA 2+690 RT (TYPE 2)
 STA 2+695 LT (TYPE 1)
 CHANGING ELEVATION OF DROP INLETS,
 CATCH BASINS, OR MANHOLES
 STA 2+562 RT (DI) REHAB
 STA 2+593 RT (DI)
 STA 2+629 LT (DI)
 STA 2+634 RT (DI)
 STA 2+683 LT (DI)
 STA 2+687 RT (DI) REHAB
 STA 2+701 LT (DI)

CHANGING ELEVATION
 OF SEWER MANHOLES
 STA 2+638 RT
 STA 2+713 LT
 ADJUST ELEVATION **DONE BY TOWN**
 OF VALVE BOX
 STA 2+584 RT (LINCOLN ST)
 STA 2+701 RT
 VERTICAL GRANITE CURB
 STA 2+701 TO 2+706 LT

REMOVING SIGNS
 AS SHOWN - 27
 ERECTING SALVAGED SIGNS
 AS SHOWN - 1

TEMPORARY 100mm YELLOW LINE, PAINT
 DURABLE 100mm YELLOW LINE, THERMOPLASTIC
 STA 2+560 TO 2+574 SOLID LT & RT
 STA 2+588 TO 2+688 SOLID LT & RT
 STA 2+691 DOUBLE SOLID LT (PLEASANT ST)
 STA 2+691 TO 2+704 SOLID LT & RT
 STA 2+716 TO 2+720 SOLID LT & RT

SPECIAL PROVISION (DURABLE
 CROSSWALK MARKING, IMPRINTED/COLORIZED)
 STA 2+574 TO 2+587 RT
 STA 2+587 LT TO RT
 SAT 2+689 TO 2+690 LT TO RT
 STA 2+689 TO 2+695 LT

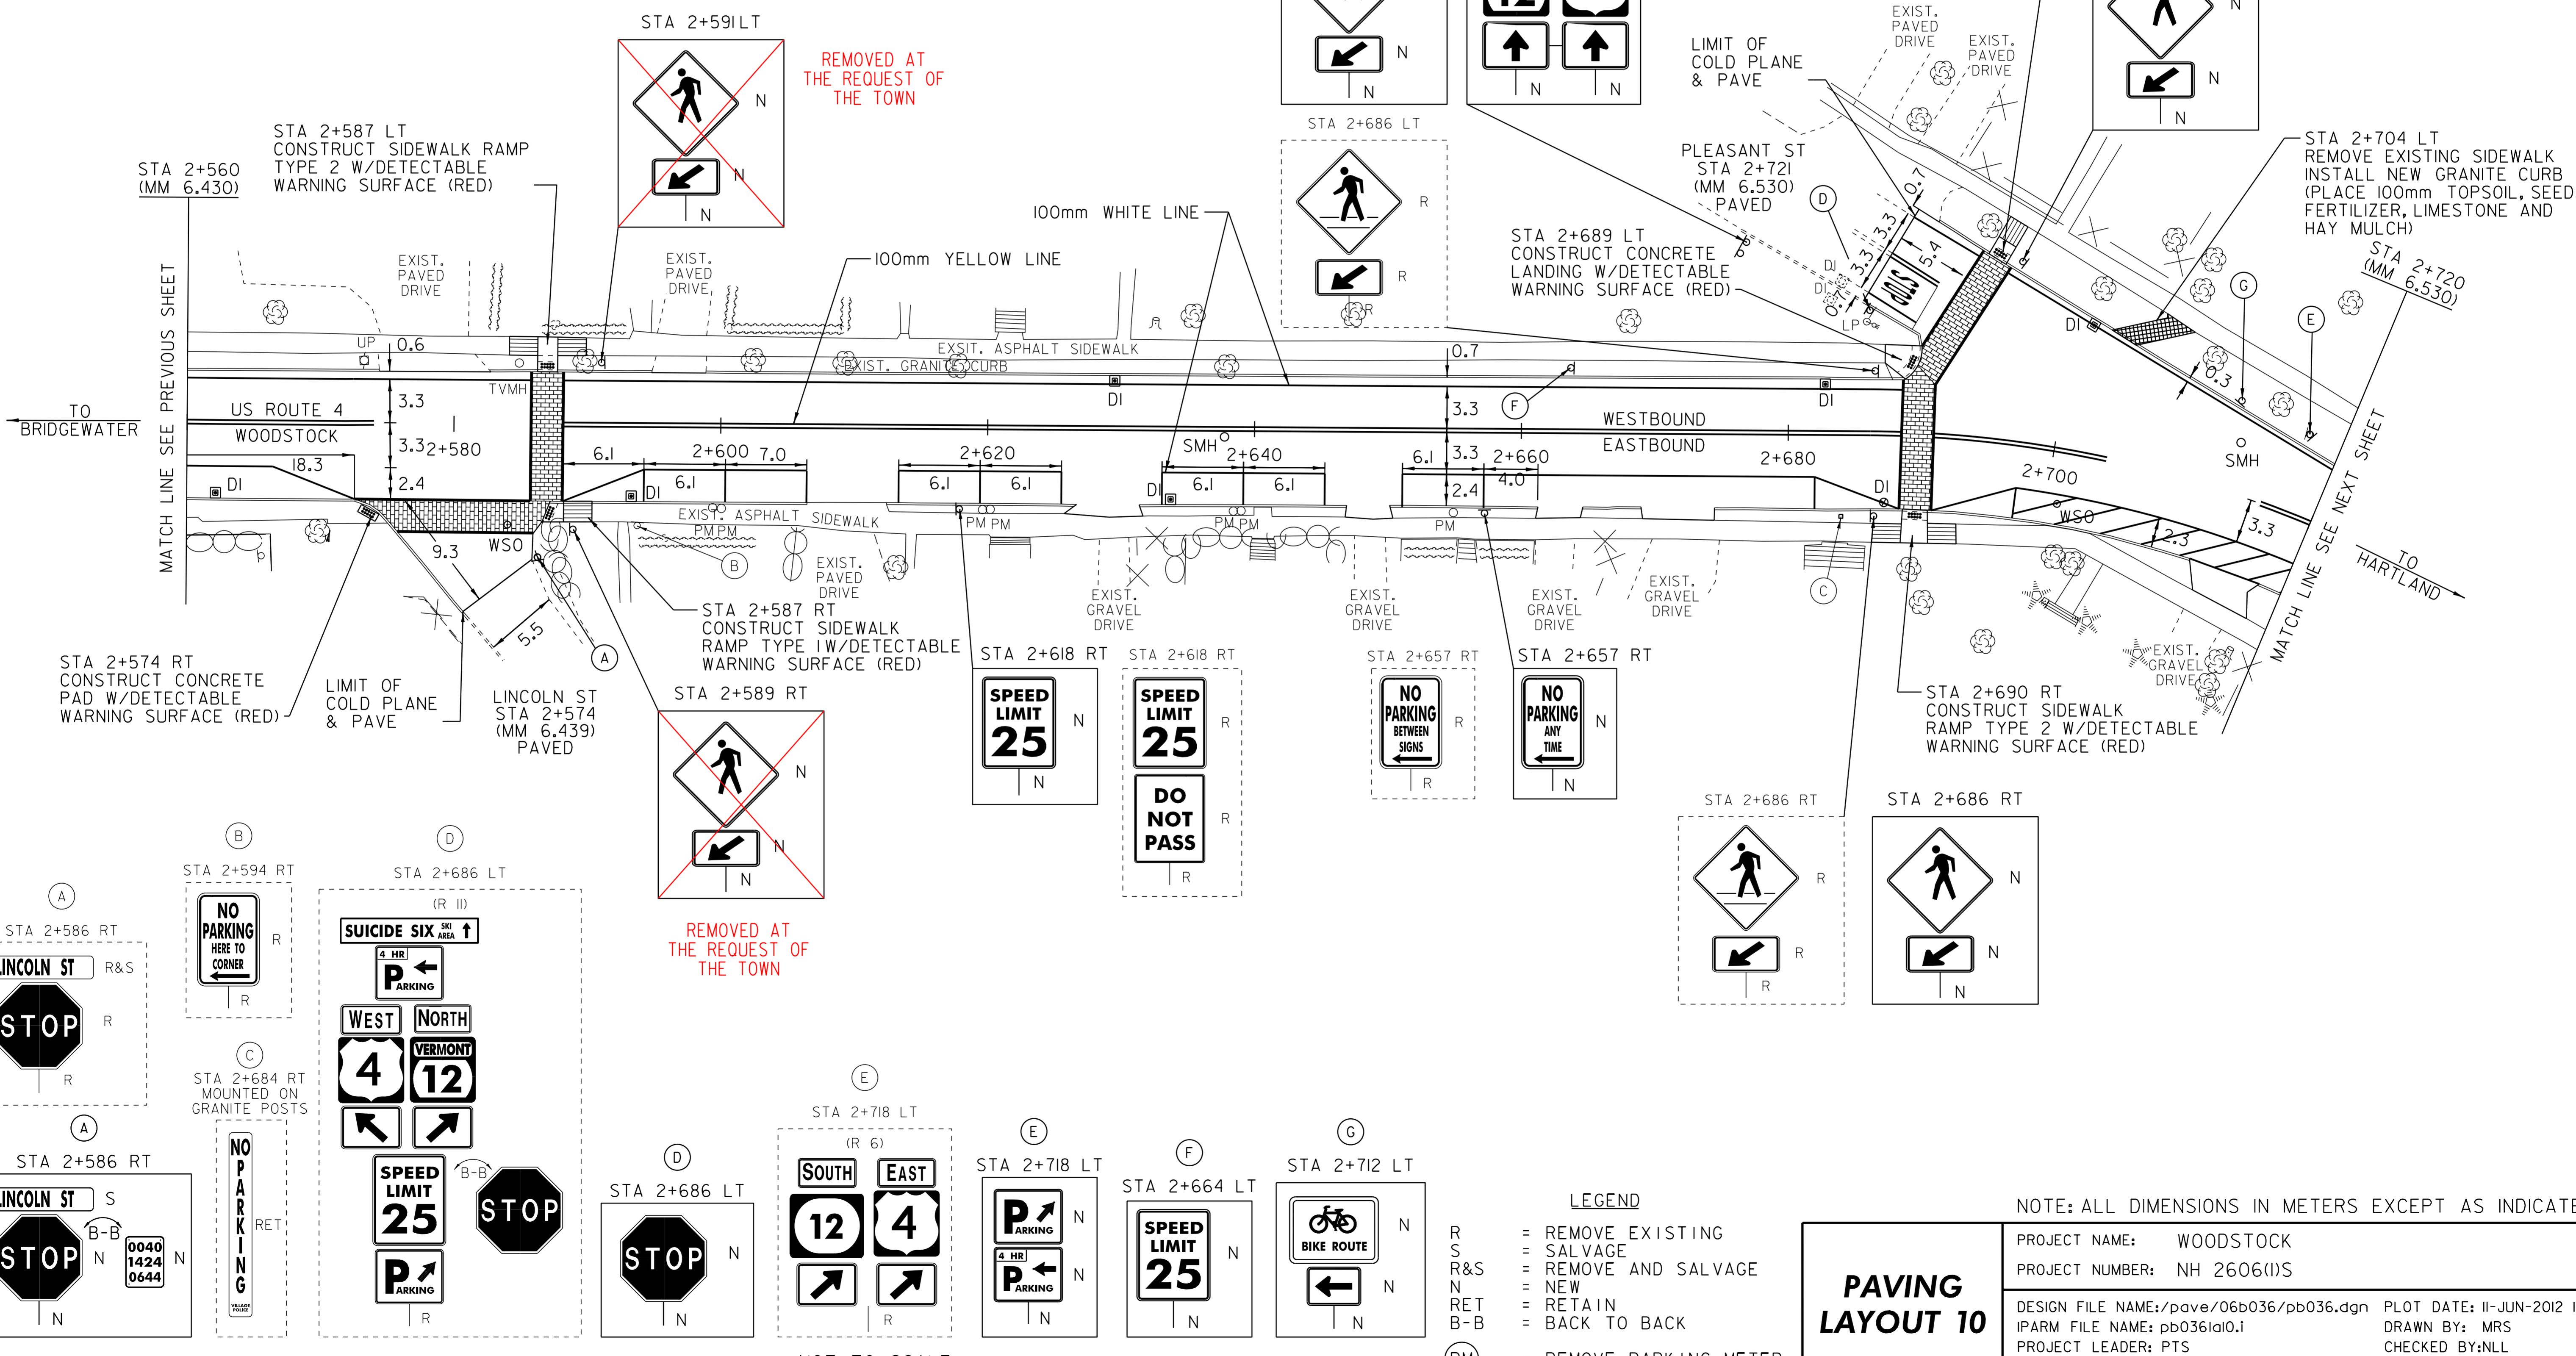

PAVING LAYOUT 10

NOTE: ALL DIMENSIONS IN METERS EXCEPT AS INDICATED
 PROJECT NAME: WOODSTOCK
 PROJECT NUMBER: NH 2606(1)S
 DESIGN FILE NAME: /pave/06b036/pb036.dgn PLOT DATE: 11-JUN-2012 16:15
 IPARM FILE NAME: pb036la0.i DRAWN BY: MRS
 PROJECT LEADER: PTS CHECKED BY: NLL
 DESIGNED BY: NLL SHEET 29 OF 73

LEGEND
 R = REMOVE EXISTING
 S = SALVAGE
 R&S = REMOVE AND SALVAGE
 N = NEW
 RET = RETAIN
 B-B = BACK TO BACK
 (PM) = REMOVE PARKING METER

NOT TO SCALE