

TEMPORARY 100mm WHITE LINE, PAINT
 DURABLE 100mm WHITE LINE, THERMOPLASTIC
 STA 2+880 TO 2+954 SOLID RT EDGE LINE
 STA 2+880 TO 3+020 SOLID LT EDGE LINE
 STA 2+978 TO 3+020 SOLID RT EDGE LINE

TEMPORARY 100mm YELLOW LINE, PAINT
 DURABLE 100mm YELLOW LINE, THERMOPLASTIC
 STA 2+880 TO 2+960 SOLID LT & RT
 STA 2+972 TO 3+020 SOLID LT & RT



TEMPORARY CROSSWALK MARKING, PAINT
 STA 2+963 TO 2+968 RT
 SPECIAL PROVISION (DURABLE
 CROSSWALK MARKING, IMPRINTED/COLORIZED)
 STA 2+963 TO 2+968 RT

CONSTRUCT SIDEWALK RAMP
 W/DETECTABLE WARNING SURFACE (RED)
 STA 2+963 RT (TYPE 1)
 STA 2+968 RT (TYPE 1)
 CHANGING ELEVATION OF DROP INLETS,
 CATCH BASINS, OR MANHOLES
 STA 2+901 RT (DI) REHAB
 STA 2+935 RT (DI)
 STA 2+970 RT (DI)
 STA 2+998 RT (DI)
 STA 3+015 LT (DI) (BEHIND CURB)

REHAB. DROP INLETS, CATCH
 BASINS, OR MANHOLES, CLASS 1
 STA 2+901 LT (DI) CHANGED ELEV.
 3+015 LT (DI)

CHANGING ELEVATION
 OF SEWER MANHOLES
 STA 2+965 LT
 3+015 RT
 ADJUST ELEVATION
 OF VALVE BOX
 STA 2+964 RT (STANTON ST)
 DONE BY TOWN

REMOVING SIGNS
 AS SHOWN - 3
 ERECTING SALVAGED SIGNS
 AS SHOWN - 2

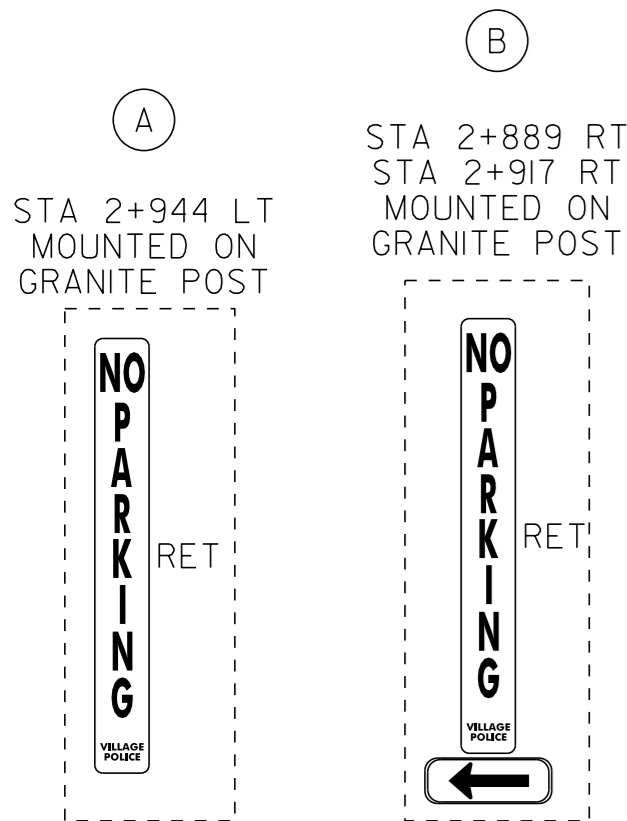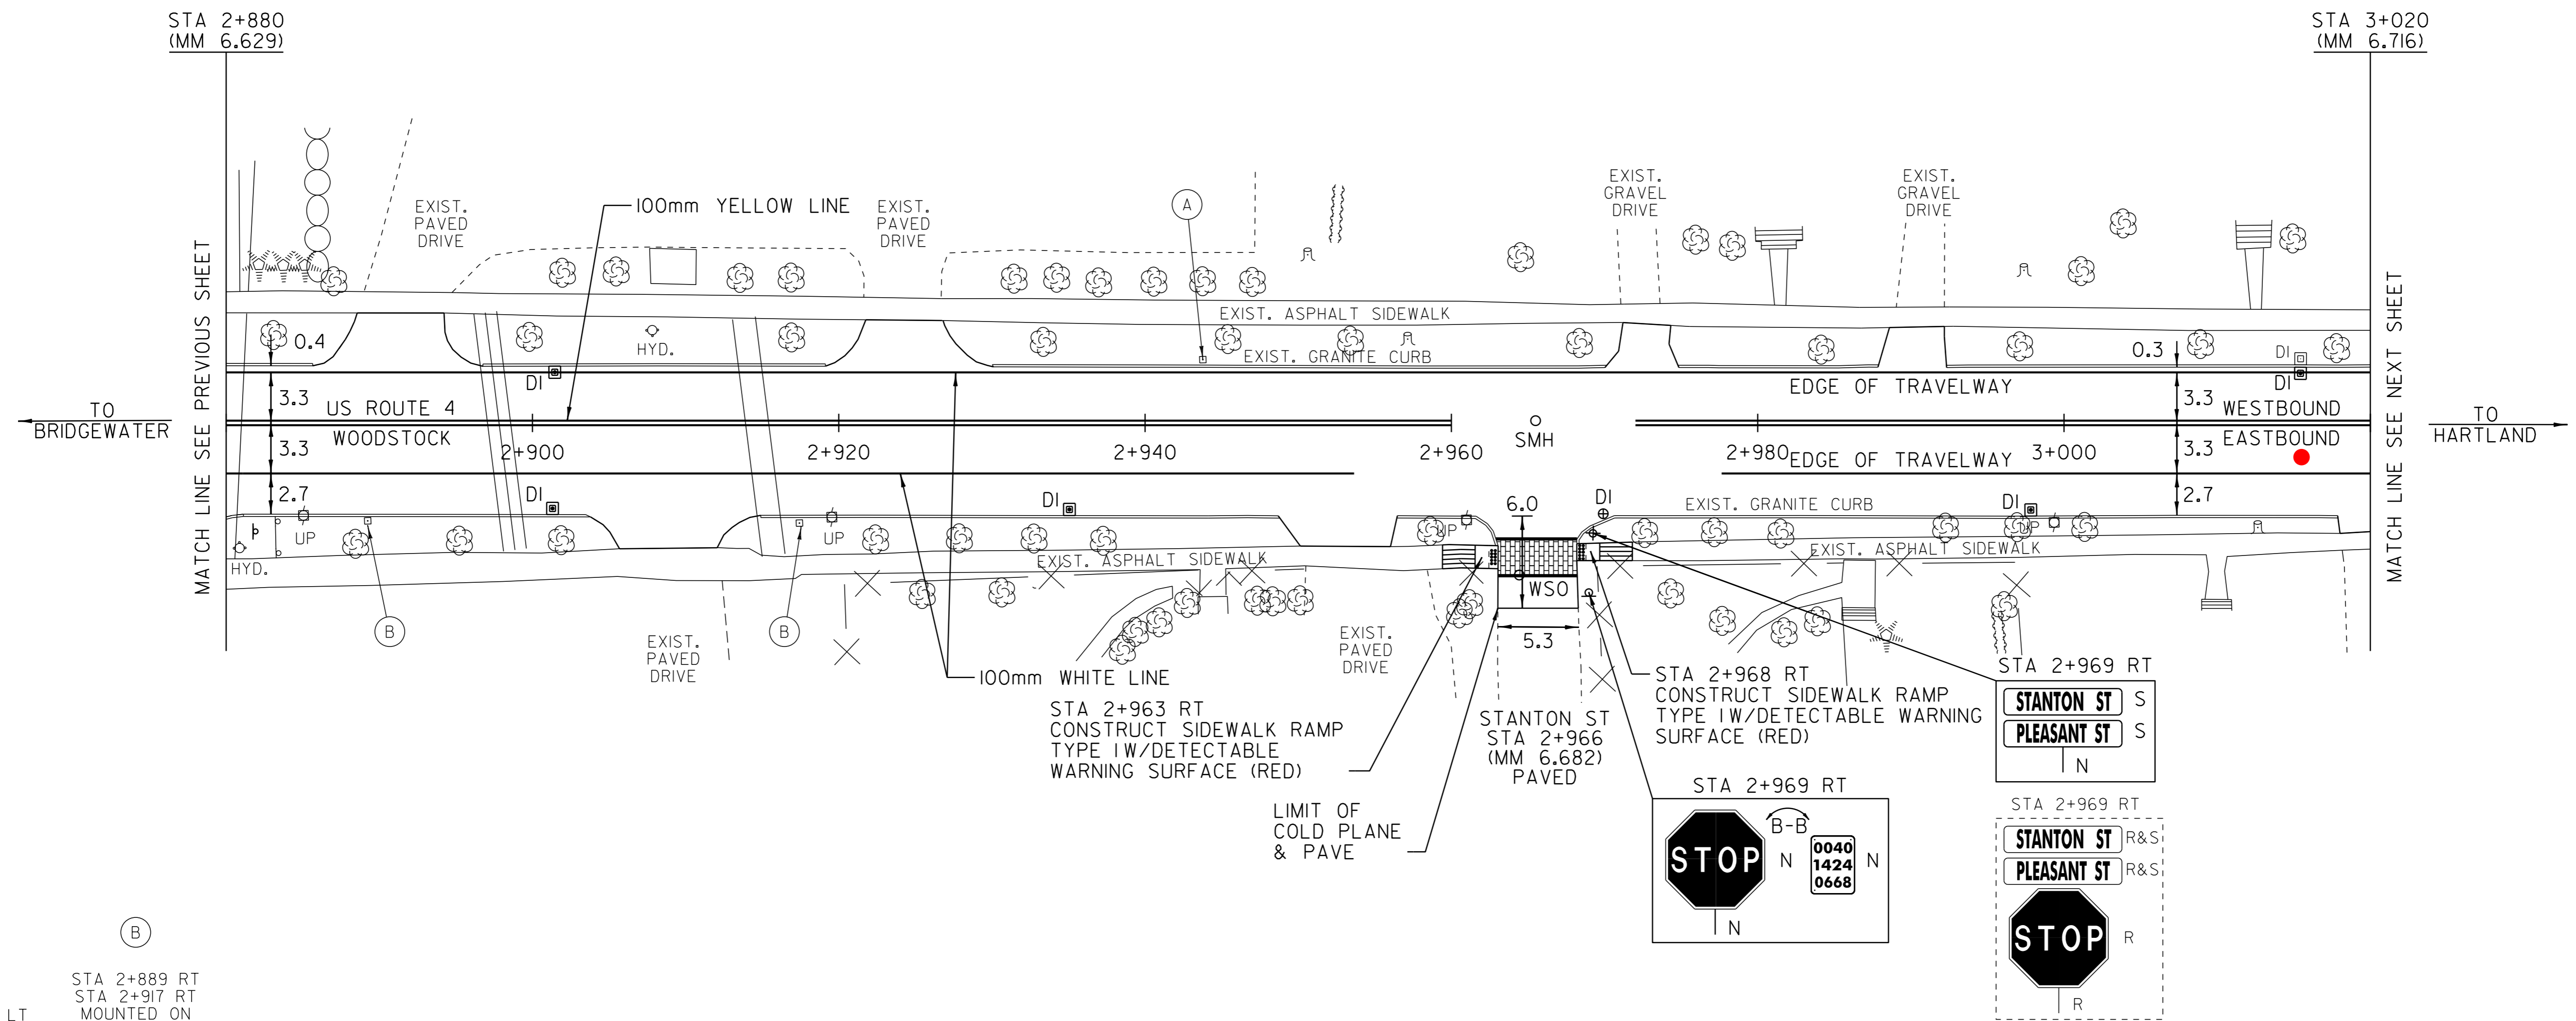

- LEGEND**
- R = REMOVE EXISTING
 - S = SALVAGE
 - R&S = REMOVE AND SALVAGE
 - N = NEW
 - RET = RETAIN
 - B-B = BACK TO BACK
 - (PM) = REMOVE PARKING METER

PAVING LAYOUT 12

NOTE: ALL DIMENSIONS IN METERS EXCEPT AS INDICATED

PROJECT NAME: WOODSTOCK	PLOT DATE: 11-JUN-2012 16:16
PROJECT NUMBER: NH 2606(1)S	DRAWN BY: MRS
DESIGN FILE NAME: /pave/06b036/pb036.dgn	CHECKED BY: NLL
IPARM FILE NAME: pb0361a12.i	SHEET 31 OF 73
PROJECT LEADER: PTS	
DESIGNED BY: NLL	

NOT TO SCALE