


- COMMON EXCAVATION
STA 1+206 TO 1+214 RT
STA 1+226 TO 1+275 RT
STA 1+254 TO 1+269 LT
- EXCAVATION OF SURFACES AND PAVEMENTS
STA 1+253 TO 1+275 RT

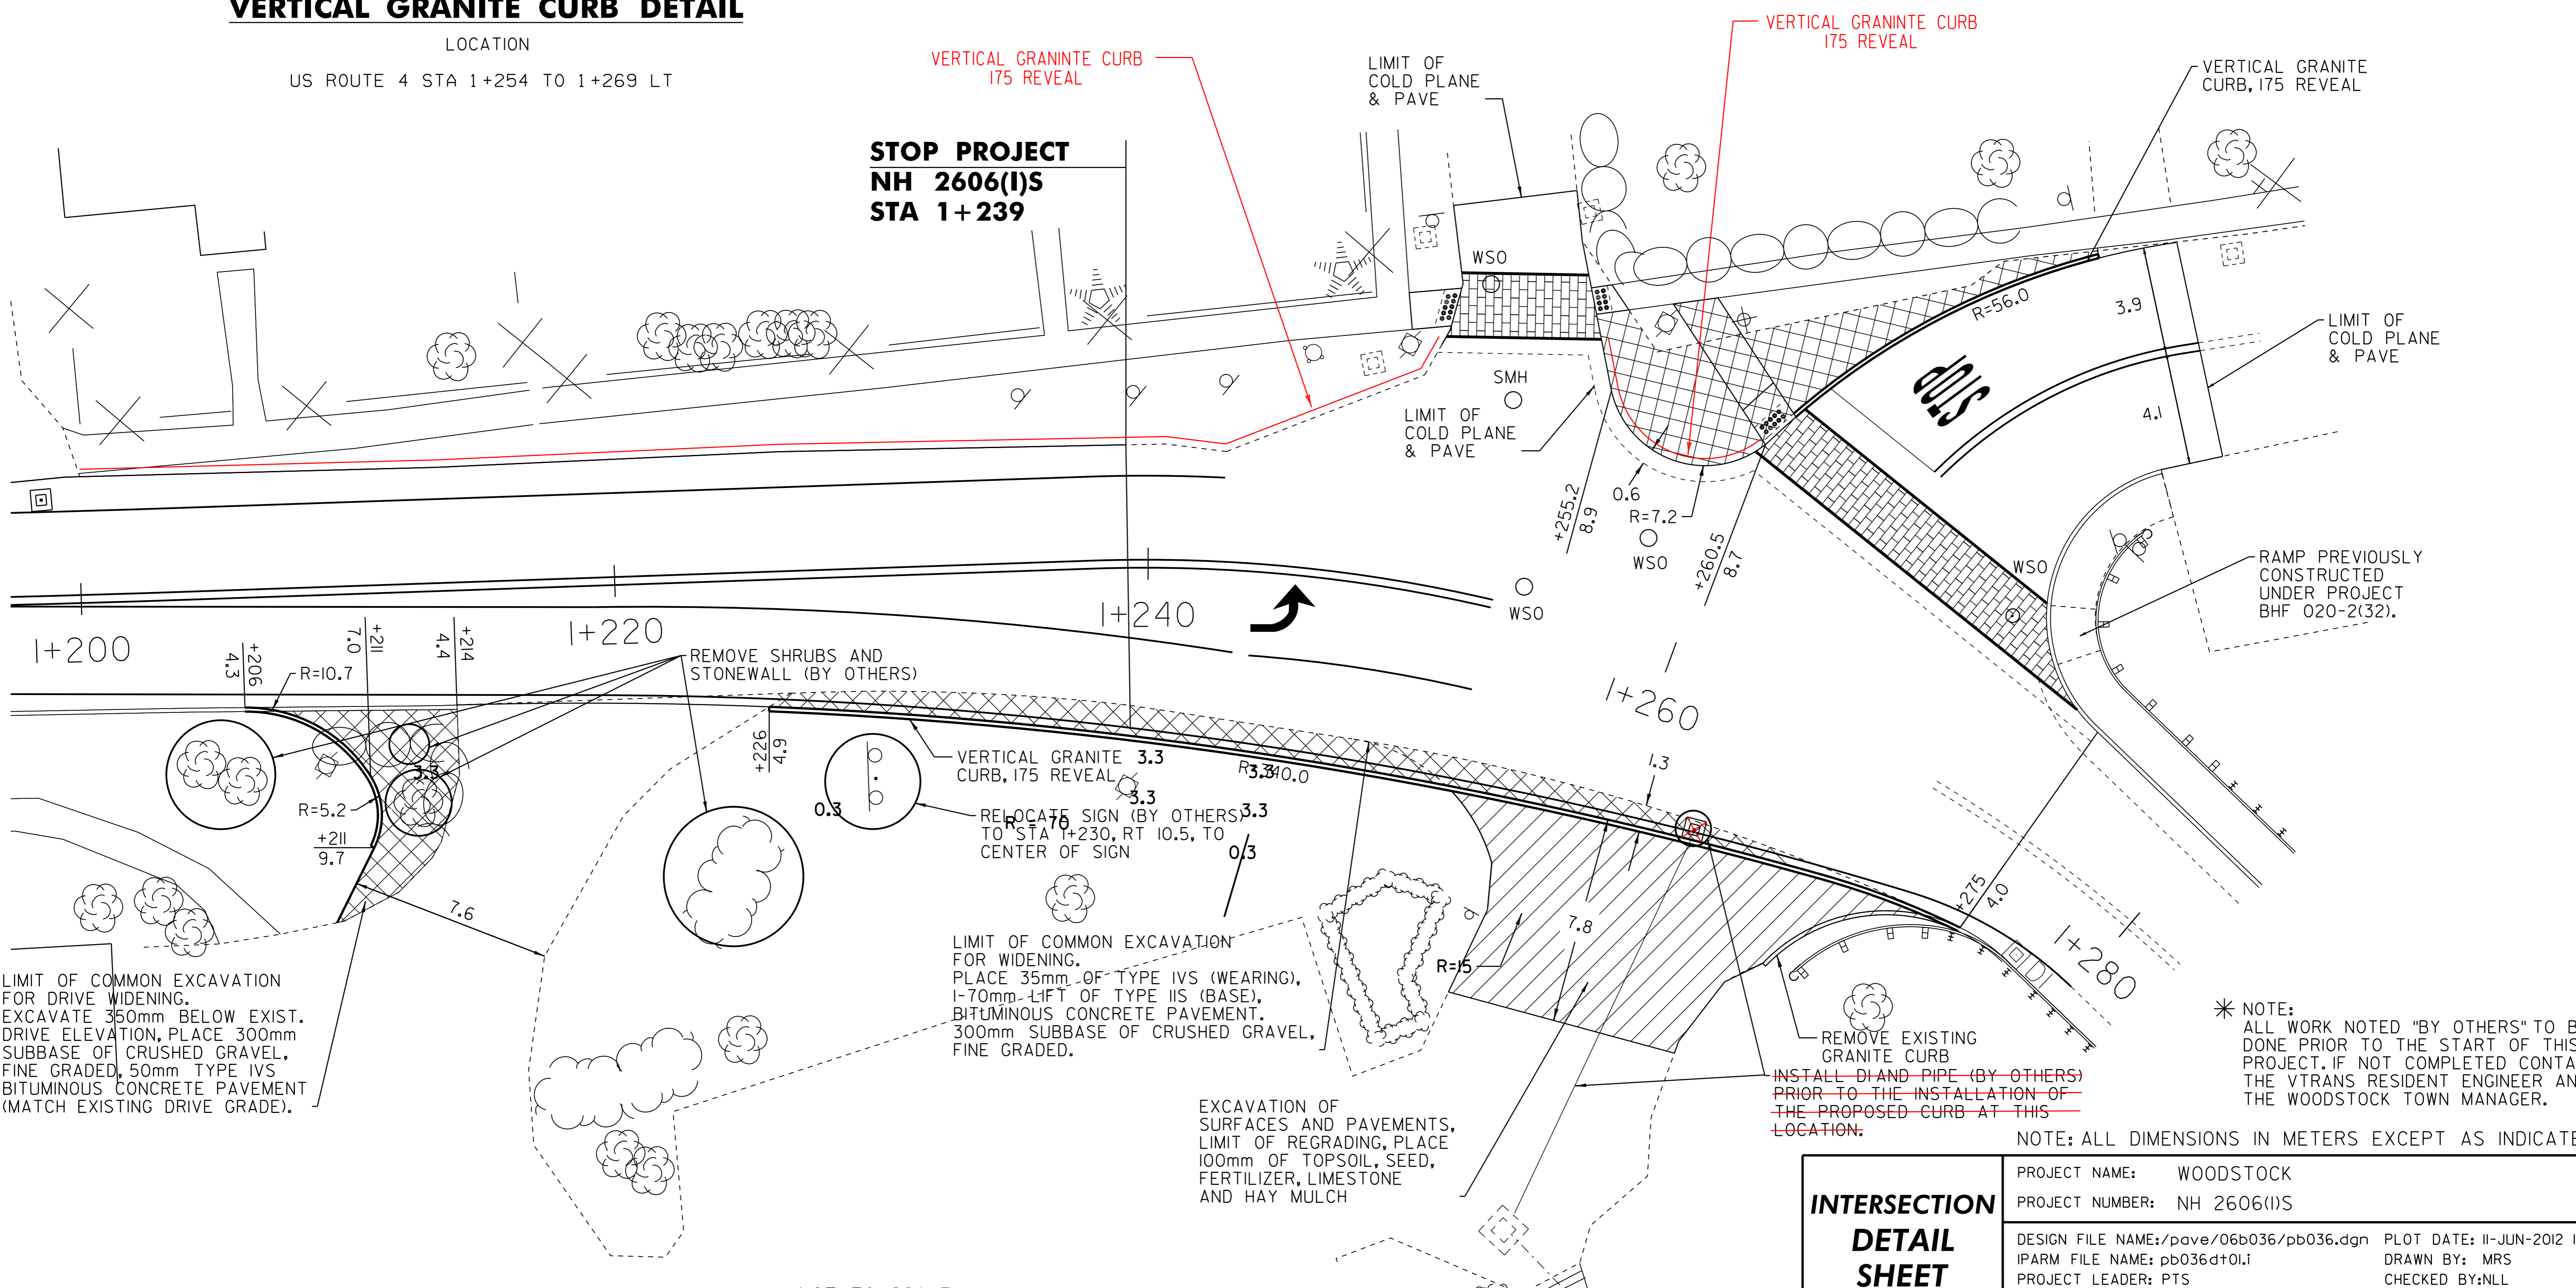

* NOTE: ALL WORK NOTED "BY OTHERS" TO BE DONE PRIOR TO THE START OF THIS PROJECT. IF NOT COMPLETED CONTACT THE VTRANS RESIDENT ENGINEER AND THE WOODSTOCK TOWN MANAGER.

NOTE: ALL DIMENSIONS IN METERS EXCEPT AS INDICATED

INTERSECTION DETAIL SHEET	PROJECT NAME: WOODSTOCK	PLOT DATE: 11-JUN-2012 16:16
	PROJECT NUMBER: NH 2606(I)S	DRAWN BY: MRS
	DESIGN FILE NAME: /pave/06b036/pb036.dgn	CHECKED BY: NLL
	IPARM FILE NAME: pb036a+01.i	SHEET 35 OF 73

NOT TO SCALE