


**COMMON EXCAVATION**  
 STA 2+838 TO 2+841 RT  
 STA 2+847 TO 2+848 RT  
 STA 2+856 TO 2+858 RT  
 STA 2+867 TO 2+871 LT  
 STA 2+868 TO 2+871 RT

**NOTE:**  
 GRASS ISLANDS TO RECEIVE  
 100mm TOPSOIL, SEED, FERTILIZER,  
 LIMESTONE AND HAY MULCH

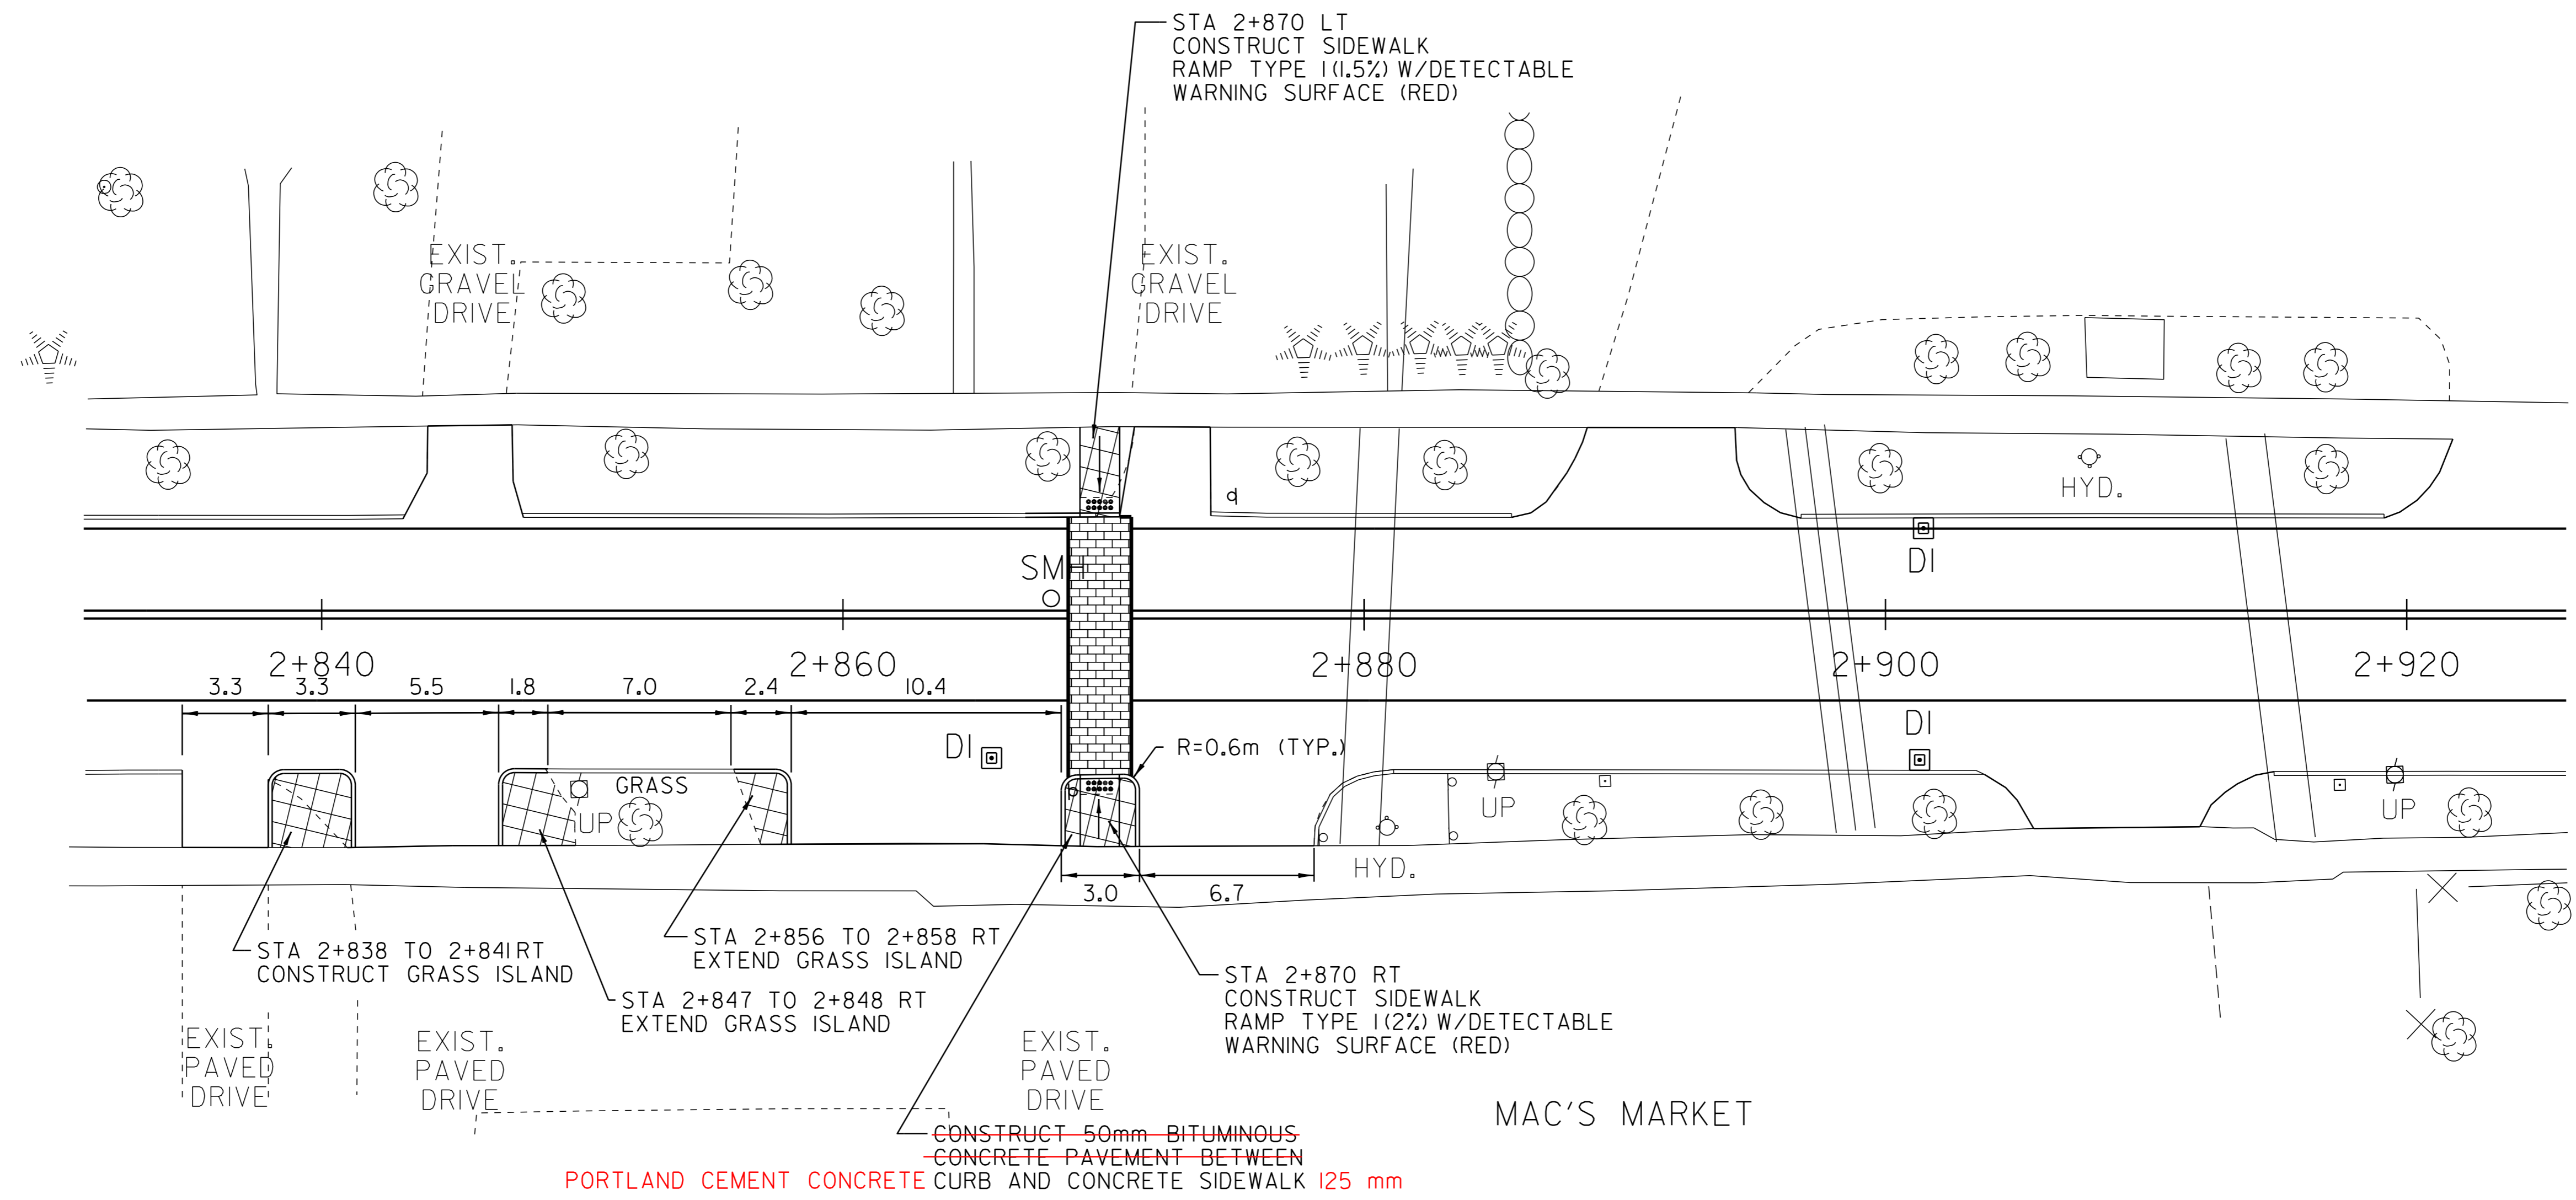

NOT TO SCALE

**LEGEND**

- R = REMOVE EXISTING
- S = SALVAGE
- R&S = REMOVE AND SALVAGE
- N = NEW
- RET = RETAIN
- B-B = BACK TO BACK

NOTE: ALL DIMENSIONS IN METERS EXCEPT AS INDICATED

**2 + 840 - 2 + 880  
 ISLAND /  
 CROSSWALK  
 DETAIL**

PROJECT NAME:	WOODSTOCK
PROJECT NUMBER:	NH 2606(1)S
DESIGN FILE NAME:	pave/06b036/pb036.dgn
IPARM FILE NAME:	pb036d+08.i
PROJECT LEADER:	PTS
DESIGNED BY:	NLL
PLOT DATE:	11-JUN-2012 16:16
DRAWN BY:	MRS
CHECKED BY:	NLL
SHEET	41 OF 73