

TEMPORARY 100mm WHITE LINE, PAINT
 DURABLE 100mm WHITE LINE, THERMOPLASTIC
 STA 12+180 TO 12+195 SOLID LT PARKING
 STA 12+180 TO 12+202 SOLID RT PARKING
 STA 12+195 TO 12+208 SOLID LT NO PARKING
 STA 12+202 TO 12+208 SOLID RT NO PARKING
 STA 12+211 TO 12+217 SOLID LT NO PARKING
 STA 12+217 TO 12+340 SOLID LT EDGE LINE
 STA 12+230 TO 12+236 SOLID RT NO PARKING
 STA 12+236 TO 12+340 SOLID RT EDGE LINE

TEMPORARY 100mm YELLOW LINE, PAINT
 DURABLE 100mm YELLOW LINE, THERMOPLASTIC
 STA 12+180 TO 12+208 SOLID LT & RT
 STA 12+210 TO 12+212 SOLID LT & RT
 STA 12+218 DOUBLE SOLID RT (PLEASANT ST)
 STA 12+224 TO 12+340 SOLID LT & RT

TEMPORARY 600mm STOP BAR, PAINT
 DURABLE 600mm STOP BAR, TYPE ITAPE
 STA 12+218 RT (PLEASANT ST)

TEMPORARY LETTER OR SYMBOL, PAINT
 DURABLE LETTER OR SYMBOL, TYPE ITAPE
 STA 12+221 RT - "STOP" (PLEASANT ST)

TEMPORARY CROSSWALK MARKING, PAINT
 STA 12+209 LT TO RT
 STA 12+209 TO 12+227 RT

SPECIAL PROVISION (DURABLE
 CROSSWALK MARKING, IMPRINTED/COLORIZED)
 STA 12+209 LT TO RT
 STA 12+209 TO 12+227 RT

CONSTRUCT SIDEWALK RAMP
 W/DETECTABLE WARNING SURFACE (RED)
 STA 12+209 LT (CONCRETE RAMP)
 STA 12+209 RT (TYPE 1)
 STA 12+227 RT (CONCRETE PAD)


CHANGING ELEVATION OF DROP INLETS,
 CATCH BASINS, OR MANHOLES
 STA 12+205 RT (CB)

CHANGING ELEVATION OF DROP INLETS,
 CATCH BASINS, OR MANHOLES (BY OTHERS)
 STA 12+212 RT (ELECTRIC MH) (PLEASANT ST)
 STA 12+213 RT (CABLE TV MH) (PLEASANT ST)

BITUMINOUS CONCRETE CURB, TYPE B
 (SEE DETAIL ON SHEET 4)
 STA 12+229 TO 12+254 RT
 STA 12+258 TO 12+276 RT
 STA 12+279 TO 12+308 RT
 STA 12+312 TO 12+340 RT

CHANGING ELEVATION
 OF SEWER MANHOLES
 STA 12+213 LT
 STA 12+280 LT
 ADJUST ELEVATION
 OF VALVE BOX DONE BY
 STA 12+199 LT TOWN
 STA 12+222 RT (PLEASANT ST)

REMOVING SIGNS
 AS SHOWN - 24

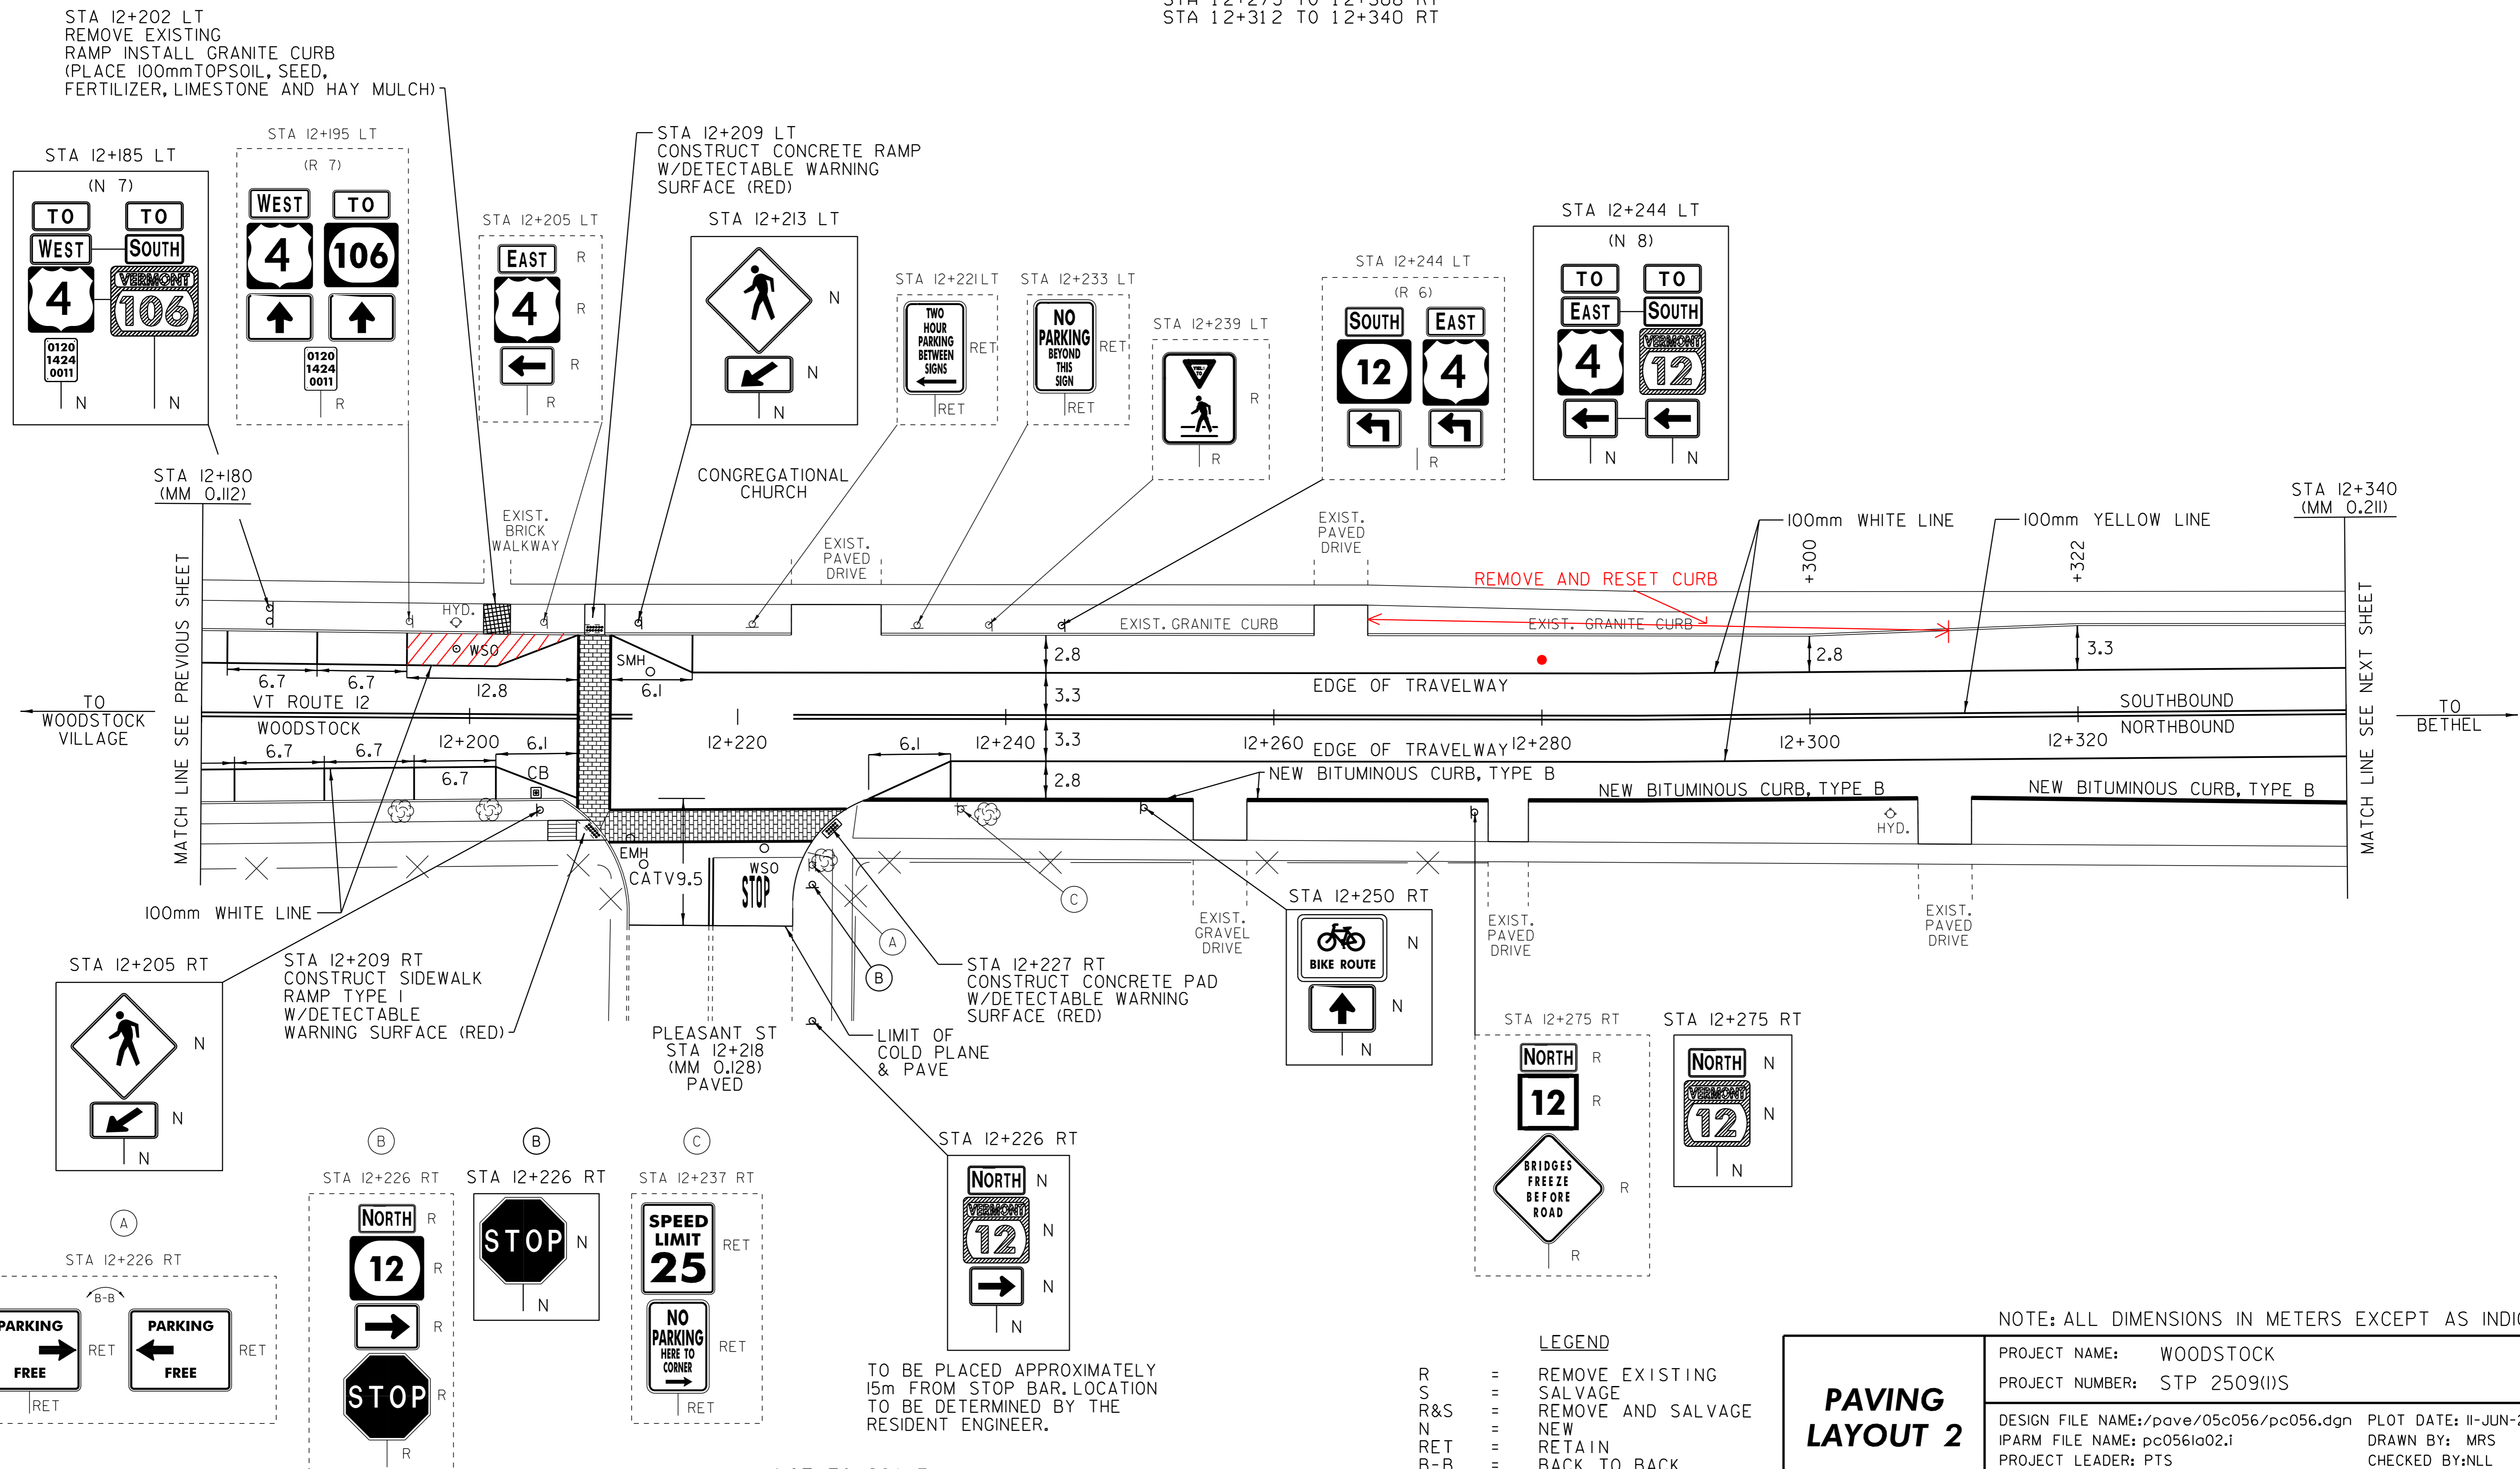

NOT TO SCALE

NOTE: ALL DIMENSIONS IN METERS EXCEPT AS INDICATED

- LEGEND**
- R = REMOVE EXISTING
 - S = SALVAGE
 - R&S = REMOVE AND SALVAGE
 - N = NEW
 - RET = RETAIN
 - B-B = BACK TO BACK

PAVING LAYOUT 2

PROJECT NAME: WOODSTOCK
 PROJECT NUMBER: STP 2509(I)S
 DESIGN FILE NAME: /pave/05c056/pc056.dgn PLOT DATE: 11-JUN-2012 16:17
 IPARM FILE NAME: pc056ia02.i DRAWN BY: MRS
 PROJECT LEADER: PTS CHECKED BY: NLL
 DESIGNED BY: NLL SHEET 63 OF 73