

TEMPORARY 100mm WHITE LINE, PAINT
 DURABLE 100mm WHITE LINE, THERMOPLASTIC
 STA 12+340 TO 12+448 SOLID LT EDGE LINE
 STA 12+340 TO 12+480 SOLID RT EDGE LINE
 STA 12+452 TO 12+480 SOLID LT EDGE LINE

TEMPORARY 100mm YELLOW LINE, PAINT
 DURABLE 100mm YELLOW LINE, THERMOPLASTIC
 STA 12+340 TO 12+444 SOLID LT & RT
 STA 12+444 TO 12+456 DOTTED CL
 STA 12+450 DOUBLE SOLID LT (RIVER ST)
 STA 12+456 TO 12+480 SOLID LT & RT

TEMPORARY 600mm STOP BAR, PAINT
 DURABLE 600mm STOP BAR, TYPE ITAPE
 STA 12+450 LT (RIVER ST)

TEMPORARY LETTER OR SYMBOL, PAINT
 DURABLE LETTER OR SYMBOL, TYPE ITAPE
 STA 12+449 LT - "STOP" (RIVER ST)

CHANGING ELEVATION OF DROP INLETS,
 CATCH BASINS, OR MANHOLES
 STA 12+360 LT (DI)
 STA 12+366 RT (DI)
 STA 12+373 LT (DI) **REHAB**
 STA 12+446 LT (CB) **REHAB**
 STA 12+449 RT (CB)
 STA 12+459 LT (CB)

CHANGING ELEVATION OF DROP INLETS,
 CATCH BASINS, OR MANHOLES (BY OTHERS)
 STA 12+362 RT (ELECTRIC MH)
 STA 12+372 RT (TELEPHONE MH)
 STA 12+375 RT (CABLE TV MH)
 STA 12+465 RT (CABLE TV MH)



CHANGING ELEVATION OF SEWER MANHOLES
 STA 12+384 RT

REHAB. DROP INLETS, CATCH BASINS,
 OR MANHOLES CLASS
 STA 12+360 LT (DI)

~~CAST IRON COVER WITH FRAME~~
~~STA 12+360 LT~~

REMOVING SIGNS
 AS SHOWN - 18

ERECTING SALVAGED SIGNS
 AS SHOWN - 4

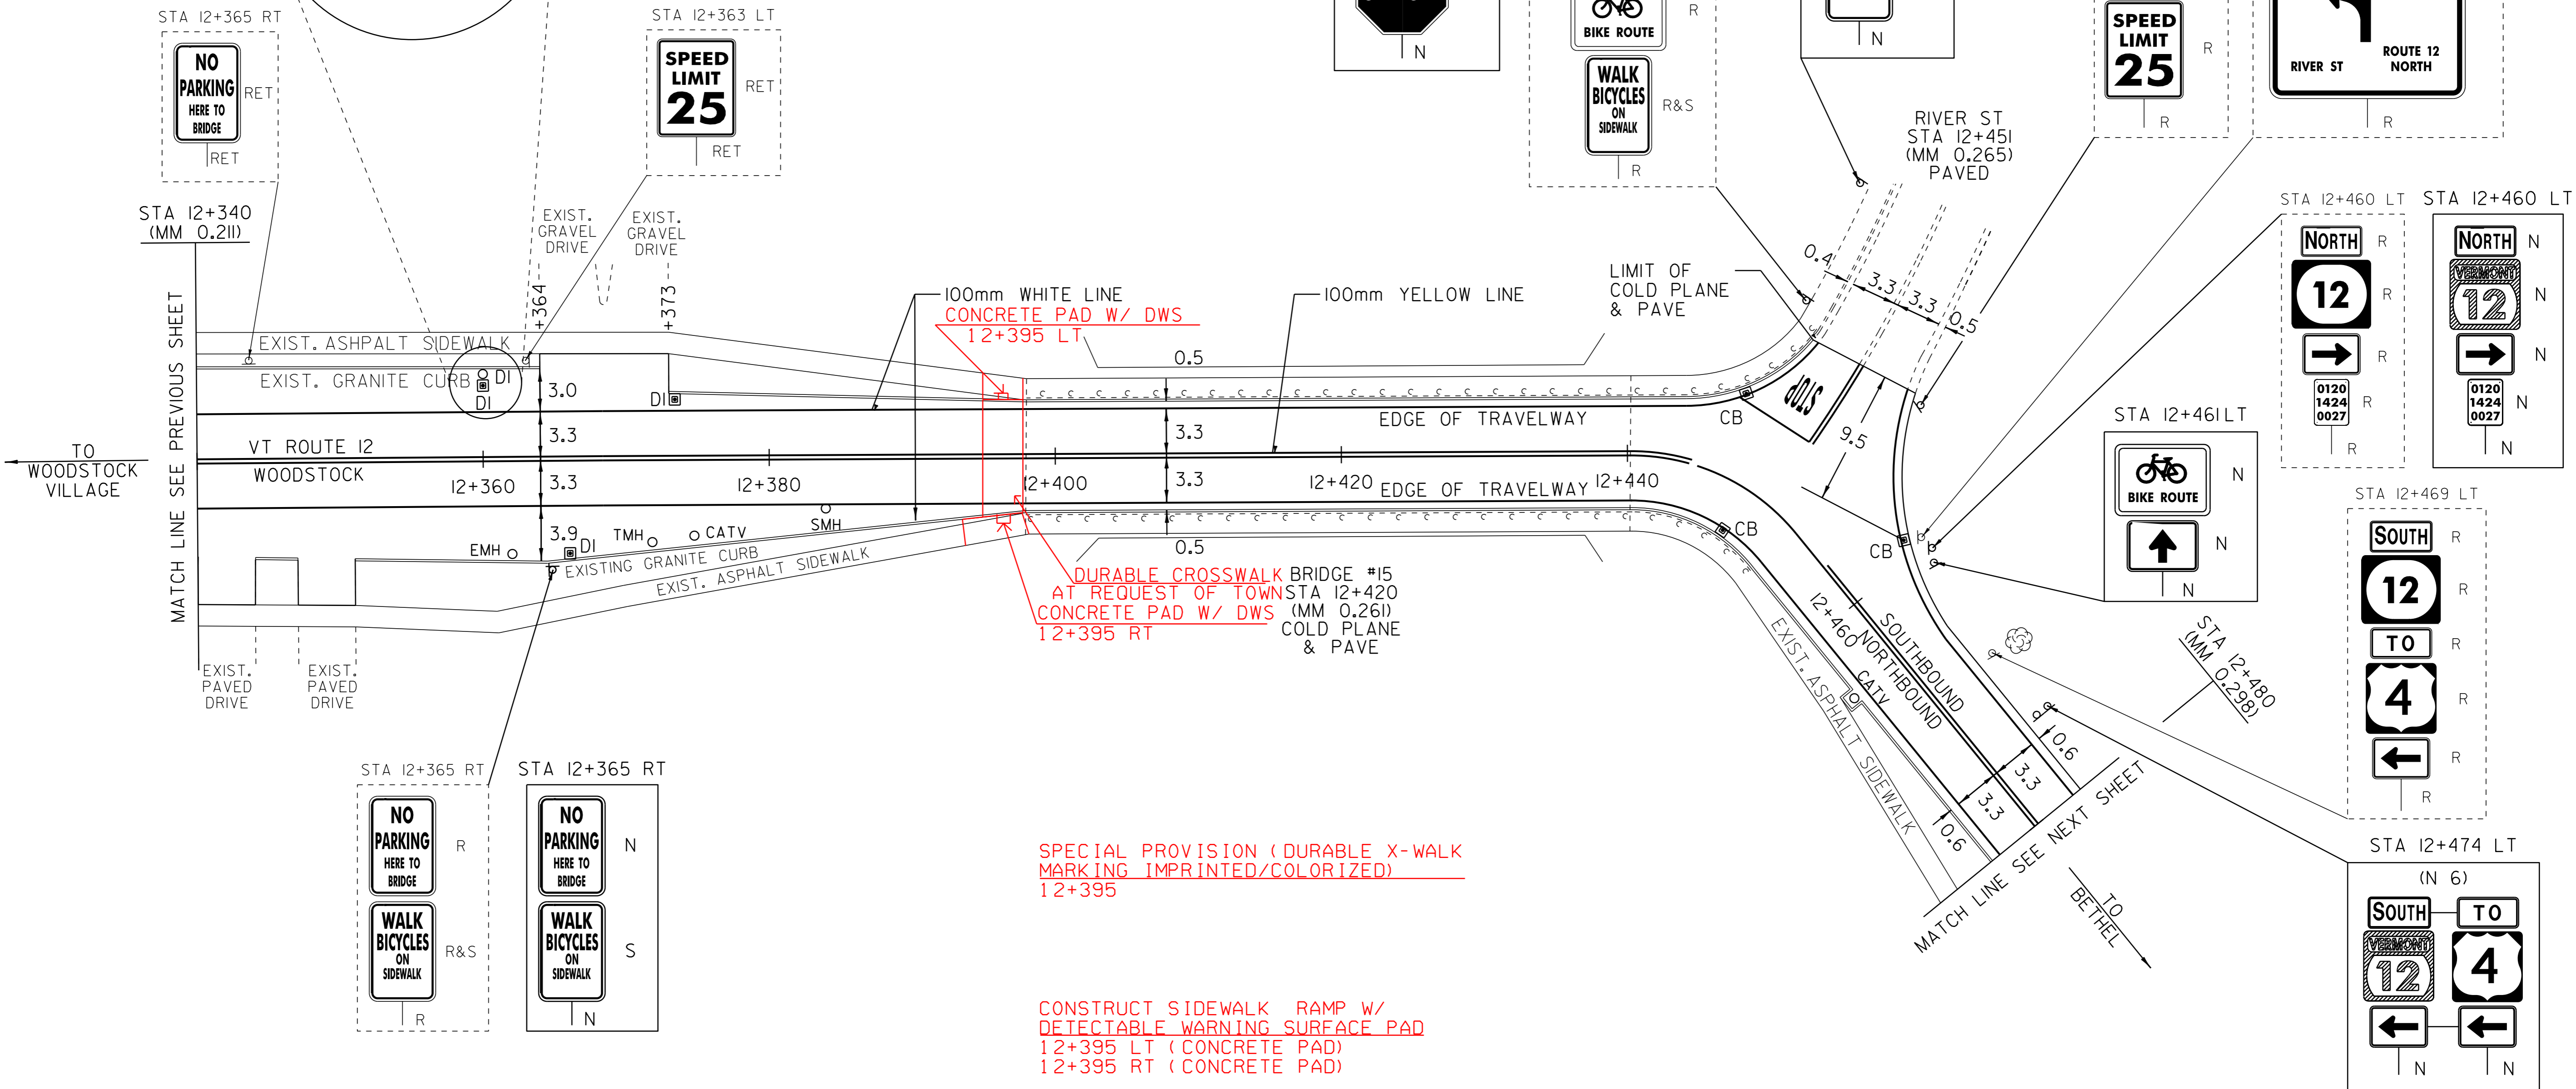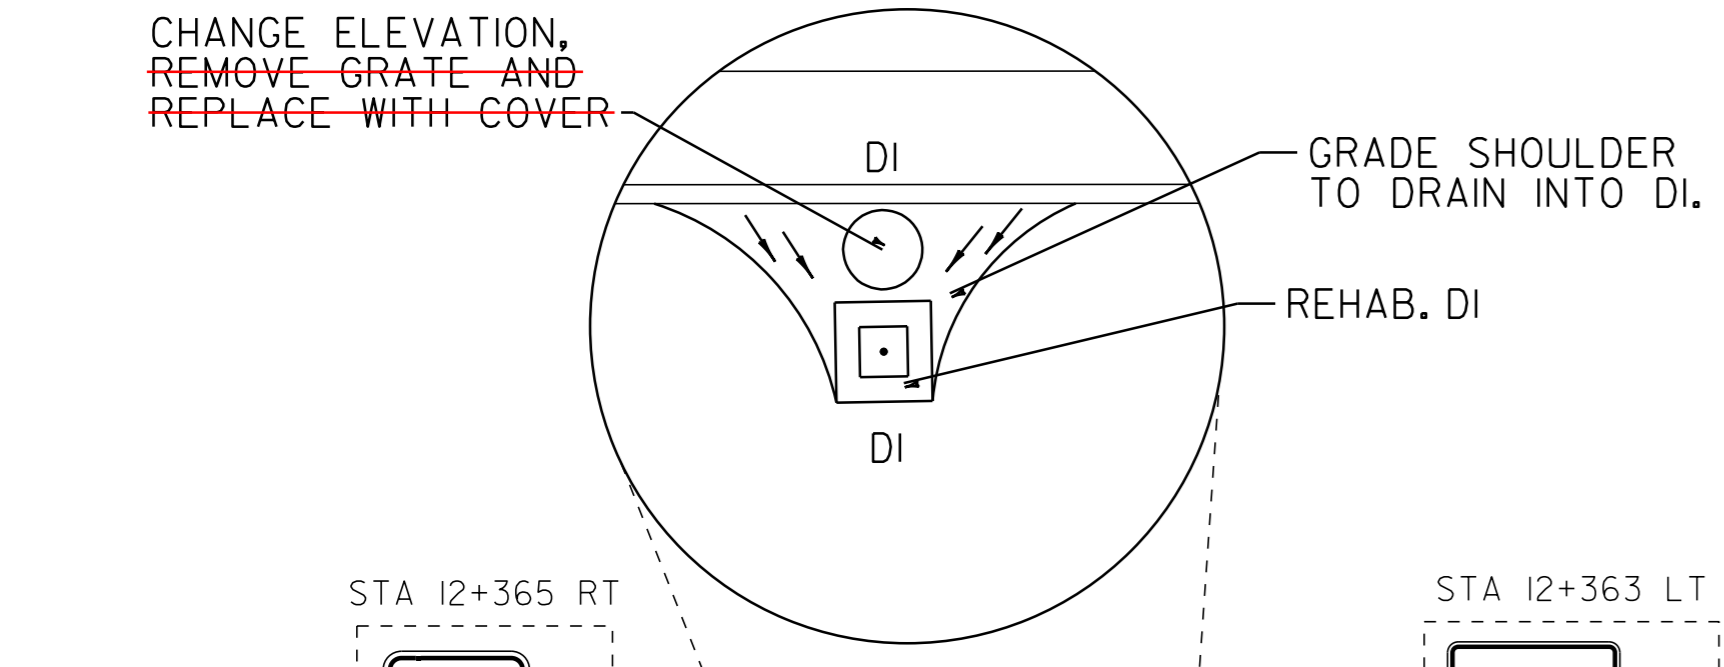

LEGEND

R	=	REMOVE EXISTING
S	=	SALVAGE
R&S	=	REMOVE AND SALVAGE
N	=	NEW
RET	=	RETAIN
B-B	=	BACK TO BACK

PAVING LAYOUT 3

NOTE: ALL DIMENSIONS IN METERS EXCEPT AS INDICATED

PROJECT NAME: WOODSTOCK
 PROJECT NUMBER: STP 2509(I)S

DESIGN FILE NAME: /pave/05c056/pc056.dgn PLOT DATE: 11-JUN-2012 16:17
 IPARM FILE NAME: pc0561a03.i DRAWN BY: MRS
 PROJECT LEADER: PTS CHECKED BY: NLL
 DESIGNED BY: NLL SHEET 64 OF 73