

TEMPORARY 100mm WHITE LINE, PAINT
 DURABLE 100mm WHITE LINE, THERMOPLASTIC
 STA 12+800 TO 12+833 SOLID RT EDGE LINE
 STA 12+800 TO 12+960 SOLID LT EDGE LINE
 STA 12+852 TO 12+887 SOLID RT EDGE LINE
 STA 12+901 TO 12+960 SOLID RT EDGE LINE

TEMPORARY 600mm STOP BAR, PAINT
 DURABLE 600mm STOP BAR, TYPE ITAPE
 STA 12+851 RT (RIVER RD)
 STA 12+889 RT (RIVER RD)

CHANGING ELEVATION OF DROP INLETS,
 CATCH BASINS, OR MANHOLES
 STA 12+871 LT (DI)



ADJUST ELEVATION
 OF VALVE BOX
 STA 12+853 RT
 STA 12+866 RT

REMOVING SIGNS
 AS SHOWN - 4



TEMPORARY 100mm YELLOW LINE, PAINT
 DURABLE 100mm YELLOW LINE, THERMOPLASTIC
 STA 12+800 TO 12+833 SOLID LT & RT
 STA 12+845 TO 12+889 SOLID LT & RT
 STA 12+851 DOUBLE SOLID RT (RIVER RD)
 STA 12+889 DOUBLE SOLID RT (RIVER RD)
 STA 12+901 TO 12+960 SOLID LT & RT

TEMPORARY LETTER OR SYMBOL, PAINT
 DURABLE LETTER OR SYMBOL, TYPE ITAPE
 STA 12+854 RT - "STOP" (RIVER RD)
 STA 12+889 RT - "STOP" (RIVER RD)

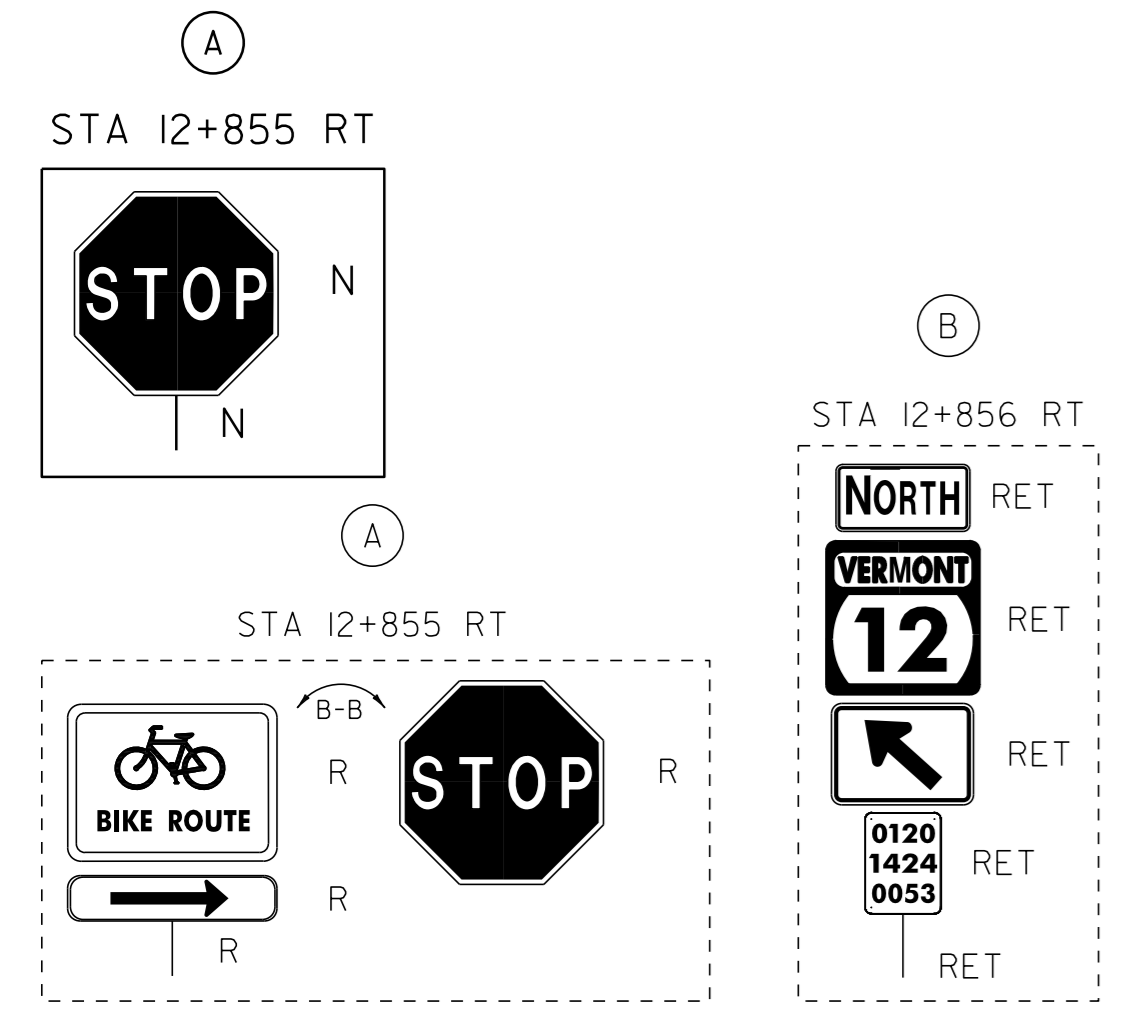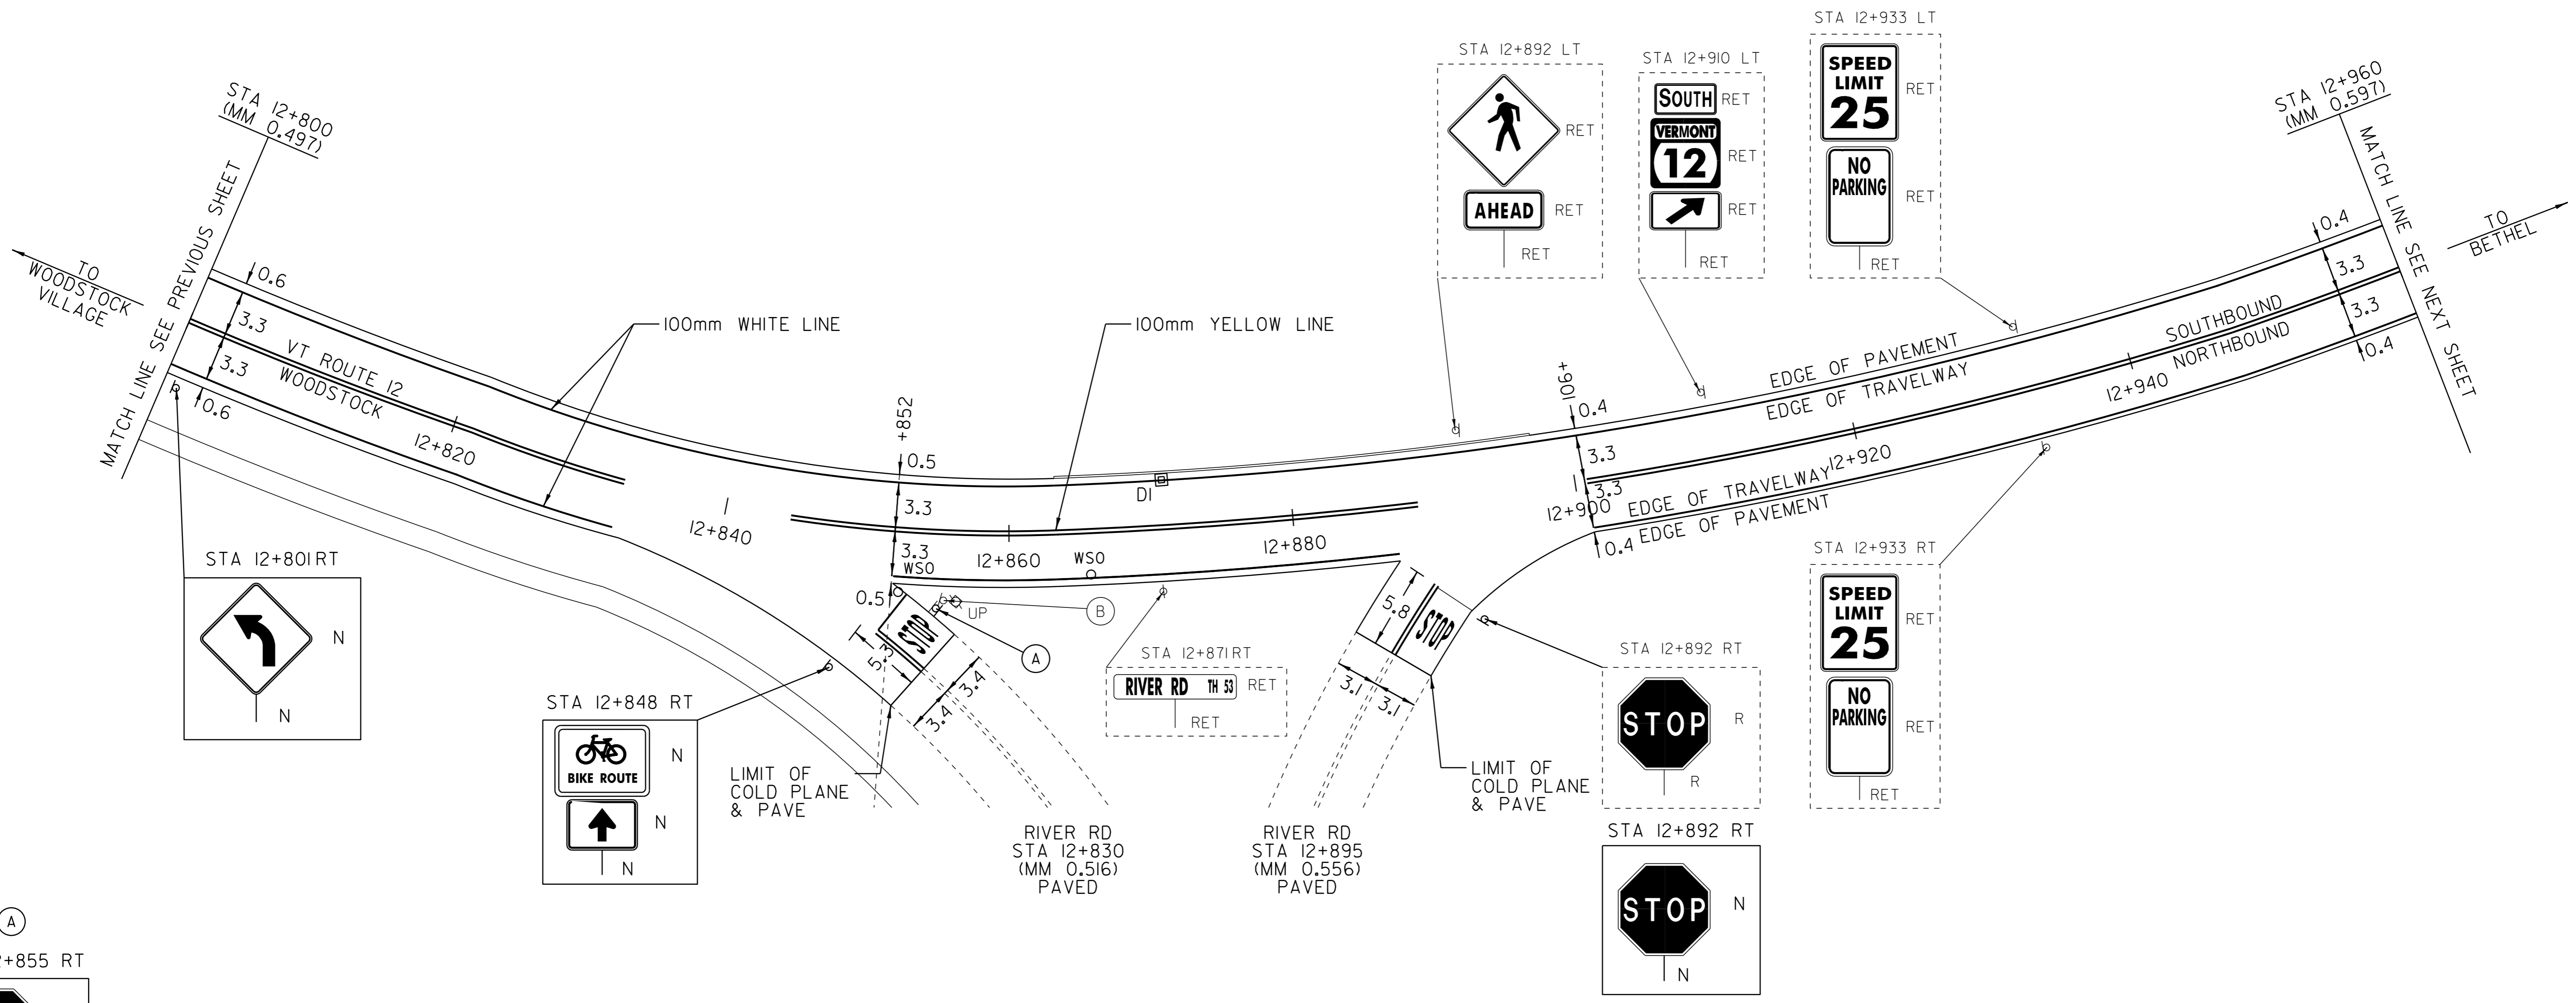

LEGEND

R	=	REMOVE EXISTING
S	=	SALVAGE
R&S	=	REMOVE AND SALVAGE
N	=	NEW
RET	=	RETAIN
B-B	=	BACK TO BACK

NOTE: ALL DIMENSIONS IN METERS EXCEPT AS INDICATED

PAVING LAYOUT 6	PROJECT NAME: WOODSTOCK	PLOT DATE: 11-JUN-2012 16:17
	PROJECT NUMBER: STP 2509(I)S	DRAWN BY: MRS
	DESIGN FILE NAME: /pave/05c056/pc056.dgn	CHECKED BY: NLL
	IPARM FILE NAME: pc0561a06.i	SHEET 67 OF 73

NOT TO SCALE