

604.40 CHANGING ELEVATION OF DROP INLETS, CATCH BASINS OR MANHOLES

STA. 195+05, LT
STA. 195+96, LT

604.412 OR 604.415 REHAB, DIS, CBS OR MHS, CLASS 1 OR 11

STA. 195+56, RT
STA. 196+49, RT

604.42 CHANGING ELEVATION OF SEWER MANHOLES

STA. 195+50, RT

616.28 CAST-IN-PLACE CONCRETE CURB, TYPE B

STA. 195+68 TO 195+89, LT

616.41 REMOVAL OF EXISTING CURB

STA. 195+68 TO 195+89, LT

618.10 PORTLAND CEMENT CONCRETE SIDEWALK, 5 INCH

STA. 195+20 TO 195+34, RT

STA. 195+21 TO 195+36, LT

STA. 195+68 TO 195+89, LT

618.30 DETECTABLE WARNING SURFACE

STA. 195+27, LT

STA. 195+27, RT

STA. 195+32, LT

STA. 195+74, LT

629.20 ADJUST ELEVATION OF VALVE BOX

STA. 195+61, LT

646.401 DURABLE 4 INCH WHITE LINE, TYPE I TAPE
(ALL LINES WILL INCLUDE EDGE LINE BREAKS AND RADIUS FOR SIDE ROADS)
STA. 195+00 TO 197+47.2, SOLID LT & RT
STA. 195+52, DOUBLE SOLID LT (BUTLER ST)

646.411 DURABLE 4 INCH YELLOW LINE, TYPE I TAPE
(ALL LINES WILL INCLUDE C BREAKS FOR SIDE ROADS)
STA. 195+00 TO 197+47.2, SOLID LT & RT
STA. 195+52, DOUBLE SOLID LT (BUTLER ST)

646.481 DURABLE 24 INCH STOP BAR, TYPE I TAPE

STA. 195+52, LT (BUTLER ST)

646.491 DURABLE LETTER OR SYMBOL, TYPE I TAPE

STA. 195+52, LT "STOP" (BUTLER ST)

646.501 DURABLE CROSSWALK MARKING, TYPE I TAPE

STA. 195+27, LT & RT

STA. 195+40 - 195+65, LT

646.602 TEMPORARY 4 INCH WHITE LINE, PAINT
(ALL LINES WILL INCLUDE EDGE LINE BREAKS AND RADIUS FOR SIDE ROADS)
STA. 195+00 TO 197+47.2, SOLID LT & RT
STA. 195+52, DOUBLE SOLID LT (BUTLER ST)

646.612 TEMPORARY 4 INCH YELLOW LINE, PAINT
(ALL LINES WILL INCLUDE C BREAKS FOR SIDE ROADS)
STA. 195+00 TO 197+47.2, SOLID LT & RT
STA. 195+52, DOUBLE SOLID LT (BUTLER ST)

646.682 TEMPORARY 24 INCH STOP BAR, PAINT

STA. 195+52, LT (BUTLER ST)

646.692 TEMPORARY LETTER OR SYMBOL, PAINT

STA. 195+52, LT "STOP" (BUTLER ST)


646.702 TEMPORARY CROSSWALK MARKING, PAINT

STA. 195+27, LT & RT

STA. 195+40 - 195+65, LT

675.50 REMOVING SIGNS
AS SHOWN - 11

675.60 ERECTING SALVAGED SIGNS
AS SHOWN - 6

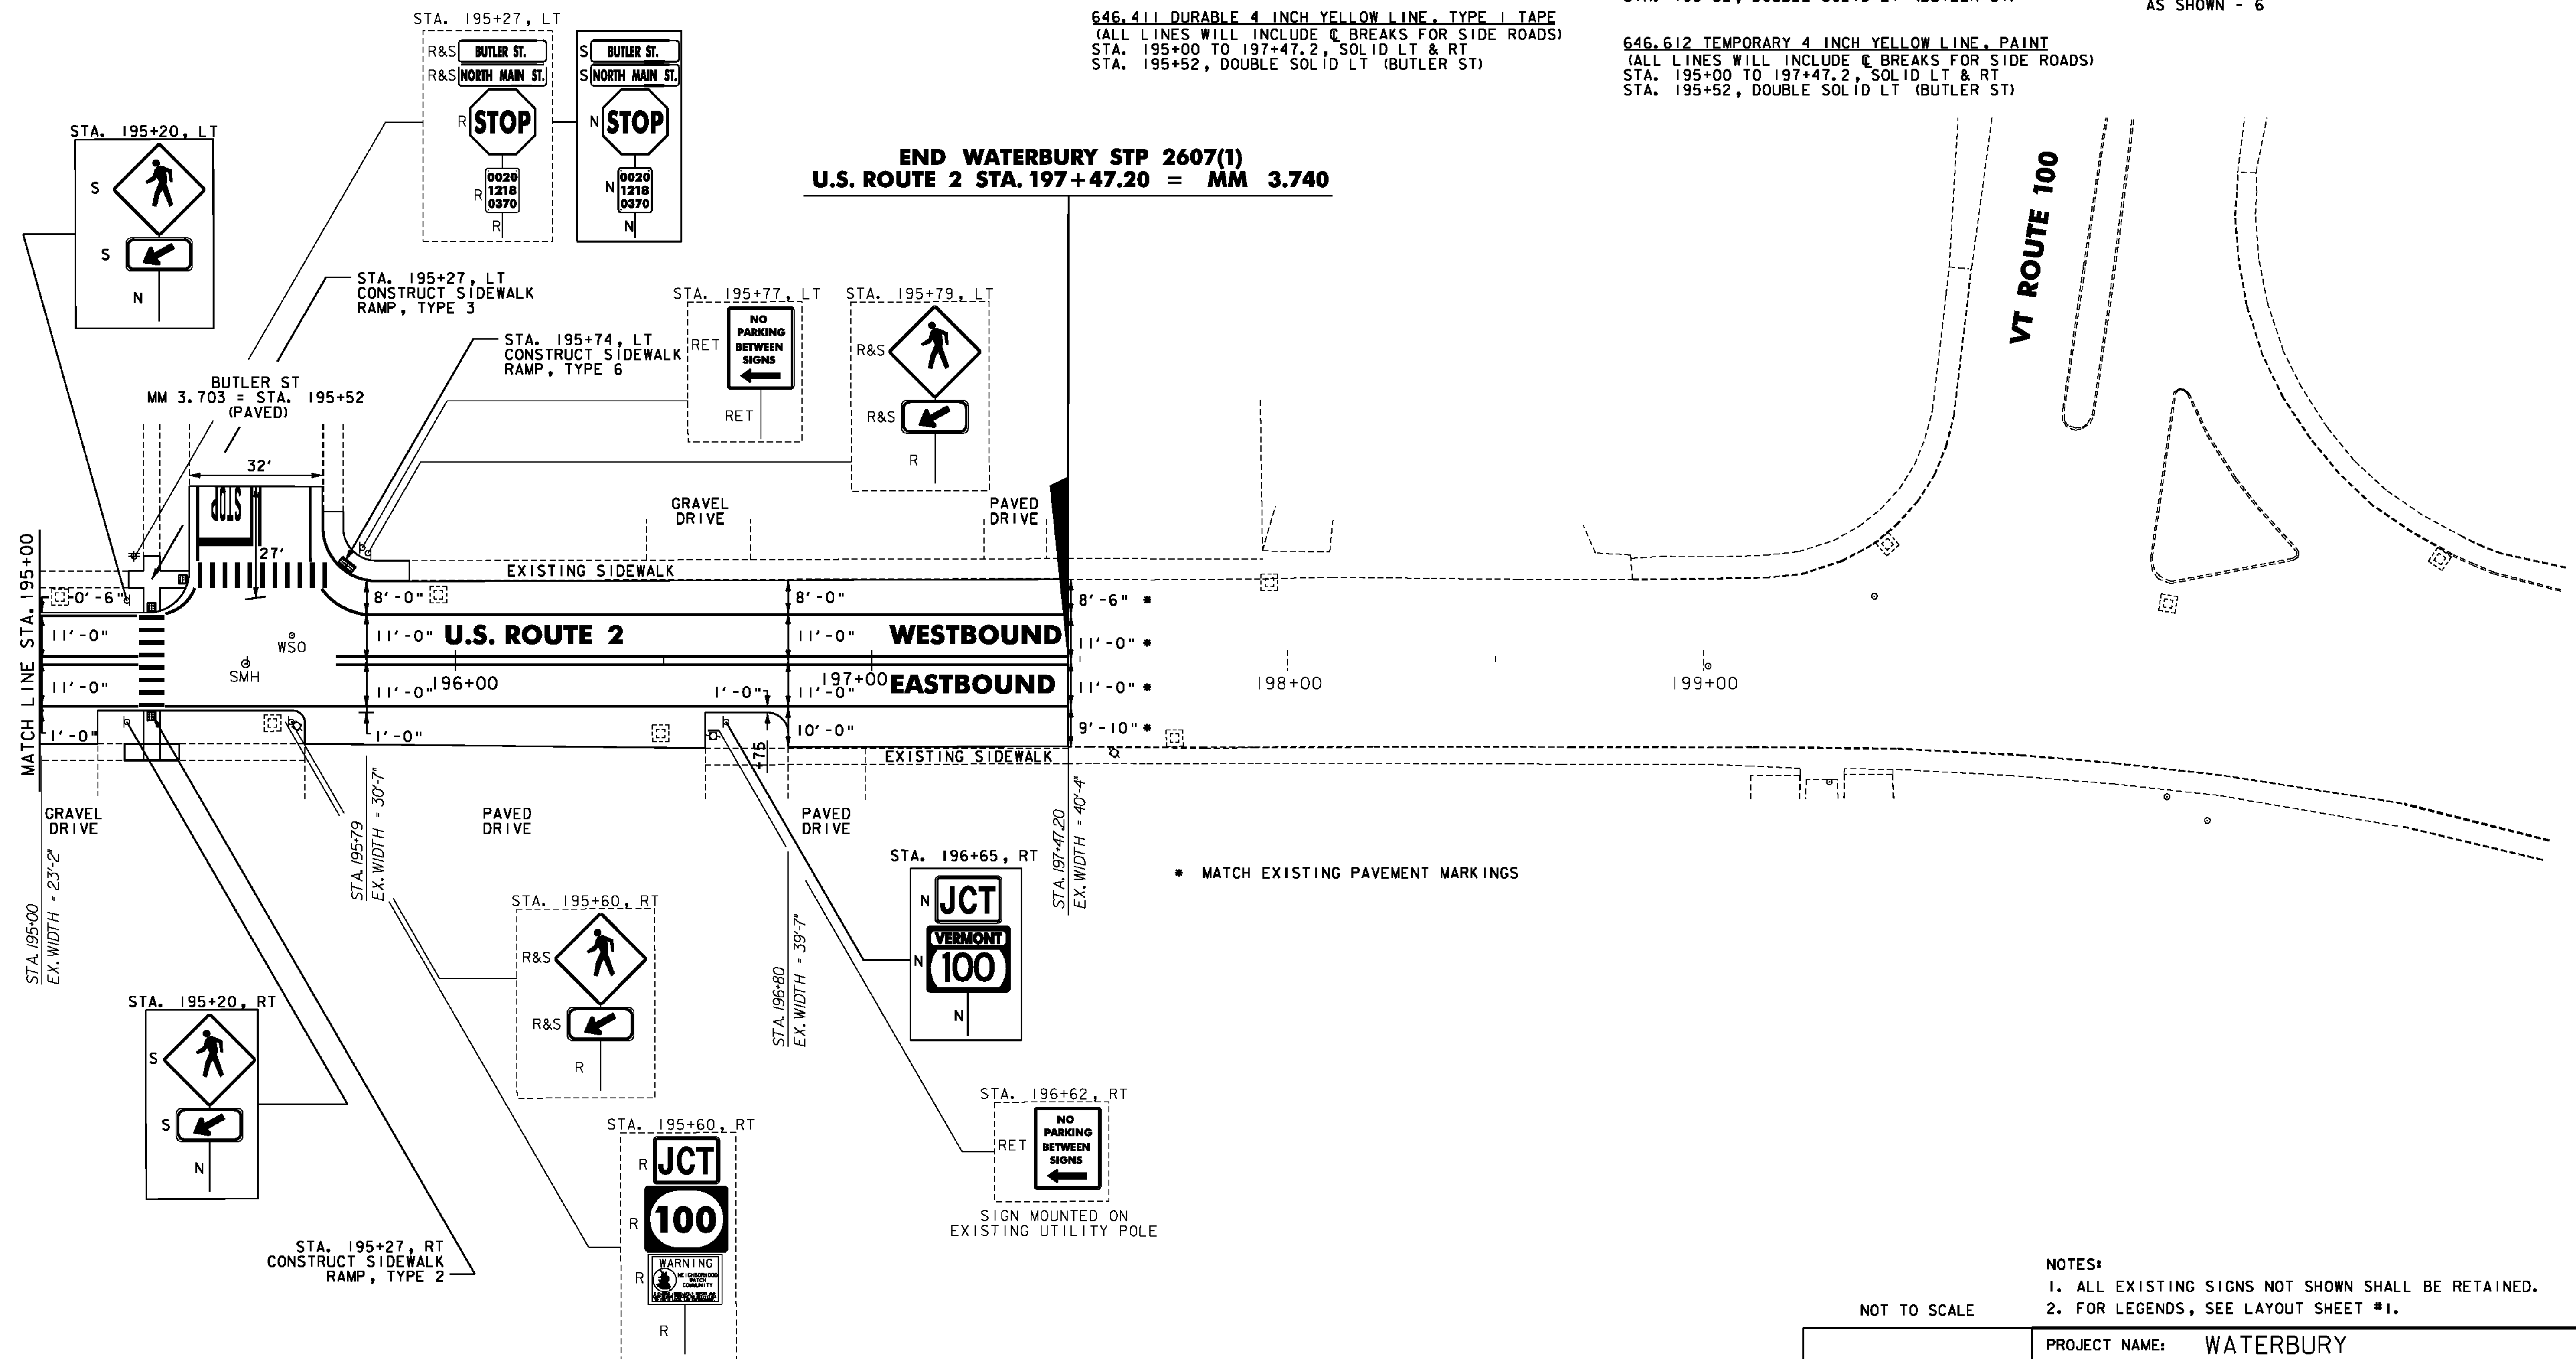

END WATERBURY STP 2607(1)
U.S. ROUTE 2 STA. 197+47.20 = MM 3.740

VT ROUTE 100

▪ MATCH EXISTING PAVEMENT MARKINGS

NOT TO SCALE

NOTES:
1. ALL EXISTING SIGNS NOT SHOWN SHALL BE RETAINED.
2. FOR LEGENDS, SEE LAYOUT SHEET #1.

PROJECT LAYOUT SHEET #3



PROJECT NAME: WATERBURY	PLOT DATE: 12/7/2010
PROJECT NUMBER: STP 2607(1)	DRAWN BY: STANTEC
FILE NAME: p06b038.dgn	CHECKED BY: STANTEC
PROJECT LEADER: JLL	SHEET 15 OF 49
DESIGNED BY: STANTEC	
IPARM FILE: p06b038i01.i	