

604.412 OR 604.415 REHAB,  
Dis. CBS OR MHS, CLASS I OR II  
STA. 49+94, LT

616.35 TREATED TIMBER CURB  
STA. 46+55 TO 51+50, RT

617.10 RELOCATE MAILBOX, SINGLE SUPPORT  
STA. 49+53, RT

621.20 STEEL BEAM GUARDRAIL, GALVANIZED  
STA. 46+42.0 TO 51+50.0, RT

621.60 ANCHOR FOR STEEL BEAM RAIL  
STA. 46+42.0, RT

621.80 REMOVAL AND DISPOSAL OF GUARDRAIL  
STA. 46+42.0 TO 51+50.0, RT

646.401 DURABLE 4 INCH WHITE LINE, TYPE I TAPE  
(ALL LINES WILL INCLUDE EDGE LINE BREAKS AND  
RADIi FOR SIDE ROADS)  
STA. 45+50 TO 51+50, SOLID LT & RT  
STA. 45+50 TO 46+64, DOTTED LT

646.411 DURABLE 4 INCH YELLOW LINE, TYPE I TAPE  
(ALL LINES WILL INCLUDE C BREAKS FOR SIDE ROADS)  
STA. 45+50 TO 45+90, DOUBLE SOLID RT  
STA. 45+90 TO 47+46, DOUBLE SOLID LT & RT  
STA. 47+46 TO 51+50, SOLID LT & RT

646.451 DURABLE 8 INCH YELLOW LINE, TYPE I TAPE  
STA. 45+90 TO 47+46, C (DIAGONALS)

646.491 DURABLE LETTER OR SYMBOL, TYPE I TAPE  
STA. 48+80, LT "AHEAD"  
STA. 49+20, LT "SIGNAL"

646.602 TEMPORARY 4 INCH WHITE LINE, PAINT  
(ALL LINES WILL INCLUDE EDGE LINE BREAKS AND  
RADIi FOR SIDE ROADS)  
STA. 45+50 TO 51+50, SOLID LT & RT  
STA. 45+50 TO 46+64, DOTTED LT


646.612 TEMPORARY 4 INCH YELLOW LINE, PAINT  
(ALL LINES WILL INCLUDE C BREAKS FOR SIDE ROADS)  
STA. 45+50 TO 45+90, DOUBLE SOLID RT  
STA. 45+90 TO 47+46, DOUBLE SOLID LT & RT  
STA. 47+46 TO 51+50, SOLID LT & RT

646.652 TEMPORARY 8 INCH YELLOW LINE, PAINT  
STA. 45+90 TO 47+46, C (DIAGONALS)

646.692 TEMPORARY LETTER OR SYMBOL, PAINT  
STA. 48+80, LT "AHEAD"  
STA. 49+20, LT "SIGNAL"

675.50 REMOVING SIGNS  
AS SHOWN - I

675.60 ERECTING SALVAGED SIGNS  
AS SHOWN - I

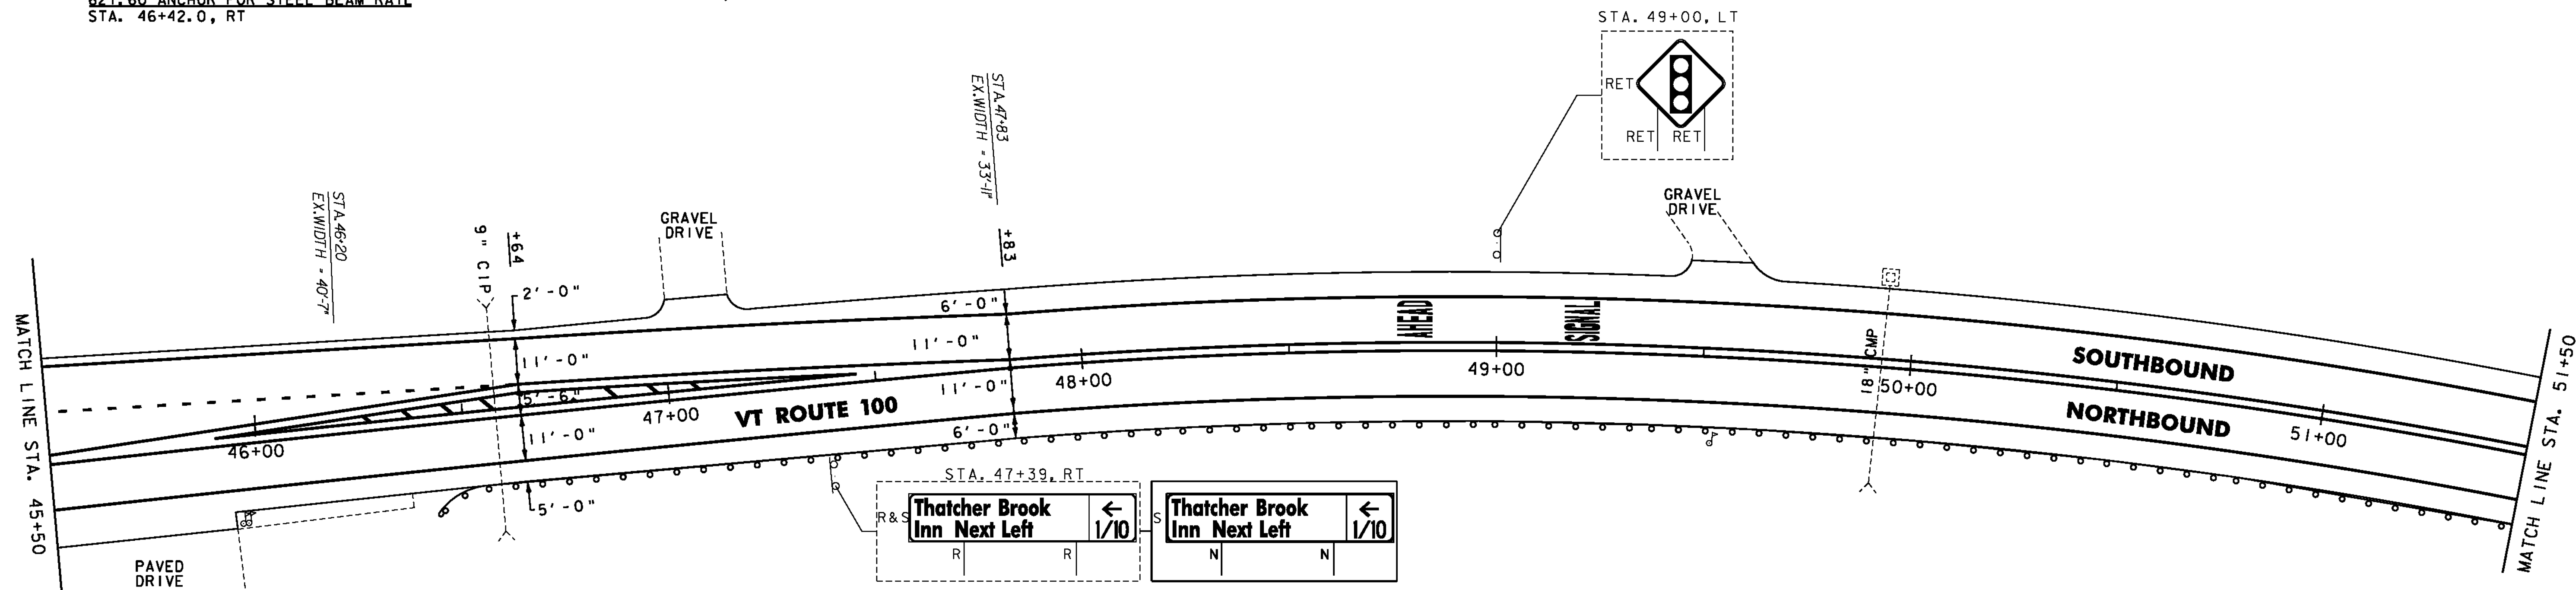

604.412 OR 604.415 REHAB,  
Dis. CBS OR MHS, CLASS I OR II

STA. 52+04, LT  
STA. 52+04, LT  
STA. 54+50, RT  
STA. 54+51, LT  
STA. 56+96, RT  
STA. 57+18, LT

604.42 CHANGING ELEVATION OF SEWER MANHOLES  
STA. 56+96, RT

616.35 TREATED TIMBER CURB  
STA. 51+50 TO 52+00, RT

621.20 STEEL BEAM GUARDRAIL, GALVANIZED  
STA. 51+50.0 TO 52+17.0, RT  
STA. 54+11.0 TO 55+23.5, RT

621.60 ANCHOR FOR STEEL BEAM RAIL  
STA. 52+17.0, RT  
STA. 54+11.0, RT  
STA. 55+23.5, RT

621.80 REMOVAL AND DISPOSAL OF GUARDRAIL  
STA. 51+50.0 TO 52+17.0, RT  
STA. 54+11.0 TO 55+14.0, RT

646.401 DURABLE 4 INCH WHITE LINE, TYPE I TAPE  
(ALL LINES WILL INCLUDE EDGE LINE BREAKS AND  
RADIi FOR SIDE ROADS)  
STA. 51+50 TO 57+50, SOLID LT & RT  
STA. 53+83, DOUBLE SOLID RT (MILL RD)

646.411 DURABLE 4 INCH YELLOW LINE, TYPE I TAPE  
(ALL LINES WILL INCLUDE C BREAKS FOR SIDE ROADS)  
STA. 51+50 TO 57+50, SOLID LT & RT  
STA. 53+83, DOUBLE SOLID RT (MILL RD)

646.441 DURABLE 8 INCH WHITE LINE, TYPE I TAPE  
STA. 54+54 TO 54+66, LT (HYDRANT)

646.481 DURABLE 24 INCH STOP BAR, TYPE I TAPE  
STA. 53+83, RT (MILL RD)

646.491 DURABLE LETTER OR SYMBOL, TYPE I TAPE  
STA. 53+83, RT "STOP"


646.602 TEMPORARY 4 INCH WHITE LINE, PAINT  
(ALL LINES WILL INCLUDE EDGE LINE BREAKS AND  
RADIi FOR SIDE ROADS)  
STA. 51+50 TO 57+50, SOLID LT & RT  
STA. 53+83, DOUBLE SOLID RT (MILL RD)

646.642 TEMPORARY 8 INCH WHITE LINE, PAINT  
STA. 54+54 TO 54+66, LT (HYDRANT)

646.682 TEMPORARY 24 INCH STOP BAR, PAINT  
STA. 53+83, RT (MILL RD)

646.692 TEMPORARY LETTER OR SYMBOL, PAINT  
STA. 53+83, RT "STOP"

646.612 TEMPORARY 4 INCH YELLOW LINE, PAINT  
(ALL LINES WILL INCLUDE C BREAKS FOR SIDE ROADS)  
STA. 51+50 TO 57+50, SOLID LT & RT  
STA. 53+83, DOUBLE SOLID RT (MILL RD)

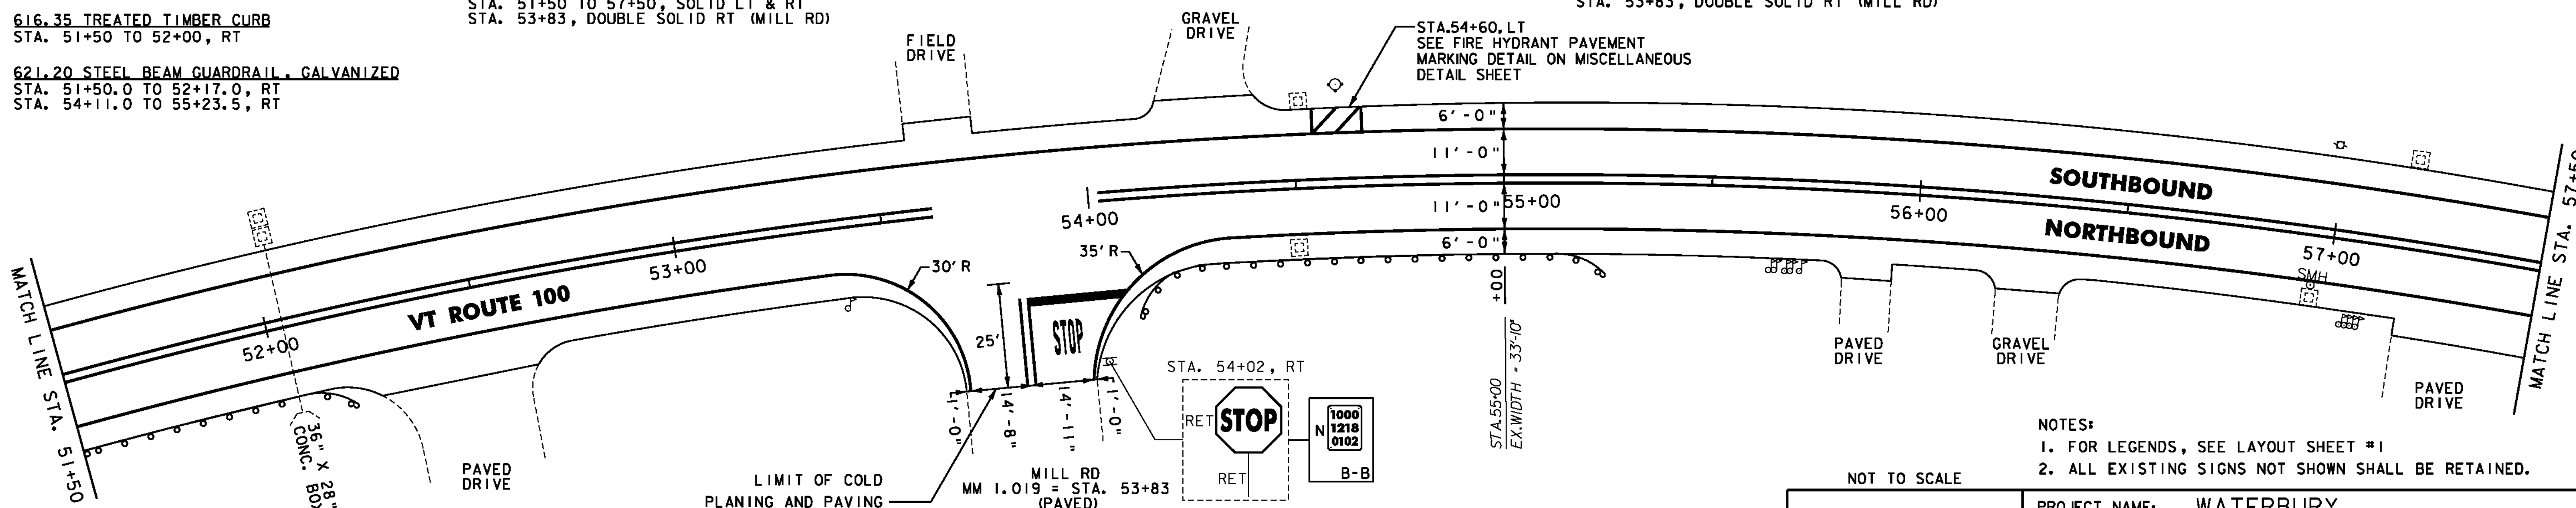

- NOTES:  
1. FOR LEGENDS, SEE LAYOUT SHEET #1  
2. ALL EXISTING SIGNS NOT SHOWN SHALL BE RETAINED.

NOT TO SCALE

**PROJECT  
LAYOUT  
SHEET #9**



PROJECT NAME: WATERBURY  
PROJECT NUMBER: STP 2201(I)

FILE NAME: p99b154.dgn  
PROJECT LEADER: JLL  
DESIGNED BY: STANTEC  
IPARM FILE: p99b154109.i

PLOT DATE: 12/7/2010  
DRAWN BY: STANTEC  
CHECKED BY: STANTEC  
SHEET 38 OF 49