

621.20 STEEL BEAM GUARDRAIL, GALVANIZED
 STA. 73+19.0 TO 73+56.5, LT
 STA. 73+19.0 TO 73+56.5, RT
 STA. 73+81.5 TO 74+06.5, LT
 STA. 73+81.5 TO 74+06.5, RT

621.206 STEEL BEAM GUARDRAIL, GALVANIZED/NESTED
 STA. 73+56.5 TO 73+81.5, LT
 STA. 73+56.5 TO 73+81.5, RT

646.401 DURABLE 4 INCH WHITE LINE, TYPE I TAPE
 (ALL LINES WILL INCLUDE EDGE LINE BREAKS AND
 RADII FOR SIDE ROADS)
 STA. 69+50 TO 75+50, SOLID RT
 STA. 69+50 TO 69+57, SOLID LT (LANE LINE)
 STA. 69+84 TO 75+50, SOLID LT

646.411 DURABLE 4 INCH YELLOW LINE, TYPE I TAPE
 (ALL LINES WILL INCLUDE C BREAKS FOR SIDE ROADS)
 STA. 70+00 TO 73+00, DOUBLE SOLID LT & C
 STA. 73+00 TO 75+50, SOLID LT & RT

621.60 ANCHOR FOR STEEL BEAM RAIL
 STA. 73+19.0, LT
 STA. 73+19.0, RT
 STA. 74+06.5, LT
 STA. 74+06.5, RT


621.80 REMOVAL AND DISPOSAL OF GUARDRAIL
 STA. 73+15.5 TO 74+03.0, LT

646.451 DURABLE 8 INCH YELLOW LINE, TYPE I TAPE
 STA. 70+00 TO 73+00, LT (DIAGONALS)

646.602 TEMPORARY 4 INCH WHITE LINE, PAINT
 (ALL LINES WILL INCLUDE EDGE LINE BREAKS AND
 RADII FOR SIDE ROADS)
 STA. 69+50 TO 75+50, SOLID RT
 STA. 69+50 TO 69+57, SOLID LT (LANE LINE)
 STA. 69+84 TO 75+50, SOLID LT

646.612 TEMPORARY 4 INCH YELLOW LINE, PAINT
 (ALL LINES WILL INCLUDE C BREAKS FOR SIDE ROADS)
 STA. 70+00 TO 73+00, DOUBLE SOLID LT & C
 STA. 73+00 TO 75+50, SOLID LT & RT

646.652 TEMPORARY 8 INCH YELLOW LINE, PAINT
 STA. 70+00 TO 73+00, LT (DIAGONALS)

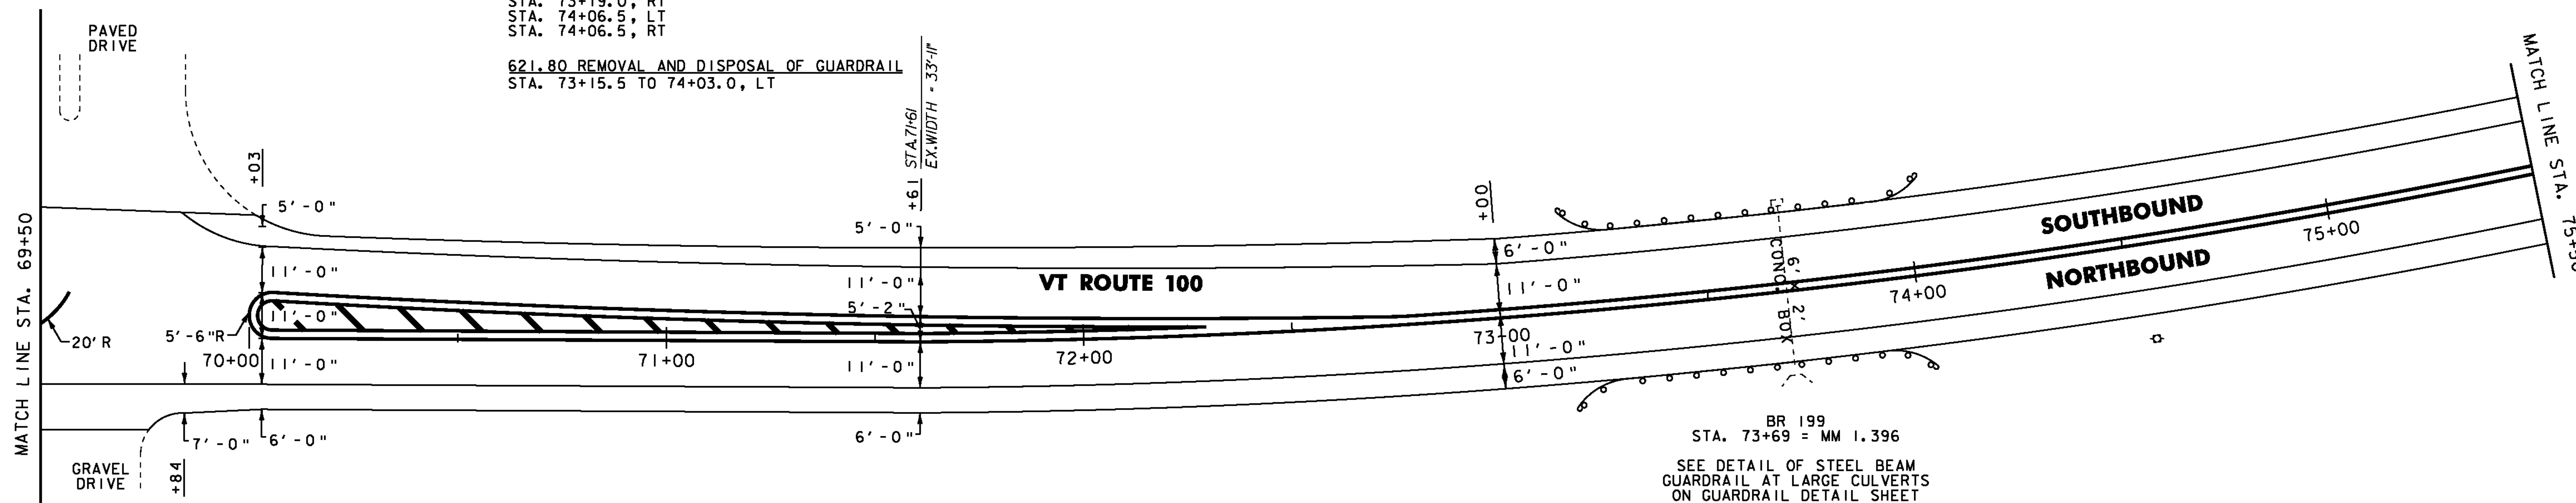

621.20 STEEL BEAM GUARDRAIL, GALVANIZED
 STA. 78+32.0 TO 80+94.5, RT

621.60 ANCHOR FOR STEEL BEAM RAIL
 STA. 78+32.0, RT
 STA. 80+94.5, RT

621.80 REMOVAL AND DISPOSAL OF GUARDRAIL
 STA. 78+32.0 TO 80+92.0, RT

646.401 DURABLE 4 INCH WHITE LINE, TYPE I TAPE
 (ALL LINES WILL INCLUDE EDGE LINE BREAKS AND
 RADII FOR SIDE ROADS)
 STA. 75+50 TO 81+50, SOLID LT & RT


646.411 DURABLE 4 INCH YELLOW LINE, TYPE I TAPE
 (ALL LINES WILL INCLUDE C BREAKS FOR SIDE ROADS)
 STA. 75+50 TO 81+50, SOLID LT & RT

646.602 TEMPORARY 4 INCH WHITE LINE, PAINT
 (ALL LINES WILL INCLUDE EDGE LINE BREAKS AND
 RADII FOR SIDE ROADS)
 STA. 75+50 TO 81+50, SOLID LT & RT

646.612 TEMPORARY 4 INCH YELLOW LINE, PAINT
 (ALL LINES WILL INCLUDE C BREAKS FOR SIDE ROADS)
 STA. 75+50 TO 81+50, SOLID LT & RT

675.50 REMOVING SIGNS
 AS SHOWN - 2

675.60 ERECTING SALVAGED SIGNS
 AS SHOWN - 2

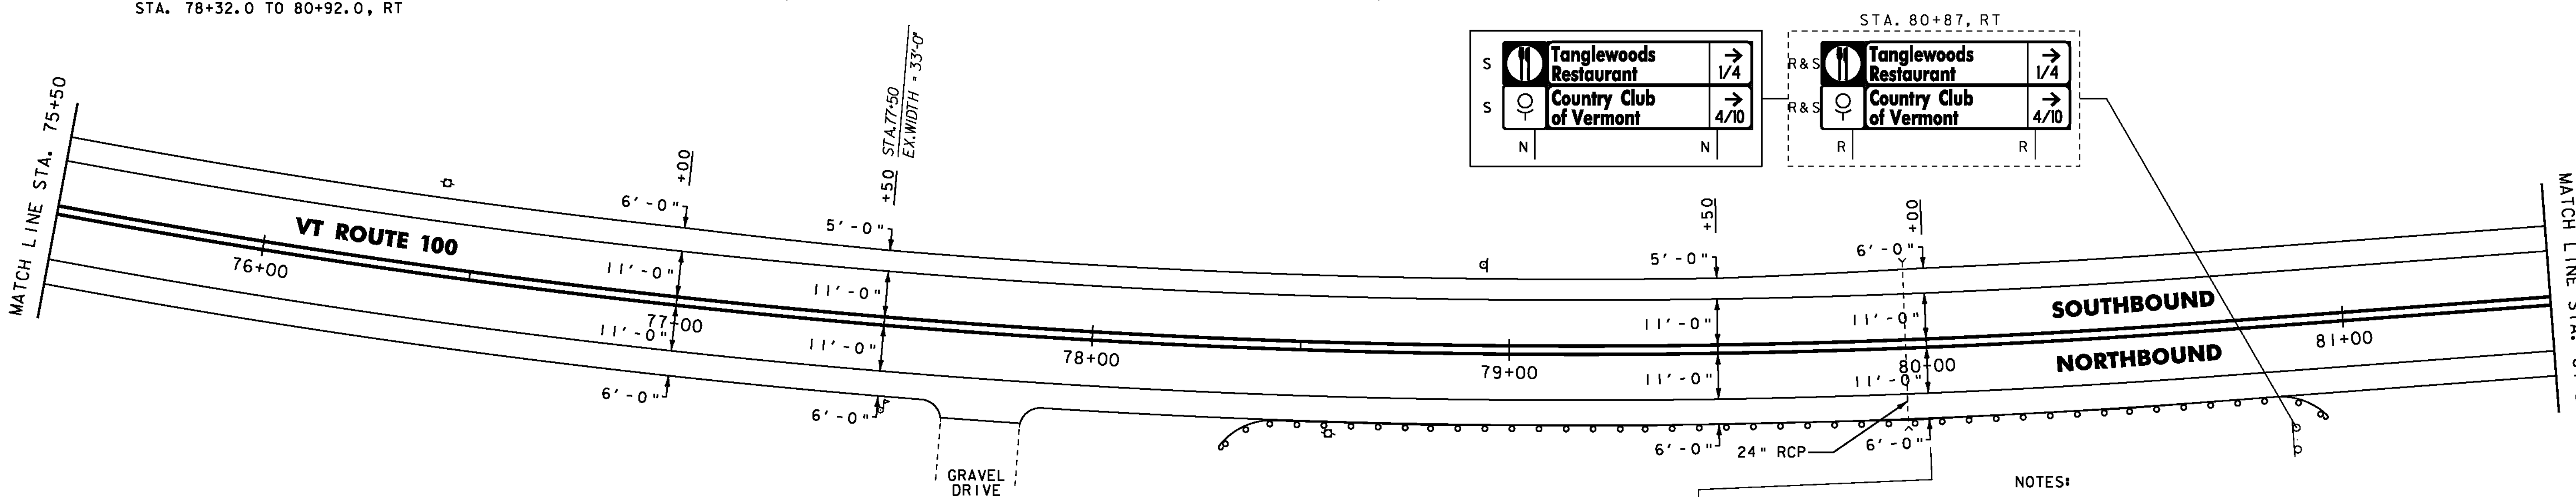

NOTES:
 1. FOR LEGENDS, SEE LAYOUT SHEET #1
 2. ALL EXISTING SIGNS NOT SHOWN SHALL BE RETAINED.

NOT TO SCALE

**PROJECT
 LAYOUT
 SHEET #11**

PROJECT NAME: WATERBURY
 PROJECT NUMBER: STP 220(I)

FILE NAME: p99b154.dgn
 PROJECT LEADER: JLL
 DESIGNED BY: STANTEC
 IPARM FILE: p99b154111.i

PLOT DATE: 27-JAN-2011
 DRAWN BY: STANTEC
 CHECKED BY: STANTEC
 SHEET 40 OF 49

