

604.412 REHAB. DROP INLETS, CATCH BASINS, MANHOLE, CLASS I

621.60 ANCHOR FOR STEEL BEAM RAIL

646.436 DURABLE 6 INCH YELLOW LINE, RECESSED

MANCHESTER: STA. D7+62.0 RT

MANCHESTER: STA. I4+00.5 - I4+15 RT

MANCHESTER: STA. D3+00.00 - STA. D17+21.00 EDGE LINE LT  
STA. E0+00.00 - STA. E10+00.00 EDGE LINE LT

621.20 STEEL BEAM GUARDRAIL, GALVANIZED

616.35 TREATED TIMBER CURB

646.632 TEMPORARY 6 INCH YELLOW LINE, PAINT

MANCHESTER: STA. D14+15 RT III5 LF  
STA. D3+00.0 - STA. D13+55.5 RT (I055.0 LF)

MANCHESTER: STA. D3+71.0 - STA. D8+00.0 RT (429.0 LF)

MANCHESTER: STA. D3+00.00 - STA. D17+21.00 EDGE LINE LT  
STA. E0+00.00 - STA. E10+00.00 EDGE LINE LT

621.50 MANUFACTURED TERMINAL SECTION, FLARED

MANCHESTER: STA. D3+71.0 - STA. D8+00.0 RT (429.0 LF)

646.426 DURABLE 6 INCH WHITE LINE, RECESSED

MANCHESTER: STA. D13+55.5 - STA. D13+93.0 RT ELIMINATED

MANCHESTER: STA. D3+00.00 - STA. D17+21.00 EDGE LINE RT  
STA. D15+82.00 - STA. D17+12.00 LANE LINE CL  
STA. E0+00.00 - STA. E10+00.00 EDGE LINE RT

646.622 TEMPORARY 6 INCH WHITE LINE, PAINT

MANCHESTER: STA. D3+00.00 - STA. D17+21.00 EDGE LINE RT  
STA. D15+82.00 - STA. D17+12.00 LANE LINE CL  
STA. E0+00.00 - STA. E10+00.00 EDGE LINE RT

646.482 DURABLE 24 INCH STOP BAR, THERMOPLASTIC

MANCHESTER: STA. D17+05.00, RAMP D

646.682 TEMPORARY 24 INCH STOP BAR, PAINT

MANCHESTER: STA. D17+05.00, RAMP D

646.492 DURABLE LETTER OR SYMBOL, THERMOPLASTIC


MANCHESTER: STA. D9+84.00, RT, RAMP D "S,T,O,P" (4 EA)  
STA. D10+16.00, RT, RAMP D "A,H,E,A,D" (5 EA)  
STA. D14+11.00, CL, RAMP D WRONG WAY ARROW (1EA)  
STA. D15+84.00, LT, RAMP D "O,N,L,Y" (4 EA)  
STA. D15+84.00, RT, RAMP D "O,N,L,Y" (4 EA)  
STA. D16+22.00, LT, RAMP D ARROW (1EA)  
STA. D16+22.00, RT, RAMP D ARROW (1EA)  
STA. D17+00.00, LT, RAMP D "S,T,O,P" (4 EA)  
STA. D17+00.00, RT, RAMP D "S,T,O,P" (4 EA)  
STA. E8+69.00, CL, RAMP E WRONG WAY ARROW (1EA)

646.692 TEMPORARY LETTER OR SYMBOL, PAINT

MANCHESTER: STA. D9+84.00, RT, RAMP D "S,T,O,P" (4 EA)  
STA. D10+16.00, RT, RAMP D "A,H,E,A,D" (5 EA)  
STA. D14+11.00, CL, RAMP D WRONG WAY ARROW (1EA)  
STA. D16+22.00, LT, RAMP D ARROW (1EA)  
STA. D16+22.00, RT, RAMP D ARROW (1EA)  
STA. D17+00.00, LT, RAMP D "S,T,O,P" (4 EA)  
STA. D17+00.00, RT, RAMP D "S,T,O,P" (4 EA)  
STA. E8+69.00, CL, RAMP E WRONG WAY ARROW (1EA)

675.50 REMOVING SIGNS

AS SHOWN - 43 47

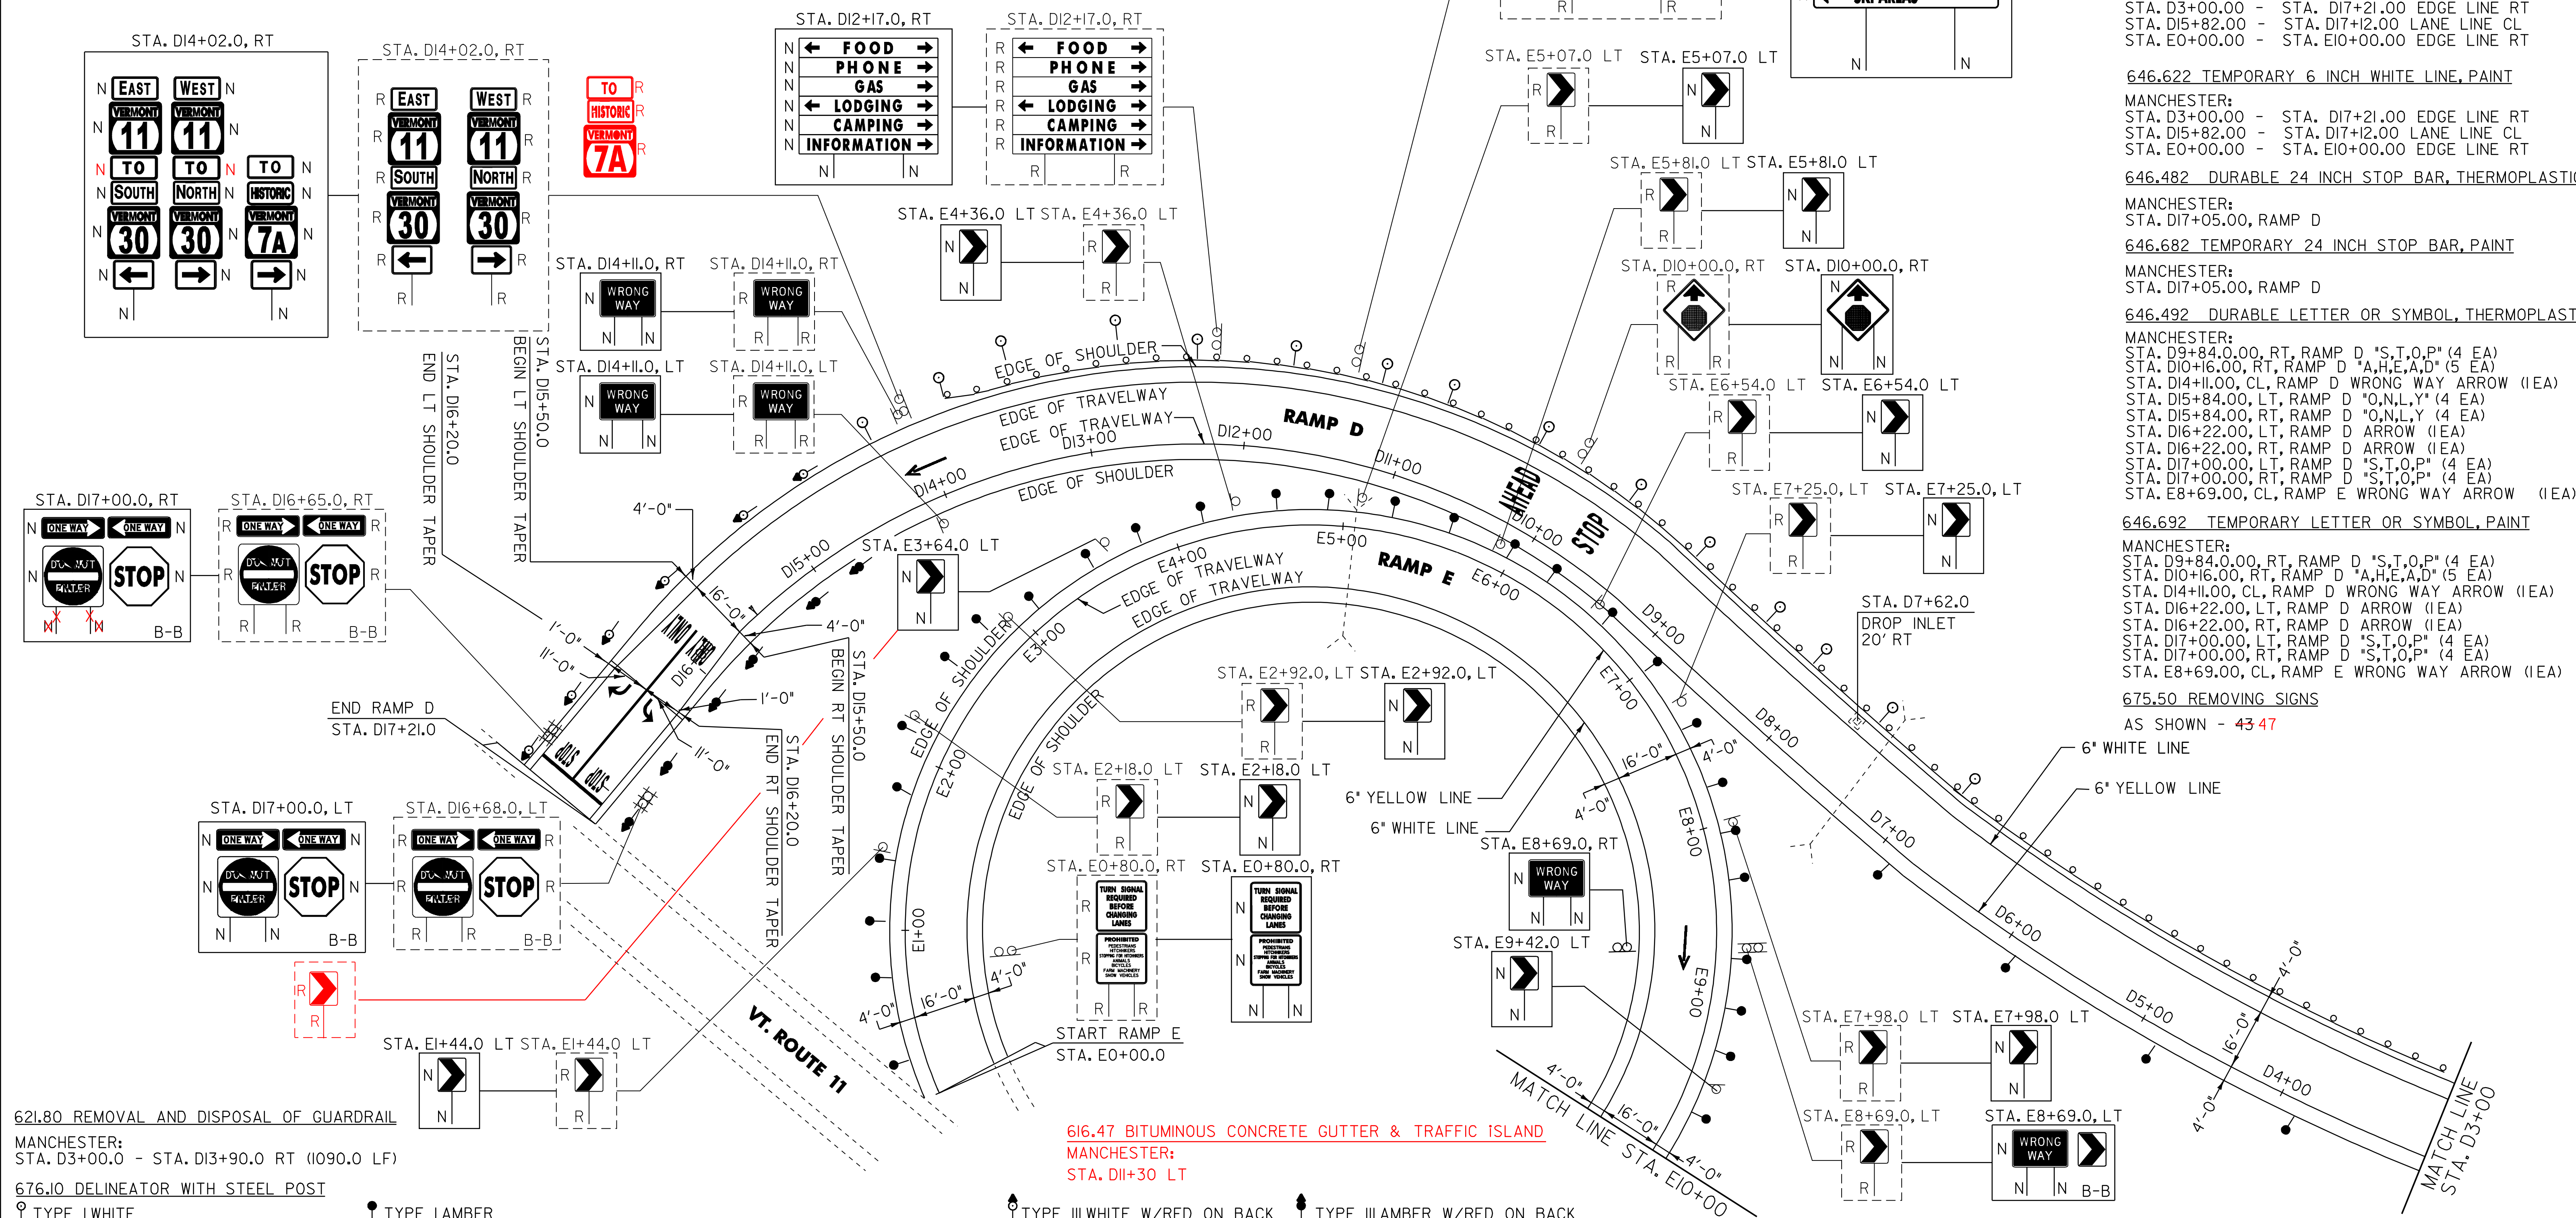

621.80 REMOVAL AND DISPOSAL OF GUARDRAIL

616.47 BITUMINOUS CONCRETE GUTTER & TRAFFIC ISLAND

NOT TO SCALE

MANCHESTER: STA. D3+00.0 - STA. D13+90.0 RT (I090.0 LF)

MANCHESTER: STA. D11+30 LT

PROJECT NAME: MANCHESTER - DORSET  
PROJECT NUMBER: NH 2608(I)S

676.10 DELINEATOR WITH STEEL POST

MANCHESTER: STA. D11+30 LT

FILE NAME: p06b040.dgn  
PROJECT LEADER: D.E.G.  
DESIGNED BY: M.J.M.  
IPARM FILE: p06b040I02.I

MANCHESTER: STA. D6+91.00 RT  
STA. D7+46.0 RT  
STA. D8+01.0 RT  
STA. D8+56.0 RT  
STA. D9+11.0 RT  
STA. D9+66.0 RT  
STA. D10+21.0 RT  
STA. D10+76.0 RT

STA. D11+31.0 RT  
STA. D11+86.0 RT  
STA. D12+41.0 RT  
STA. D12+96.0 RT  
STA. D13+51.0 RT  
STA. D13+93.0 RT  
STA. D14+06.0 RT

STA. D3+91.0 LT  
STA. D4+91.0 LT  
STA. D5+91.0 LT  
STA. D6+91.0 LT  
STA. E0+35.0 LT  
STA. E0+70.0 LT  
STA. E1+05.0 LT  
STA. E1+40.0 LT  
STA. E1+75.0 LT

STA. E2+10.0 LT  
STA. E2+45.0 LT  
STA. E2+80.0 LT  
STA. E3+15.0 LT  
STA. E3+50.0 LT  
STA. E3+85.0 LT  
STA. E4+20.0 LT  
STA. E4+55.0 LT  
STA. E4+90.0 LT

STA. E5+25.0 LT  
STA. E5+60.0 LT  
STA. E5+95.0 LT  
STA. E6+30.0 LT  
STA. E6+65.0 LT  
STA. E7+00.0 LT  
STA. E7+35.0 LT  
STA. E7+70.0 LT  
STA. E8+05.0 LT

STA. E8+40.0 LT  
STA. E8+75.0 LT  
STA. E9+10.0 LT  
STA. E9+45.0 LT  
STA. E9+80.0 LT

STA. D4+61.0 RT  
STA. D5+11.0 RT  
STA. D5+61.0 RT  
STA. D6+11.0 RT  
STA. D6+61.0 RT  
STA. D7+11.0 RT

STA. D14+61.0 LT  
STA. D15+11.0 LT  
STA. D15+61.0 LT  
STA. D16+11.0 LT  
STA. D16+61.0 LT  
STA. D17+11.0 LT

**SIGN LEGEND**

- R = REMOVE
- S = SALVAGE
- N = NEW
- RET = RETAIN
- B-B = BACK TO BACK
- EXISTING = - - - - -
- NEW = \_\_\_\_\_

**PROJECT LAYOUT SHEET #2**

PROJECT NAME: MANCHESTER - DORSET	PLOT DATE: 07-JUN-2010 11
PROJECT NUMBER: NH 2608(I)S	DRAWN BY: C.A.K.
FILE NAME: p06b040.dgn	CHECKED BY: D.W.E.
PROJECT LEADER: D.E.G.	SHEET 14 OF 78
DESIGNED BY: M.J.M.	
IPARM FILE: p06b040I02.I	