

646.426 DURABLE 6 INCH WHITE LINE, RECESSED
(ALL LINES WILL INCLUDE EDGE LINE BREAKS AND RADIUS FOR TOWN HIGHWAYS)

MANCHESTER:
STA. 286+00.00 - STA. 301+00.00 LT & RT

646.622 TEMPORARY 6 INCH WHITE LINE, PAINT
(ALL LINES WILL INCLUDE EDGE LINE BREAKS AND RADIUS FOR TOWN HIGHWAYS)

MANCHESTER:
STA. 286+00.00 - STA. 301+00.00 LT & RT


646.436 DURABLE 6 INCH YELLOW LINE, RECESSED
(ALL LINES WILL INCLUDE C/L BREAKS FOR TOWN HIGHWAYS) S=SOLID, D=DASHED

MANCHESTER:
STA. 286+00.00 - STA. 299+64.00 - LT C RT
D D -
STA. 299+64.00 - STA. 301+00.00 D - S

646.632 TEMPORARY 6 INCH YELLOW LINE, PAINT
(ALL LINES WILL INCLUDE C/L BREAKS FOR TOWN HIGHWAYS) S=SOLID, D=DASHED

MANCHESTER:
STA. 286+00.00 - STA. 299+64.00 - LT C RT
D D -
STA. 299+64.00 - STA. 301+00.00 D - S

675.50 REMOVING SIGNS
AS SHOWN - 2

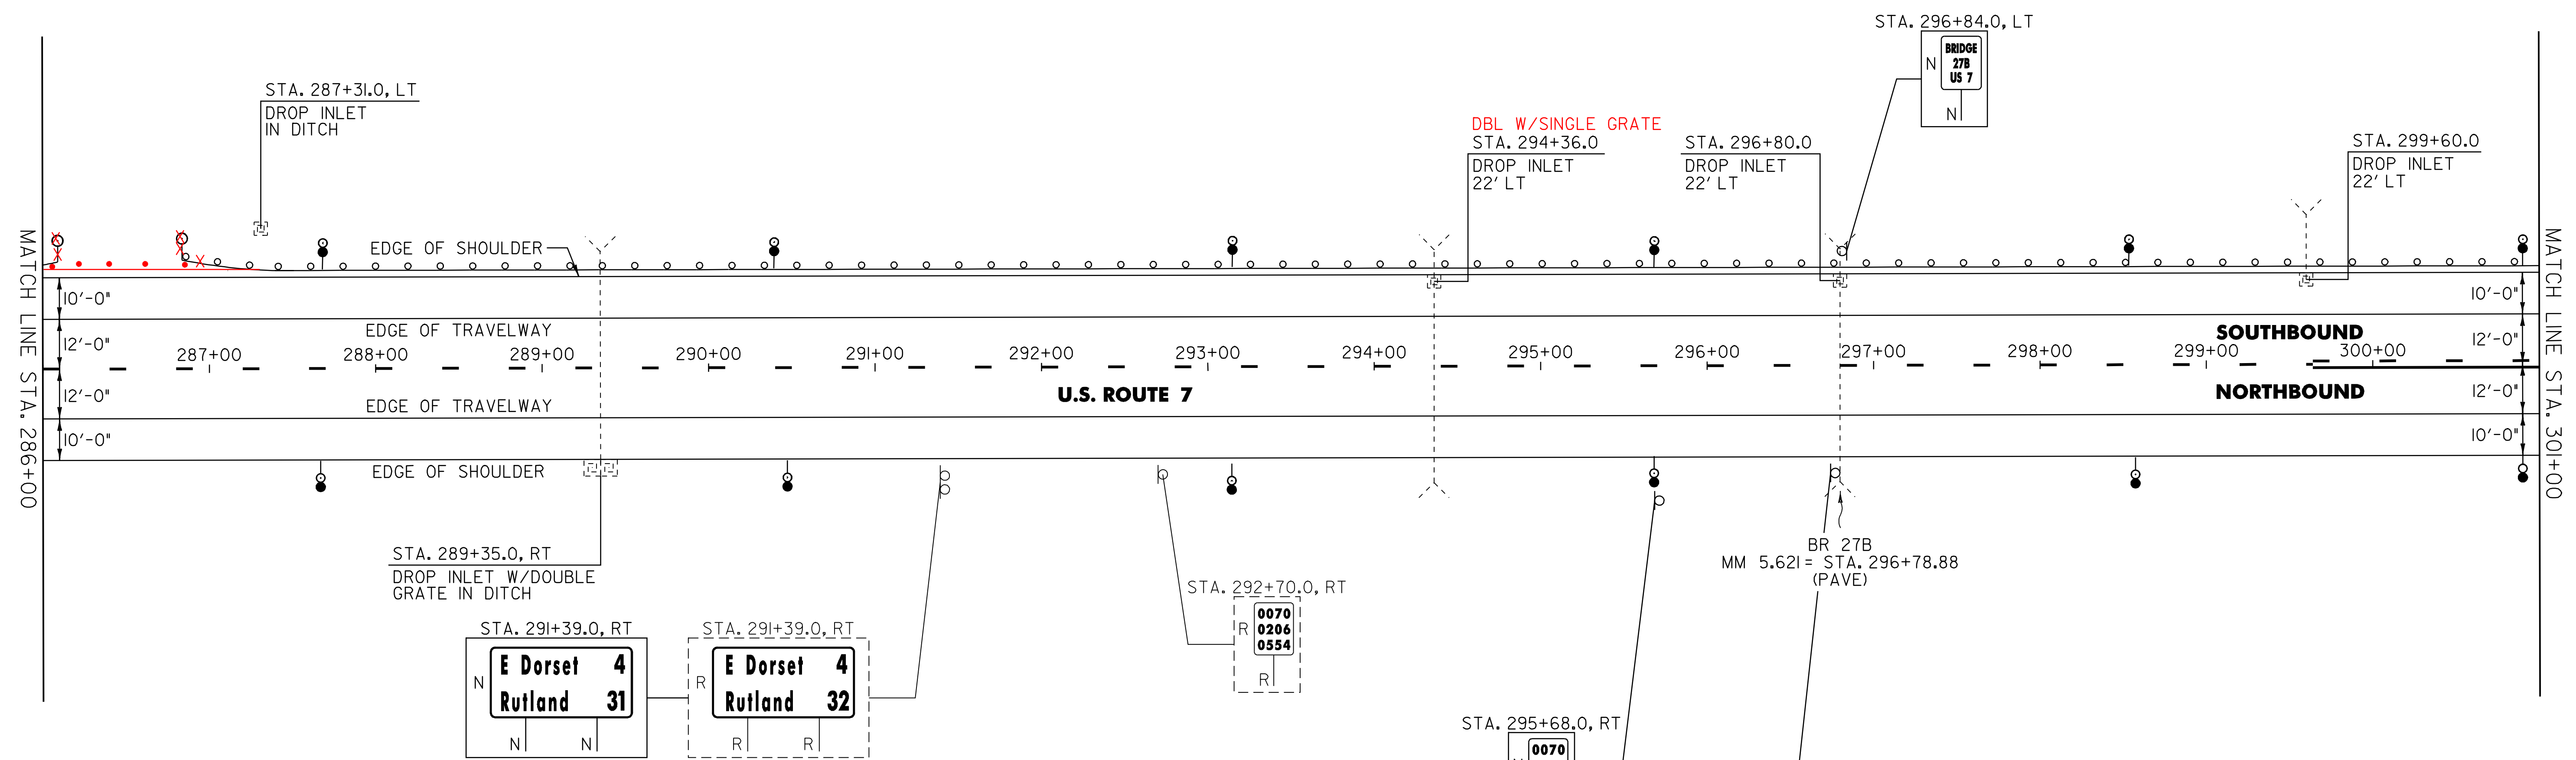

213.10 MILLED RUMBLE STRIPS

MANCHESTER:
STA. 286+00.0 - STA. 301+00.0 LT (1500.0 LF)
STA. 286+00.0 - STA. 301+00.0 RT (1500.0 LF)

604.412 REHAB. DROP INLETS, CATCH BASINS OR MANHOLES, CLASS I

MANCHESTER:
STA. 287+31.0 LT
STA. 289+35.0 RT
STA. 294+36.0 LT
STA. 296+80.0 LT
STA. 299+60.0 LT

616.35 TREATED TIMBER CURB

MANCHESTER:
STA. 292+35.0 - STA. 301+00.0 LT (865.0 LF)

621.20 STEEL BEAM GUARDRAIL, GALVANIZED

MANCHESTER: STA 286+00.0 - STA. 287+22.0 - STA. 301+00.0 LT (1378.0 LF) 1500.0 LF

621.50 MANUFACTURED TERMINAL SECTION, FLARED

MANCHESTER:
~~STA. 286+00.0 - STA. 286+21.5 LT~~
~~STA. 286+84.5 - STA. 287+22.0 LT~~

621.80 REMOVAL AND DISPOSAL OF GUARDRAIL

MANCHESTER:
STA. 287+83.0 - STA. 301+00.0 LT (1317.0 LF)

676.10 DELINEATOR WITH STEEL POST

♀ TYPE I WHITE ♂ TYPE I AMBER W/WHITE ON BACK ♂ TYPE I WHITE W/AMBER ON BACK

MANCHESTER:

STA. 286+21.5 LT	STA. 287+76.0 LT	STA. 287+76.0 RT
STA. 286+84.5 LT	STA. 290+40.0 LT	STA. 290+40.0 RT
	STA. 293+04.0 LT	STA. 293+04.0 RT
	STA. 295+68.0 LT	STA. 295+68.0 RT
	STA. 298+32.0 LT	STA. 298+32.0 RT
	STA. 300+96.0 LT	STA. 300+96.0 RT

SIGN LEGEND
R = REMOVE
S = SALVAGE
N = NEW
RET = RETAIN
B-B = BACK TO BACK
EXISTING = - - - - -
NEW = _____

NOT TO SCALE

PROJECT LAYOUT SHEET #5

PROJECT NAME: MANCHESTER - DORSET	PLOT DATE: 07-JUN-2010 11:00
PROJECT NUMBER: NH 2608(1)S	DRAWN BY: C.A.K.
FILE NAME: p06b040.dgn	CHECKED BY: D.W.E.
DESIGNED BY: M.J.M.	SHEET 17 OF 78
IPARM FILE: p06b04105.i	