

646.426 DURABLE 6 INCH WHITE LINE, RECESSED  
 (ALL LINES WILL INCLUDE EDGE LINE BREAKS AND RADIUS FOR TOWN HIGHWAYS)  
 MANCHESTER:  
 STA. 361+00.00 - STA. 376+00.00 LT & RT  
 STA. 375+05.00 - STA. 376+00.00 DASHED LANE LINE RT

646.622 TEMPORARY 6 INCH WHITE LINE, PAINT  
 (ALL LINES WILL INCLUDE EDGE LINE BREAKS AND RADIUS FOR TOWN HIGHWAYS)  
 MANCHESTER:  
 STA. 361+00.00 - STA. 376+00.00 LT & RT  
 STA. 375+05.00 - STA. 376+00.00 DASHED LANE LINE RT


646.436 DURABLE 6 INCH YELLOW LINE, RECESSED  
 (ALL LINES WILL INCLUDE C/L BREAKS FOR TOWN HIGHWAYS) S=SOLID, D=DASHED

MANCHESTER:  
 STA. 361+00.00 - STA. 364+85.00 LT C RT  
 - D - -  
 STA. 364+85.00 - STA. 370+80.00 D - S  
 STA. 370+80.00 - STA. 376+00.00 S - S

646.632 TEMPORARY 6 INCH YELLOW LINE, PAINT  
 (ALL LINES WILL INCLUDE C/L BREAKS FOR TOWN HIGHWAYS) S=SOLID, D=DASHED

MANCHESTER:  
 STA. 361+00.00 - STA. 364+85.00 LT C RT  
 - D - -  
 STA. 364+85.00 - STA. 370+80.00 D - S  
 STA. 370+80.00 - STA. 376+00.00 S - S

675.50 REMOVING SIGNS  
 AS SHOWN - 2

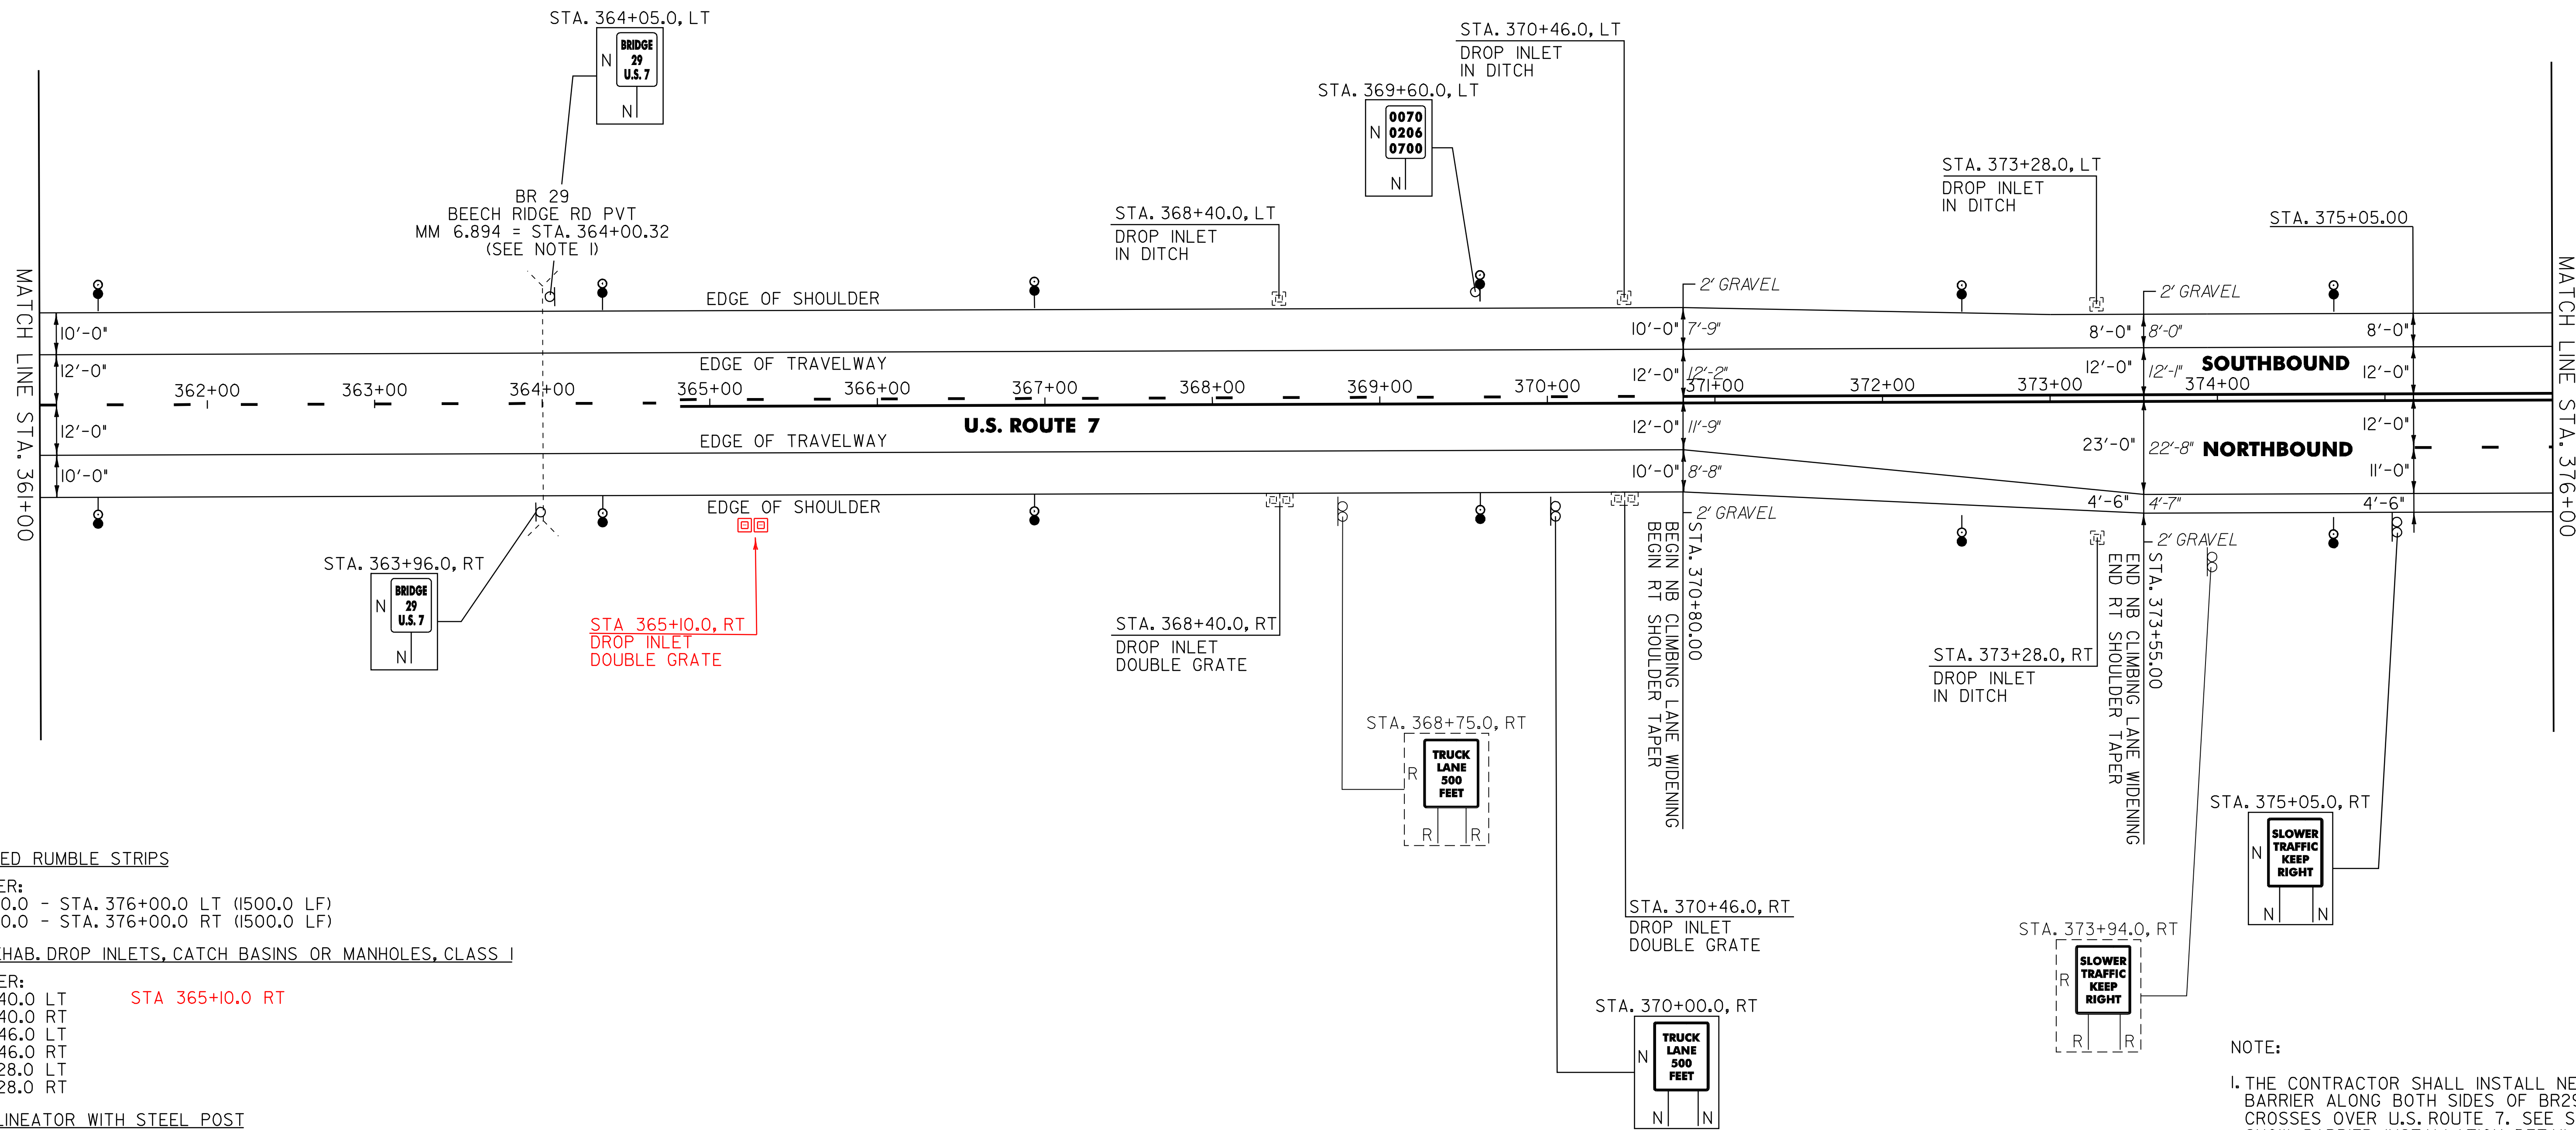

213.10 MILLED RUMBLE STRIPS

MANCHESTER:  
 STA. 361+00.0 - STA. 376+00.0 LT (1500.0 LF)  
 STA. 361+00.0 - STA. 376+00.0 RT (1500.0 LF)

604.412 REHAB. DROP INLETS, CATCH BASINS OR MANHOLES, CLASS I

MANCHESTER:  
 STA. 368+40.0 LT STA 365+10.0 RT  
 STA. 368+40.0 RT  
 STA. 370+46.0 LT  
 STA. 370+46.0 RT  
 STA. 373+28.0 LT  
 STA. 373+28.0 RT

676.10 DELINEATOR WITH STEEL POST

● TYPE I AMBER W/WHITE ON BACK ○ TYPE I WHITE W/AMBER ON BACK

MANCHESTER:  
 STA. 361+68.0 LT  
 STA. 364+32.0 LT  
 STA. 366+96.0 LT  
 STA. 369+60.0 LT  
 STA. 372+24.0 LT  
 STA. 374+88.0 LT

MANCHESTER:  
 STA. 361+68.0 RT  
 STA. 364+32.0 RT  
 STA. 366+96.0 RT  
 STA. 369+60.0 RT  
 STA. 372+24.0 RT  
 STA. 374+88.0 RT

SIGN LEGEND  
 R = REMOVE  
 S = SALVAGE  
 N = NEW  
 RET = RETAIN  
 B-B = BACK TO BACK  
 EXISTING = - - - - -  
 NEW = \_\_\_\_\_

NOTE:  
 I. THE CONTRACTOR SHALL INSTALL NEW SNOW BARRIER ALONG BOTH SIDES OF BR29 THAT CROSSES OVER U.S. ROUTE 7. SEE SHEET 73 FOR SNOW BARRIER INSTALLATION DETAILS.

**NOT TO SCALE**  
**PROJECT LAYOUT SHEET #10**

PROJECT NAME: MANCHESTER - DORSET  
 PROJECT NUMBER: NH 2608(1)S  
 FILE NAME: p06b040.dgn  
 PROJECT LEADER: D.E.G.  
 DESIGNED BY: M.J.M.  
 IPARM FILE: p06b040110.1

PLOT DATE: 07-JUN-2010 11:00  
 DRAWN BY: C.A.K.  
 CHECKED BY: D.W.E.  
 SHEET 22 OF 78