


MM 7.520 = STA. 397+05.60
 MM 0.000 = STA. 0+00.00
 MANCHESTER DORSET

646.426 DURABLE 6 INCH WHITE LINE, RECESSED
 (ALL LINES WILL INCLUDE EDGE LINE BREAKS AND
 RADIUS FOR TOWN HIGHWAYS)
 MANCHESTER:
 STA. 391+00.00 - STA. 397+05.60 LT & RT
 DORSET:
 STA. 0+00.00 - STA. 9+00.00 LT & RT
 STA. 6+42.00 - STA. 9+00.00 DASHED LANE LINE LT

646.436 DURABLE 6 INCH YELLOW LINE, RECESSED
 (ALL LINES WILL INCLUDE C/L BREAKS FOR
 TOWN HIGHWAYS) S=SOLID, D=DASHED
 MANCHESTER:
 STA. 391+00.00 - STA. 397+05.60 LT RT
 S - S
 DORSET:
 STA. 0+00.00 - STA. 9+00.00 S - S

675.50 REMOVING SIGNS
 AS SHOWN - 8

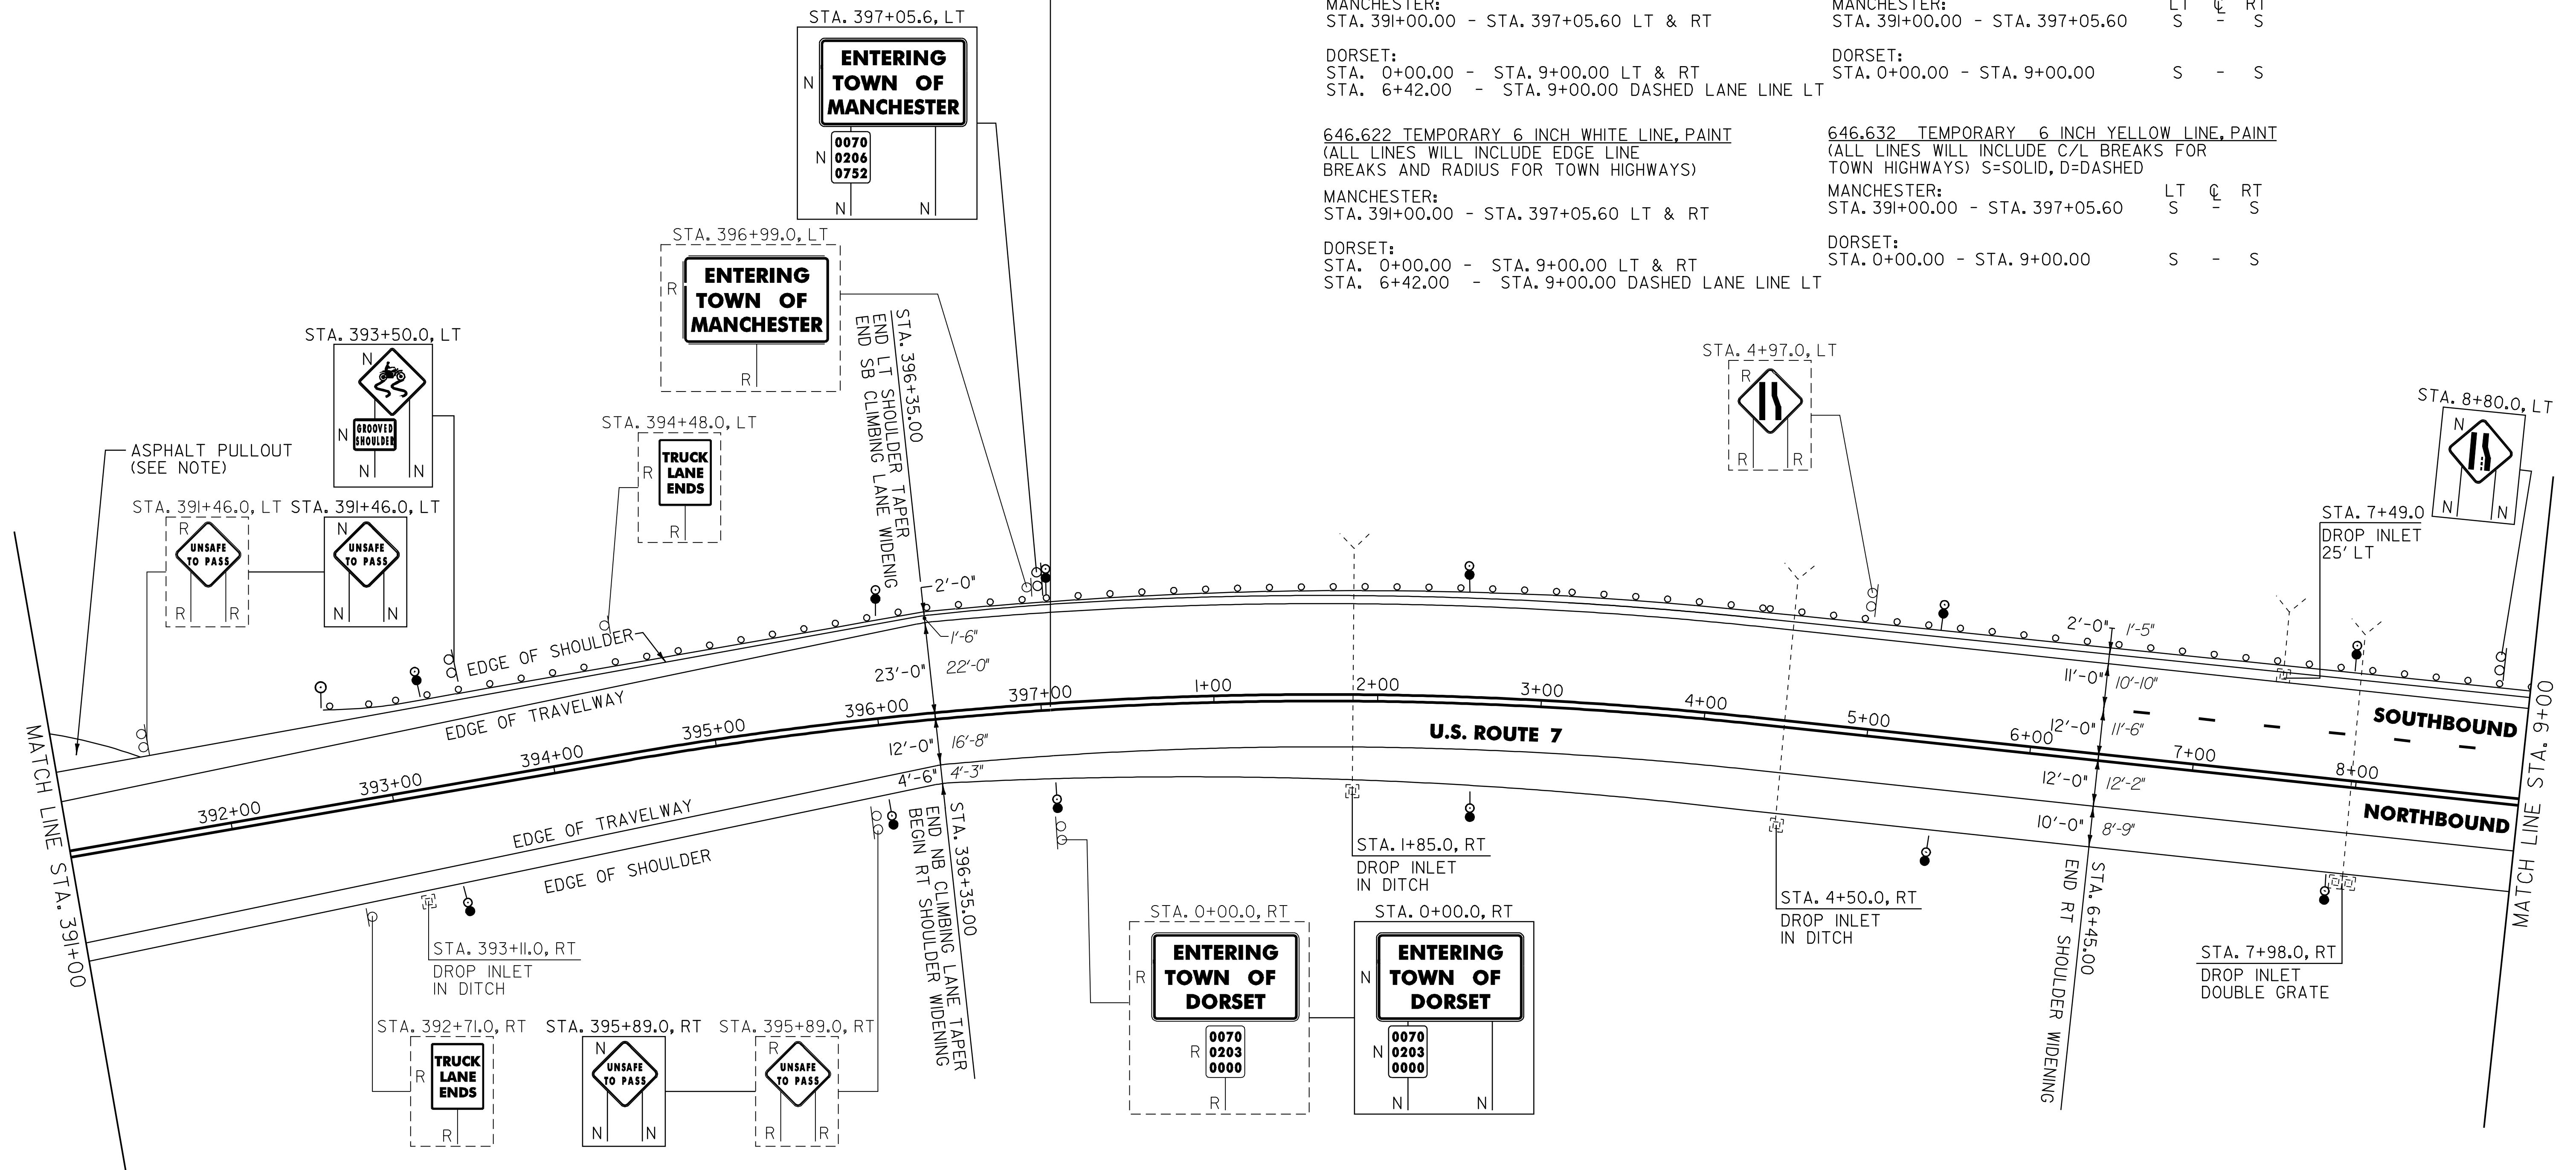

616.35 TREATED TIMBER CURB

DORSET:
 STA. 5+52.5 - STA. 9+00.0 LT (347.5 LF)

621.20 STEEL BEAM GUARDRAIL, GALVANIZED

MANCHESTER:
 STA. 393+06.0 - STA. 397+05.6 LT (399.6 LF)

DORSET:
 STA. 0+00.0 - STA. 9+00.0 LT (900.0 LF)

621.50 MANUFACTURED TERMINAL SECTION, FLARED

MANCHESTER:
 STA. 392+68.5 - STA. 393+06.0 LT

621.80 REMOVAL AND DISPOSAL OF GUARDRAIL

MANCHESTER:
 STA. 392+71.0 - STA. 397+05.6 LT (434.6 LF)

DORSET:
 STA. 0+00.0 - STA. 9+00.0 LF (900.0 LF)

676.10 DELINEATOR WITH STEEL POST

♀ TYPE I WHITE ♂ TYPE I AMBER W/ WHITE ON BACK ♂ TYPE I WHITE W/ AMBER ON BACK

MANCHESTER:
 STA. 392+68.5 LT STA. 393+36.0 LT STA. 396+00.0 LT

DORSET:
 STA. 0+00.0 LT STA. 2+64.0 LT STA. 5+28.0 LT STA. 7+92.0 LT

STA. 393+36.0 RT STA. 396+00.0 RT

STA. 0+00.0 RT STA. 2+64.0 RT STA. 5+28.0 RT STA. 7+92.0 RT

SIGN LEGEND
 R = REMOVE
 S = SALVAGE
 N = NEW
 RET = RETAIN
 B-B = BACK TO BACK
 EXISTING = - - - - -
 NEW = _____

213.10 MILLED RUMBLE STRIPS

MANCHESTER:
 STA. 391+00.0 - STA. 397+05.6 RT (605.6 LF)

DORSET:
 STA. 0+00.0 - STA. 9+00.0 RT (900.0 LF)

604.412 REHAB. DROP INLETS, CATCH BASINS OR MANHOLES, CLASS 1

MANCHESTER:
 STA. 393+11.0 RT

DORSET:
 STA. 1+85.0 RT STA. 4+50.0 RT STA. 7+49.0 LT STA. 7+98.0 RT

NOTE:

1. THE EXISTING ASPHALT PULLOUT SHALL BE PAVED WITH 2" TYPE III WEARING COURSE. ANY REQUIRED EXCAVATION OR GRADING SHALL BE PREFORMED AS DIRECTED BY THE RESIDENT ENGINEER AND PAID FOR UNDER THE APPLICABLE RENTAL ITEM(S).

NOT TO SCALE

PROJECT LAYOUT SHEET #12

PROJECT NAME: MANCHESTER - DORSET
 PROJECT NUMBER: NH 2608(1)S

FILE NAME: p06b040.dgn PLOT DATE: 07-JUN-2010 11:00
 PROJECT LEADER: D.E.G. DRAWN BY: C.A.K.
 DESIGNED BY: M.J.M. CHECKED BY: D.W.E.
 IPARM FILE: p06b040I12.1 SHEET 24 OF 78