

646.426 DURABLE 6 INCH WHITE LINE, RECESSED
 (ALL LINES WILL INCLUDE EDGE LINE BREAKS AND RADIUS FOR TOWN HIGHWAYS)

DORSET:
 STA. 9+00.00 - STA. 24+00.00 LT & RT
 STA. 9+00.00 - STA. 17+50.00 DASHED LANE LINE LT

646.436 DURABLE 6 INCH YELLOW LINE, RECESSED
 (ALL LINES WILL INCLUDE C/L BREAKS FOR TOWN HIGHWAYS) S=SOLID, D=DASHED

DORSET:
 STA. 9+00.00 - STA. 21+75.00 LT S - S
 STA. 21+75.00 - STA. 24+00.00 LT S - D


675.50 REMOVING SIGNS
 AS SHOWN - 3

646.622 TEMPORARY 6 INCH WHITE LINE, PAINT
 (ALL LINES WILL INCLUDE EDGE LINE BREAKS AND RADIUS FOR TOWN HIGHWAYS)

DORSET:
 STA. 9+00.00 - STA. 24+00.00 LT & RT
 STA. 9+00.00 - STA. 17+50.00 DASHED LANE LINE LT

646.632 TEMPORARY 6 INCH YELLOW LINE, PAINT
 (ALL LINES WILL INCLUDE C/L BREAKS FOR TOWN HIGHWAYS) S=SOLID, D=DASHED

DORSET:
 STA. 9+00.00 - STA. 21+75.00 LT S - S
 STA. 21+75.00 - STA. 24+00.00 LT S - D

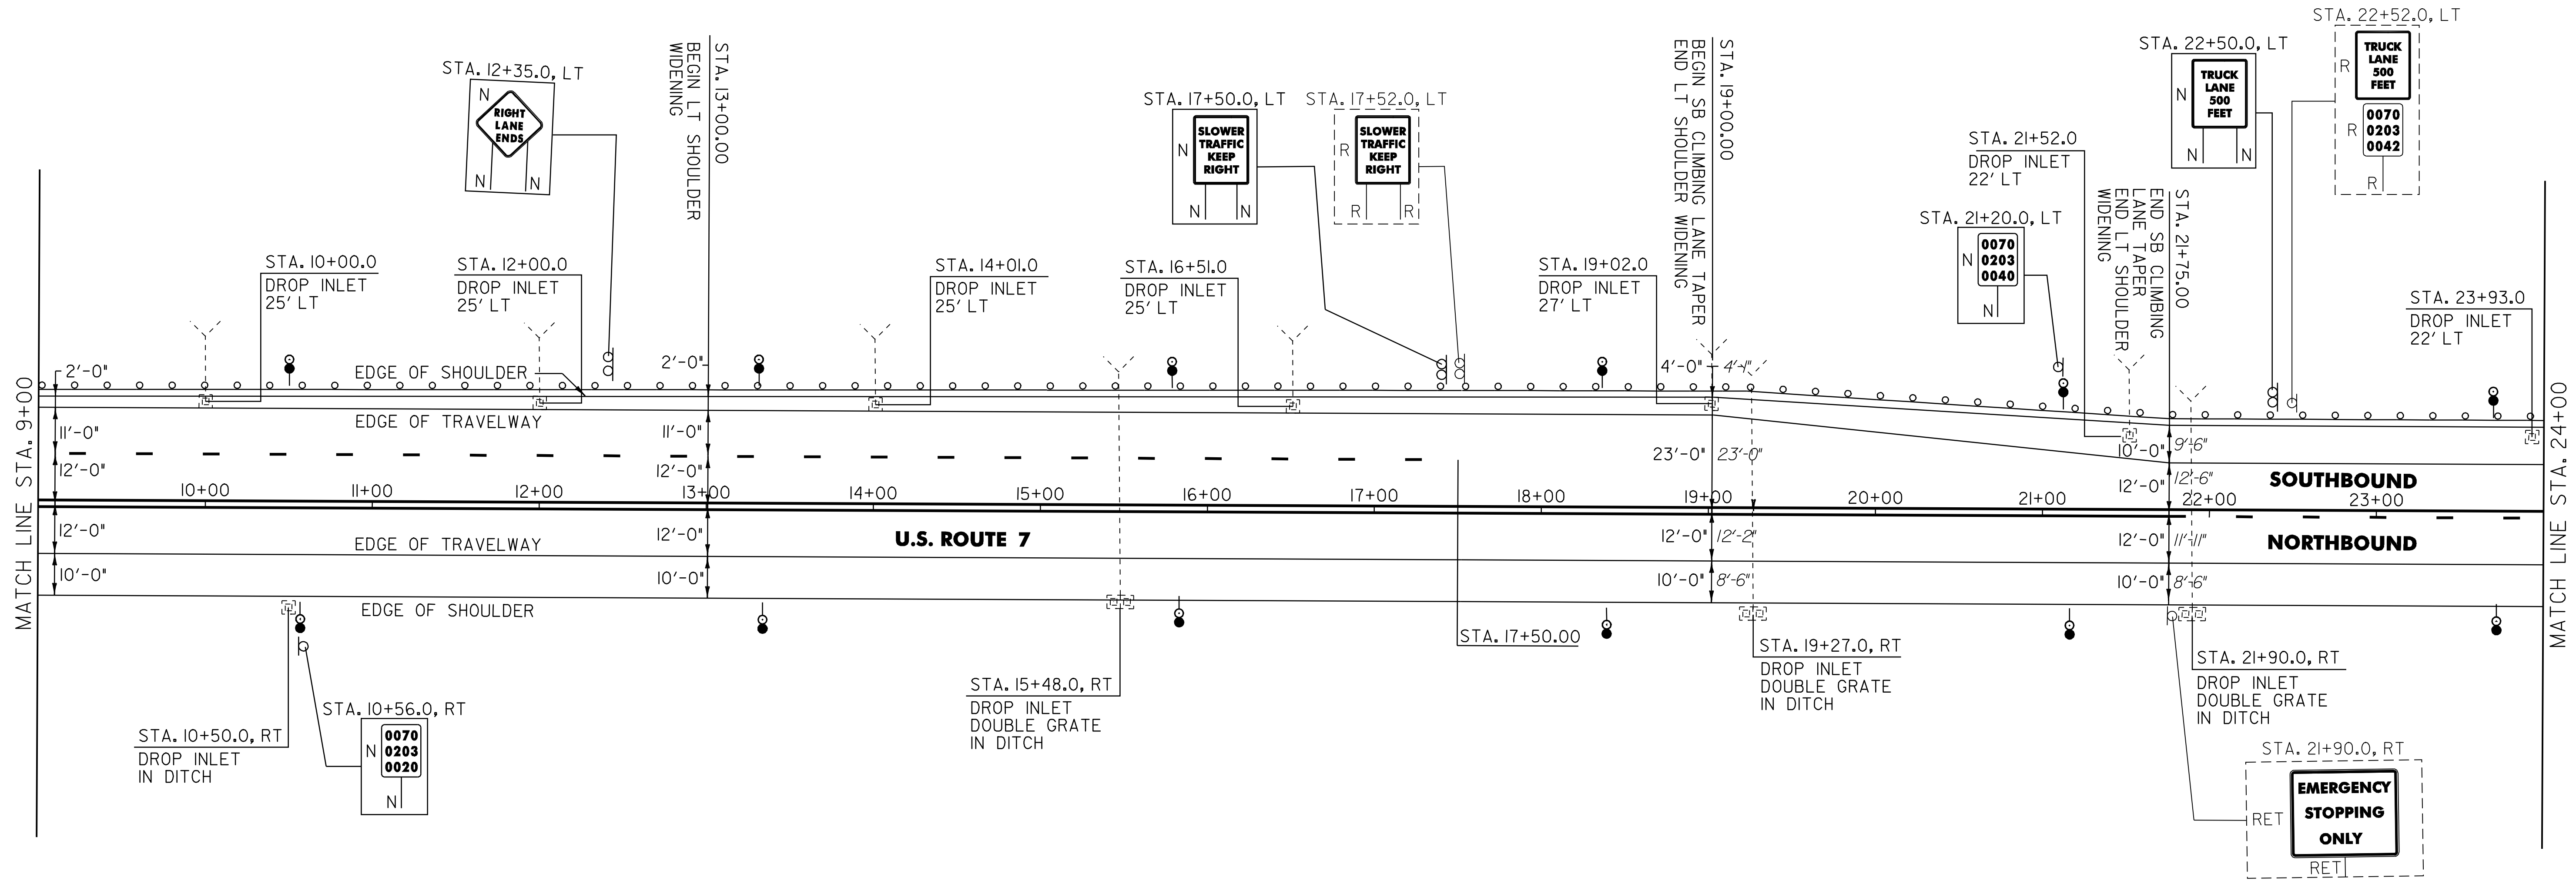

213.10 MILLED RUMBLE STRIPS

DORSET:
 STA. 19+00.0 - STA. 24+00.0 LT (500.0 LF)
 STA. 9+00.0 - STA. 24+00.0 RT (1500.0 LF)

604.412 REHAB. DROP INLETS, CATCH BASINS OR MANHOLES, CLASS I

DORSET:
 STA. 10+00.0 LT
 STA. 10+50.0 RT
 STA. 12+00.0 LT
 STA. 14+01.0 LT
 STA. 15+48.0 RT
 STA. 16+51.0 LT
 STA. 19+02.0 LT
 STA. 19+27.0 RT
 STA. 21+52.0 LT
 STA. 21+90.0 RT
 STA. 23+93.0 LT

616.35 TREATED TIMBER CURB

DORSET:
 STA. 9+00.0 - STA. 24+00.0 LT (1500.0 LF)

621.20 STEEL BEAM GUARDRAIL, GALVANIZED

DORSET:
 STA. 9+00.0 - STA. 24+00.0 LT (1500.0 LF)

621.80 REMOVAL AND DISPOSAL OF GUARDRAIL

DORSET:
 STA. 9+00.0 - STA. 24+00.0 LT (1500.0 LF)

676.10 DELINEATOR WITH STEEL POST

● TYPE I AMBER W/WHITE ON BACK ● TYPE I WHITE W/AMBER ON BACK

DORSET:
 STA. 10+56.0 LT
 STA. 13+20.0 LT
 STA. 15+84.0 LT
 STA. 18+48.0 LT
 STA. 21+12.0 LT
 STA. 23+76.0 LT

STA. 10+56.0 RT
 STA. 13+20.0 RT
 STA. 15+84.0 RT
 STA. 18+48.0 RT
 STA. 21+12.0 RT
 STA. 23+76.0 RT

SIGN LEGEND

R = REMOVE
 S = SALVAGE
 N = NEW
 RET = RETAIN
 B-B = BACK TO BACK
 EXISTING = - - - - -
 NEW = _____

NOT TO SCALE

PROJECT LAYOUT SHEET #13

PROJECT NAME: MANCHESTER - DORSET
 PROJECT NUMBER: NH 2608(1)S

FILE NAME: p06b040.dgn PLOT DATE: 07-JUN-2010 11:00
 PROJECT LEADER: D.E.G. DRAWN BY: C.A.K.
 DESIGNED BY: M.J.M. CHECKED BY: D.W.E.
 IPARM FILE: p06b040i13.1 SHEET 25 OF 78