

646.426 DURABLE 6 INCH WHITE LINE, RECESSED
(ALL LINES WILL INCLUDE EDGE LINE BREAKS AND RADIUS FOR TOWN HIGHWAYS)

DORSET:
STA. 24+00.00 - STA. 39+00.00 LT & RT

646.622 TEMPORARY 6 INCH WHITE LINE, PAINT
(ALL LINES WILL INCLUDE EDGE LINE BREAKS AND RADIUS FOR TOWN HIGHWAYS)


DORSET:
STA. 24+00.00 - STA. 39+00.00 LT & RT

646.436 DURABLE 6 INCH YELLOW LINE, RECESSED
(ALL LINES WILL INCLUDE C/L BREAKS FOR TOWN HIGHWAYS) S=SOLID, D=DASHED

DORSET:
STA. 24+00.00 - STA. 27+75.00 LT C RT
STA. 24+00.00 - STA. 27+75.00 S - D
STA. 27+75.00 - STA. 35+40.00 - D -
STA. 35+40.00 - STA. 39+00.00 D - S

646.632 TEMPORARY 6 INCH YELLOW LINE, PAINT
(ALL LINES WILL INCLUDE C/L BREAKS FOR TOWN HIGHWAYS) S=SOLID, D=DASHED

DORSET:
STA. 24+00.00 - STA. 27+75.00 LT C RT
STA. 24+00.00 - STA. 27+75.00 S - D
STA. 27+75.00 - STA. 35+40.00 - D -
STA. 35+40.00 - STA. 39+00.00 D - S

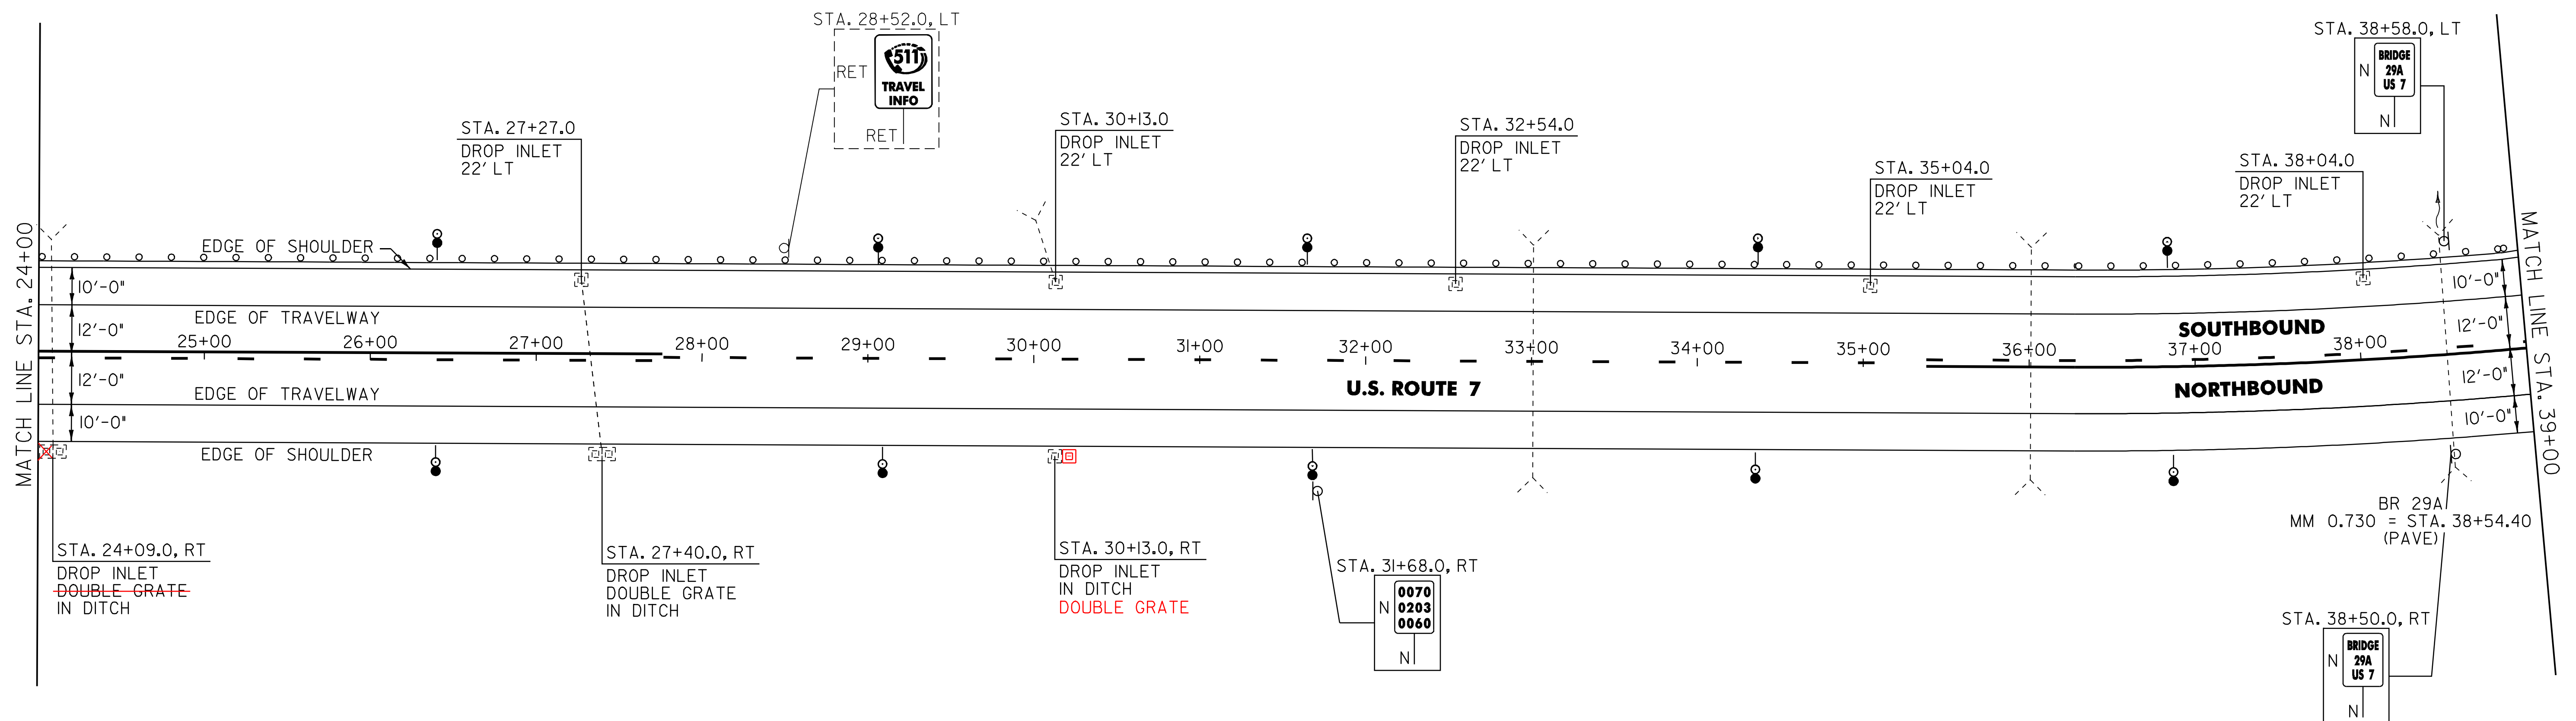

213.10 MILLED RUMBLE STRIPS

DORSET:
STA. 24+00.0 - STA. 39+00.0 LT (1500.0 LF)
STA. 24+00.0 - STA. 39+00.0 RT (1500.0 LF)

604.412 REHAB. DROP INLETS, CATCH BASINS OR MANHOLES, CLASS I

DORSET:
STA. 24+09.0 RT
STA. 27+27.0 LT
STA. 27+40.0 RT
STA. 30+13.0 LT
STA. 30+13.0 RT
STA. 32+54.0 LT
STA. 35+04.0 LT
STA. 38+04.0 LT

616.35 TREATED TIMBER CURB

DORSET:
STA. 24+00.0 - STA. 39+00.0 LF (1500.0 LF)

621.20 STEEL BEAM GUARDRAIL, GALVANIZED

DORSET:
STA. 24+00.0 - STA. 39+00.0 LT (1,500.0 LF)

621.80 REMOVAL AND DISPOSAL OF GUARDRAIL

DORSET:
STA. 24+00.0 - STA. 39+00.0 LT (1500.0 LF)

676.10 DELINEATOR WITH STEEL POST

● TYPE I AMBER W/WHITE ON BACK ● TYPE I WHITE W/AMBER ON BACK

DORSET:
STA. 26+40.0 LT STA. 26+40.0 RT
STA. 29+04.0 LT STA. 29+04.0 RT
STA. 31+68.0 LT STA. 31+68.0 RT
STA. 34+32.0 LT STA. 34+32.0 RT
STA. 36+96.0 LT STA. 36+96.0 RT

SIGN LEGEND

R = REMOVE
S = SALVAGE
N = NEW
RET = RETAIN
B-B = BACK TO BACK
EXISTING = -----
NEW = -----

NOT TO SCALE

PROJECT LAYOUT SHEET #14

PROJECT NAME: MANCHESTER - DORSET
PROJECT NUMBER: NH 2608(1)S

FILE NAME: p06b040.dgn PLOT DATE: 07-JUN-2010 11:00
PROJECT LEADER: D.E.G. DRAWN BY: C.A.K.
DESIGNED BY: M.J.M. CHECKED BY: D.W.E.
IPARM FILE: p06b040114.1 SHEET 26 OF 78