

646.426 DURABLE 6 INCH WHITE LINE, RECESSED
 (ALL LINES WILL INCLUDE EDGE LINE BREAKS AND RADIUS FOR TOWN HIGHWAYS)

DORSET:
 STA. 39+00.00 - STA. 54+00.00 LT & RT
 STA. 52+42.00 - STA. 54+00.00 DASHED LANE LINE LT

646.622 TEMPORARY 6 INCH WHITE LINE, PAINT
 (ALL LINES WILL INCLUDE EDGE LINE BREAKS AND RADIUS FOR TOWN HIGHWAYS)

DORSET:
 STA. 39+00.00 - STA. 54+00.00 LT & RT
 STA. 52+42.00 - STA. 54+00.00 DASHED LANE LINE LT


646.436 DURABLE 6 INCH YELLOW LINE, RECESSED
 (ALL LINES WILL INCLUDE C/L BREAKS FOR TOWN HIGHWAYS) S=SOLID, D=DASHED

DORSET:
 STA. 39+00.00 - STA. 43+30.00 LT C RT
 STA. 39+00.00 - STA. 43+30.00 D - S
 STA. 43+30.00 - STA. 54+00.00 S - S

646.632 TEMPORARY 6 INCH YELLOW LINE, PAINT
 (ALL LINES WILL INCLUDE C/L BREAKS FOR TOWN HIGHWAYS) S=SOLID, D=DASHED

DORSET:
 STA. 39+00.00 - STA. 43+30.00 LT C RT
 STA. 43+30.00 - STA. 54+00.00 S - S

675.50 REMOVING SIGNS
 AS SHOWN - 4

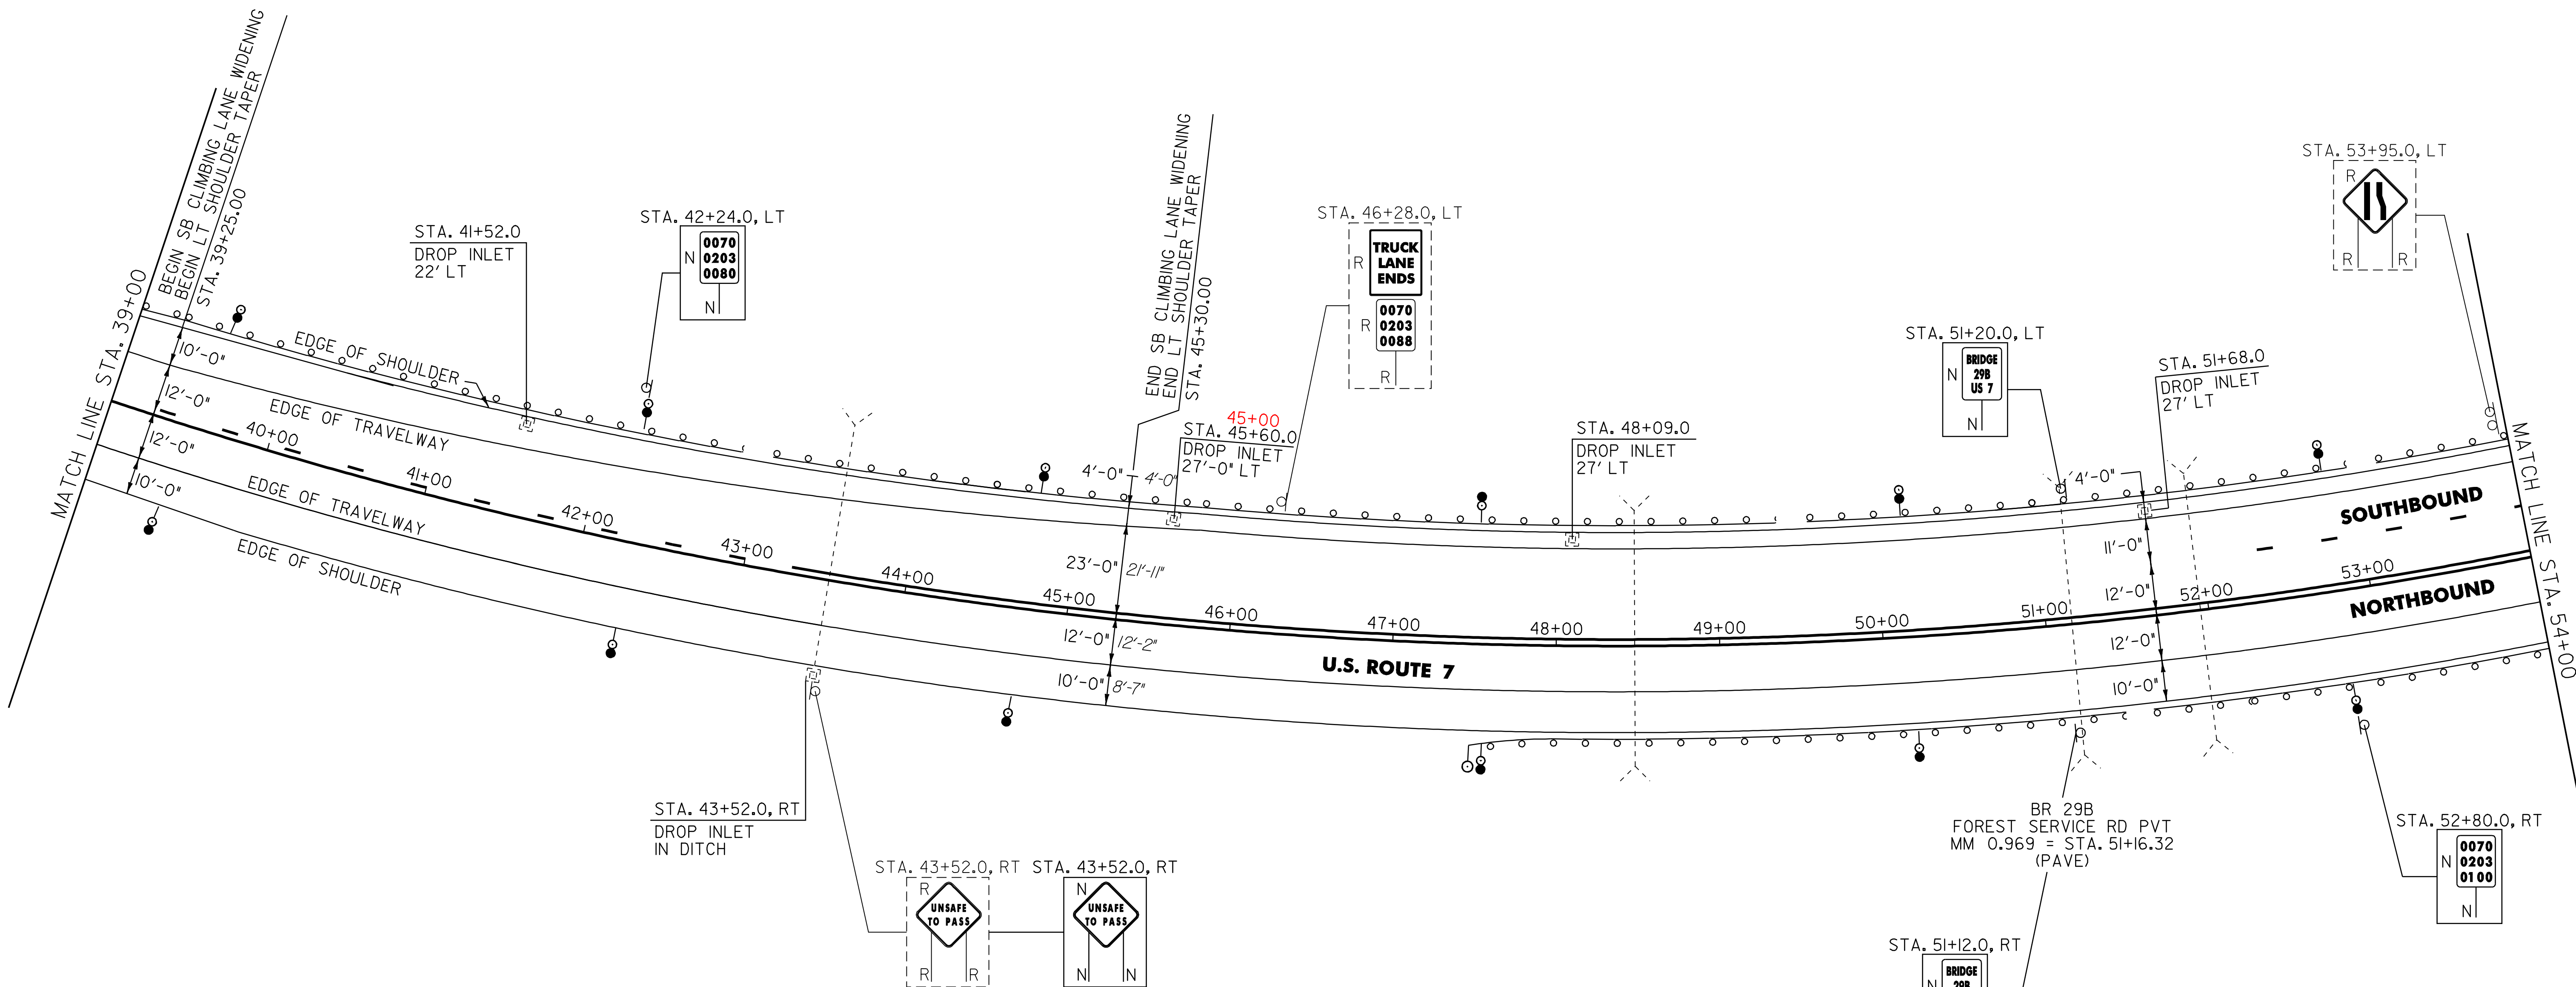

213.10 MILLED RUMBLE STRIPS

DORSET:
 STA. 39+00.0 - STA. 45+75.0 LT (675.0 LF)
 STA. 39+00.0 - STA. 54+00.0 RT (1500.0 LF)

604.412 REHAB. DROP INLETS, CATCH BASINS OR MANHOLES, CLASS I

DORSET:
 STA. 41+52.0 LT
 STA. 43+52.0 RT
 STA. 45+60.0 LT 45+00 LT
 STA. 48+09.0 LT
 STA. 51+68.0 LT

616.35 TREATED TIMBER CURB

DORSET:
 STA. 39+00.0 - STA. 54+00.0 LT (1500.0 LF)

621.20 STEEL BEAM GUARDRAIL, GALVANIZED

DORSET:
 STA. 39+00.0 - STA. 54+00.0 LT (1,500.0 LF)
 STA. 47+78.0 - STA. 54+00.0 RT (622.0 LF)

621.50 MANUFACTURED TERMINAL SECTION, FLARED

DORSET:
 STA. 47+40.5 - STA. 47+78.0 RT

621.80 REMOVAL AND DISPOSAL OF GUARDRAIL

DORSET:
 STA. 39+00.0 - STA. 54+00.0 LT (1500.0 LF)
 STA. 47+41.0 - STA. 54+00.0 RT (659.0 LF)

676.10 DELINEATOR WITH STEEL POST

○ TYPE I WHITE ○ TYPE I AMBER W/ WHITE ON BACK ○ TYPE I WHITE W/ AMBER ON BACK

DORSET:
 STA. 47+40.5 RT STA. 39+60.0 LT STA. 42+24.0 LT STA. 44+88.0 LT STA. 47+52.0 LT STA. 50+16.0 LT STA. 52+80.0 LT

STA. 39+60.0 RT STA. 42+24.0 RT STA. 44+88.0 RT STA. 47+52.0 RT STA. 50+16.0 RT STA. 52+80.0 RT

SIGN LEGEND

R = REMOVE
 S = SALVAGE
 N = NEW
 RET = RETAIN
 B-B = BACK TO BACK
 EXISTING = - - - - -
 NEW = _____

NOT TO SCALE

PROJECT LAYOUT SHEET #15

PROJECT NAME: MANCHESTER - DORSET
 PROJECT NUMBER: NH 2608(1)S

FILE NAME: p06b040.dgn PLOT DATE: 07-JUN-2010 11:00
 PROJECT LEADER: D.E.G. DRAWN BY: C.A.K.
 DESIGNED BY: M.J.M. CHECKED BY: D.W.E.
 IPARM FILE: p06b040i15.i SHEET 27 OF 78