

621.20 STEEL BEAM GUARDRAIL, GALVANIZED
 DORSET:
 STA. 68+00.0 - STA. 68+04.0 LT (4.0 LF)
 STA. 69+54.5 - STA. 73+30.0 LT (375.5 LF)
 STA. 69+42.0 - STA. 73+18.5 RT (376.5 LF)
 STA. 74+71.5 - STA. 75+09.0 LT (37.5 LF) (50 LF)
 STA. 74+64.0 - STA. 77+39.0 RT (275.0 LF)
 STA. 77+08.5 - STA. 79+00.0 LT (191.5 LF)
 STA. 75+01.5 - STA. 77+39 RT (225 LF)
 621.50 MANUFACTURED TERMINAL SECTION, FLARED

675.50 REMOVING SIGNS
 AS SHOWN - 27
 213.10 MILLED RUMBLE STRIPS
 DORSET:
 STA. 69+40.0 - STA. 72+40.0 RT (300.0 LF)

STA. 73+50.0, LT STA. 73+50.0, LT
 STA. 75+50.0, LT STA. 75+50.0, LT
 STA. 77+55.0, LT STA. 77+55.0, LT
 STA. 78+50.0, LT STA. 78+50.0, LT

DORSET:
 STA. 75+09.0 - STA. 75+46.5 LT
 STA. 76+71.0 - STA. 77+08.5 LT
 STA. 77+39.0 - STA. 77+76.5 RT


621.70 GUARDRAIL APPROACH SECTION, GALVANIZED TYPE I
 DORSET:
 STA. 68+00.0 - STA. 68+30.5 RT
 STA. 69+04.5 - STA. 69+54.5 LT
 STA. 73+18.5 - STA. 73+68.5 RT
 STA. 74+21.5 - STA. 74+71.5 LT
 STA. 68+00-STA. 68+16.5 LT
 STA. 72+92.5-STA. 73+42.5 LT
 STA. 69+29.5-STA. 69+79.5 RT
 STA. 74+51.5-STA. 75+01.5 RT

621.71 GUARDRAIL APPROACH SECTION, GALVANIZED TYPE II
 DORSET:
 STA. 68+04.0 - STA. 68+16.5 LT
 STA. 69+29.5 - STA. 69+42.0 RT
 STA. 73+30.0 - STA. 73+42.5 LT
 STA. 74+51.5 - STA. 74+64.0 RT

616.35 TREATED TIMBER CURB
 DORSET:
 STA. 69+20 - STA. 69+51.0 RT (35.0 LF)
 616.47 BITUMINOUS CONCRETE GUTTERS AND TRAFFIC ISLANDS
 DORSET:
 STA. 69+62.0 - STA. 69+66.0 RT (0.2 TON)

621.80 REMOVAL AND DISPOSAL OF GUARDRAIL
 DORSET:
 STA. 68+00.0 - STA. 68+18.0 LT (18.0 LF)
 STA. 69+04.0 - STA. 73+33.0 LT (429.0 LF)
 STA. 69+27.0 - STA. 73+72.0 RT (445.0 LF)
 STA. 74+18.0 - STA. 75+46.5 LT (128.5 LF)
 STA. 74+52.0 - STA. 77+85.0 RT (333.0 LF)
 STA. 76+21.0 - STA. 78+74.0 LT (253.0 LF)
 STA. 76+74.0 (200.0 LF)
 676.10 DELINEATOR WITH STEEL POST
 ♀ TYPE I WHITE
 ♂ TYPE I AMBER W/WHITE ON BACK
 ♂ TYPE I WHITE W/AMBER ON BACK

DORSET:
 STA. 75+46.5 LT STA. 77+08.0 RT
 STA. 68+64.0 LT STA. 71+28.0 LT
 STA. 76+71.5 LT STA. 73+92.0 LT
 STA. 68+64.0 RT STA. 71+28.0 RT
 STA. 76+56.0 RT STA. 73+92.0 RT

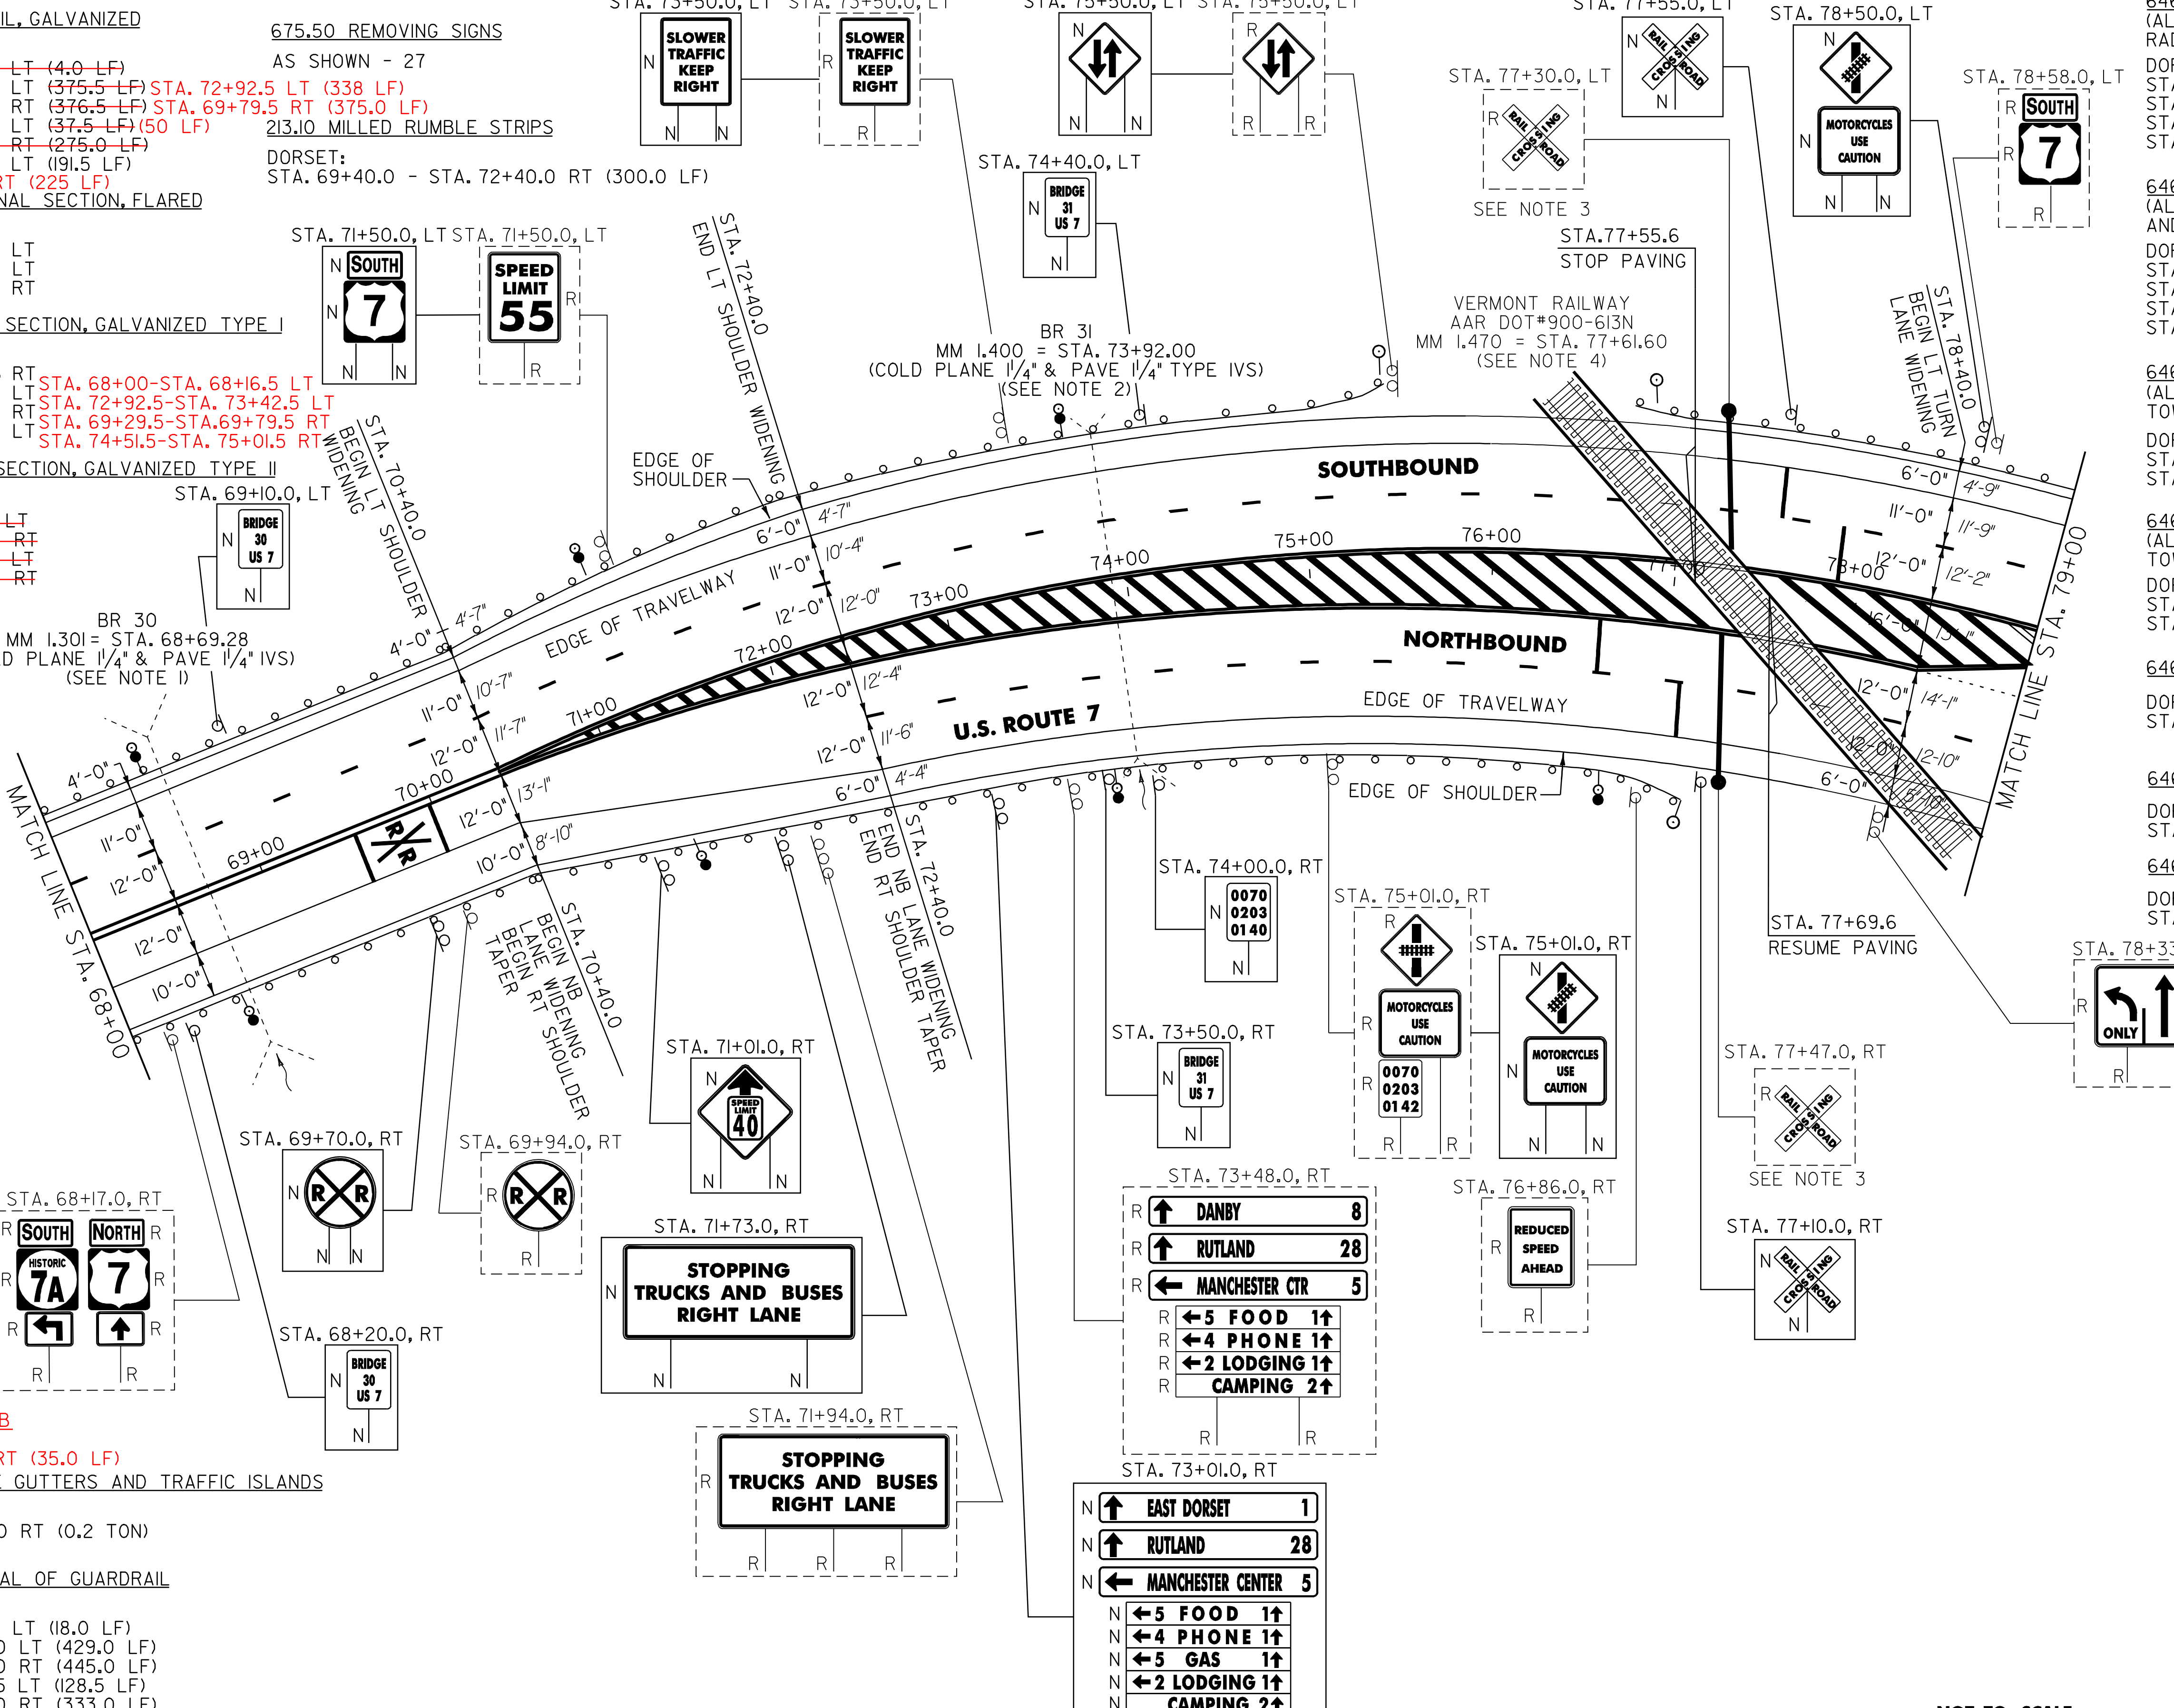

646.426 DURABLE 6 INCH WHITE LINE, RECESSED
 (ALL LINES WILL INCLUDE EDGE LINE BREAKS AND RADIUS FOR TOWN HIGHWAYS)
 DORSET:
 STA. 68+00.00 - STA. 79+00.00 LT & RT
 STA. 68+00.00 - STA. 79+00.00 DASHED LANE LINE, LT
 STA. 72+40.00 - STA. 79+00.00 DASHED LANE LINE, RT
 STA. 78+40.00 - STA. 79+00.00 DOTTED LANE LINE, RT

646.622 TEMPORARY 6 INCH WHITE LINE, PAINT
 (ALL LINES WILL INCLUDE EDGE LINE BREAKS AND RADIUS FOR TOWN HIGHWAYS)
 DORSET:
 STA. 68+00.00 - STA. 79+00.00 LT & RT
 STA. 68+00.00 - STA. 79+00.00 DASHED LANE LINE, LT
 STA. 72+40.00 - STA. 79+00.00 DASHED LANE LINE, RT
 STA. 78+40.00 - STA. 79+00.00 DOTTED LANE LINE, RT


646.436 DURABLE 6 INCH YELLOW LINE, RECESSED
 (ALL LINES WILL INCLUDE C/L BREAKS FOR TOWN HIGHWAYS) S=SOLID, D=DASHED
 DORSET:
 STA. 68+00.00 - STA. 70+40.00 LT & RT
 STA. 70+40.00 - STA. 79+00.00 DOUBLE SOLID MEDIAN LT & RT

646.632 TEMPORARY 6 INCH YELLOW LINE, PAINT
 (ALL LINES WILL INCLUDE C/L BREAKS FOR TOWN HIGHWAYS) S=SOLID, D=DASHED
 DORSET:
 STA. 68+00.00 - STA. 70+40.00 LT & RT
 STA. 70+40.00 - STA. 79+00.00 DOUBLE SOLID MEDIAN LT & RT

646.476 DURABLE 12 INCH YELLOW LINE, RECESSED
 DORSET:
 STA. 70+40.00 - STA. 79+00.00 HATCHED MEDIAN LT & RT

646.512 DURABLE RAILROAD CROSSING SYMBOL, THERMOPLASTIC
 DORSET:
 STA. 69+70.00 RT (1 EA)

646.712 TEMPORARY RAILROAD CROSSING SYMBOL, PAINT
 DORSET:
 STA. 69+70.00 RT (1EA)

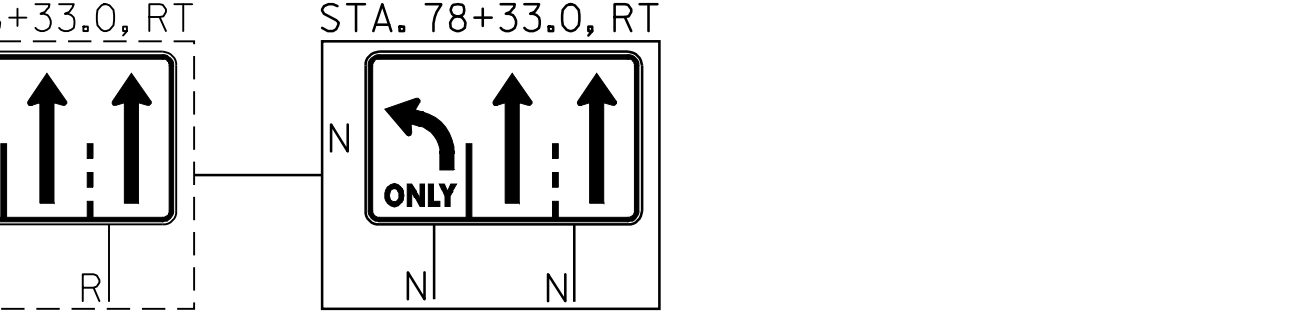

- NOTES:
 1. SEE SHEET 70 FOR BR 30 DETAILS.
 2. SEE SHEET 71 FOR BR 31 DETAILS.
 3. REMOVE EXISTING RAILROAD CROSSBUCK SIGN LOCATED ON RAILROAD SIGNAL POST.
 4. SEE SHEETS 74-76 FOR RAIL CROSSING DETAIL SHEETS

NOT TO SCALE

PROJECT LAYOUT SHEET #17

PROJECT NAME: MANCHESTER - DORSET
 PROJECT NUMBER: NH 2608(1)S

FILE NAME: p06b040.dgn
 PROJECT LEADER: D.E.G.
 DESIGNED BY: M.J.M.
 IPARM FILE: p06b040i17.i

PLOT DATE: 07-JUN-2010 11:00
 DRAWN BY: C.A.K.
 CHECKED BY: D.W.E.
 SHEET 29 OF 78

SIGN LEGEND
 R = REMOVE
 S = SALVAGE
 N = NEW
 RET = RETAIN
 B-B = BACK TO BACK
 EXISTING = - - - - -
 NEW = _____