


675.50 REMOVING SIGNS
AS SHOWN - 39-32

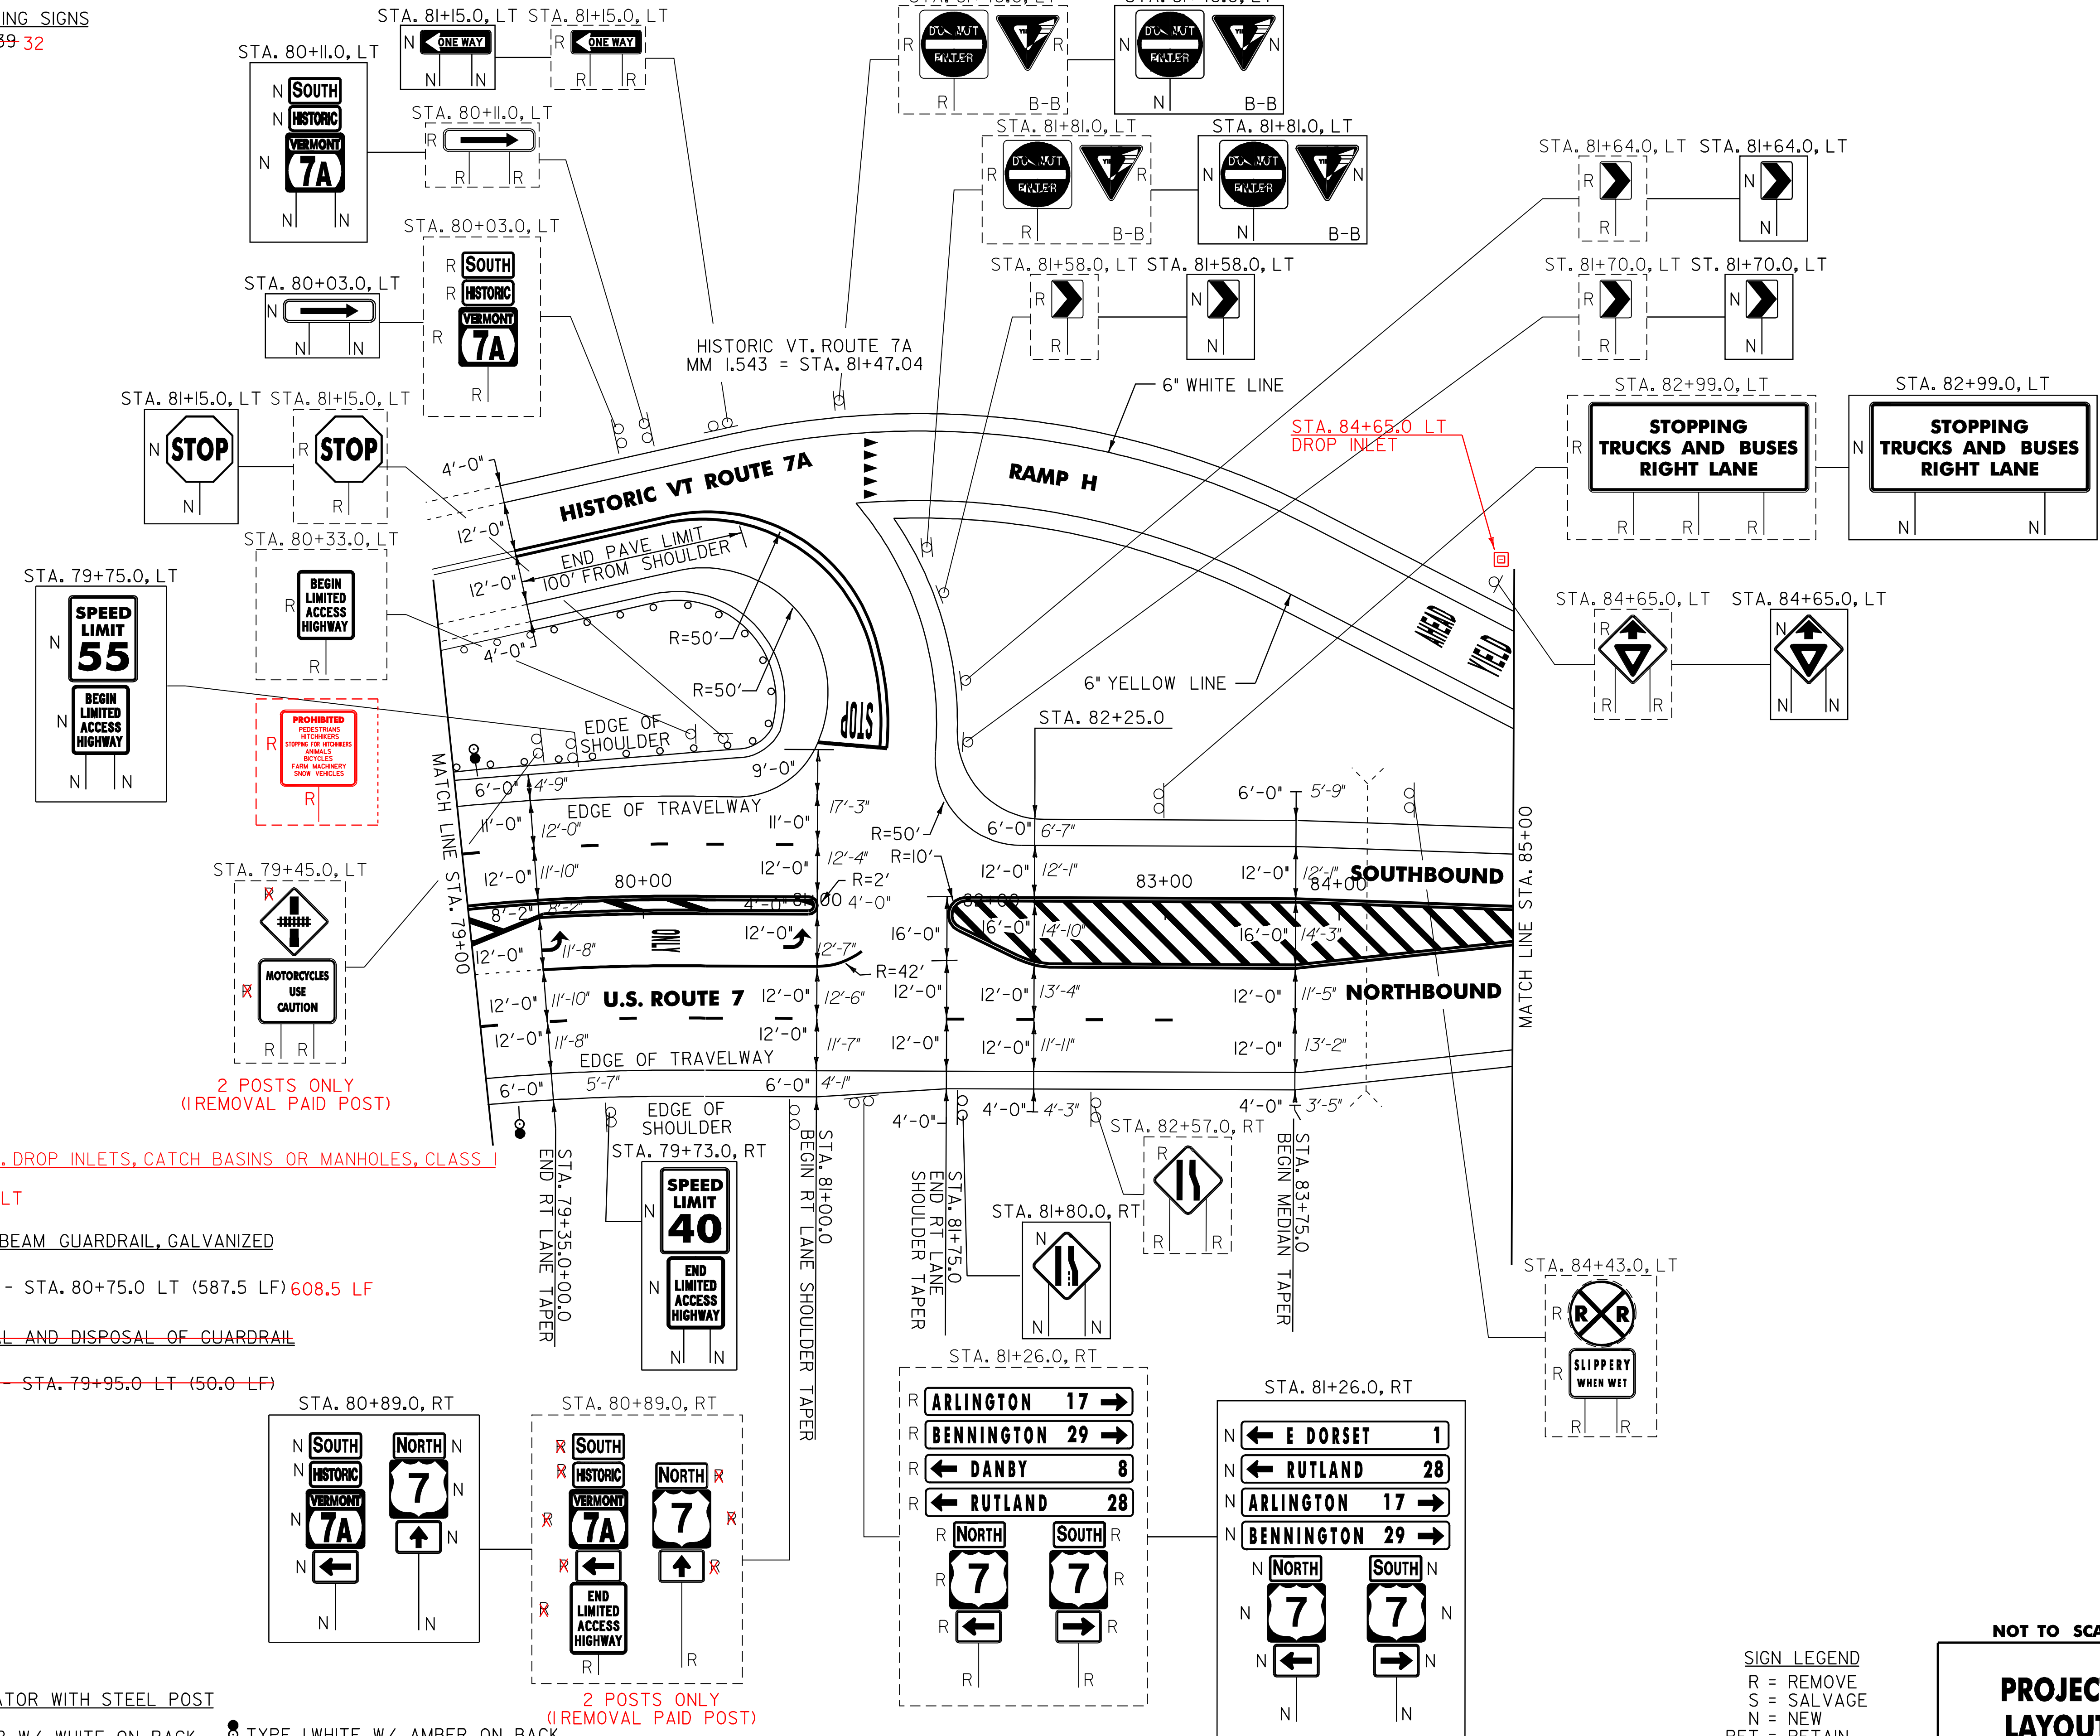

646.426 DURABLE 6 INCH WHITE LINE, RECESSED
(ALL LINES WILL INCLUDE EDGE LINE BREAKS AND RADIUS FOR TOWN HIGHWAYS)
DORSET:
STA. 79+00.00 - STA. 81+00.00 DASHED LANE LINE LT
STA. 79+00.00 - STA. 85+00.00 LT & RT
STA. 79+00.00 - STA. 83+05.00 DASHED LANE LINE RT
STA. 79+00.00 - STA. 79+35.00 DOTTED LANE LINE RT
STA. 79+35.00 - STA. 81+20.00 SOLID LANE LINE RT
STA. 81+47.04 EDGE LINE LT, HISTORIC VT. ROUTE 7A

646.436 DURABLE 6 INCH YELLOW LINE, RECESSED
(ALL LINES WILL INCLUDE C/L BREAKS FOR TOWN HIGHWAYS)
DORSET:
STA. 79+00.00 - STA. 81+00.00 DOUBLE SOLID MEDIAN LT & RT
STA. 81+75.00 - STA. 85+00.00 DOUBLE SOLID MEDIAN LT & RT
STA. 81+47.04 DOUBLE SOLID LT, HISTORIC VT. ROUTE 7A

646.476 DURABLE 12 INCH YELLOW LINE, RECESSED
(ALL LINES WILL INCLUDE C/L BREAKS FOR TOWN HIGHWAYS) S=SOLID, D=DASHED
DORSET:
STA. 79+00.00 - STA. 81+00.00 HATCHED MEDIAN LT & RT
STA. 81+75.00 - STA. 85+00.00 HATCHED MEDIAN LT & RT

646.482 DURABLE 24 INCH STOP BAR, THERMOPLASTIC
DORSET:
STA. 81+47.04 LT, HISTORIC VT. ROUTE 7A

646.632 TEMPORARY 6 INCH YELLOW LINE, PAINT
(ALL LINES WILL INCLUDE C/L BREAKS FOR TOWN HIGHWAYS)
DORSET:
STA. 79+00.00 - STA. 81+00.00 DOUBLE SOLID MEDIAN LT & RT
STA. 81+75.00 - STA. 85+00.00 DOUBLE SOLID MEDIAN LT & RT
STA. 81+47.04 DOUBLE SOLID LT, HISTORIC VT. ROUTE 7A

646.622 TEMPORARY 6 INCH WHITE LINE, PAINT
(ALL LINES WILL INCLUDE EDGE LINE BREAKS AND RADIUS FOR TOWN HIGHWAYS)
DORSET:
STA. 79+00.00 - STA. 81+00.00 DASHED LANE LINE LT
STA. 79+00.00 - STA. 85+00.00 LT & RT
STA. 79+00.00 - STA. 83+05.00 DASHED LANE LINE RT
STA. 79+00.00 - STA. 79+35.00 DOTTED LANE LINE RT
STA. 79+35.00 - STA. 81+20.00 SOLID LANE LINE RT
STA. 81+47.04 EDGE LINE, LT, HISTORIC VT. ROUTE 7A

646.682 TEMPORARY 24 INCH STOP BAR, PAINT
DORSET:
STA. 81+47.04 LT, HISTORIC VT. ROUTE 7A

646.492 DURABLE LETTER OR SYMBOL, THERMOPLASTIC
DORSET:
STA. 79+39.00 RT, ARROW (1EA)
STA. 80+12.00 RT, "O,N,L,Y" (4 EA)
STA. 80+85.00 RT, ARROW (1EA)
STA. 81+46.00 LT, "S,T,O,P" (4 EA)
STA. 81+46.00 LT, YIELD LINE (5 EA)
STA. 84+49.00 LT, "A,H,E,A,D" (5 EA)
STA. 84+81.00 LT, "Y,I,E,L,D" (5 EA)

646.692 TEMPORARY LETTER OR SYMBOL, PAINT
DORSET:
STA. 79+39.00 RT, ARROW (1EA)
STA. 80+85.00 RT, ARROW (1EA)
STA. 81+46.00 LT, "S,T,O,P" (4 EA)
STA. 81+46.00 LT, YIELD LINE (5 EA)
STA. 84+49.00 LT, "A,H,E,A,D" (5 EA)
STA. 84+81.00 LT, "Y,I,E,L,D" (5 EA)

604.412 REHAB. DROP INLETS, CATCH BASINS OR MANHOLES, CLASS I
DORSET:
STA. 84+65.0 LT

621.20 STEEL BEAM GUARDRAIL, GALVANIZED
DORSET:
STA. 79+00.0 - STA. 80+75.0 LT (587.5 LF) 608.5 LF

621.80 REMOVAL AND DISPOSAL OF GUARDRAIL
DORSET:
STA. 79+45.0 - STA. 79+95.0 LT (50.0 LF)

676.10 DELINEATOR WITH STEEL POST
TYPE I AMBER W/ WHITE ON BACK TYPE I WHITE W/ AMBER ON BACK
DORSET:
STA. 79+20.0 LT STA. 79+20.0 RT

SIGN LEGEND
R = REMOVE
S = SALVAGE
N = NEW
RET = RETAIN
B-B = BACK TO BACK
EXISTING = - - - - -
NEW = _____

NOT TO SCALE
PROJECT LAYOUT SHEET #18

PROJECT NAME: MANCHESTER - DORSET
PROJECT NUMBER: NH 2608(1)S
FILE NAME: p06b040.dgn PLOT DATE: 07-JUN-2010 11:00
PROJECT LEADER: D.E.G. DRAWN BY: C.A.K.
DESIGNED BY: M.J.M. CHECKED BY: D.W.E.
IPARM FILE: p06b040I18.I SHEET 30 OF 78