

646.436 DURABLE 6 INCH YELLOW LINE, RECESSED
 (ALL LINES WILL INCLUDE C/L BREAKS FOR TOWN HIGHWAYS) S=SOLID, D=DASHED

DORSET:
 STA. 86+25.00 - STA. 92+13.60
 STA. 85+00.00 - STA. 86+25.00 DOUBLE SOLID MEDIAN LT & RT
 STA. 90+39.36 DOUBLE SOLID RT, TH-5

LT C RT
 S - S

646.632 TEMPORARY 6 INCH YELLOW LINE, PAINT
 (ALL LINES WILL INCLUDE C/L BREAKS FOR TOWN HIGHWAYS) S=SOLID, D=DASHED

DORSET:
 STA. 86+25.00 - STA. 92+13.60
 STA. 85+00.00 - STA. 86+25.00 DOUBLE SOLID MEDIAN LT & RT
 STA. 90+39.36 DOUBLE SOLID RT, TH-5

LT C RT
 S - S

646.426 DURABLE 6 INCH WHITE LINE, RECESSED
 (ALL LINES WILL INCLUDE EDGE LINE BREAKS AND RADIUS FOR TOWN HIGHWAYS)

DORSET:
 STA. 85+00.00 - STA. 92+13.60 LT & RT
 STA. 88+53.00 - STA. 92+13.60 DOTTED LANE LINE LT

646.466 DURABLE 12 INCH WHITE LINE, RECESSED
 DORSET:
 STA. 86+25.00 - STA. 88+53.00 GORE AREA LT

646.622 TEMPORARY 6 INCH WHITE LINE, PAINT
 (ALL LINES WILL INCLUDE EDGE LINE BREAKS AND RADIUS FOR TOWN HIGHWAYS)

DORSET:
 STA. 85+00.00 - STA. 92+13.60 LT & RT
 STA. 88+53.00 - STA. 92+13.60 DOTTED LANE LINE LT

646.476 DURABLE 12 INCH YELLOW LINE, RECESSED
 DORSET:
 STA. 85+00.00 - STA. 86+25.00 HATCHED MEDIAN LT & RT

646.482 DURABLE 24 INCH STOP BAR, THERMOPLASTIC
 DORSET:
 STA. 90+39.36 RT, TH-5

646.682 TEMPORARY 24 INCH STOP BAR, PAINT
 DORSET:
 STA. 90+39.36 RT, TH-5

646.492 DURABLE LETTER OR SYMBOL, THERMOPLASTIC
 DORSET:
 STA. 90+39.36 RT, TH-5 *S,T,O,P* (4 EA)

646.692 TEMPORARY LETTER OR SYMBOL, PAINT
 DORSET:
 STA. 90+39.36 RT, TH-5 *S,T,O,P* (4 EA)

646.512 DURABLE RAILROAD CROSSING SYMBOL, THERMOPLASTIC
 DORSET:
 STA. 85+90.00 LT (1EA)

646.712 TEMPORARY RAILROAD CROSSING SYMBOL, PAINT
 DORSET:
 STA. 85+90.00 LT (1EA)

621.50 MANUFACTURED TERMINAL SECTION, FLARED

DORSET:
 STA. 88+28.8 - STA. 88+66.3 RT
 STA. 91+81.0 - STA. 92+18.5 LT

621.20 STEEL BEAM GUARDRAIL, GALVANIZED

DORSET:
 STA. 88+66.3 - STA. 89+66.3 RT (100.0 LF)
 STA. 90+03.8 - STA. 90+18.3 RT (14.5 LF)
 STA. 90+29.0 - STA. 90+43.5 LT (14.5 LF)
 STA. 90+81.0 - STA. 91+81.0 LT (100.0 LF)

621.60 ANCHOR FOR STEEL BEAM RAIL


DORSET:
 STA. 90+18.3 RT
 STA. 90+29.0 LT

621.80 REMOVAL AND DISPOSAL OF GUARDRAIL

621.21 HD STEEL BEAM GUARDRAIL, GALVANIZED

DORSET:
 STA. 89+66.3 - STA. 89+91.3 RT (32.5 LF)
 STA. 90+56.0 - STA. 90+81.0 LT (32.5 LF)

DORSET:
 STA. 88+28.0 - STA. 89+91.3 RT (163.3 LF)
 STA. 90+03.8 - STA. 90+19.0 RT (15.2 LF)
 STA. 90+32.0 - STA. 90+43.5 LT (12.5 LF)
 STA. 90+56.0 - STA. 91+69.0 LT (133.0 LF)

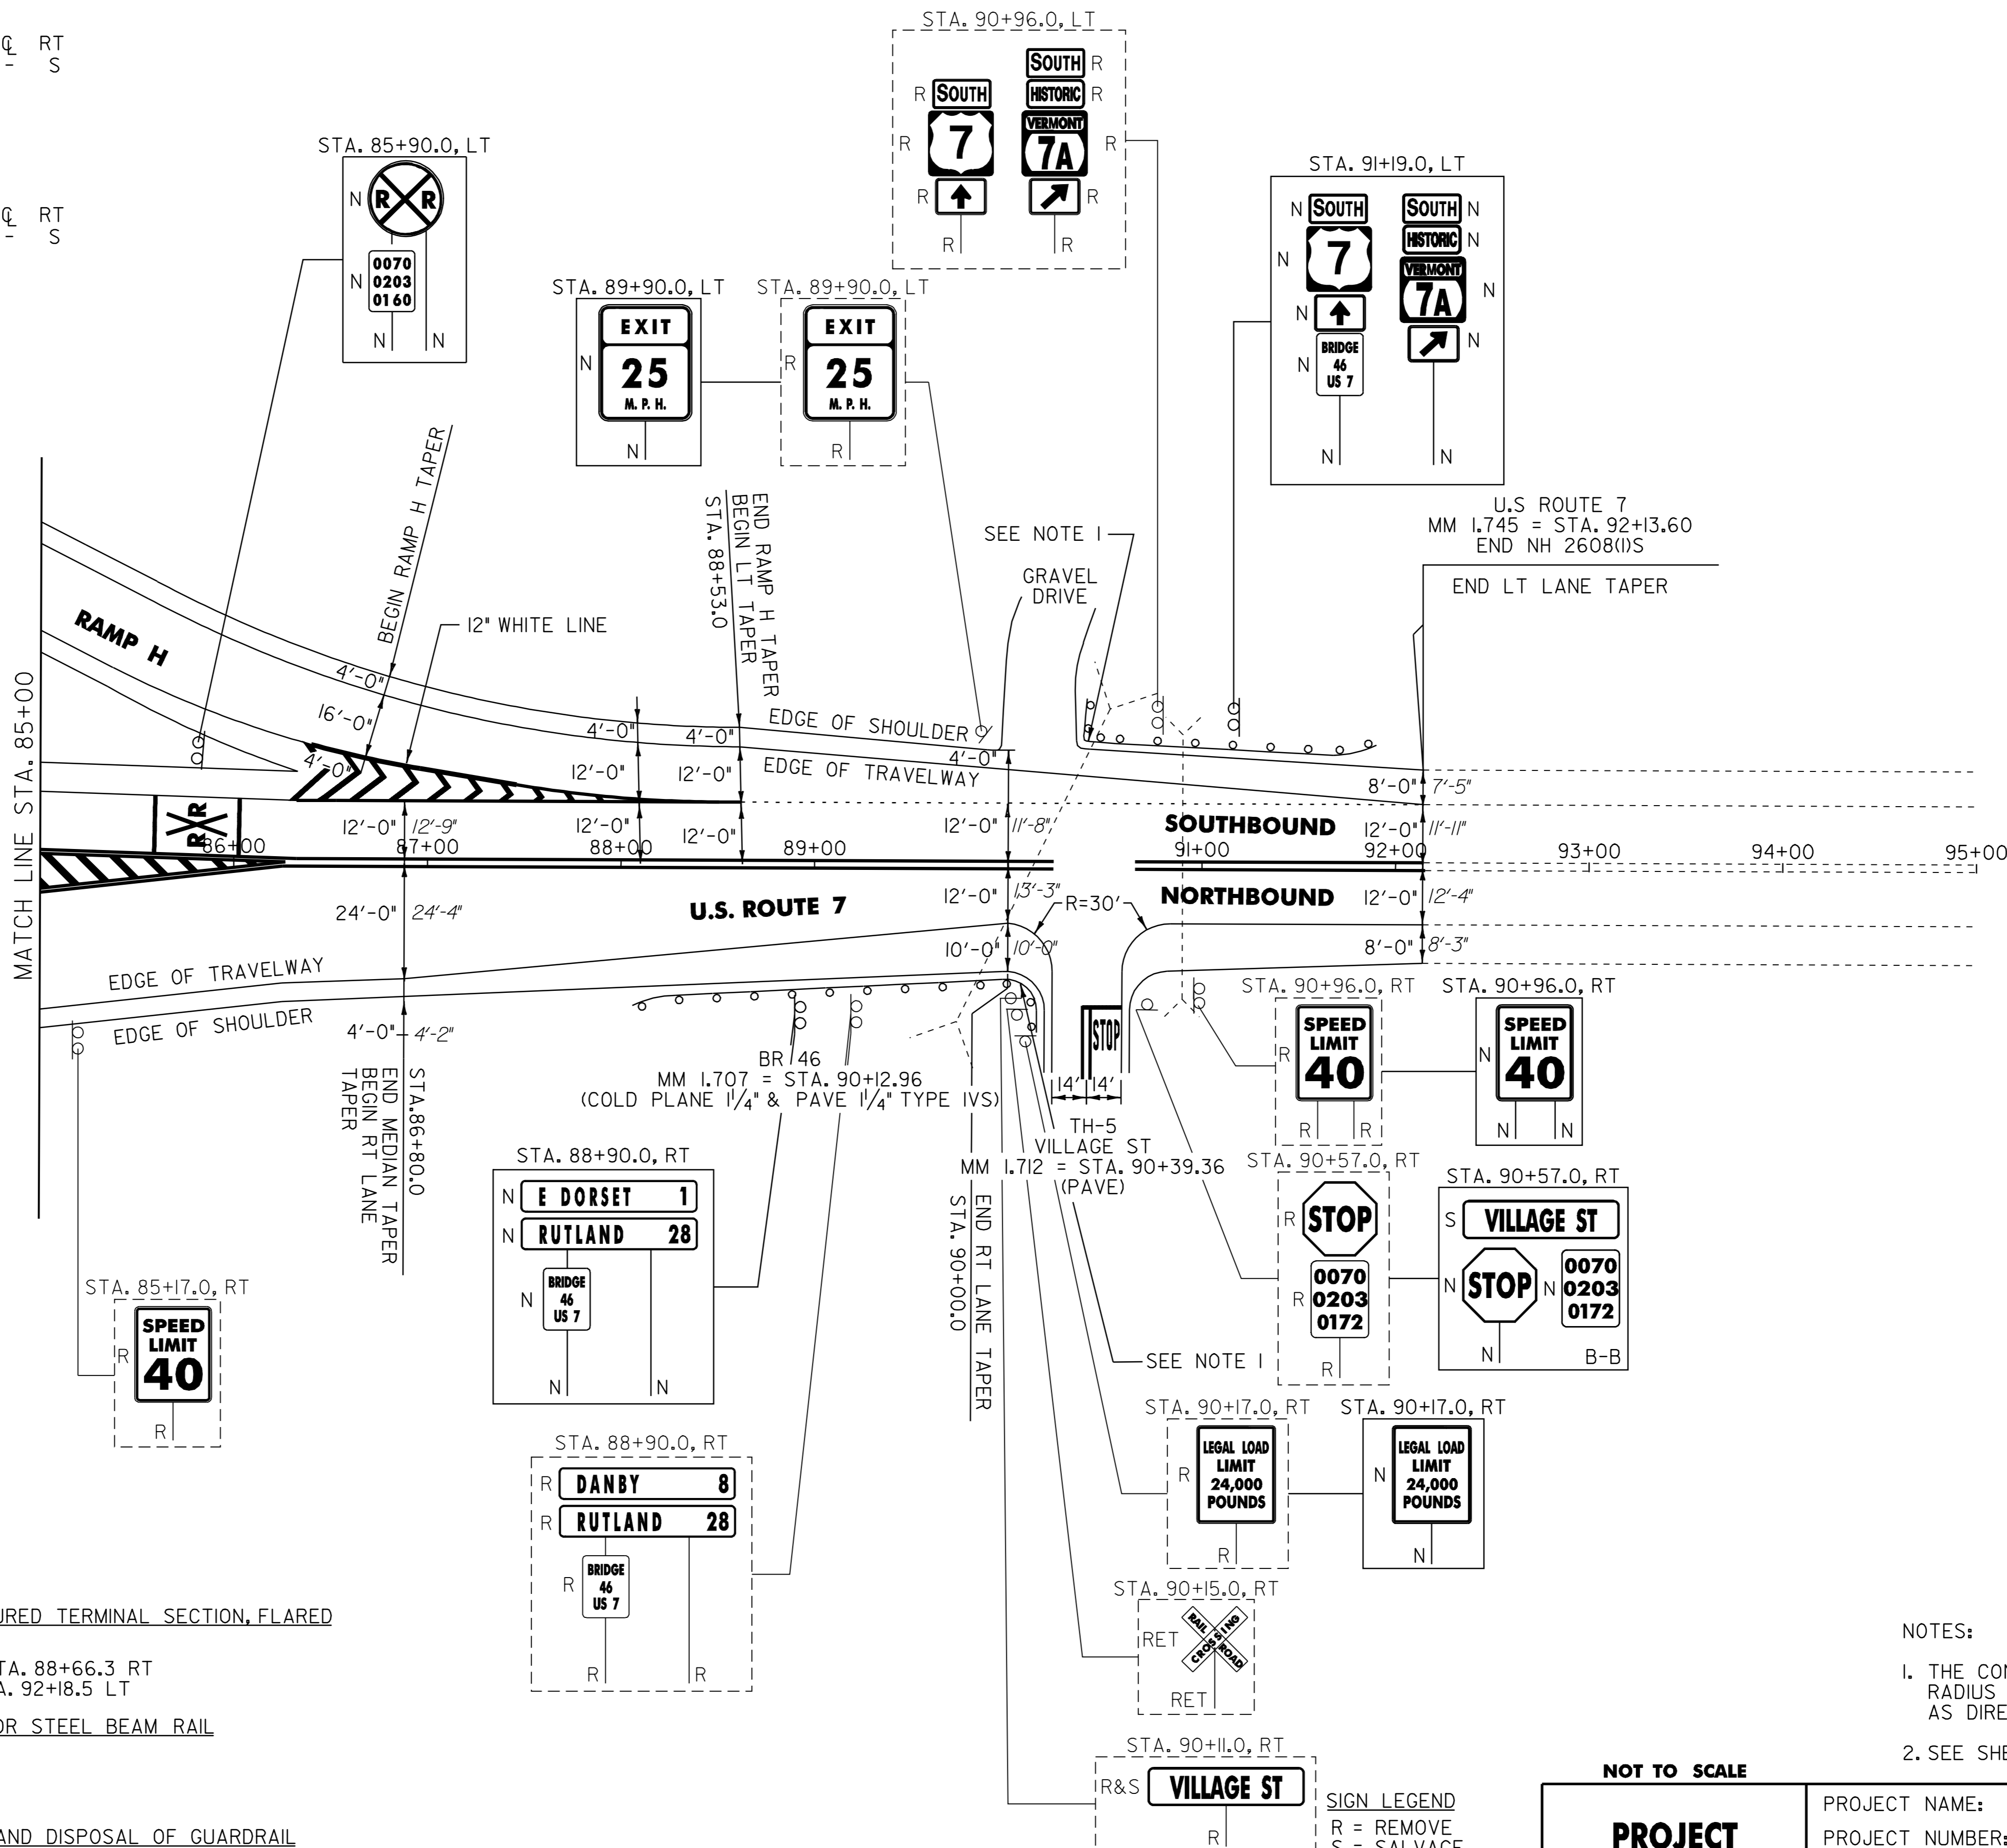

NOTES:
 1. THE CONTRACTOR SHALL INSTALL A NEW 16' RADIUS PANEL WITH ANCHORS AT EACH END AS DIRECTED BY THE RESIDENT ENGINEER.
 2. SEE SHEET 72 FOR BR 46 DETAILS.

PROJECT LAYOUT SHEET #19	NOT TO SCALE	
	PROJECT NAME: MANCHESTER - DORSET PROJECT NUMBER: NH 2608(I)S FILE NAME: p06b040.dgn PROJECT LEADER: D.E.G. DESIGNED BY: M.J.M. IPARM FILE: p06b040I19.I	PLOT DATE: 07-JUN-2010 11:55 DRAWN BY: C.A.K. CHECKED BY: D.W.E. SHEET 31 OF 78

SIGN LEGEND
 R = REMOVE
 S = SALVAGE
 N = NEW
 RET = RETAIN
 B-B = BACK TO BACK
 EXISTING = - - - - -
 NEW = _____