


THE CONTRACTOR SHALL REMOVE ALL WOODY STEMMED GROWTH INCLUDING BRUSH, SAPLINGS, TREE LIMBS GROWING WITHIN OR PROJECTING INTO THE CLEARANCE AREA AND DOWN TO GROUND LEVEL OR AT LEAST 10 FT BELOW THE BOTTOM OF THE SIGN. PAYMENT WILL BE FOR THINNING AND TRIMMING FOR SIGNS, ITEM 201.31, AND PAID FOR PER EACH. NO CHEMICALS (POISONS OR DEFOLIANTS) ALLOWED.


MINIMUM SIGN SIGHT DISTANCE CHART

APPROACH SPEED (mph)	SIGHT DISTANCE (feet)
30 OR LESS	300
35	350
40	400
45	450
50	500
55	550


CLEARING LIMITS FOR SIGNS ON CONVENTIONAL ROADS

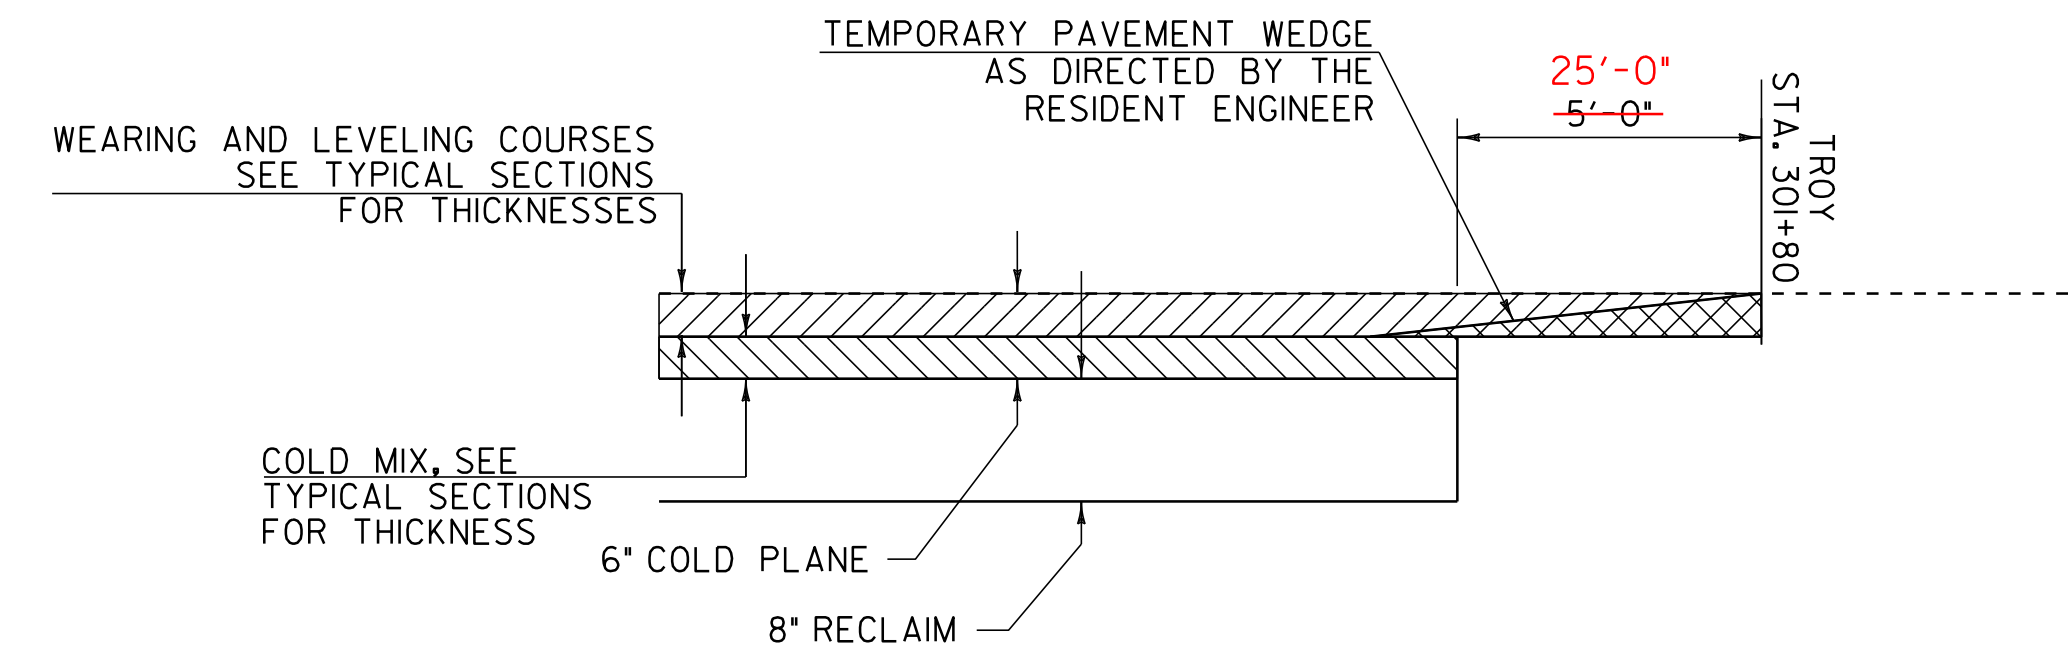

TRANSITION FOR STOP STA. 301+80 (TROY)

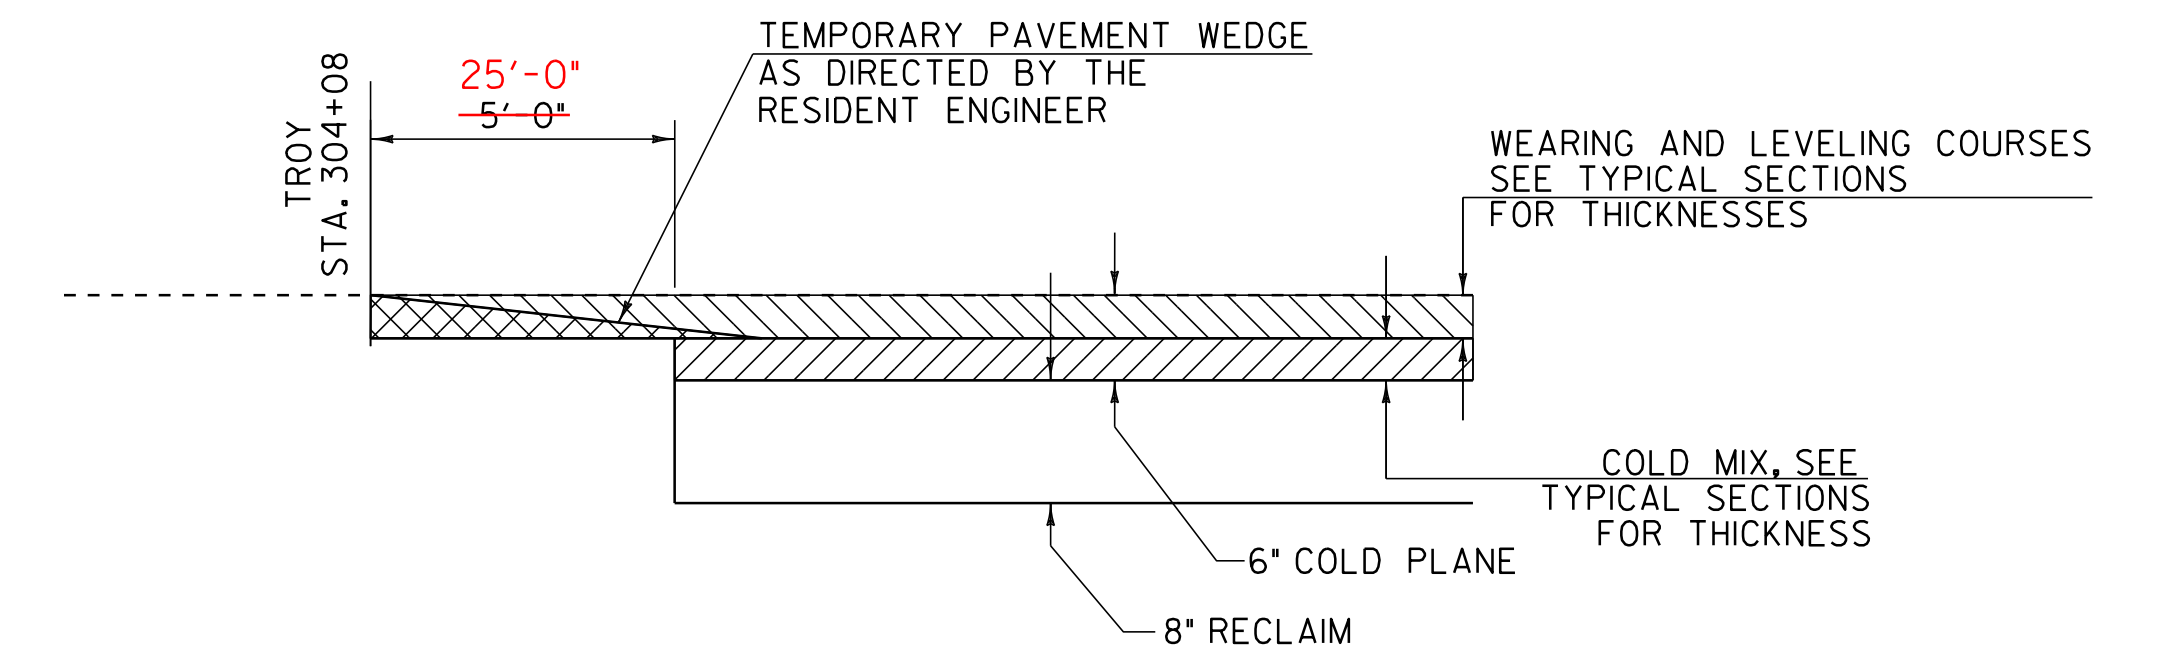

TRANSITION FOR RESUME STA. 304+08 (TROY)

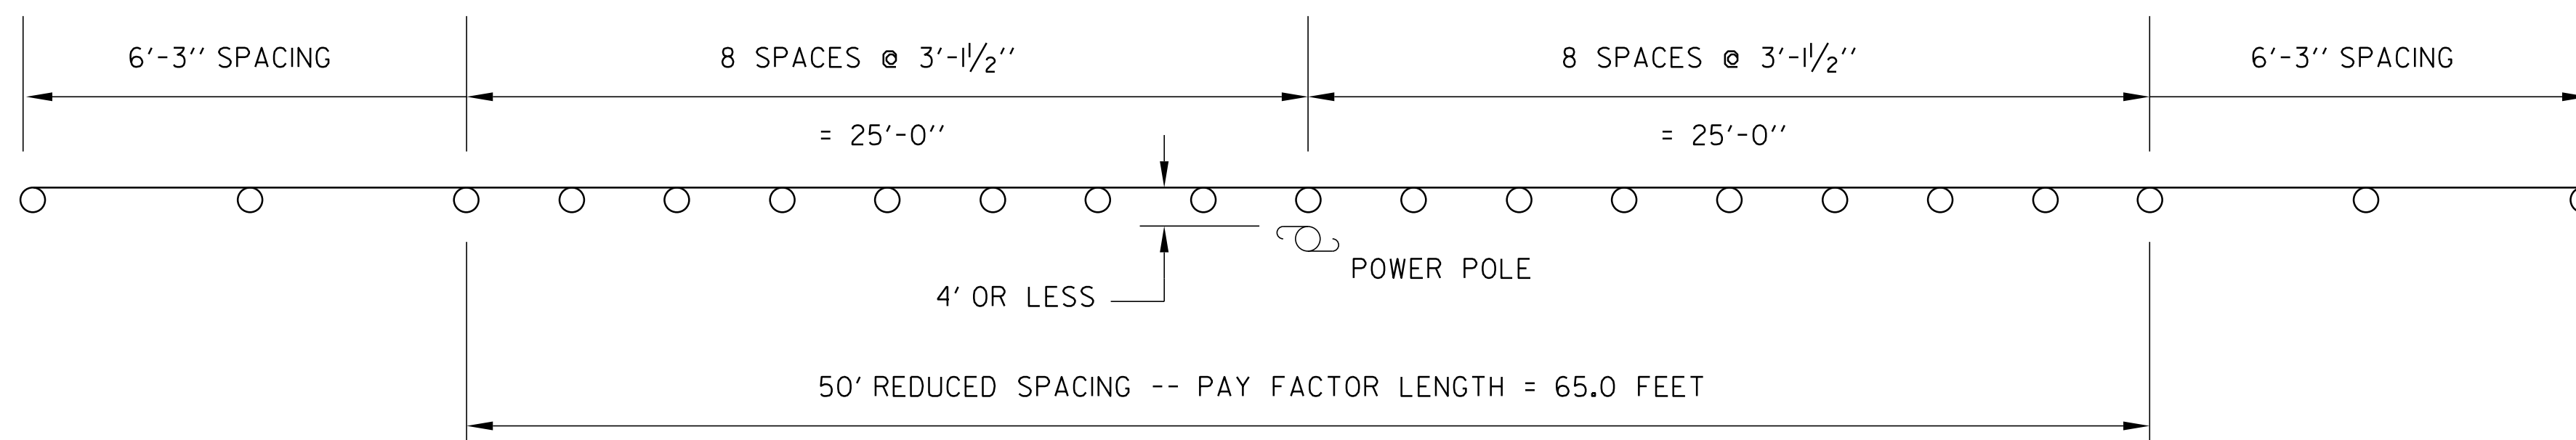

REDUCED SPACING GUARDRAIL DETAIL

OBJECTS WITHIN 4' OF GUARDRAIL

DETAILS ARE NOT TO SCALE

PROJECT TYPICAL SHEET 3	PROJECT NAME: TROY-NEWPORT	PLOT DATE: 25-OCT-2011 12:17
	PROJECT NUMBER: STP 2613(I)	DRAWN BY: SJL
	FILE NAME: 06B056.dgn	CHECKED BY: EPD
	PROJECT LEADER: CDL	SHEET 5 OF 31
DESIGNED BY: SJL		
PLOT FILE: 06b056*05.i		