


201.31 THINNING AND TRIMMING FOR SIGNS
10+24 LT

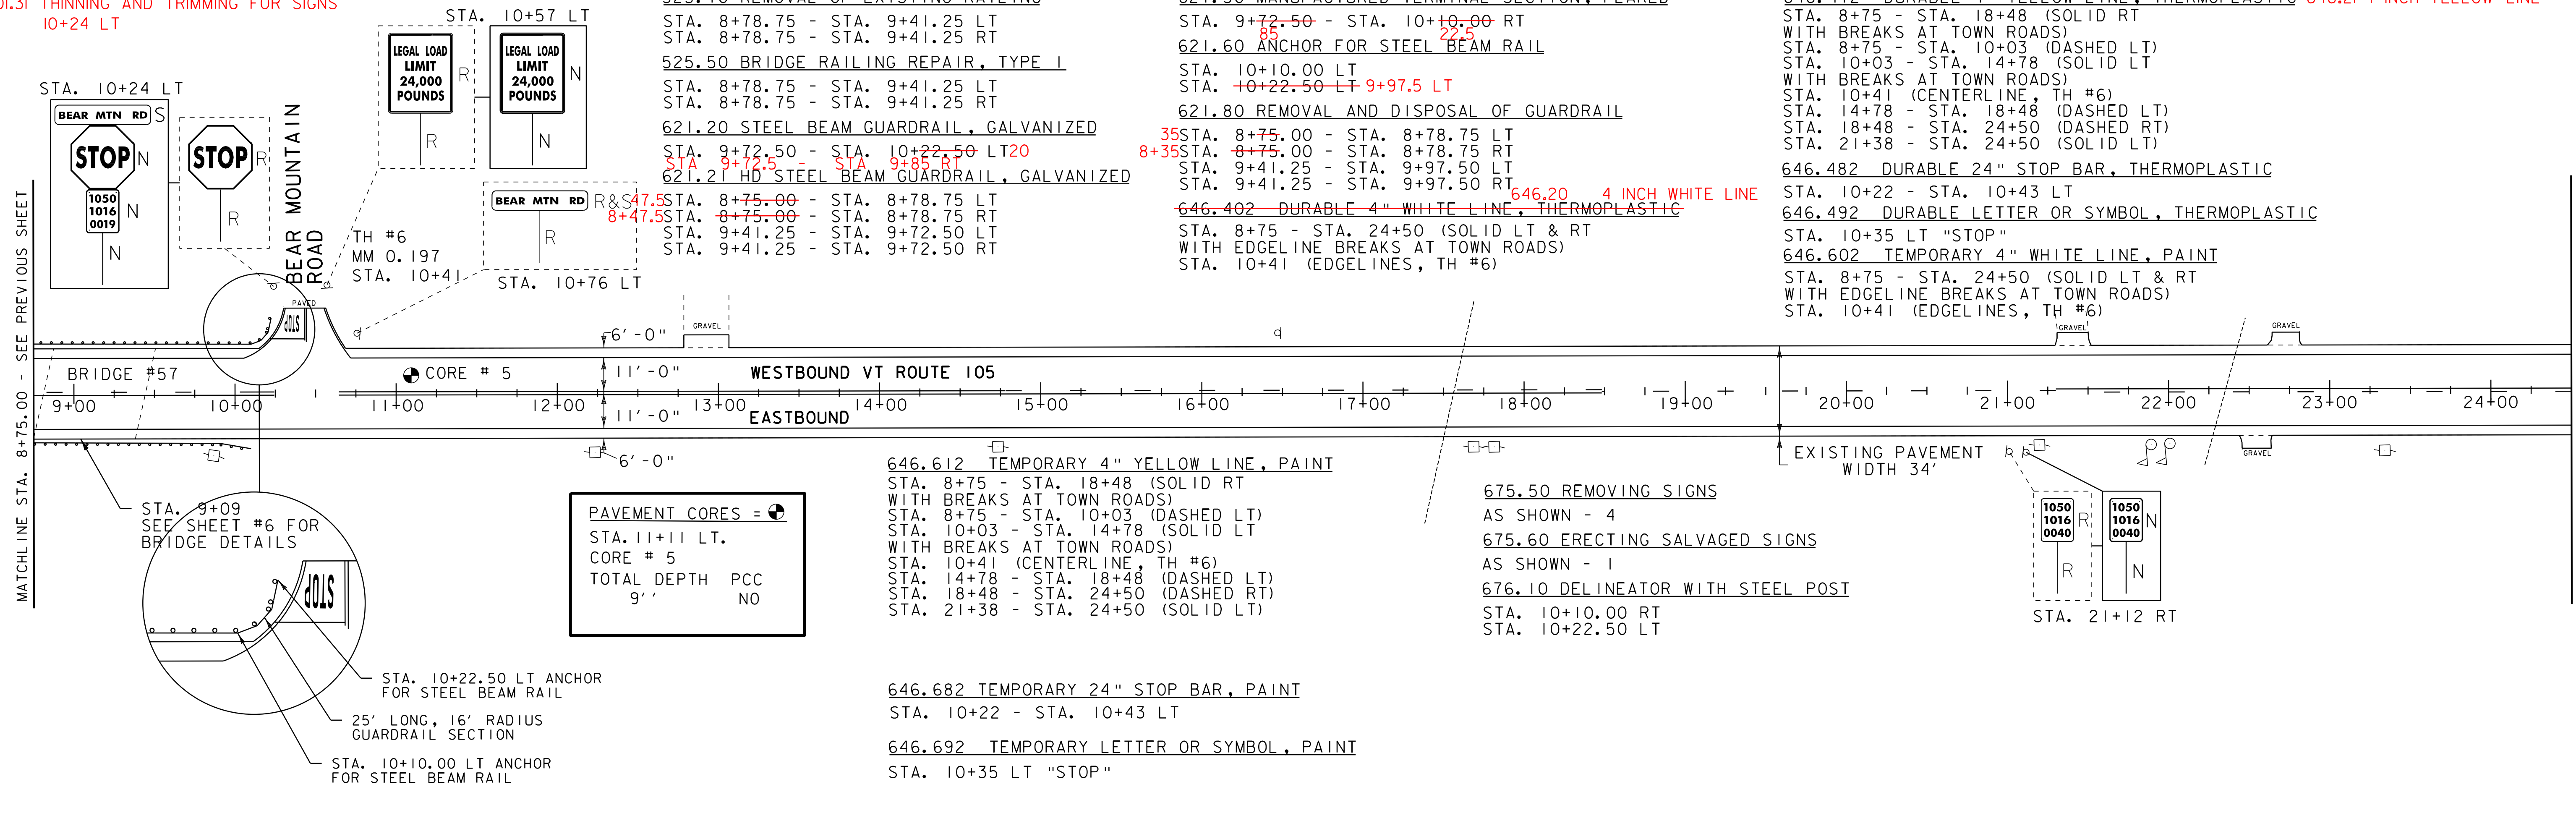

PAVEMENT CORES =	
STA. 11+11 LT.	CORE # 5
TOTAL DEPTH	PCC
9'	NO

621.50 MANUFACTURED TERMINAL SECTION, FLARED
STA. 26+08.00 - STA. 26+45.50 RT
STA. 32+22.00 - STA. 32+59.50 LT
~~STA. 33+20.50 - STA. 33+58.00 RT~~


621.80 REMOVAL AND DISPOSAL OF GUARDRAIL
STA. 27+83.00 - STA. 33+58.00 RT
STA. 33+22.00 - STA. 34+11.50 LT

~~646.20 4 INCH WHITE LINE~~
~~646.402 DURABLE 4" WHITE LINE, THERMOPLASTIC~~
STA. 24+50 - STA. 38+25 (SOLID LT & RT)

621.20 STEEL BEAM GUARDRAIL, GALVANIZED
STA. 26+45.50 - STA. 33+20.50 RT
STA. 32+59.50 - STA. 34+11.50 LT

621.60 ANCHOR FOR STEEL BEAM RAIL
STA. 33+99.00 LT STA 32+92.5 RT
STA. 34+11.50 LT STA 33+05 RT

676.10 DELINEATOR WITH STEEL POST
STA. 26+08.00 RT
STA. 32+22.00 LT
~~STA. 33+58.00 RT~~
STA. 34+11.50 LT
32+92 RT
34+87 LT

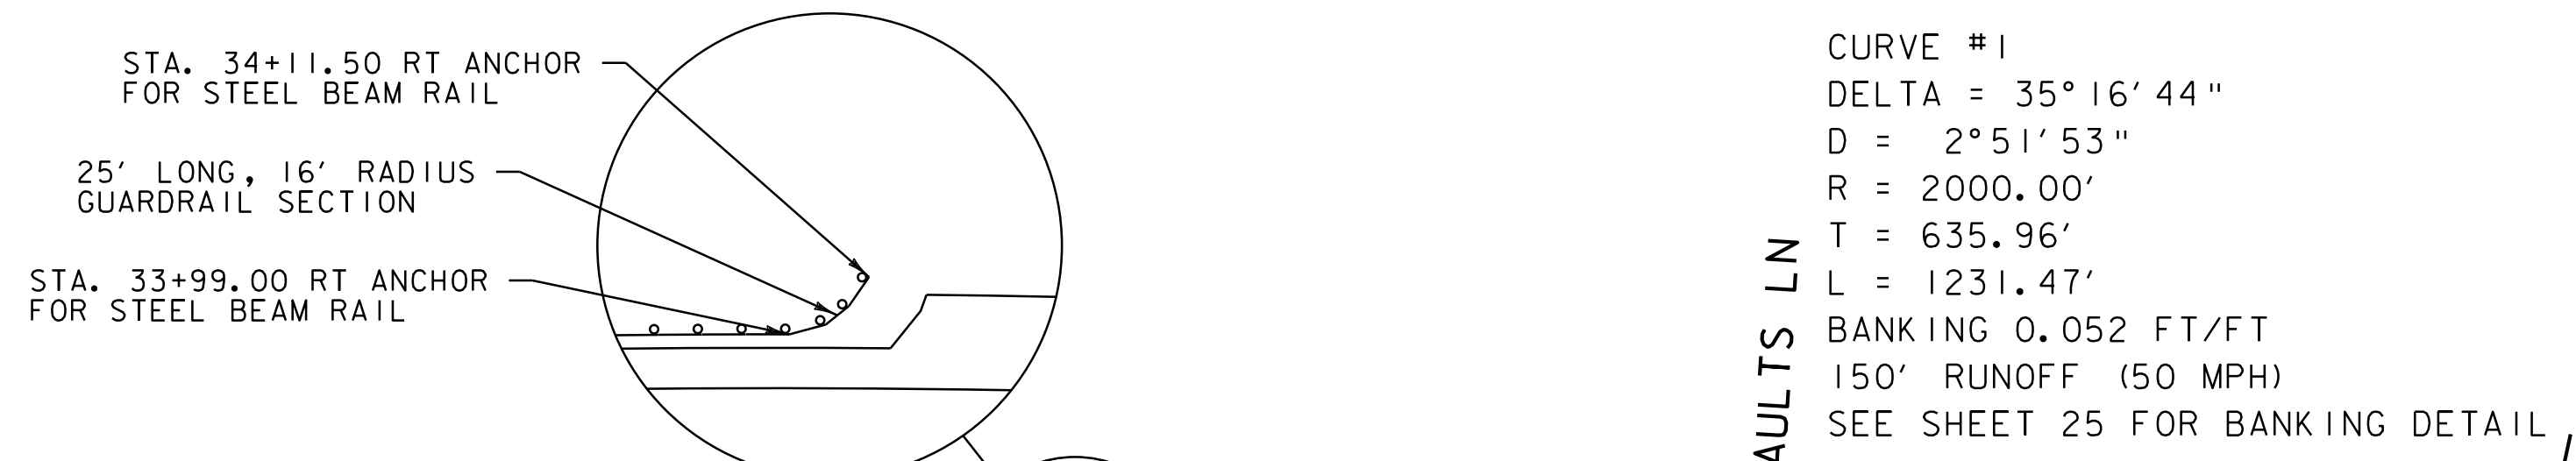

CURVE #1
DELTA = 35° 16' 44"
D = 2° 51' 53"
R = 2000.00'
T = 635.96'
L = 1231.47'
BANKING 0.052 FT/FT
150' RUNOFF (50 MPH)
SEE SHEET 25 FOR BANKING DETAIL

~~646.21 4 INCH YELLOW LINE~~
~~646.412 DURABLE 4" YELLOW LINE, THERMOPLASTIC~~
STA. 24+50 - STA. 27+72 (SOLID LT)
STA. 24+50 - STA. 27+72 (DASHED RT)
STA. 27+72 - STA. 35+64 (DASHED LT)
STA. 27+72 - STA. 38+25 (SOLID RT)
STA. 35+64 - STA. 38+25 (SOLID LT)

646.602 TEMPORARY 4" WHITE LINE, PAINT
STA. 24+50 - STA. 38+25 (SOLID LT & RT)

646.612 TEMPORARY 4" YELLOW LINE, PAINT
STA. 24+50 - STA. 27+72 (SOLID LT)
STA. 24+50 - STA. 27+72 (DASHED RT)
STA. 27+72 - STA. 35+64 (DASHED LT)
STA. 27+72 - STA. 38+25 (SOLID RT)
STA. 35+64 - STA. 38+25 (SOLID LT)

- LEGEND**
- MAILBOX
 - UTILITY POLE
 - HYDRANT
 - MANHOLE
 - WATER VALVE
 - ⊕ CATCH BASIN / DROP INLET
 - ⊕ RAILROAD CROSSING SIGNAL
- SIGN LEGEND**
- R = REMOVE
 - R&S = REMOVE AND SALVAGE
 - RET = RETAIN
 - S = SALVAGE
 - N = NEW
 - B-B = BACK TO BACK

PROJECT LAYOUT SHEET 7

PROJECT NAME: TROY-NEWPORT	PLOT DATE: 25-OCT-2011 12:18
PROJECT NUMBER: STP 2613(I)	DRAWN BY: SJL
FILE NAME: 06B056.dgn	DESIGNED BY: SJL
PROJECT LEADER: CDL	CHECKED BY: EPD
PLOT FILE: 06b056*20.i	SHEET 20 OF 31

NOT TO SCALE