

~~646.412 DURABLE 4" YELLOW LINE, THERMOPLASTIC~~
 646.21 4 INCH YELLOW LINE
 STA. 68+50 - STA. 78+14 (SOLID RT)
 STA. 68+50 - STA. 82+50 (SOLID LT)
 STA. 78+14 - STA. 82+50 (DASHED RT)


646.602 TEMPORARY 4" WHITE LINE, PAINT
 STA. 68+50 - STA. 82+50 (SOLID LT & RT)

646.612 TEMPORARY 4" YELLOW LINE, PAINT
 STA. 68+50 - STA. 78+14 (SOLID RT)
 STA. 68+50 - STA. 82+50 (SOLID LT)
 STA. 78+14 - STA. 82+50 (DASHED RT)

CURVE #5
 DELTA = 10°50'25"
 D = 3°34'52"
 R = 1600.00'
 T = 151.81'
 L = 302.72'
 BANKING 0.059 FT/FT
 150' RUNOFF (50 MPH)
 SEE SHEET 25 FOR BANKING DETAIL

~~646.402 DURABLE 4" WHITE LINE, THERMOPLASTIC~~
 646.20 4 INCH WHITE LINE
 STA. 68+50 - STA. 82+50 (SOLID LT & RT)

CURVE #4
 DELTA = 11°07'22"
 D = 2°51'53"
 R = 2000.00'
 T = 194.74'
 L = 388.26'
 BANKING 0.051 FT/FT
 150' RUNOFF (50 MPH)
 SEE SHEET 25 FOR BANKING DETAIL

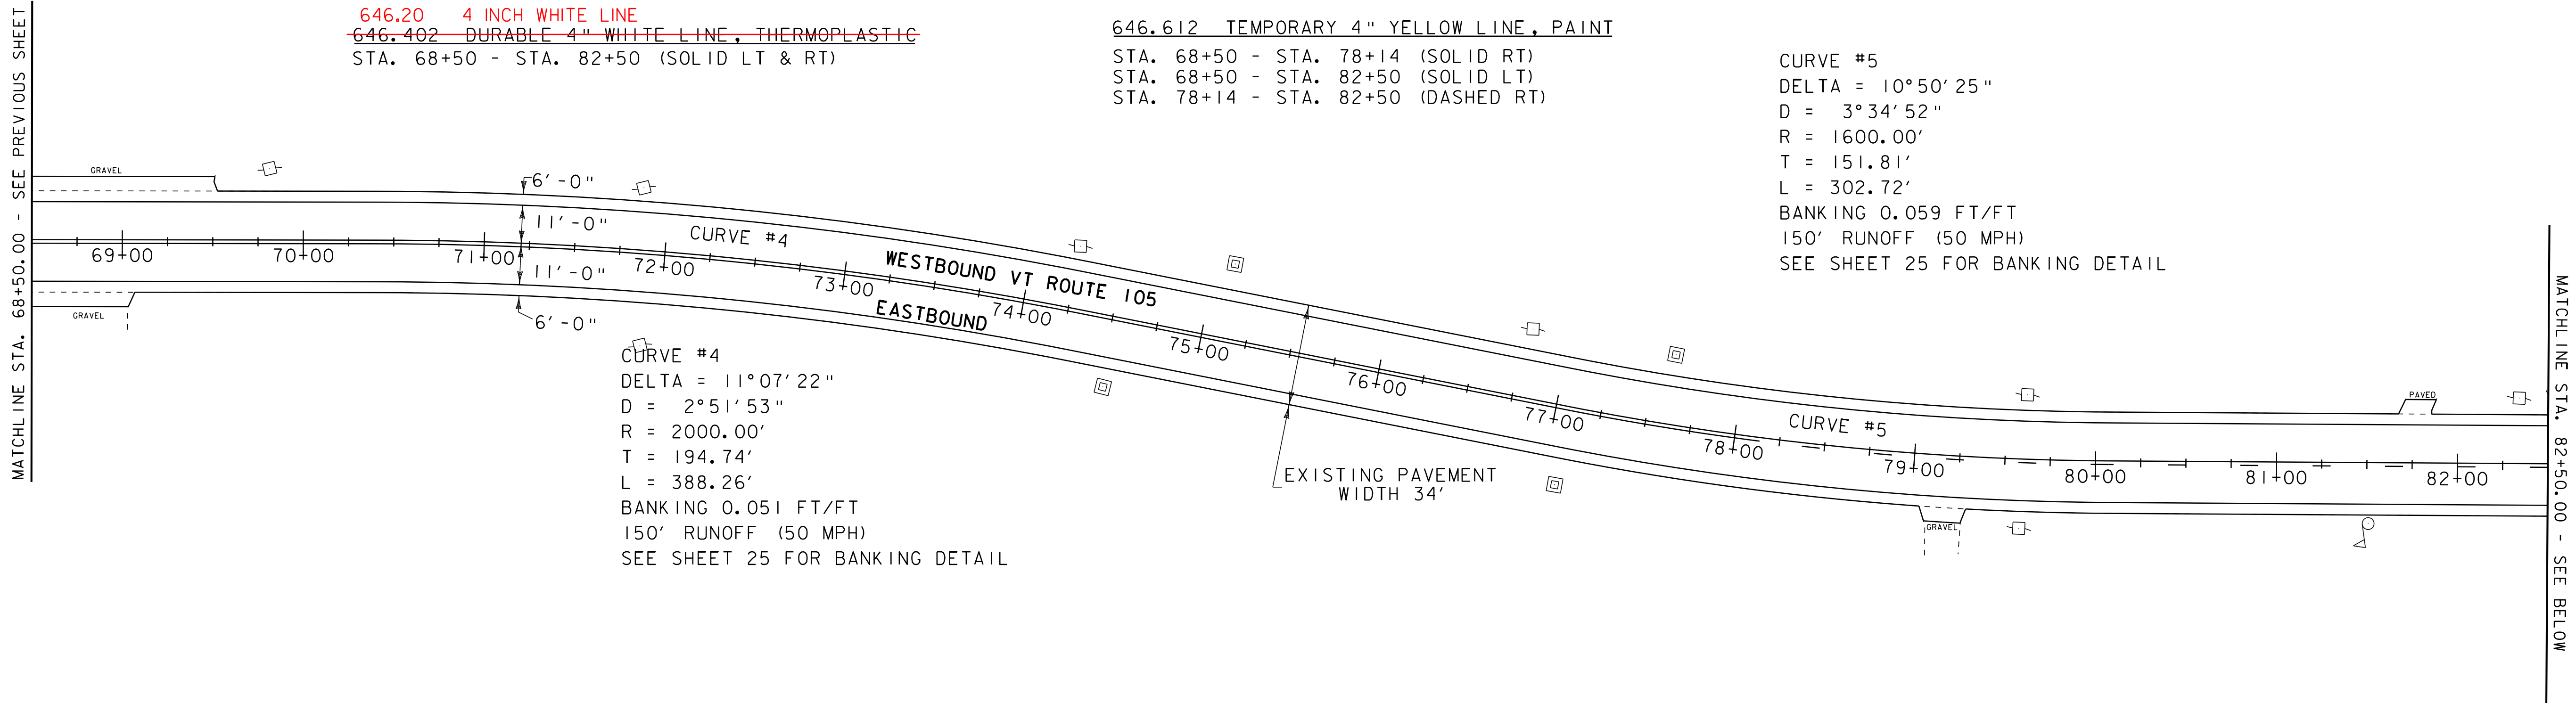


~~646.412 DURABLE 4" YELLOW LINE, THERMOPLASTIC~~
 646.21 4 INCH YELLOW LINE
 STA. 82+50 - STA. 86+06 (DASHED RT)
 STA. 82+50 - STA. 86+06 (SOLID LT)
 STA. 86+06 - STA. 95+57 (DASHED RT)
 STA. 95+57 - STA. 98+25 (DASHED LT)
 STA. 95+57 - STA. 98+25 (SOLID RT)
 646.602 TEMPORARY 4" WHITE LINE, PAINT
 STA. 82+50 - STA. 98+25 (SOLID LT & RT)


675.50 REMOVING SIGNS
 AS SHOWN - 1

~~646.402 DURABLE 4" WHITE LINE, THERMOPLASTIC~~
 646.20 4 INCH WHITE LINE
 STA. 82+50 - STA. 98+25 (SOLID LT & RT)

646.612 TEMPORARY 4" YELLOW LINE, PAINT
 STA. 82+50 - STA. 86+06 (DASHED RT)
 STA. 82+50 - STA. 86+06 (SOLID LT)
 STA. 86+06 - STA. 95+57 (DASHED RT)
 STA. 95+57 - STA. 98+25 (DASHED LT)
 STA. 95+57 - STA. 98+25 (SOLID RT)

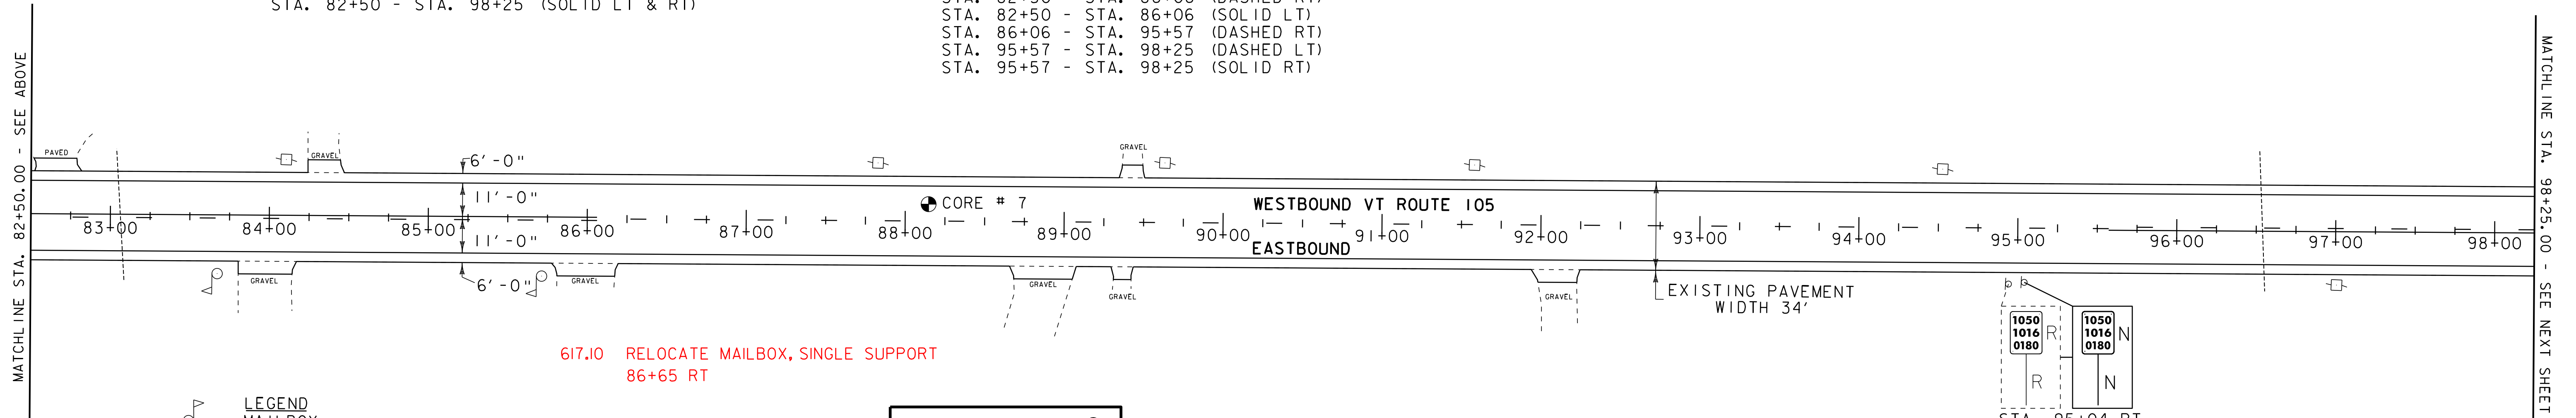

617.10 RELOCATE MAILBOX, SINGLE SUPPORT
 86+65 RT

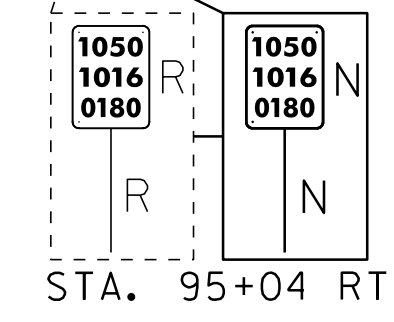

- LEGEND
- MAILBOX
 - UTILITY POLE
 - ⊙ HYDRANT
 - MANHOLE
 - WATER VALVE
 - ⊞ CATCH BASIN / DROP INLET
 - ⊕ RAILROAD CROSSING SIGNAL

PAVEMENT CORES = ⊕
 STA. 88+22 LT.
 CORE # 7
 TOTAL DEPTH PCC
 9' NO

- SIGN LEGEND
- R = REMOVE
 - R&S = REMOVE AND SALVAGE
 - RET = RETAIN
 - S = SALVAGE
 - N = NEW
 - B-B = BACK TO BACK

NOT TO SCALE

PROJECT LAYOUT SHEET 9

PROJECT NAME: TROY-NEWPORT
 PROJECT NUMBER: STP 2613(I)

FILE NAME: 06B056.dgn
 PROJECT LEADER: CDL
 DESIGNED BY: SJL
 PLOT FILE: 06b056*22.1

PLOT DATE: 25-OCT-2011 12:18
 DRAWN BY: SJL
 CHECKED BY: EPD
 SHEET 22 OF 31