

203.16 SOLID ROCK EXCAVATION

STA. 10+75 - STA. 10+80 LT

604.412, 604.415, 604.418 REHAB, DROP INLETS, CATCH BASINS, OR MANHOLES, CLASS I, CLASS II OR CLASS III

STA. 5+49 RT "TYPE D GRATE"
 STA. 6+75 RT & LT "TYPE D GRATE"
 STA. 9+10 RT & LT "TYPE D GRATE"
 STA. 10+92 LT "TYPE D GRATE"
 STA. 10+93 RT "TYPE D GRATE"

604.42 CHANGING ELEVATION OF SEWER MANHOLES

STA. 7+12 RT
 STA. 9+61 RT

618.10 PORTLAND CEMENT CONCRETE SIDEWALK, 5 INCH

STA. 10+75 - STA. 10+80 LT

618.30 DETECTABLE WARNING SURFACE

STA. 10+78 LT

646.402 DURABLE 4" WHITE LINE, THERMOPLASTIC

STA. 5+25 - STA. 11+00 (SOLID LT)
 STA. 5+25 - STA. 10+64 (SOLID RT)
 STA. 5+25 - STA. 10+64 (DASHED LT & RT)
 STA. 7+34 - STA. 8+69 (DOTTED RT)
 STA. 8+69 - STA. 10+64 (SOLID RT)

646.412 DURABLE 4" YELLOW LINE, THERMOPLASTIC

STA. 5+25 - STA. 10+64 (SOLID LT, CENTERLINE)

646.482 DURABLE 24" STOP BAR, THERMOPLASTIC

STA. 10+64 LT & RT

646.492 DURABLE LETTER OR SYMBOL, THERMOPLASTIC

STA. 8+75 LT "ONLY"
 STA. 9+36 LT ARROW
 STA. 9+97 LT "ONLY"
 STA. 10+58 LT ARROW

646.502 DURABLE CROSSWALK MARKING, THERMOPLASTIC

STA. 10+78 LT & RT

646.602 TEMPORARY 4" WHITE LINE, PAINT

STA. 5+25 - STA. 11+00 (SOLID LT)
 STA. 5+25 - STA. 10+64 (SOLID RT)
 STA. 5+25 - STA. 10+64 (DASHED LT & RT)
 STA. 7+34 - STA. 8+69 (DOTTED RT)
 STA. 8+69 - STA. 10+64 (SOLID RT)

646.612 TEMPORARY 4" YELLOW LINE, PAINT

STA. 5+25 - STA. 10+64 (SOLID LT, CENTERLINE)

646.682 TEMPORARY 24" STOP BAR, PAINT

STA. 10+64 LT & RT

646.692 TEMPORARY LETTER OR SYMBOL, PAINT


STA. 8+75 LT "ONLY"
 STA. 9+36 LT ARROW
 STA. 9+97 LT "ONLY"
 STA. 10+58 LT ARROW

646.702 TEMPORARY CROSSWALK MARKING, PAINT

STA. 10+78 LT & RT

675.50 REMOVING SIGNS

AS SHOWN - 1

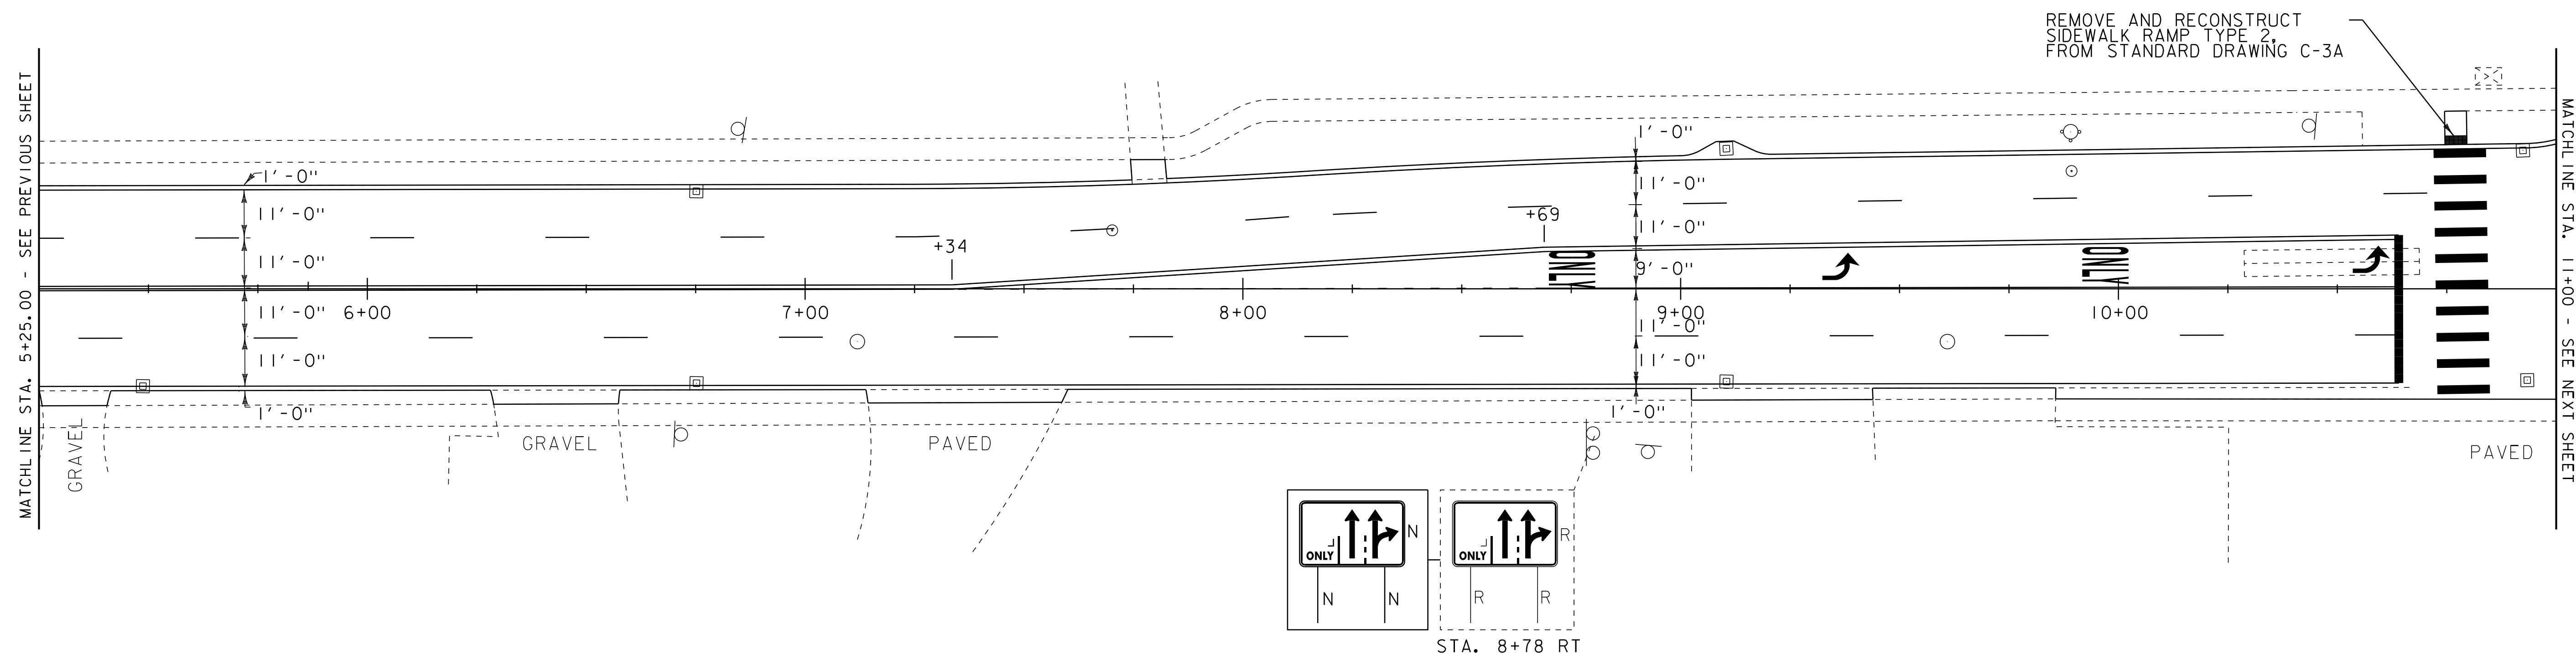

NOTE
 1.) ALL VALVE BOX ADJUSTMENTS TO BE DONE BY OTHERS.

- LEGEND**
- HYDRANT
 - MANHOLE
 - WATER VALVE
 - GAS PIPELINE MARKER
 - CATCH BASIN / DROP INLET
 - CURB INLET
 - ⊠ TRAFFIC CONTROL BOX
 - ⊕ RAILROAD CROSSING SIGNAL
- SIGN LEGEND**
- R = REMOVE
 - R&S = REMOVE AND SALVAGE
 - RET = RETAIN
 - S = SALVAGE
 - N = NEW
 - B-B = BACK TO BACK

DATUM	
VERTICAL	N/A
HORIZONTAL	N/A

NOT TO SCALE

PROJECT LAYOUT SHEET 2	PROJECT NAME: COLCHESTER-ESSEX
	PROJECT NUMBER: STP 2616(I)
	FILE NAME: p06b062.dgn
	PLOT DATE: 30-OCT-2012 12:0
PROJECT LEADER: EPD	DRAWN BY: SJL
DESIGNED BY: CDL	CHECKED BY: EPD
PLOT FILE: p06b062pl02.i	SHEET 10 OF 45