


- 646.402 DURABLE 4" WHITE LINE, THERMOPLASTIC  
 STA. 22+75 - STA. 24+52 (SOLID LT)  
 STA. 24+52 - STA. 26+22 (DOTTED LT)  
 STA. 22+75 - STA. 28+75 (SOLID LT)  
 WITH EDGELINE BREAK AT ST. MICHAELS ACCESS  
 STA. 22+75 - STA. 28+75 (DASHED LT & RT)  
 STA. 22+75 - STA. 28+75 (SOLID RT)  
 EDGELINE ALONG JUGHANDLE  
 STA. 26+93 - STA. 27+58 (SOLID RT)  
 STA. 27+82 - STA. 28+75 (SOLID RT)
- 646.442 DURABLE 8" WHITE LINE, THERMOPLASTIC  
 STA. 26+48 - STA. 26+93 (SOLID RT)  
 STA. 26+55 - STA. 26+88 (SOLID RT)  
 STA. 26+55 - STA. 26+93 (HATCHED RT)
- 646.482 DURABLE 24" STOP BAR, THERMOPLASTIC  
 STA. 23+30 - STA. 23+46 LT
- 646.492 DURABLE LETTER OR SYMBOL, THERMOPLASTIC  
 STA. 23+38 LT ARROW    STA. 26+95 LT "AHEAD"  
 STA. 23+37 LT "STOP"    STA. 27+35 LT "SIGNAL"  
 STA. 24+06 LT "ONLY"    STA. 27+35 LT "SIGNAL"  
 STA. 26+95 LT "AHEAD"    STA. 27+41 RT YIELD ARROWS (JUGHANDLE)
- 646.502 DURABLE CROSSWALK MARKING, THERMOPLASTIC  
 STA. 23+27 - STA. 23+63 LT
- 646.602 TEMPORARY 4" WHITE LINE, PAINT  
 STA. 22+75 - STA. 24+52 (SOLID LT)  
 STA. 24+52 - STA. 26+22 (DOTTED LT)  
 STA. 22+75 - STA. 28+75 (SOLID LT)  
 WITH EDGELINE BREAK AT ST. MICHAELS ACCESS  
 STA. 22+75 - STA. 28+75 (DASHED LT & RT)  
 STA. 22+75 - STA. 28+75 (SOLID RT)  
 EDGELINE ALONG JUGHANDLE  
 STA. 26+93 - STA. 27+58 (SOLID RT)  
 STA. 27+82 - STA. 28+75 (SOLID RT)

- 646.412 DURABLE 4" YELLOW LINE, THERMOPLASTIC  
 STA. 26+92 - STA. 27+54 (SOLID RT)  
 EDGELINE OF JUGHANDLE  
 STA. 27+82 - STA. 28+75 (SOLID RT)  
 EDGELINE OF JUGHANDLE  
 STA. 22+75 - STA. 27+76 (SOLID RT)  
 BOTH EDGES OF MEDIAN  
 STA. 28+12 - STA. 28+75 (SOLID RT)  
 BOTH EDGES OF MEDIAN  
 STA. 23+46 LT (CENTERLINE ST. MICHAELS ACCESS)

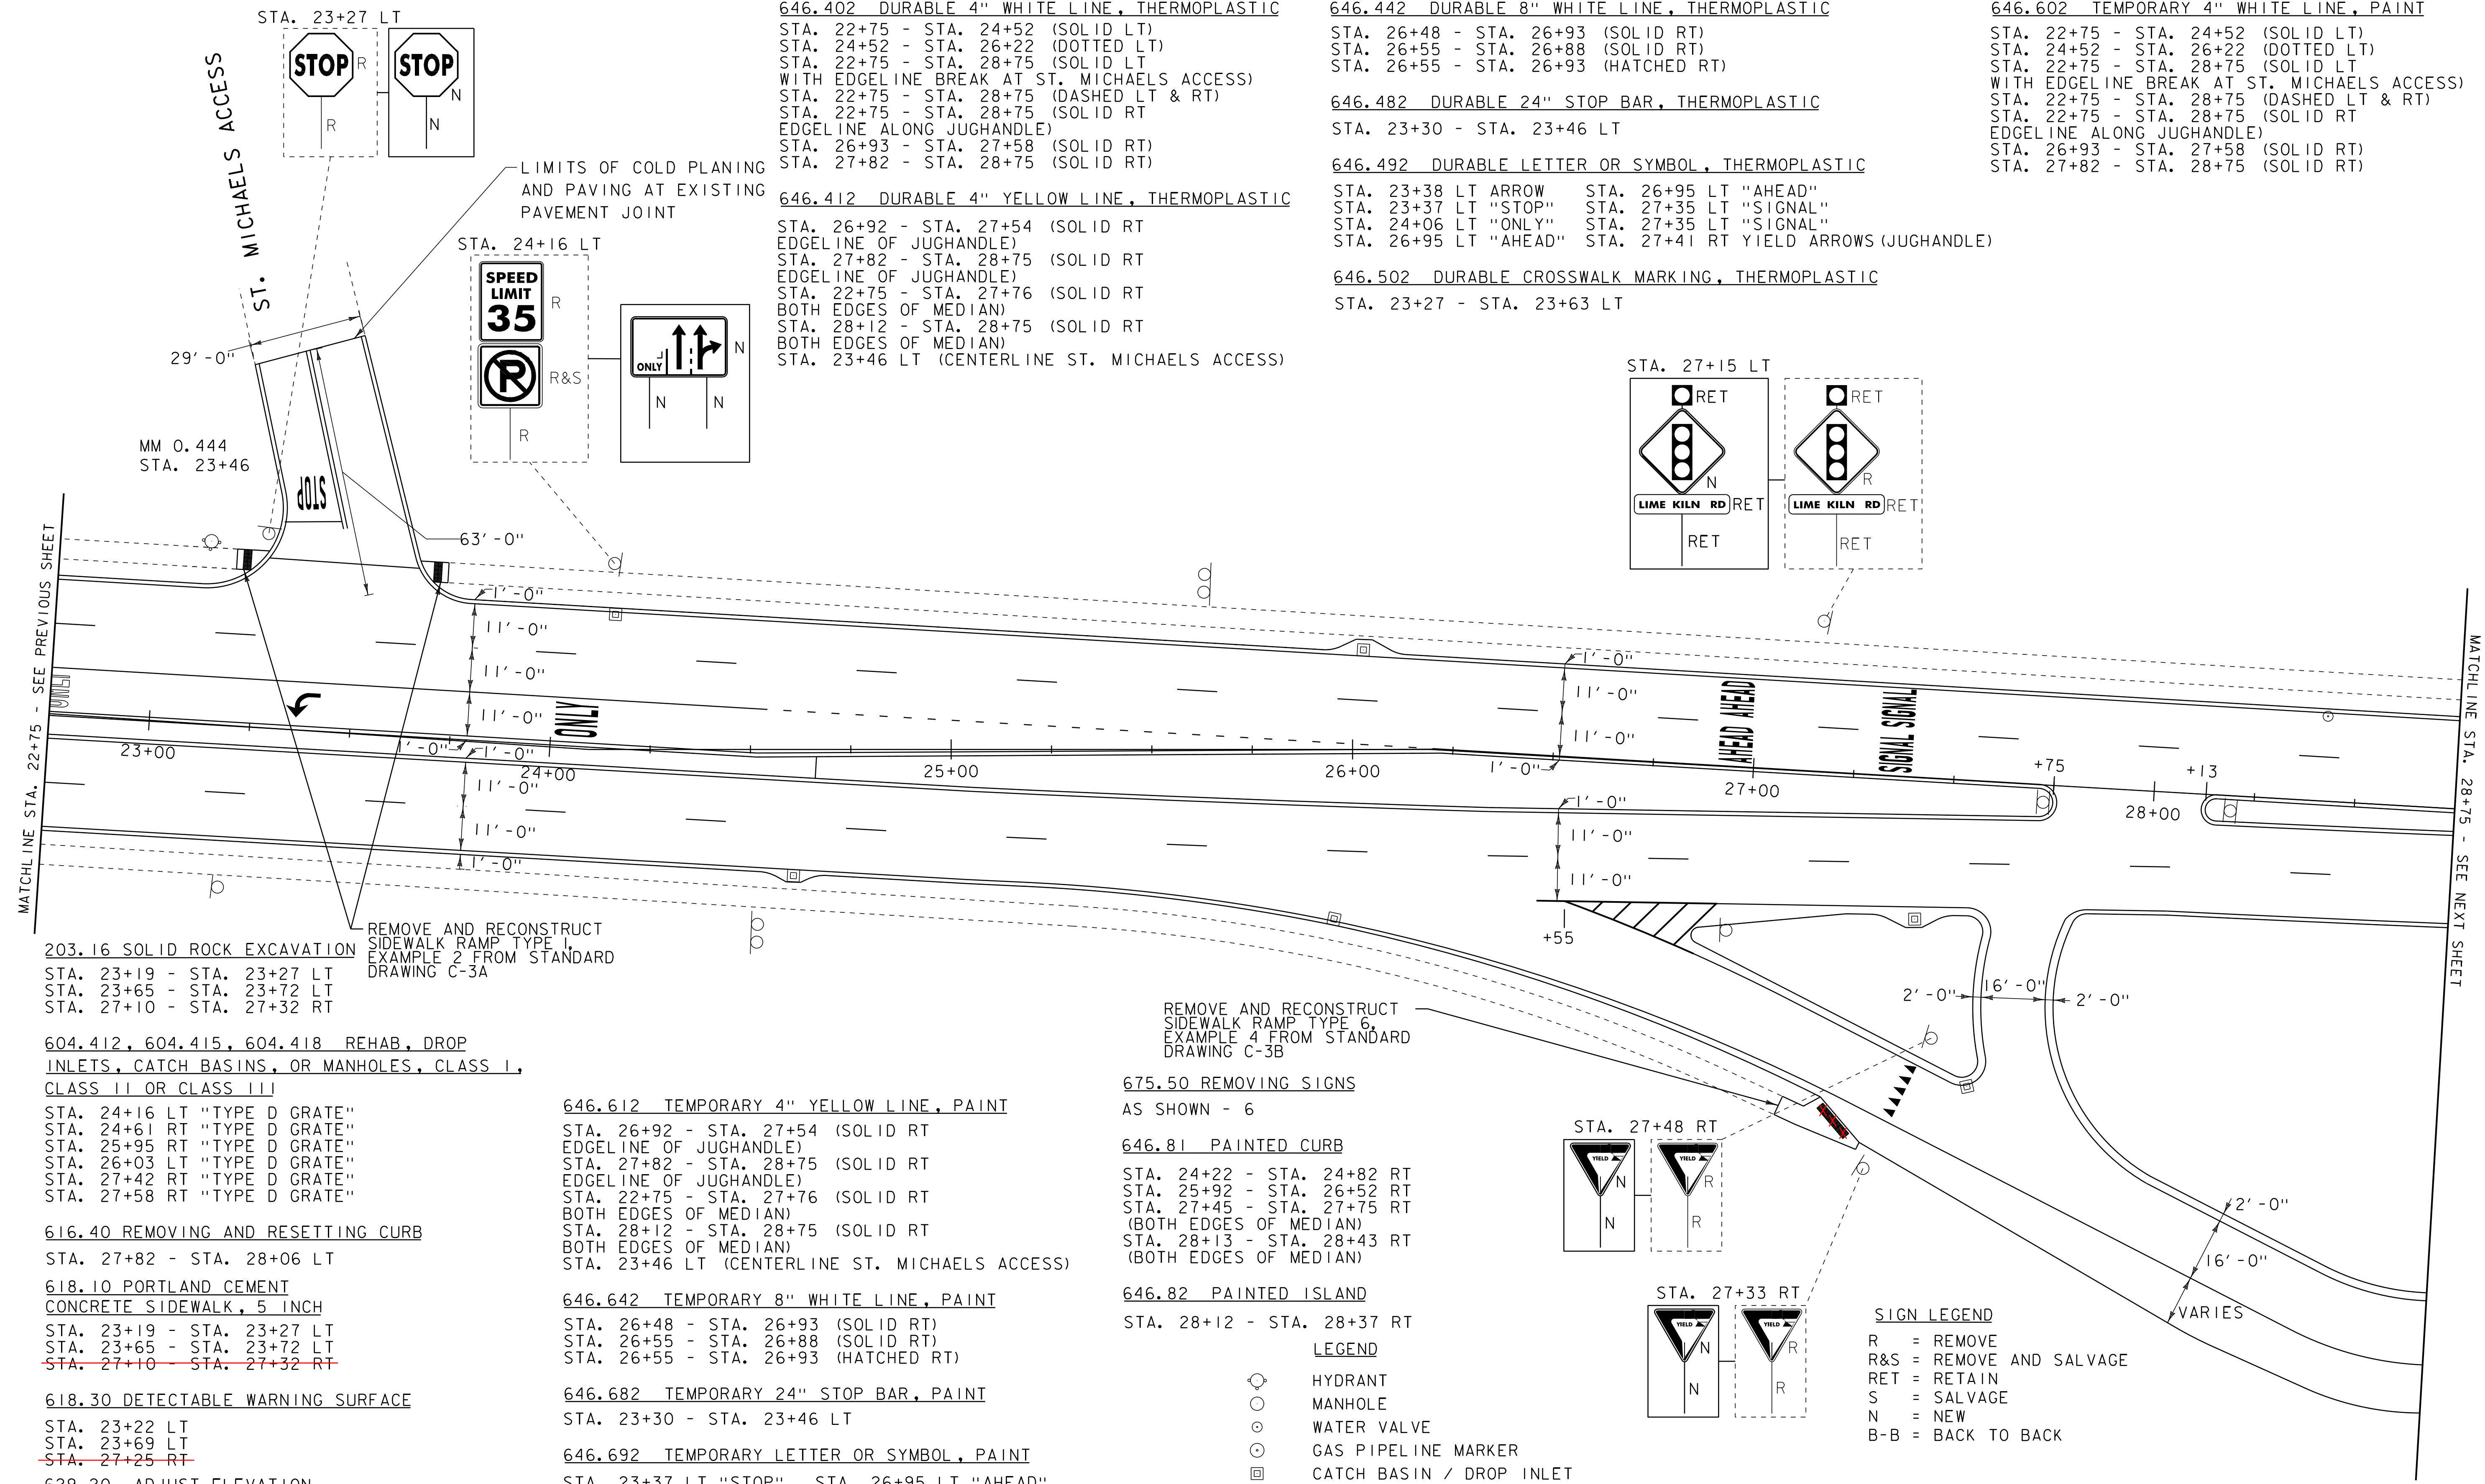

- 203.16 SOLID ROCK EXCAVATION  
 STA. 23+19 - STA. 23+27 LT  
 STA. 23+65 - STA. 23+72 LT  
 STA. 27+10 - STA. 27+32 RT

- 604.412, 604.415, 604.418 REHAB, DROP  
 INLETS, CATCH BASINS, OR MANHOLES, CLASS I,  
 CLASS II OR CLASS III

- STA. 24+16 LT "TYPE D GRATE"  
 STA. 24+61 RT "TYPE D GRATE"  
 STA. 25+95 RT "TYPE D GRATE"  
 STA. 26+03 LT "TYPE D GRATE"  
 STA. 27+42 RT "TYPE D GRATE"  
 STA. 27+58 RT "TYPE D GRATE"

- 616.40 REMOVING AND RESETTING CURB  
 STA. 27+82 - STA. 28+06 LT

- 618.10 PORTLAND CEMENT  
 CONCRETE SIDEWALK, 5 INCH  
 STA. 23+19 - STA. 23+27 LT  
 STA. 23+65 - STA. 23+72 LT  
~~STA. 27+10 - STA. 27+32 RT~~

- 618.30 DETECTABLE WARNING SURFACE  
 STA. 23+22 LT  
 STA. 23+69 LT  
~~STA. 27+25 RT~~

- 629.20 ADJUST ELEVATION  
 OF VALVE BOX  
 STA. 28+42 LT

- 646.612 TEMPORARY 4" YELLOW LINE, PAINT  
 STA. 26+92 - STA. 27+54 (SOLID RT)  
 EDGELINE OF JUGHANDLE  
 STA. 27+82 - STA. 28+75 (SOLID RT)  
 EDGELINE OF JUGHANDLE  
 STA. 22+75 - STA. 27+76 (SOLID RT)  
 BOTH EDGES OF MEDIAN  
 STA. 28+12 - STA. 28+75 (SOLID RT)  
 BOTH EDGES OF MEDIAN  
 STA. 23+46 LT (CENTERLINE ST. MICHAELS ACCESS)

- 646.642 TEMPORARY 8" WHITE LINE, PAINT  
 STA. 26+48 - STA. 26+93 (SOLID RT)  
 STA. 26+55 - STA. 26+88 (SOLID RT)  
 STA. 26+55 - STA. 26+93 (HATCHED RT)

- 646.682 TEMPORARY 24" STOP BAR, PAINT  
 STA. 23+30 - STA. 23+46 LT

- 646.692 TEMPORARY LETTER OR SYMBOL, PAINT  
 STA. 23+37 LT "STOP"    STA. 26+95 LT "AHEAD"  
 STA. 23+38 LT ARROW    STA. 27+35 LT "SIGNAL"  
 STA. 24+06 LT "ONLY"    STA. 27+35 LT "SIGNAL"  
 STA. 26+95 LT "AHEAD"    STA. 27+41 RT YIELD ARROWS (JUGHANDLE)

- 646.702 TEMPORARY CROSSWALK MARKING, PAINT  
 STA. 23+27 - STA. 23+63 LT




- REMOVE AND RECONSTRUCT  
 SIDEWALK RAMP TYPE 6,  
 EXAMPLE 4 FROM STANDARD  
 DRAWING C-3B

- 675.50 REMOVING SIGNS  
 AS SHOWN - 6

- 646.81 PAINTED CURB  
 STA. 24+22 - STA. 24+82 RT  
 STA. 25+92 - STA. 26+52 RT  
 STA. 27+45 - STA. 27+75 RT  
 (BOTH EDGES OF MEDIAN)  
 STA. 28+13 - STA. 28+43 RT  
 (BOTH EDGES OF MEDIAN)

- 646.82 PAINTED ISLAND  
 STA. 28+12 - STA. 28+37 RT

- LEGEND
- HYDRANT
- MANHOLE
- WATER VALVE
- GAS PIPELINE MARKER
- CATCH BASIN / DROP INLET
- CURB INLET
- ⊕ TRAFFIC CONTROL BOX
- ⊕ RAILROAD CROSSING SIGNAL

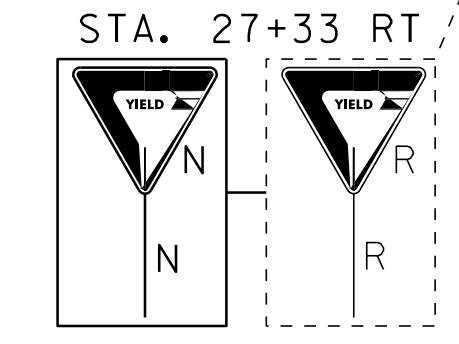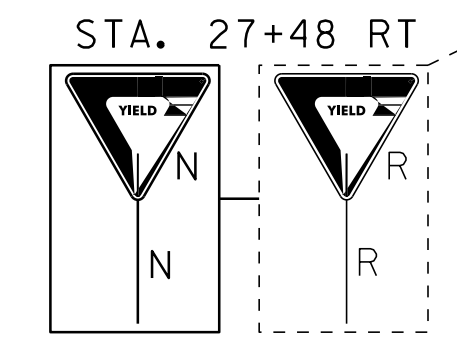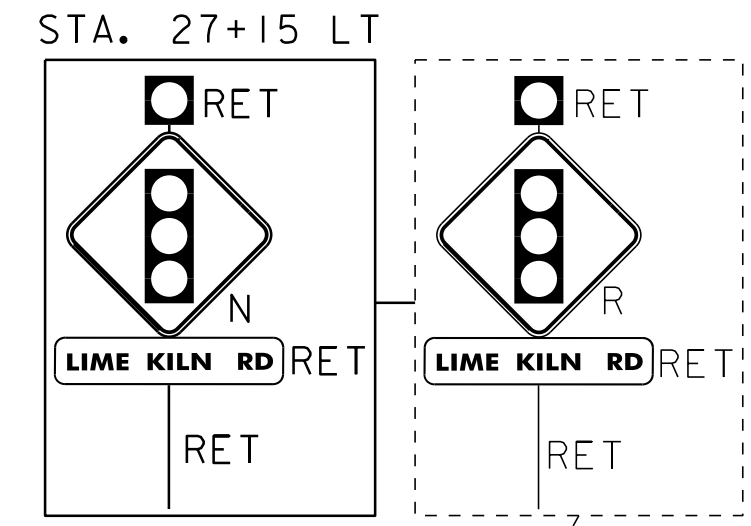

- SIGN LEGEND
- R = REMOVE
- R&S = REMOVE AND SALVAGE
- RET = RETAIN
- S = SALVAGE
- N = NEW
- B-B = BACK TO BACK

DATUM	
VERTICAL	N/A
HORIZONTAL	N/A

NOT TO SCALE

<b>PROJECT LAYOUT SHEET 5</b>	PROJECT NAME: COLCHESTER-ESSEX
	PROJECT NUMBER: STP 2616(I)S
	FILE NAME: p06b062.dgn
	PROJECT LEADER: EPD
	DESIGNED BY: CDL
PLOT FILE: p06b062pl05.i	PLOT DATE: 30-OCT-2012 12:0
	DRAWN BY: SJL
	CHECKED BY: EPD
	SHEET 13 OF \$SH\$