






604.412, 604.415, 604.418 REHAB, DROP  
INLETS, CATCH BASINS, OR MANHOLES, CLASS I,  
CLASS II OR CLASS III

STA. 42+16 RT "TYPE D GRATE"  
STA. 42+17 LT "TYPE D GRATE"  
STA. 43+63 RT&LT "TYPE D GRATE"  
STA. 45+06 LT "TYPE D GRATE"  
STA. 45+15 RT "TYPE D GRATE"

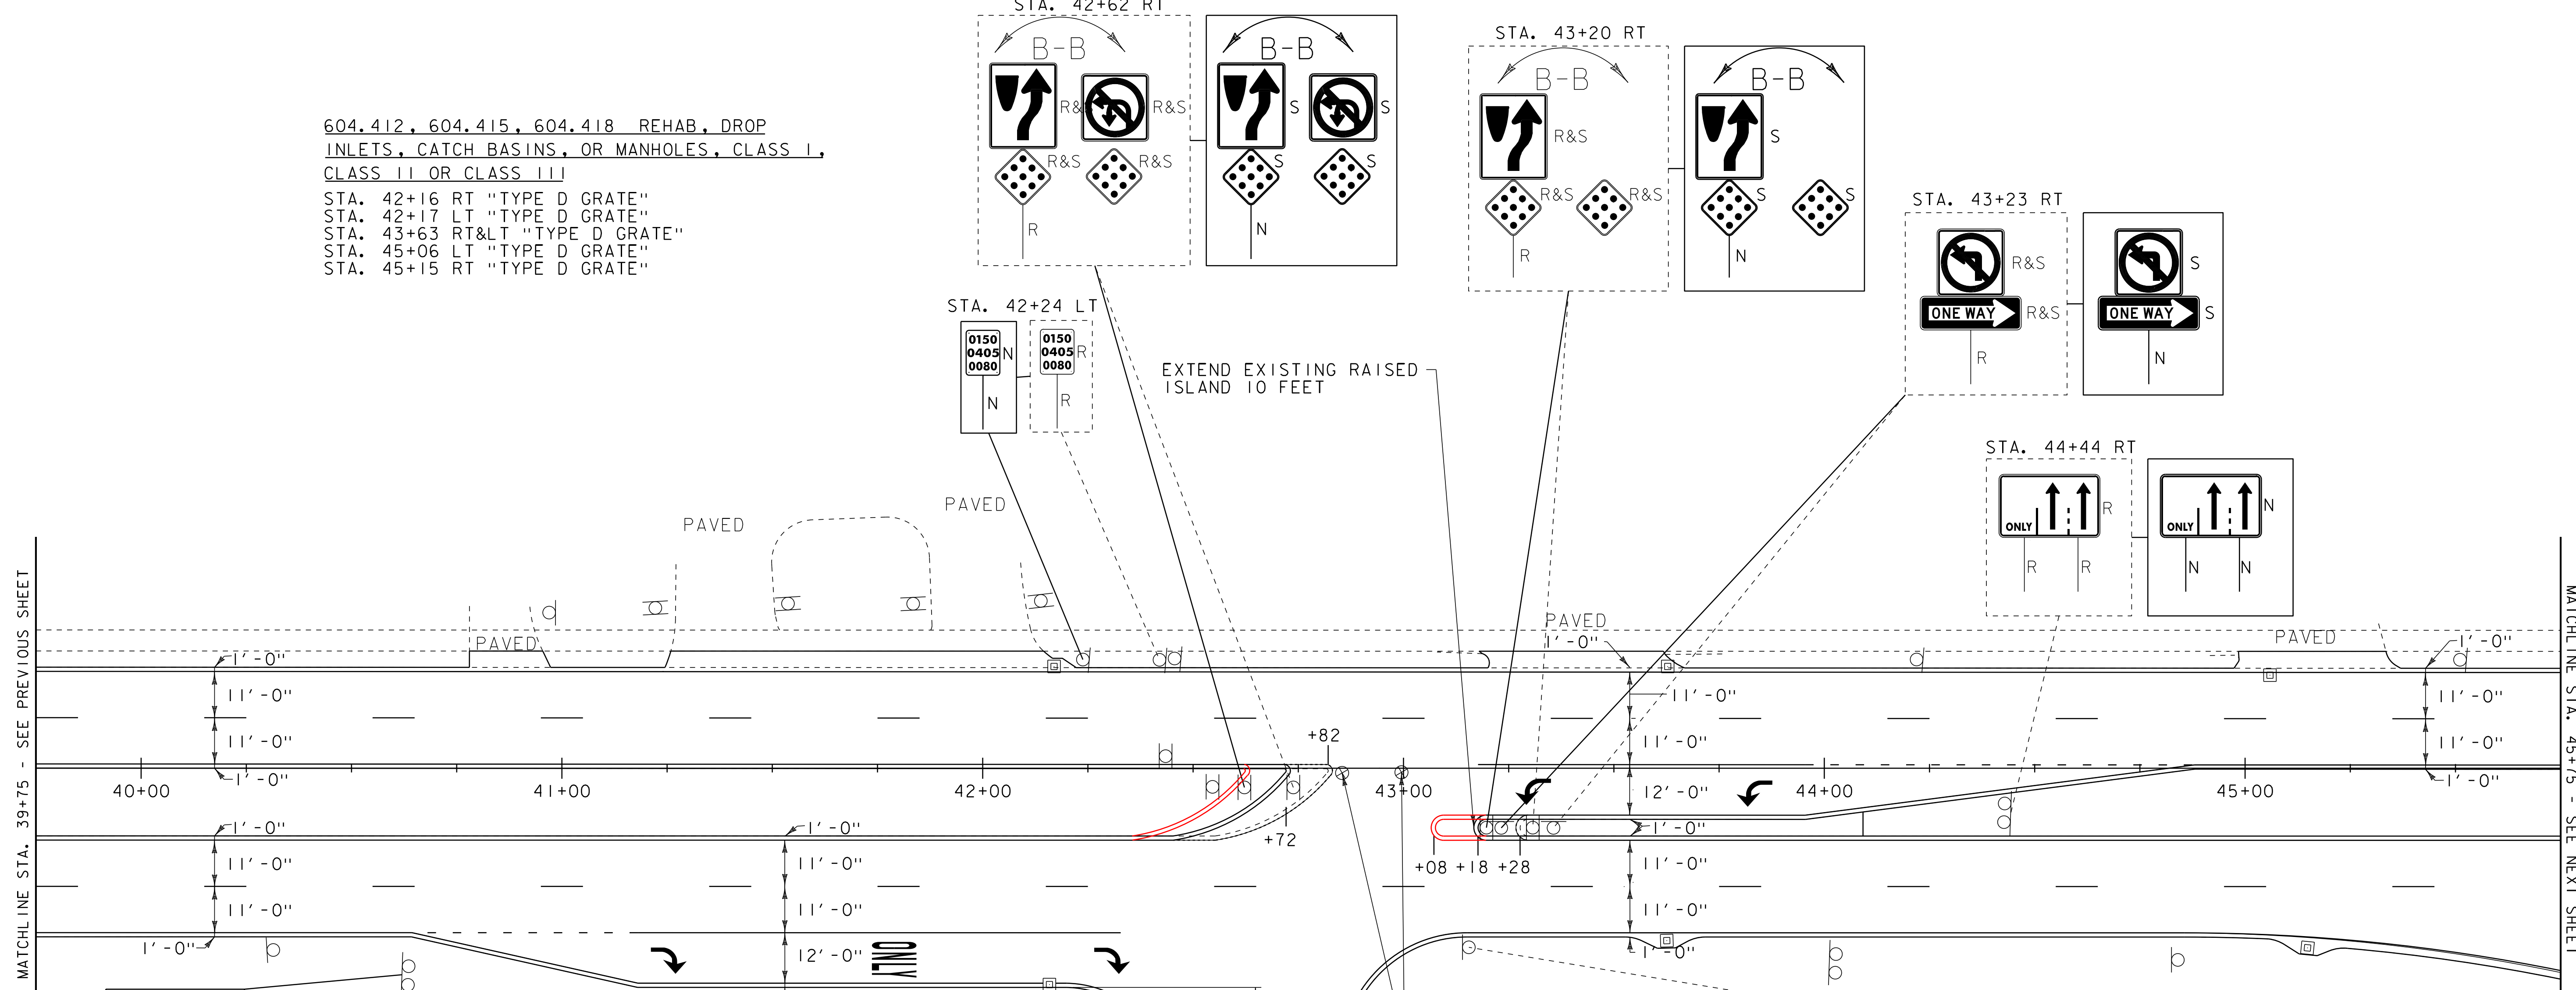

MATCHLINE STA. 39+75 - SEE PREVIOUS SHEET

MATCHLINE STA. 45+75 - SEE NEXT SHEET

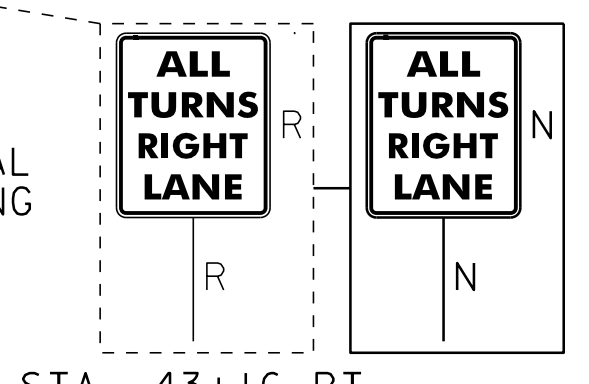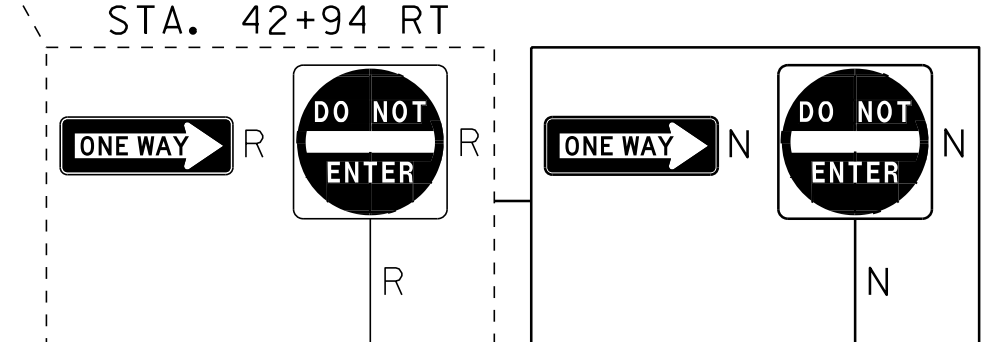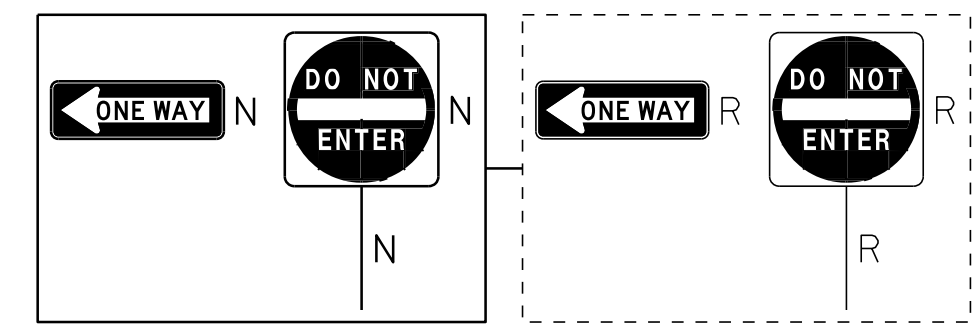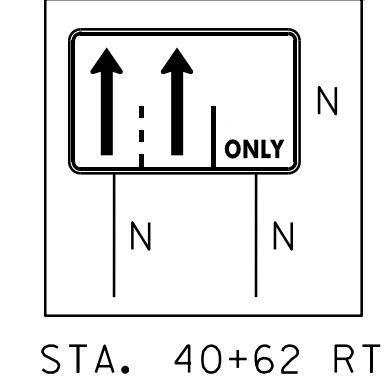

616.40 REMOVING AND RESETTING CURB  
~~STA. 42+45 - STA. 42+72 RT (32.5 LF)~~  
~~STA. 43+18 - STA. 43+20 RT (6 LF)~~  
~~STA. 42+40 - STA. 42+67 RT (32.5 LF)~~

616.41 REMOVAL OF EXISTING CURB  
STA. 42+~~45~~40 - STA. 42+55 RT  
STA. 42+~~47~~67 - STA. 42+82 RT  
STA. 43+12 - STA. 43+20 LT (8 LF)

646.402 DURABLE 4" WHITE LINE, THERMOPLASTIC  
STA. 39+75 - STA. 42+45 (SOLID RT)  
STA. 39+75 - STA. 45+75 (SOLID LT)  
STA. 39+75 - STA. 45+75 (DASHED LT & RT)  
STA. 40+64 - STA. 41+18 (DOTTED RT)  
STA. 41+18 - STA. 42+33 (SOLID RT)  
STA. 42+86 - STA. 45+75 (SOLID RT)  
STA. 43+18 - STA. 43+95 (SOLID LT)  
STA. 43+95 - STA. 44+88 (DOTTED LT)

646.412 DURABLE 4" YELLOW LINE, THERMOPLASTIC  
STA. 39+75 - STA. 42+73 (SOLID RT BOTH EDGES OF MEDIAN)  
STA. 43+18 - STA. 45+75 (SOLID RT BOTH EDGES OF MEDIAN)

646.492 DURABLE LETTER OR SYMBOL, THERMOPLASTIC  
STA. 41+26 RT ARROW  
STA. 41+79 RT "ONLY"  
STA. 42+31 RT ARROW  
STA. 43+31 RT ARROW  
STA. 43+83 LT ARROW

646.692 TEMPORARY LETTER OR SYMBOL, PAINT  
STA. 41+26 RT ARROW  
STA. 41+79 RT "ONLY"  
STA. 42+31 RT ARROW  
STA. 43+31 RT ARROW  
STA. 43+83 LT ARROW

646.602 TEMPORARY 4" WHITE LINE, PAINT  
STA. 39+75 - STA. 42+45 (SOLID RT)  
STA. 39+75 - STA. 45+75 (SOLID LT)  
STA. 39+75 - STA. 45+75 (DASHED LT & RT)  
STA. 40+64 - STA. 41+18 (DOTTED RT)  
STA. 41+18 - STA. 42+33 (SOLID RT)  
STA. 42+86 - STA. 45+75 (SOLID RT)  
STA. 43+18 - STA. 43+95 (SOLID LT)  
STA. 43+95 - STA. 44+88 (DOTTED LT)

646.612 TEMPORARY 4" YELLOW LINE, PAINT  
STA. 39+75 - STA. 42+73 (SOLID RT BOTH EDGES OF MEDIAN)  
STA. 43+18 - STA. 45+75 (SOLID RT BOTH EDGES OF MEDIAN)

646.81 PAINTED CURB  
STA. 40+34 - STA. 41+48 RT  
STA. 42+42 - STA. 42+72 RT (BOTH EDGES OF MEDIAN)  
STA. 43+18 - STA. 43+48 RT (BOTH EDGES OF MEDIAN)  
STA. 43+65 - STA. 44+25 RT  
STA. 44+58 - STA. 45+18 RT

646.82 PAINTED ISLAND  
STA. 43+18 - STA. 43+52 RT

675.50 REMOVING SIGNS  
AS SHOWN - 16

675.60 ERECTING SALVAGED SIGNS  
AS SHOWN - 9

616.20 GRANITE SLOPE EDGING  
STA. 43+~~18~~08 - STA. 43+28 RT (BOTH EDGES OF MEDIAN)

616.21 VERTICAL GRANITE CURB  
STA. 43+12 - STA. 43+20 LT (8 LF)

EXTEND EXISTING RAISED ISLAND 10 FEET

REMOVE EXISTING BOLLARDS. PAYMENT CONSIDERED INCIDENTAL TO ITEM 210.10, "COLD PLANING BITUMINOUS PAVEMENT".

LIMITS OF COLD PLANING AND PAVING AT EXISTING PAVEMENT JOINT

NOT TO SCALE

LEGEND

- ⊙ HYDRANT
- MANHOLE
- ⊙ WATER VALVE
- ⊙ GAS PIPELINE MARKER
- ⊙ CATCH BASIN / DROP INLET
- ⊙ CURB INLET
- ⊙ TRAFFIC CONTROL BOX
- ⊕ RAILROAD CROSSING SIGNAL

SIGN LEGEND

- R = REMOVE
- R&S = REMOVE AND SALVAGE
- RET = RETAIN
- S = SALVAGE
- N = NEW
- B-B = BACK TO BACK

PROJECT LAYOUT SHEET 8

PROJECT NAME: COLCHESTER-ESSEX  
PROJECT NUMBER: STP 2616(I)S

FILE NAME: p06b062.dgn  
PROJECT LEADER: EPD  
DESIGNED BY: CDL  
PLOT FILE: p06b062pl08.i

PLOT DATE: 30-OCT-2012 12:0  
DRAWN BY: SJL  
CHECKED BY: EPD  
SHEET 16 OF \$SH\$

DATUM  
VERTICAL N/A  
HORIZONTAL N/A