

621.20 STEEL BEAM GUARDRAIL, GALVANIZED

STA. 11+53.00 RT - STA. 11+90.50 RT

621.60 ANCHOR FOR STEEL BEAM RAIL


STA. 11+53.00 RT

621.80 REMOVAL AND DISPOSAL OF GUARDRAIL


STA. 11+53.00 RT - STA. 11+90.50 RT

676.10 DELINEATOR WITH STEEL POST

STA. 11+53.00 RT

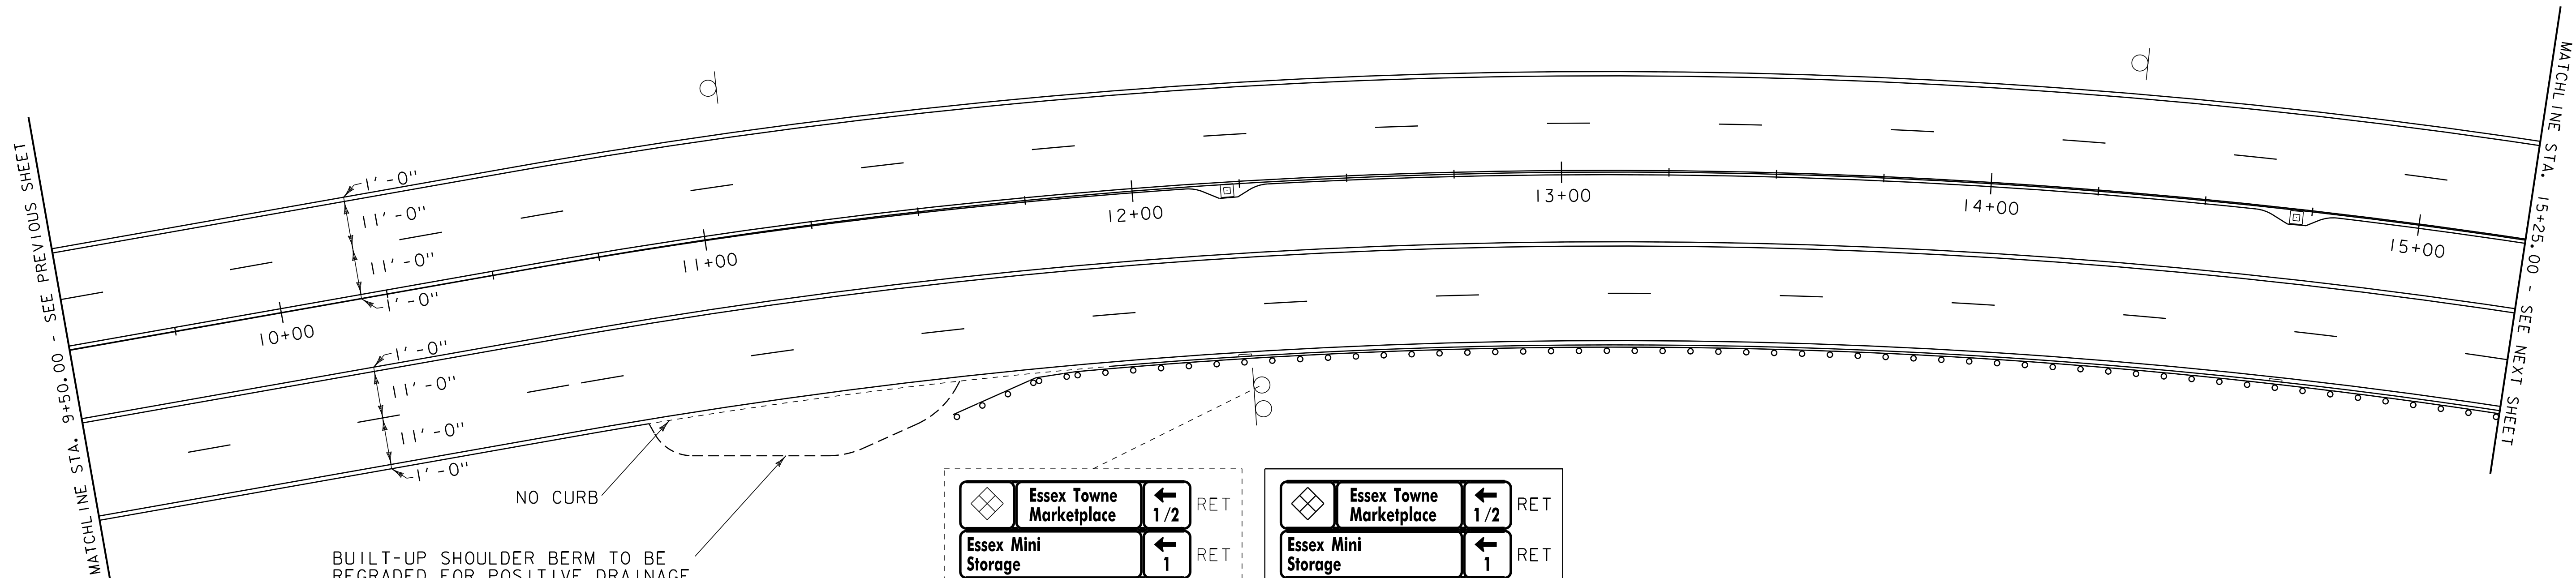

BUILT-UP SHOULDER BERM TO BE REGRADED FOR POSITIVE DRAINAGE. SEE REGRADING DETAIL ON PROJECT TYPICAL SHEET I.

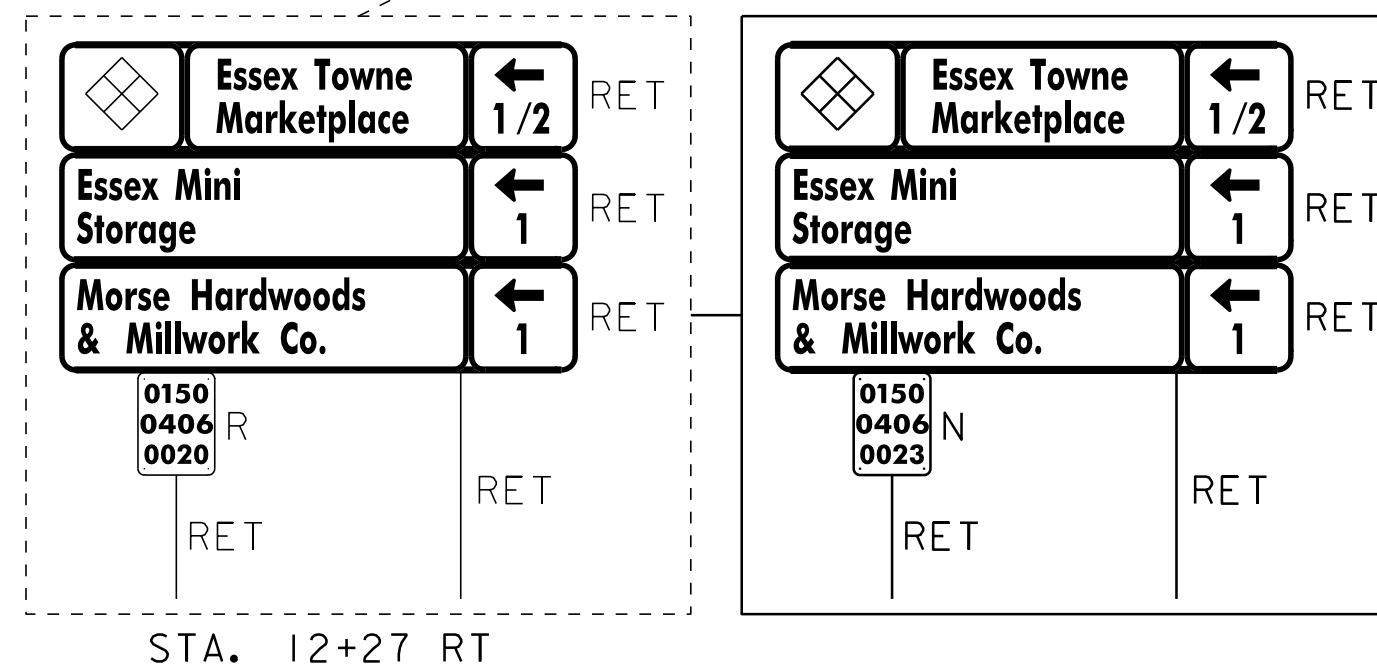

646.402 DURABLE 4" WHITE LINE, THERMOPLASTIC

STA. 9+50 - STA. 15+25 (SOLID LT & RT)
STA. 9+50 - STA. 15+25 (DASHED LT & RT)

646.602 TEMPORARY 4" WHITE LINE, PAINT

STA. 9+50 - STA. 15+25 (SOLID LT & RT)
STA. 9+50 - STA. 15+25 (DASHED LT & RT)

675.50 REMOVING SIGNS

AS SHOWN - I

646.612 TEMPORARY 4" YELLOW LINE, PAINT

STA. 9+50 - STA. 15+25 (SOLID RT BOTH EDGES OF MEDIAN)

646.412 DURABLE 4" YELLOW LINE, THERMOPLASTIC

STA. 9+50 - STA. 15+25 (SOLID RT BOTH EDGES OF MEDIAN)

604.412, 604.415, 604.418 REHAB, DROP
INLETS, CATCH BASINS, OR MANHOLES, CLASS I,
CLASS II OR CLASS III

STA. 12+22 RT "TYPE D GRATE"

STA. 12+24 RT "TYPE D GRATE"

STA. 14+71 RT "TYPE D GRATE"

~~STA. 14+71 RT~~

- LEGEND
- HYDRANT
 - MANHOLE
 - WATER VALVE
 - GAS PIPELINE MARKER
 - CATCH BASIN / DROP INLET
 - CURB INLET
 - ⊠ TRAFFIC CONTROL BOX
 - ⊕ RAILROAD CROSSING SIGNAL

SIGN LEGEND

- R = REMOVE
- R&S = REMOVE AND SALVAGE
- RET = RETAIN
- S = SALVAGE
- N = NEW
- B-B = BACK TO BACK

| | |
|------------|-----|
| DATUM | |
| VERTICAL | N/A |
| HORIZONTAL | N/A |

NOT TO SCALE

PROJECT LAYOUT SHEET 15

PROJECT NAME: COLCHESTER-ESSEX
PROJECT NUMBER: STP 2616(I)S

FILE NAME: p06b062.dgn
PROJECT LEADER: EPD
DESIGNED BY: CDL
PLOT FILE: p06b062p115.i

PLOT DATE: 30-OCT-2012 12:00
DRAWN BY: SJL
CHECKED BY: EPD
SHEET 23 OF \$SH\$