


646.492 DURABLE LETTER OR SYMBOL, THERMOPLASTIC

STA. 21+60 RT "AHEAD"	STA. 24+74 RT ARROW
STA. 21+60 RT "AHEAD"	STA. 24+74 RT ARROW
STA. 22+34 RT "ONLY"	STA. 25+54 RT "ONLY"
STA. 22+34 RT "ONLY"	STA. 25+54 RT "ONLY"
STA. 23+14 RT ARROW	STA. 26+34 RT ARROW
STA. 23+14 RT ARROW	STA. 26+34 RT ARROW
STA. 23+94 RT "ONLY"	STA. 27+14 RT "ONLY"
STA. 23+94 RT "ONLY"	STA. 27+14 RT "ONLY"




646.692 TEMPORARY LETTER OR SYMBOL, PAINT

STA. 21+60 RT "AHEAD"	STA. 24+74 RT ARROW
STA. 21+60 RT "AHEAD"	STA. 24+74 RT ARROW
STA. 22+34 RT "ONLY"	STA. 25+54 RT "ONLY"
STA. 22+34 RT "ONLY"	STA. 25+54 RT "ONLY"
STA. 23+14 RT ARROW	STA. 26+34 RT ARROW
STA. 23+14 RT ARROW	STA. 26+34 RT ARROW
STA. 23+94 RT "ONLY"	STA. 27+14 RT "ONLY"
STA. 23+94 RT "ONLY"	STA. 27+14 RT "ONLY"

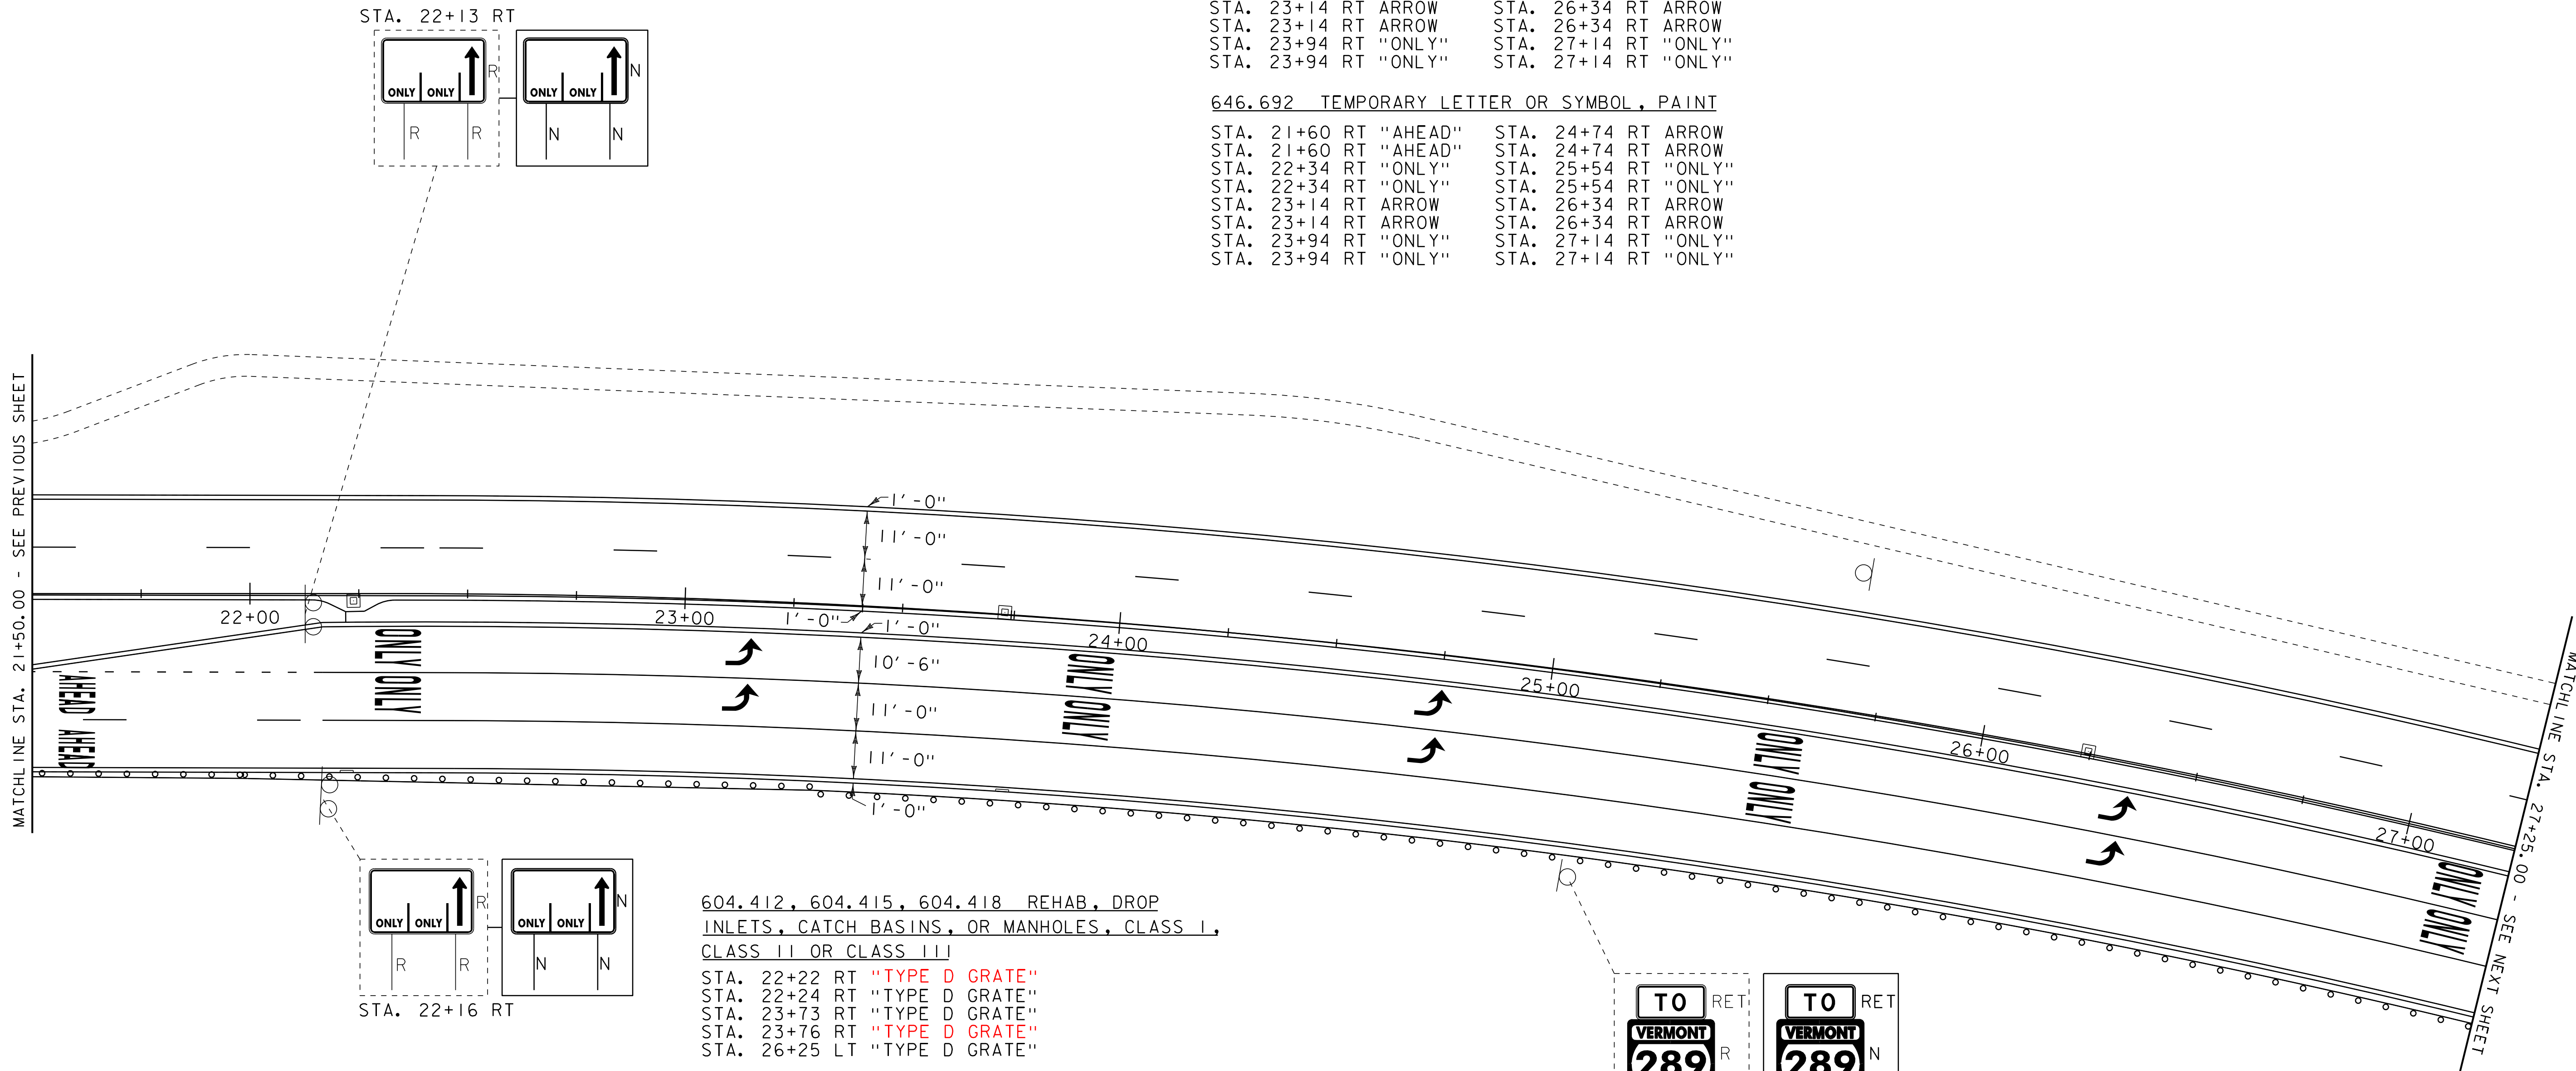

MATCHLINE STA. 21+50.00 - SEE PREVIOUS SHEET

MATCHLINE STA. 27+25.00 - SEE NEXT SHEET

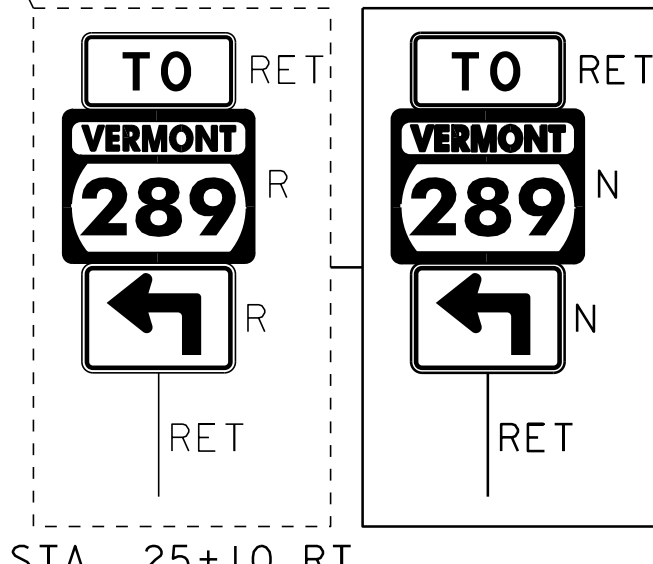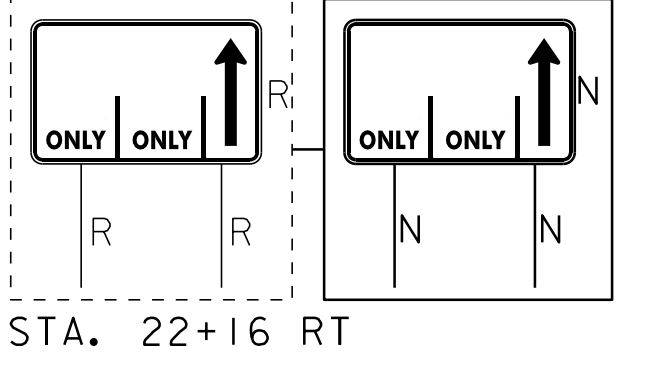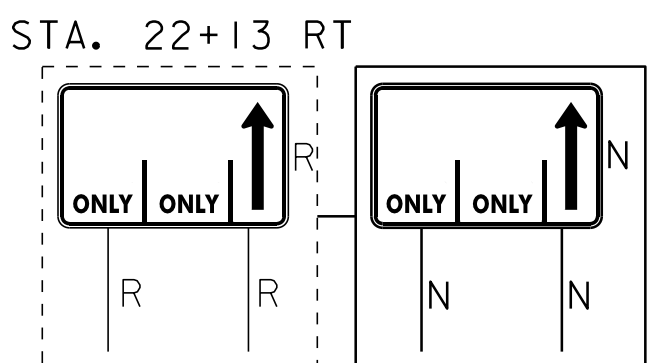

604.412, 604.415, 604.418 REHAB, DROP INLETS, CATCH BASINS, OR MANHOLES, CLASS I, CLASS II OR CLASS III

STA. 22+22 RT "TYPE D GRATE"
 STA. 22+24 RT "TYPE D GRATE"
 STA. 23+73 RT "TYPE D GRATE"
 STA. 23+76 RT "TYPE D GRATE"
 STA. 26+25 LT "TYPE D GRATE"

646.402 DURABLE 4" WHITE LINE, THERMOPLASTIC

- STA. 21+50 - STA. 27+25 (SOLID LT & RT)
- STA. 21+50 - STA. 22+17 (DASHED RT)
- STA. 21+50 - STA. 27+25 (DASHED LT)
- STA. 21+50 - STA. 22+17 (DOTTED RT)
- STA. 22+17 - STA. 27+25 (SOLID RT)
- STA. 22+17 - STA. 27+25 (SOLID RT)

646.602 TEMPORARY 4" WHITE LINE, PAINT

- STA. 21+50 - STA. 27+25 (SOLID LT & RT)
- STA. 21+50 - STA. 22+17 (DASHED RT)
- STA. 21+50 - STA. 27+25 (DASHED LT)
- STA. 21+50 - STA. 22+17 (DOTTED RT)
- STA. 22+17 - STA. 27+25 (SOLID RT)
- STA. 22+17 - STA. 27+25 (SOLID RT)

646.412 DURABLE 4" YELLOW LINE, THERMOPLASTIC

STA. 21+50 - STA. 27+25 (SOLID RT BOTH EDGES OF MEDIAN)

646.612 TEMPORARY 4" YELLOW LINE, PAINT

STA. 21+50 - STA. 27+25 (SOLID RT BOTH EDGES OF MEDIAN)

646.81 PAINTED CURB

STA. 21+50 - STA. 21+76 RT
 STA. 21+87 - STA. 22+47 RT

675.50 REMOVING SIGNS
 AS SHOWN - 4

SIGN LEGEND

- R = REMOVE
- R&S = REMOVE AND SALVAGE
- RET = RETAIN
- S = SALVAGE
- N = NEW
- B-B = BACK TO BACK

LEGEND

- ⊙ HYDRANT
- MANHOLE
- ⊙ WATER VALVE
- ⊙ GAS PIPELINE MARKER
- ⊠ CATCH BASIN / DROP INLET
- CURB INLET
- ⊠ TRAFFIC CONTROL BOX
- ⊕ RAILROAD CROSSING SIGNAL

DATUM

VERTICAL	N/A
HORIZONTAL	N/A

NOT TO SCALE

PROJECT LAYOUT SHEET 17

PROJECT NAME: COLCHESTER-ESSEX	PLOT DATE: 30-OCT-2012 12:0
PROJECT NUMBER: STP 2616(I)S	DRAWN BY: SJL
FILE NAME: p06b062.dgn	CHECKED BY: EPD
PROJECT LEADER: EPD	SHEET 25 OF \$SH\$
DESIGNED BY: CDL	
PLOT FILE: p06b062pl17.i	