

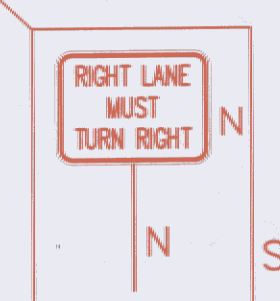



START OF PROPOSED MODIFICATIONS
REQUESTED BY THE VILLAGE OF
ESSEX JUNCTION
STA. 50+30

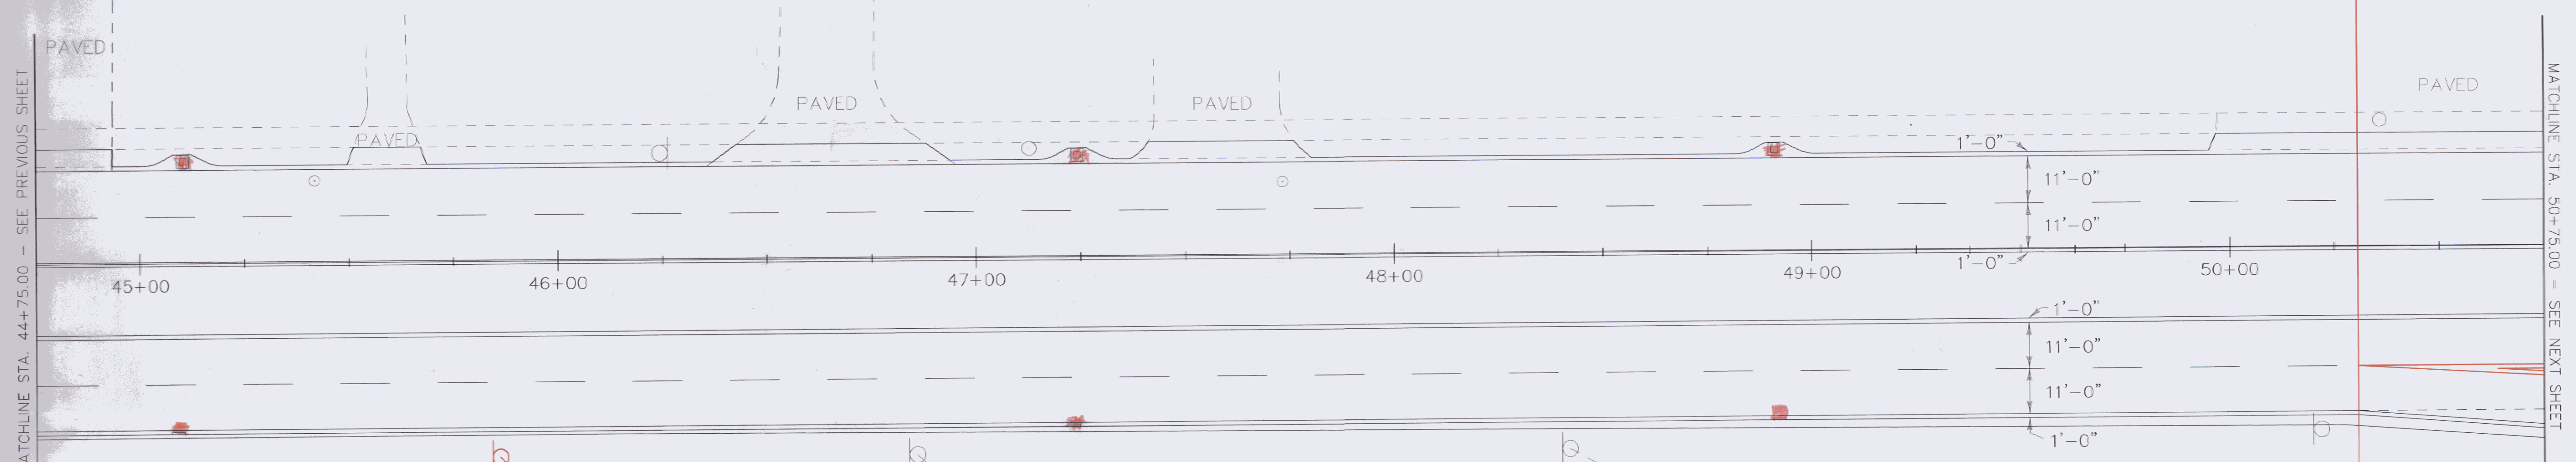

STA. 45+86 RT

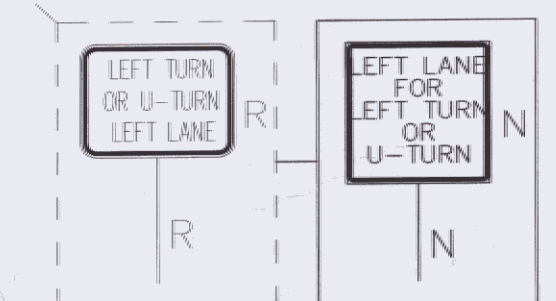

STA. 46+86 RT

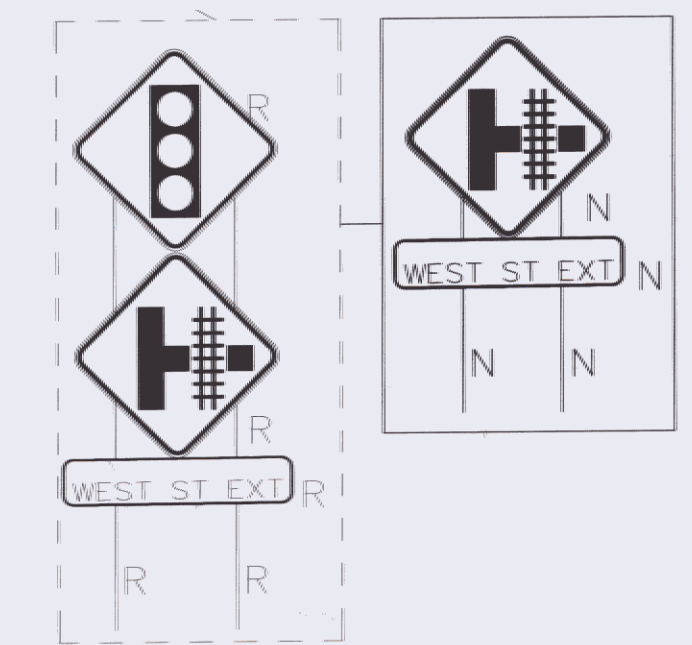

STA. 48+42 RT

NOTE:

1.) ALL VALVE BOX ADJUSTMENTS TO BE DONE BY OTHERS.

~~646.402 DURABLE 4" WHITE LINE, THERMOPLASTIC~~

~~STA. 44+75 - STA. 50+75 (SOLID LT & RT)
STA. 44+75 - STA. 50+75 (DASHED LT & RT)
STA. 50+31 - STA. 50+75 (DOTTED RT)~~

~~646.602 TEMPORARY 4" WHITE LINE, PAINT~~

~~STA. 44+75 - STA. 50+75 (SOLID LT & RT)
STA. 44+75 - STA. 50+75 (DASHED LT & RT)
STA. 50+31 - STA. 50+75 (DOTTED RT)~~

646.81 PAINTED CURB

STA. 50+01 - STA. 50+61 RT

~~646.402 DURABLE 4" WHITE LINE, THERMOPLASTIC~~

STA. 44+75 - STA. 50+75 (SOLID LT & RT)
STA. 44+75 - STA. 50+75 (DASHED LT)
STA. 44+75 - STA. 50+31 (DASHED RT)
STA. 50+31 - STA. 50+75 (SOLID RT) (APPROACH TAPER)

646.412 DURABLE 4" YELLOW LINE, THERMOPLASTIC

STA. 44+75 - STA. 50+75 (SOLID RT)
(BOTH EDGELINES OF MEDIAN)

646.612 TEMPORARY 4" YELLOW LINE, PAINT

STA. 44+75 - STA. 50+75 (SOLID RT)
(BOTH EDGELINES OF MEDIAN)

604.412, 604.415, 604.418 REHAB. DROP
INLETS, CATCH BASINS, OR MANHOLES, CLASS 1,
CLASS II OR CLASS III

STA. 45+09 RT, TYPE D GRATE
STA. 45+10 LT, TYPE D GRATE
STA. 47+23 RT, TYPE D GRATE
STA. 47+24 LT, TYPE D GRATE
STA. 48+91 LT, TYPE D GRATE
STA. 48+92 RT, TYPE D GRATE

646.602 TEMPORARY 4" WHITE LINE, PAINT

STA. 44+75 - STA. 50+75 (SOLID LT & RT)
STA. 44+75 - STA. 50+75 (DASHED LT)
STA. 44+75 - STA. 50+31 (DASHED RT)
STA. 50+31 - STA. 50+75 (SOLID RT) (APPROACH TAPER)

LEGEND

- HYDRANT
- MANHOLE
- WATER VALVE
- GAS PIPELINE MARKER
- CATCH BASIN / DROP INLET
- CURB INLET
- TRAFFIC CONTROL BOX
- RAILROAD CROSSING SIGNAL

SIGN LEGEND

- R = REMOVE
- R&S = REMOVE AND SALVAGE
- RET = RETAIN
- S = SALVAGE
- N = NEW
- B-B = BACK TO BACK

675.50 REMOVING SIGNS
AS SHOWN - 4

NOT TO SCALE

DATUM	
VERTICAL	N/A
HORIZONTAL	N/A

PROJECT
LAYOUT
SHEET 21

PROJECT NAME: COLCHESTER-ESSEX
PROJECT NUMBER: STP 2616(1)

FILE NAME: p06b062.dgn
PROJECT LEADER: EPD
DESIGNED BY: CDL
PLOT FILE: p06b062pl21.i

PLOT DATE: \$\$\$DATE\$\$\$
DRAWN BY: SJL
CHECKED BY: EPD
SHEET 29 OF 45

-04/13/09
-07/24/09
-07/31/09
08/01/09