

616.20 GRANITE SLOPE EDGING
 STA. 51+81 - STA. 53+04 RT (ISLAND)

NOTE:
 1.) ALL SEWER MAN HOLE AND VALVE BOX ADJUSTMENTS TO BE DONE BY OTHERS UNLESS OTHERWISE NOTED IN THE PLANS.

646.26 24" STOP BAR
646.482 DURABLE 24" STOP BAR, THERMOPLASTIC
 STA. 53+00 RT
 STA. 53+63 - STA. 53+73 LT
 STA. 54+50 LT
 STA. 54+92 LT - STA. 55+12 LT

646.682 TEMPORARY 24" STOP BAR, PAINT
 STA. 53+00 RT
 STA. 53+63 - STA. 53+73 LT
 STA. 54+50 LT
 STA. 54+92 LT - STA. 55+12 LT

646.30 LETTER OR SYMBOL
646.492 DURABLE LETTER OR SYMBOL, THERMOPLASTIC

STA. 51+90 RT ARROW
 STA. 52+41 RT "ONLY"
 STA. 52+52 RT ARROW
 STA. 54+54 RT BIKE
 STA. 54+66 RT ARROW

646.692 TEMPORARY LETTER OR SYMBOL, PAINT

STA. 51+90 RT ARROW
 STA. 52+41 RT "ONLY"
 STA. 52+52 RT ARROW
 STA. 54+54 RT BIKE
 STA. 54+66 RT ARROW

616.40 REMOVING AND RESETTING CURB
 STA. 55+75 - STA. 56+50 NORTH SIDE OF MEDIAN
 STA. 54+22 - STA. 55+14 RT
 STA. 55+89 - STA. 56+75 RT
 STA. 55+82 - STA. 56+75 RT
 STA. 56+39 - STA. 56+75 RT

646.81 PAINTED CURB
 STA. 51+01 - STA. 51+61 RT
 STA. 51+51 - STA. 52+11 RT
 STA. 52+11 - STA. 52+71 RT
 STA. 52+74 - STA. 53+04 RT (BOTH EDGES OF MEDIAN)
 STA. 54+42 - STA. 54+72 RT (BOTH EDGES OF MEDIAN)

646.82 PAINTED ISLAND
 STA. 52+80 - STA. 53+05 RT
 STA. 51+81 - STA. 53+04 RT

675.50 REMOVING SIGNS
 AS SHOWN - X6

678.22 VEHICLE LOOP DETECTOR
 STA. 53+64 - STA. 53+70 LT (150 LF)

616.47 BITUMINOUS CONCRETE GUTTERS AND TRAFFIC ISLANDS
 STA. 55+47 - STA. 55+79 LT


STREET	LANE	STATION	SIZE	TYPE	# OF TURNS	MODE
JUGHANDLE	-	53+64 - 53+70 LT	6' X 29"	QUAD	2	PRES.

203.16 SOLID ROCK EXCAVATION
 STA. 53+51 - STA. 53+62 LT
 STA. 53+95 - STA. 54+05 LT
 STA. 54+17 - STA. 54+23 RT
 STA. 54+20 - STA. 54+25 LT
 STA. 54+77 - STA. 54+87 LT
 STA. 55+05 - STA. 55+18 LT
 STA. 55+81 - STA. 55+92 LT
 STA. 56+27 - STA. 56+42 LT

618.10 PORTLAND CEMENT CONCRETE SIDEWALK, 5 INCH
 STA. 53+51 - STA. 53+62 LT
 STA. 53+95 - STA. 54+05 LT
 STA. 54+17 - STA. 54+23 RT
 STA. 54+20 - STA. 54+25 LT
 STA. 54+77 - STA. 54+87 LT
 STA. 55+05 - STA. 55+18 LT
 STA. 55+81 - STA. 55+92 LT
 STA. 56+27 - STA. 56+42 LT

646.452 DURABLE 8" YELLOW LINE, THERMOPLASTIC
 STA. 54+27 - STA. 54+44 (HATCHED RT)

646.652 TEMPORARY 8" YELLOW LINE, PAINT
 STA. 54+27 - STA. 54+44 (HATCHED RT)

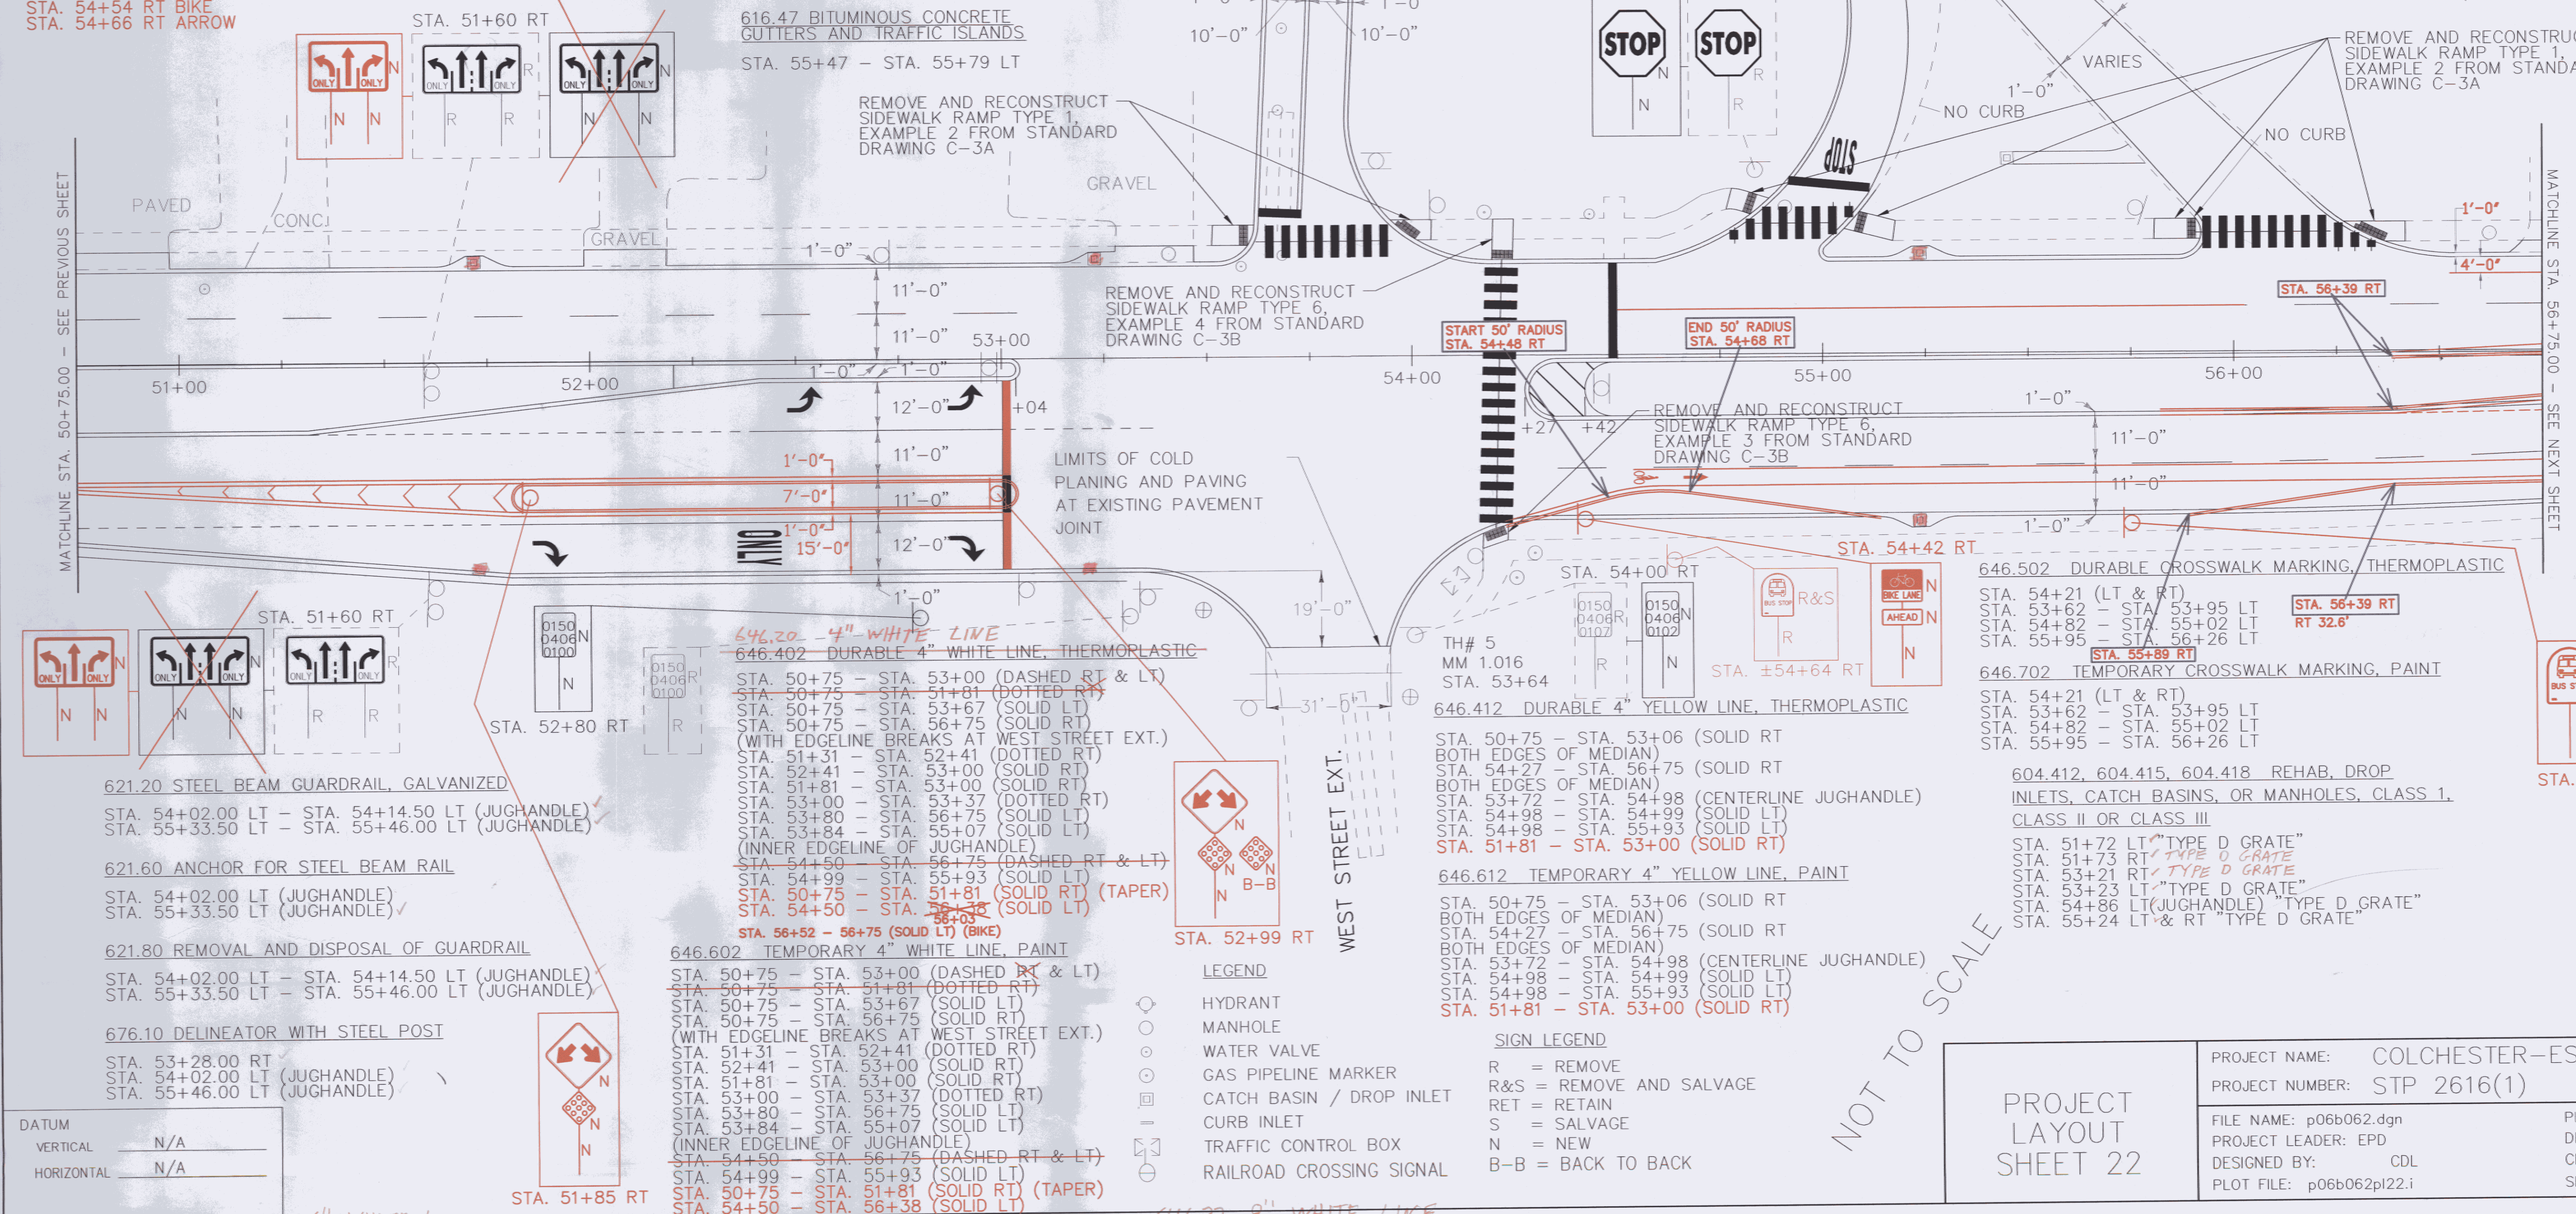

DATUM

VERTICAL	N/A
HORIZONTAL	N/A

- LEGEND**
- HYDRANT
 - MANHOLE
 - WATER VALVE
 - GAS PIPELINE MARKER
 - CATCH BASIN / DROP INLET
 - CURB INLET
 - TRAFFIC CONTROL BOX
 - RAILROAD CROSSING SIGNAL
- SIGN LEGEND**
- R = REMOVE
 - R&S = REMOVE AND SALVAGE
 - RET = RETAIN
 - S = SALVAGE
 - N = NEW
 - B-B = BACK TO BACK

NOT TO SCALE

PROJECT NAME: COLCHESTER-ESSEX	
PROJECT NUMBER: STP 2616(1)	
FILE NAME: p06b062.dgn	PLOT DATE: \$\$\$DATE\$\$\$
PROJECT LEADER: EPD	DRAWN BY: SJL
DESIGNED BY: CDL	CHECKED BY: EPD
PLOT FILE: p06b062p122.i	SHEET 30 OF 45

646.214 6" WHITE LINE
646.422 DURABLE 6" WHITE LINE, THERMOPLASTIC
 STA. 54+50 - STA. 56+75 (SOLID RT) (BIKE)

646.622 TEMPORARY 6" WHITE LINE, PAINT
 STA. 54+50 - STA. 56+75 (SOLID RT) (BIKE)

646.221 8" WHITE LINE
646.442 DURABLE 8" WHITE LINE, THERMOPLASTIC
 STA. 51+00 - STA. 51+81 (HATCHED RT)

646.642 TEMPORARY 8" WHITE LINE, PAINT
 STA. 51+00 - STA. 51+81 (HATCHED RT)

-04/13/09
 -07/24/09
 -07/31/09
 08/01/09