

616.20 GRANITE SLOPE EDGING
STA. 57+78 - STA. 58+41 LT (ISLAND)

616.40 REMOVING AND RESETTING CURB
STA. 56+75 - STA. 57+78 RT (ISLAND)
STA. 56+75 - STA. 58+03 RT
58+03

675.50 REMOVING SIGNS

AS SHOWN - X 9

646.31

~~646.502 DURABLE CROSSWALK MARKING, THERMOPLASTIC~~

STA. 58+36 LT - 58+80 LT

646.702 TEMPORARY CROSSWALK MARKING, PAINT

STA. 58+36 LT - 58+80 LT

646.26

~~646.482 DURABLE 24" STOP BAR, THERMOPLASTIC~~

STA. 58+41 - STA. 58+59 LT

646.682 TEMPORARY 24" STOP BAR, PAINT

STA. 58+41 - STA. 58+59 LT

646.81 PAINTED CURB


~~STA. 57+48 - STA. 57+78 RT~~

~~(BOTH EDGES OF MEDIAN)~~

STA. 58+10 - STA. 58+40 LT

646.82 PAINTED ISLAND

STA. 57+89 - STA. 58+40 RT

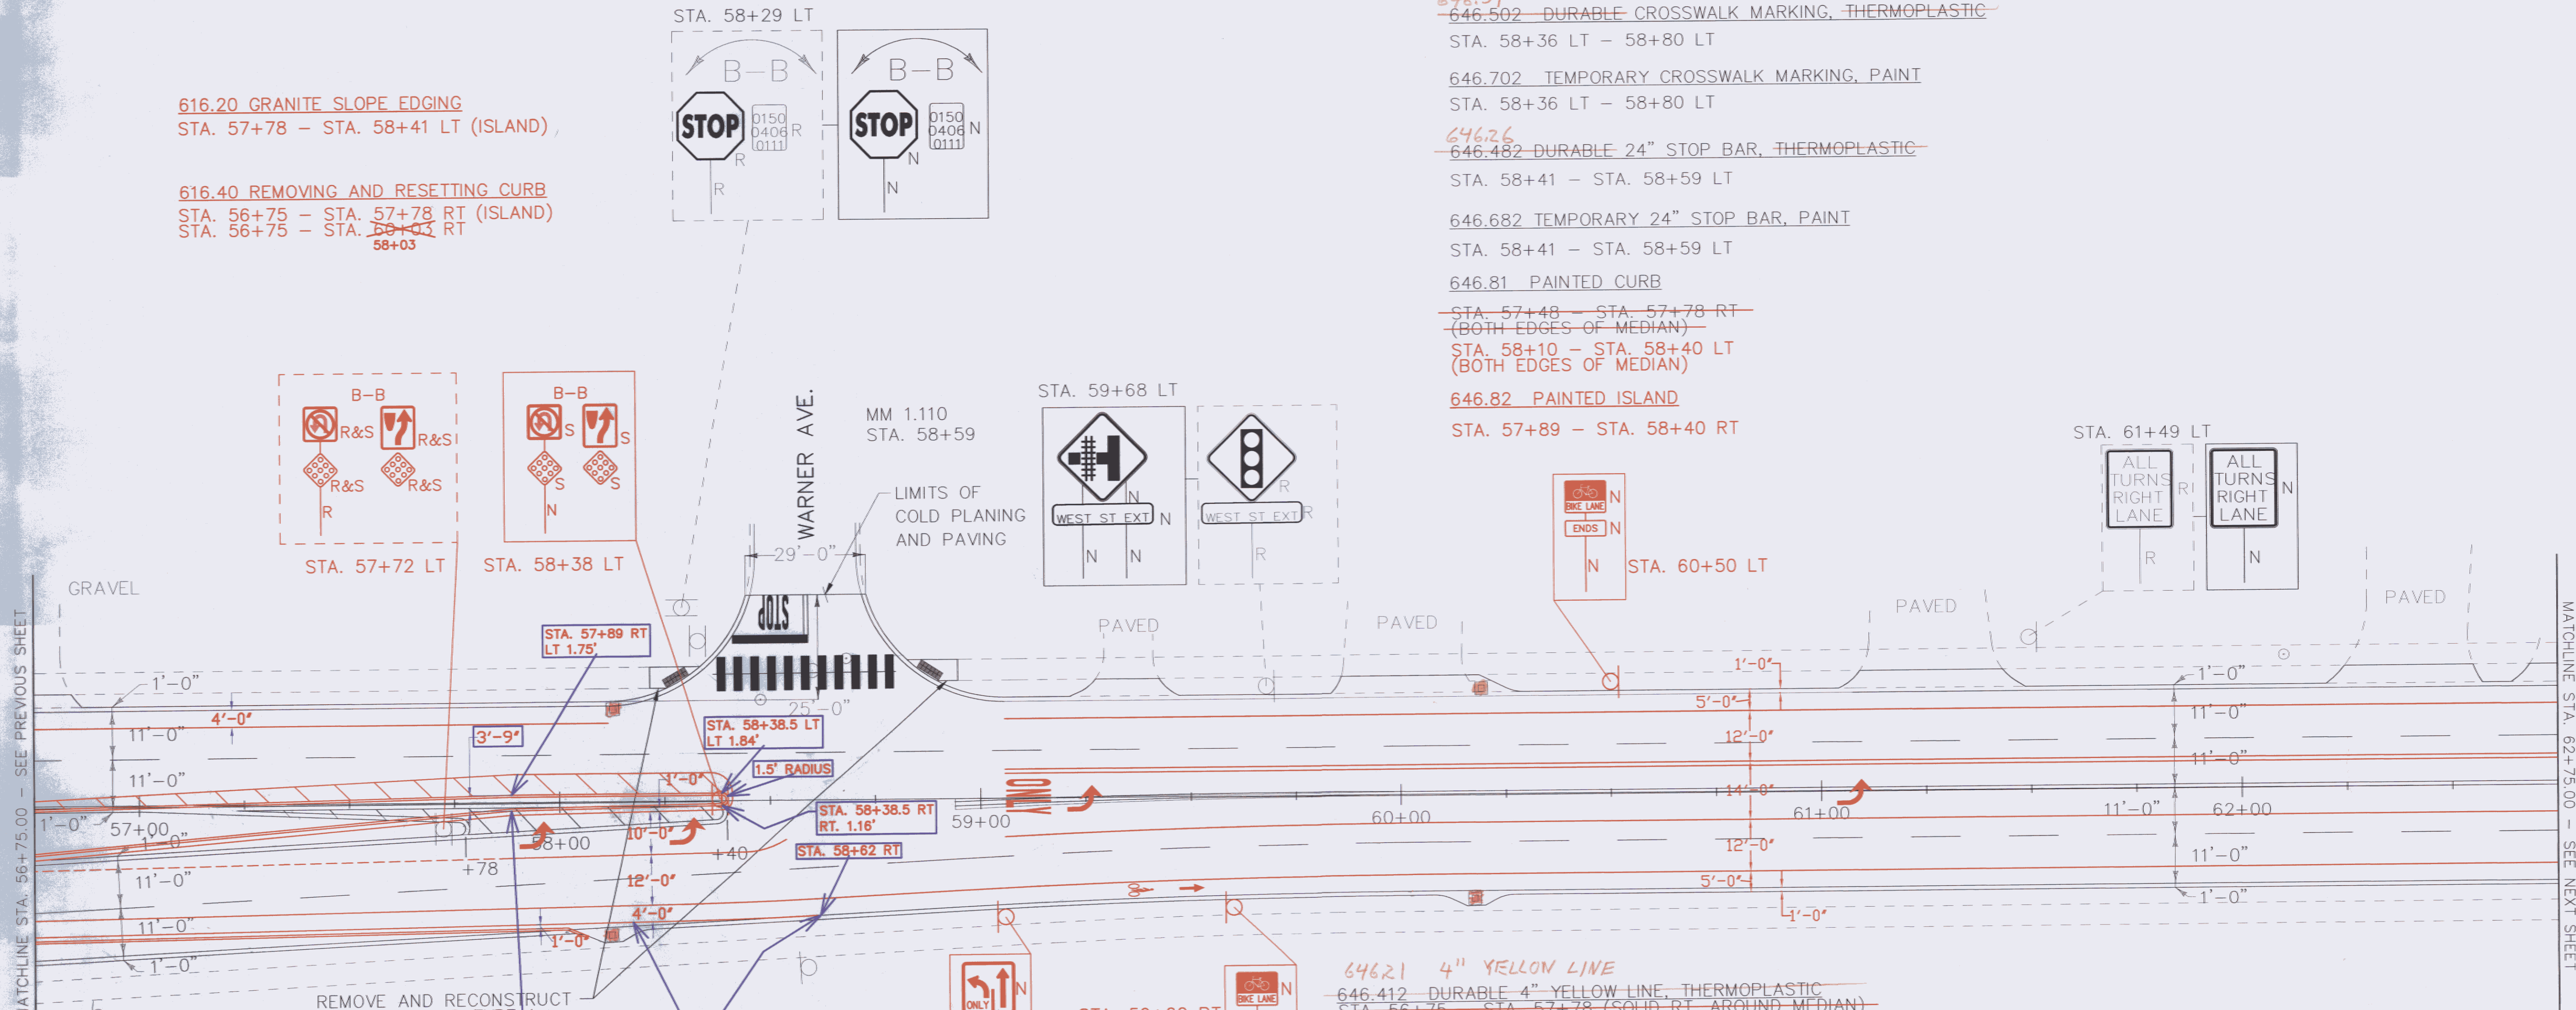

203.16 SOLID ROCK EXCAVATION

STA. 58+22 - STA. 58+33 LT
STA. 58+83 - STA. 58+95 LT

618.10 PORTLAND CEMENT
CONCRETE SIDEWALK, 5 INCH

STA. 58+22 - STA. 58+33 LT
STA. 58+83 - STA. 58+95 LT

618.30 DETECTABLE WARNING SURFACE

STA. 58+25 LT
STA. 58+91 LT

646.20 4" WHITE LINE

~~646.402 DURABLE 4" WHITE LINE, THERMOPLASTIC~~

STA. 56+75 - STA. 62+75 (SOLID LT & RT)
(WITH EDGELINE BREAKS AT WARNER AVE.)
STA. 56+75 - STA. 57+90 (DOTTED RT)
STA. 57+90 - STA. 58+59 (SOLID RT)
STA. 56+75 - STA. 57+87 (DOTTED LT)
STA. 59+06 - STA. 62+75 (SOLID RT)
STA. 56+75 - STA. 62+75 (SOLID LT) (BIKE)

646.602 TEMPORARY 4" WHITE LINE, PAINT

STA. 56+75 - STA. 62+75 (SOLID LT & RT)
(WITH EDGELINE BREAKS AT WARNER AVE.)
STA. 56+75 - STA. 57+90 (DOTTED RT)
STA. 57+90 - STA. 58+59 (SOLID RT)
STA. 56+75 - STA. 57+87 (DOTTED LT)
STA. 59+06 - STA. 62+75 (SOLID RT)

646.214 6" WHITE LINE

~~646.422 DURABLE 6" WHITE LINE, THERMOPLASTIC~~

STA. 56+75 - STA. 62+75 (SOLID RT) (BIKE)
STA. 59+06 - STA. 62+75 (SOLID LT) (BIKE)

646.23 8" YELLOW LINE

~~646.452 DURABLE 8" YELLOW LINE, THERMOPLASTIC~~

~~STA. 57+26 - STA. 58+40 (HATCHED RT)~~

~~STA. 56+75 - STA. 58+12 (HATCHED LT)~~

~~646.652 TEMPORARY 8" YELLOW LINE, PAINT~~

~~STA. 57+26 - STA. 58+40 (HATCHED RT)~~

~~646.402 DURABLE 4" WHITE LINE, THERMOPLASTIC~~

~~STA. 56+75 - STA. 62+75 (SOLID LT & RT)~~

~~(WITH EDGELINE BREAKS AT WARNER AVE.)~~

~~STA. 56+75 - STA. 62+75 (DASHED LT & RT)~~

~~646.602 TEMPORARY 4" WHITE LINE, PAINT~~

~~STA. 56+75 - STA. 62+75 (SOLID LT & RT)~~

~~(WITH EDGELINE BREAKS AT WARNER AVE.)~~

~~STA. 56+75 - STA. 62+75 (DASHED LT & RT)~~

~~646.30 LETTER OR SYMBOL~~

~~646.492 DURABLE LETTER OR SYMBOL, THERMOPLASTIC~~

~~STA. 58+51 LT "STOP" STA. 59+38 RT BIKE~~

~~STA. 57+90 RT ARROW STA. 59+50 RT ARROW~~

~~STA. 58+26 RT ARROW STA. 59+21 CTR ARROW~~

~~STA. 59+06 CTR "ONLY" STA. 61+03 CTR ARROW~~

~~646.692 TEMPORARY LETTER OR SYMBOL, PAINT~~

~~STA. 58+51 LT "STOP" STA. 59+38 RT BIKE~~

~~STA. 57+90 RT ARROW STA. 59+50 RT ARROW~~

~~STA. 58+26 RT ARROW STA. 59+21 CTR ARROW~~

~~STA. 59+06 CTR "ONLY" STA. 61+03 CTR ARROW~~

646.662 TEMPORARY 6" WHITE LINE, PAINT

STA. 56+75 - STA. 62+75 (SOLID RT) (BIKE)

STA. 59+06 - STA. 62+75 (SOLID LT) (BIKE)

646.21 4" YELLOW LINE

~~646.412 DURABLE 4" YELLOW LINE, THERMOPLASTIC~~

~~STA. 56+75 - STA. 57+78 (SOLID RT, AROUND MEDIAN)~~

~~STA. 57+23 - STA. 58+40 (SOLID RT, CENTERLINE)~~

~~STA. 57+78 - STA. 58+40 (SOLID RT, CENTERLINE)~~

~~STA. 58+59 LT (CENTERLINE WARNER AVE.)~~

~~STA. 58+94 - STA. 62+75 (SOLID LT & RT, CENTERLINE)~~

~~STA. 56+75 - STA. 58+40 (SOLID LT & RT, AROUND MEDIAN)~~

~~STA. 59+06 - STA. 62+75 (LT, CENTERLINE)~~

~~646.612 TEMPORARY 4" YELLOW LINE, PAINT~~

~~STA. 56+75 - STA. 57+78 (SOLID RT, AROUND MEDIAN)~~

~~STA. 57+23 - STA. 58+40 (SOLID RT, CENTERLINE)~~

~~STA. 57+78 - STA. 58+40 (SOLID RT, CENTERLINE)~~

~~STA. 58+59 LT (CENTERLINE WARNER AVE.)~~

~~STA. 58+94 - STA. 62+75 (SOLID LT & RT, CENTERLINE)~~

~~STA. 56+75 - STA. 58+40 (SOLID LT & RT, AROUND MEDIAN)~~

~~STA. 59+06 - STA. 62+75 (LT, CENTERLINE)~~

~~604.412, 604.415, 604.418 REHAB. DROP~~

~~INLETS, CATCH BASINS, OR MANHOLES, CLASS 1,~~

~~CLASS II OR CLASS III~~

~~STA. 58+12 RT "TYPE D GRATE"~~

~~STA. 58+13 LT "TYPE D GRATE"~~

~~STA. 60+17 RT "TYPE D GRATE"~~

~~STA. 60+19 LT "TYPE D GRATE"~~

~~XXX.XXX REMOVE EXISTING CATCH BASIN~~

~~STA. 58+12 RT~~

~~XXX.XXX NEW CATCH BASIN~~

~~STA. 58+12 RT~~

NOTE:

1.) ALL SEWER MANHOLE AND VALVE BOX ADJUSTMENTS TO BE DONE BY OTHERS
UNLESS OTHERWISE NOTED IN THE PLANS.

LEGEND

- HYDRANT
- MANHOLE
- WATER VALVE
- GAS PIPELINE MARKER
- CATCH BASIN / DROP INLET
- CURB INLET
- ⊠ TRAFFIC CONTROL BOX
- ⊕ RAILROAD CROSSING SIGNAL

SIGN LEGEND

- R = REMOVE
- R&S = REMOVE AND SALVAGE
- RET = RETAIN
- S = SALVAGE
- N = NEW
- B-B = BACK TO BACK

NOT TO SCALE

DATUM	N/A
VERTICAL	N/A
HORIZONTAL	N/A

PROJECT
LAYOUT
SHEET 23

PROJECT NAME: COLCHESTER-ESSEX

PROJECT NUMBER: STP 2616(1)

FILE NAME: p06b062.dgn

PROJECT LEADER: EPD

DESIGNED BY: CDL

PLOT FILE: p06b062p23.i

PLOT DATE: \$\$\$DATE\$\$\$

DRAWN BY: SJL

CHECKED BY: EPD

SHEET 31 OF 45

04/13/09

07/24/09

07/31/09

08/01/09