

203.16 SOLID ROCK EXCAVATION
 STA. 71+42 - STA. 71+52 LT
 STA. 71+84 - STA. 71+93 LT

604.412, 604.415, 604.418 REHAB. DROP
 INLETS, CATCH BASINS, OR MANHOLES, CLASS 1,
 CLASS II OR CLASS III

STA. 70+16 LT TYPE D GRATE"
 STA. 70+17 RT TYPE D GRATE"
 STA. 72+17 RT TYPE D GRATE"
 STA. 72+26 LT TYPE D GRATE"
 STA. 74+13 LT TYPE D GRATE"
 STA. 74+24 RT TYPE D GRATE"

618.10 PORTLAND CEMENT
 CONCRETE SIDEWALK, 5 INCH
 STA. 71+42 - STA. 71+52 LT
 STA. 71+84 - STA. 71+93 LT

618.30 DETECTABLE WARNING SURFACE
 STA. 71+48 LT
 STA. 71+88 LT


646.30
~~646.492 DURABLE LETTER OR SYMBOL, THERMOPLASTIC~~

STA. 69+07 CTR ARROW
 STA. 69+27 CTR ARROW
 STA. 70+48 LT ARROW
 STA. 70+60 LT BIKE
 STA. 71+07 CTR ARROW
 STA. 71+27 CTR ARROW
 STA. 72+16 CTR ARROW
 STA. 72+36 CTR ARROW
 STA. 72+45 RT BIKE
 STA. 72+57 RT ARROW
 STA. 74+06 CTR ARROW
 STA. 74+26 CTR ARROW

646.692 TEMPORARY LETTER OR SYMBOL, PAINT

STA. 69+07 CTR ARROW
 STA. 69+27 CTR ARROW
 STA. 70+48 LT ARROW
 STA. 70+60 LT BIKE
 STA. 71+07 CTR ARROW
 STA. 71+27 CTR ARROW
 STA. 72+16 CTR ARROW
 STA. 72+36 CTR ARROW
 STA. 72+45 RT BIKE
 STA. 72+57 RT ARROW
 STA. 74+06 CTR ARROW
 STA. 74+26 CTR ARROW

616.21 VERTICAL GRANITE CURB
 STA. 72+95 - STA. 73+25 RT

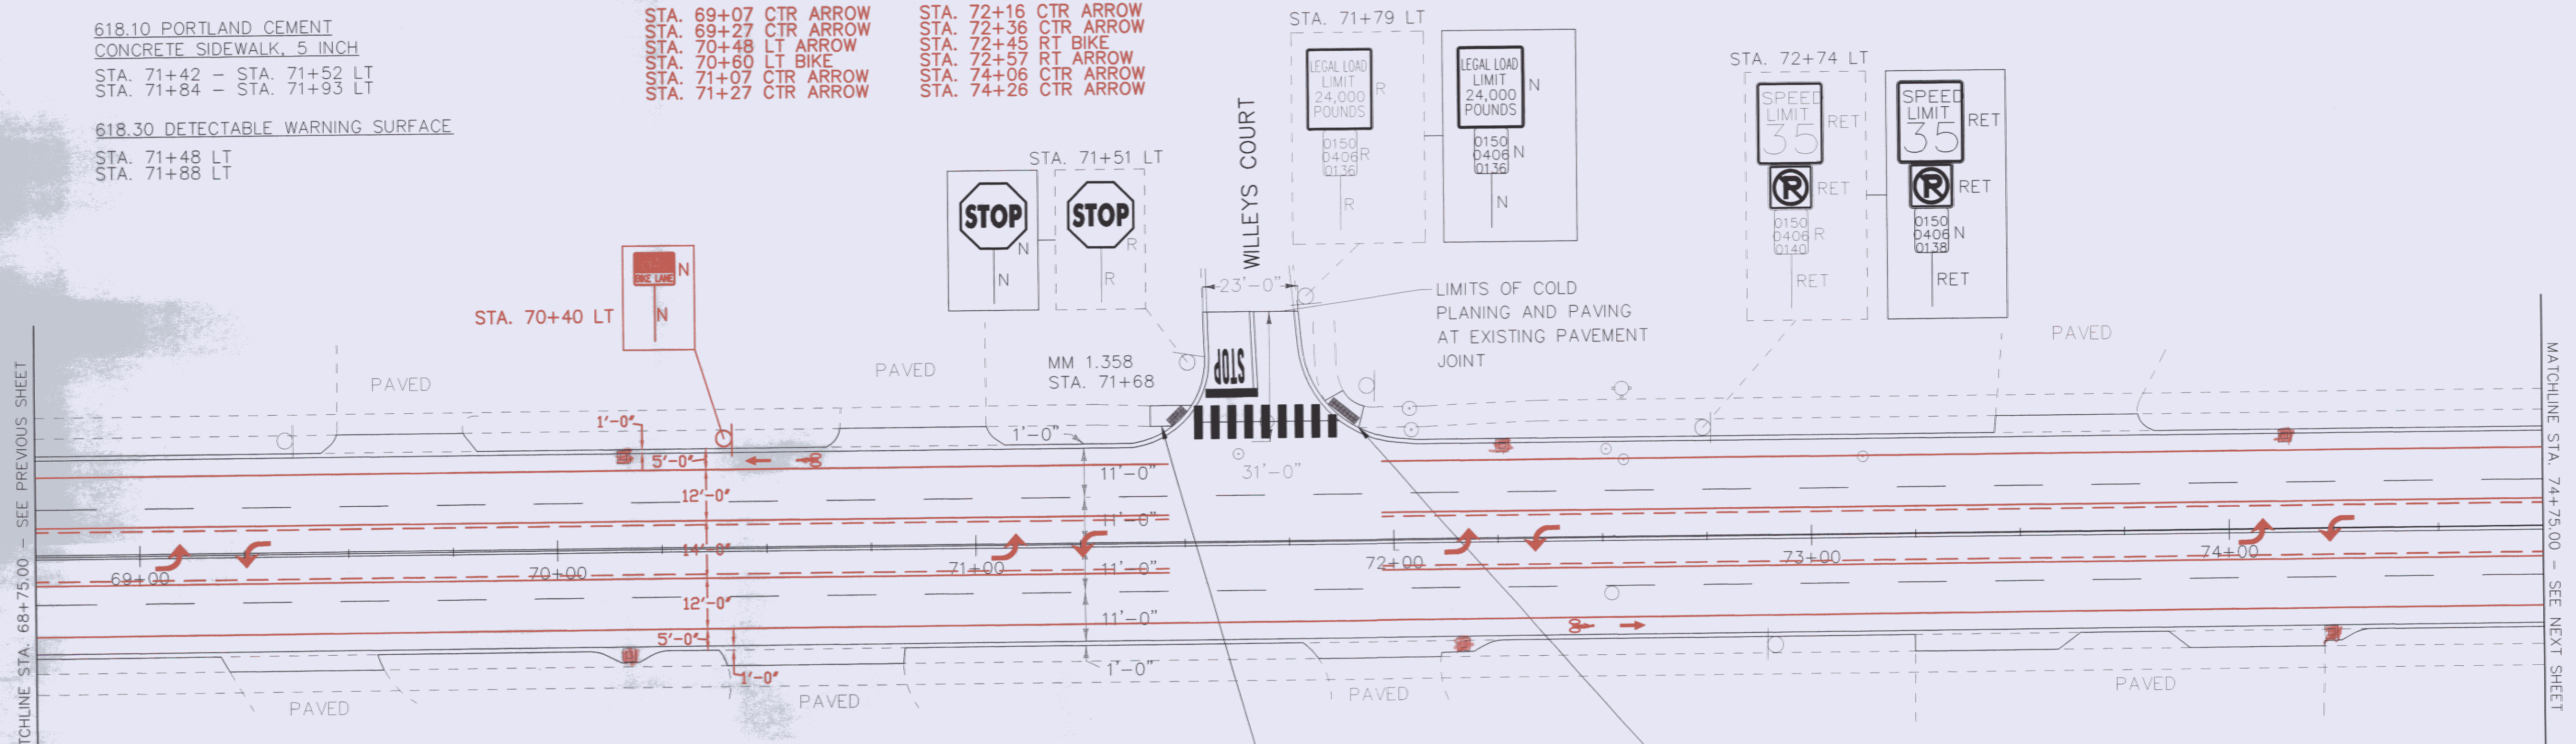

646.20
~~646.402 DURABLE 4" WHITE LINE, THERMOPLASTIC~~

STA. 68+75 - STA. 74+75 (SOLID LT & RT) 1200
 (WITH EDGELINE BREAKS AT WILLEYS COURT)
~~STA. 68+75 - STA. 74+75 (DASHED LT & RT)~~

646.602 TEMPORARY 4" WHITE LINE, PAINT

STA. 68+75 - STA. 74+75 (SOLID LT & RT)
 (WITH EDGELINE BREAKS AT WILLEYS COURT)
~~STA. 68+75 - STA. 74+75 (DASHED LT & RT)~~

646.21
~~646.412 DURABLE 4" YELLOW LINE, THERMOPLASTIC~~

STA. 68+75 - STA. 74+75 (SOLID LT & RT, CENTERLINE)
 STA. 71+68 LT (CENTERLINE, WILLEYS COURT) 40
 STA. 68+75 - STA. 71+46 (SOLID LT & RT) 542
 STA. 68+75 - STA. 71+46 (DASHED LT & RT) 140
 STA. 71+97 - STA. 74+75 (SOLID LT & RT) 550
 STA. 71+97 - STA. 74+75 (DASHED LT & RT) 140

646.612 TEMPORARY 4" YELLOW LINE, PAINT

STA. 68+75 - STA. 74+75 (SOLID LT & RT, CENTERLINE)
 STA. 71+68 LT (CENTERLINE, WILLEYS COURT)
 STA. 68+75 - STA. 71+46 (SOLID LT & RT)
 STA. 68+75 - STA. 71+46 (DASHED LT & RT)
 STA. 71+97 - STA. 74+75 (SOLID LT & RT)
 STA. 71+97 - STA. 74+75 (DASHED LT & RT)

646.26
~~646.482 DURABLE 24" STOP BAR, THERMOPLASTIC~~

STA. 71+55 - STA. 71+68 LT 12

646.214
~~646.422 DURABLE 6" WHITE LINE, THERMOPLASTIC~~

STA. 68+75 - STA. 74+75 (SOLID LT & RT) (BIKE) 1200
 (WITH EDGELINE BREAKS AT WILLEYS COURT)

646.682 TEMPORARY 24" STOP BAR, PAINT

STA. 71+55 - STA. 71+68 LT

646.30
~~646.492 DURABLE LETTER OR SYMBOL, THERMOPLASTIC~~

646.692 TEMPORARY LETTER OR SYMBOL, PAINT
 STA. 71+61 LT "STOP"

646.31
~~646.502 DURABLE CROSSWALK MARKING, THERMOPLASTIC~~

646.702 TEMPORARY CROSSWALK MARKING, PAINT
 STA. 71+51 LT - 71+85 LT

675.50 REMOVING SIGNS
 AS SHOWN - 4

646.622 TEMPORARY 6" WHITE LINE, PAINT

STA. 68+75 - STA. 74+75 (SOLID LT & RT) (BIKE)
 (WITH EDGELINE BREAKS AT WILLEYS COURT)

NOTE:
 REVISIONS IN RED REPRESENT
 PROPOSED MODIFICATIONS REQUESTED
 BY THE VILLAGE OF ESSEX JUNCTION

- LEGEND
- HYDRANT
 - MANHOLE
 - WATER VALVE
 - GAS PIPELINE MARKER
 - CATCH BASIN / DROP INLET
 - CURB INLET
 - TRAFFIC CONTROL BOX
 - ⊕ RAILROAD CROSSING SIGNAL
- SIGN LEGEND
- R = REMOVE
 - R&S = REMOVE AND SALVAGE
 - RET = RETAIN
 - S = SALVAGE
 - N = NEW
 - B-B = BACK TO BACK

DATUM	
VERTICAL	N/A
HORIZONTAL	N/A

PROJECT LAYOUT SHEET 25	PROJECT NAME: COLCHESTER-ESSEX	PLOT DATE: \$\$\$DATE\$\$\$
	PROJECT NUMBER: STP 2616(1)	DRAWN BY: S.JL
	FILE NAME: p06b062.dgn	CHECKED BY: EPD
	PROJECT LEADER: EPD	SHEET 33 OF 45
	DESIGNED BY: CDL	
	PLOT FILE: p06b062pl25.i	

NOT TO SCALE