

604.412, 604.415, 604.418 REHAB, DROP
INLETS, CATCH BASINS, OR MANHOLES, CLASS I,
CLASS II OR CLASS III

STA. 76+28 LT "TYPE D GRATE"
STA. 76+29 RT "TYPE D GRATE"
STA. 78+27 LT "TYPE D GRATE"
STA. 78+31 RT "TYPE D GRATE"
STA. 80+43 LT "TYPE D GRATE"
STA. 80+44 RT "TYPE D GRATE"

604.42 CHANGING ELEVATION
OF SEWER MANHOLES

STA. 75+13 RT
STA. 78+78 RT

629.20 ADJUST ELEVATION
OF VALVE BOX

STA. 78+04 LT
STA. 80+43 LT

616.21 VERTICAL GRANITE CURB
STA. 75+37 - STA. 75+74 LT

616.40 REMOVING AND RESETTING CURB
STA. 80+43 - STA. 80+53 RT

616.41 REMOVAL OF EXISTING CURB
STA. 75+37 - STA. 75+74 LT
STA. 76+00 - STA. 76+35 LT

646.402 DURABLE 4" WHITE LINE, THERMOPLASTIC

STA. 74+75 - STA. 80+06 (DASHED LT)
STA. 74+75 - STA. 76+18 (DASHED RT)
STA. 74+75 - STA. 80+75 (SOLID LT & RT)
STA. 80+06 - STA. 80+75 (SOLID LT)

646.602 TEMPORARY 4" WHITE LINE, PAINT

STA. 74+75 - STA. 80+06 (DASHED LT)
STA. 74+75 - STA. 76+18 (DASHED RT)
STA. 74+75 - STA. 80+75 (SOLID LT & RT)
STA. 80+06 - STA. 80+75 (SOLID LT)

646.412 DURABLE 4" YELLOW LINE, THERMOPLASTIC

STA. 74+75 - STA. 80+75 (SOLID LT & RT, CENTERLINE)
STA. 79+07 - STA. 80+75 (SOLID RT, CENTERLINE)

646.612 TEMPORARY 4" YELLOW LINE, PAINT

STA. 74+75 - STA. 80+75 (SOLID LT & RT, CENTERLINE)
STA. 79+07 - STA. 80+75 (SOLID RT, CENTERLINE)


646.442 DURABLE 8" WHITE LINE, THERMOPLASTIC
STA. 80+06 - STA. 80+75 (HATCHED LT)

646.642 TEMPORARY 8" WHITE LINE, PAINT
STA. 80+06 - STA. 80+75 (HATCHED LT)

646.452 DURABLE 8" YELLOW LINE, THERMOPLASTIC
STA. 79+07 - STA. 80+75 (HATCHED RT)

646.652 TEMPORARY 8" YELLOW LINE, PAINT
STA. 79+07 - STA. 80+75 (HATCHED RT)

675.50 REMOVING SIGNS
AS SHOWN - 2

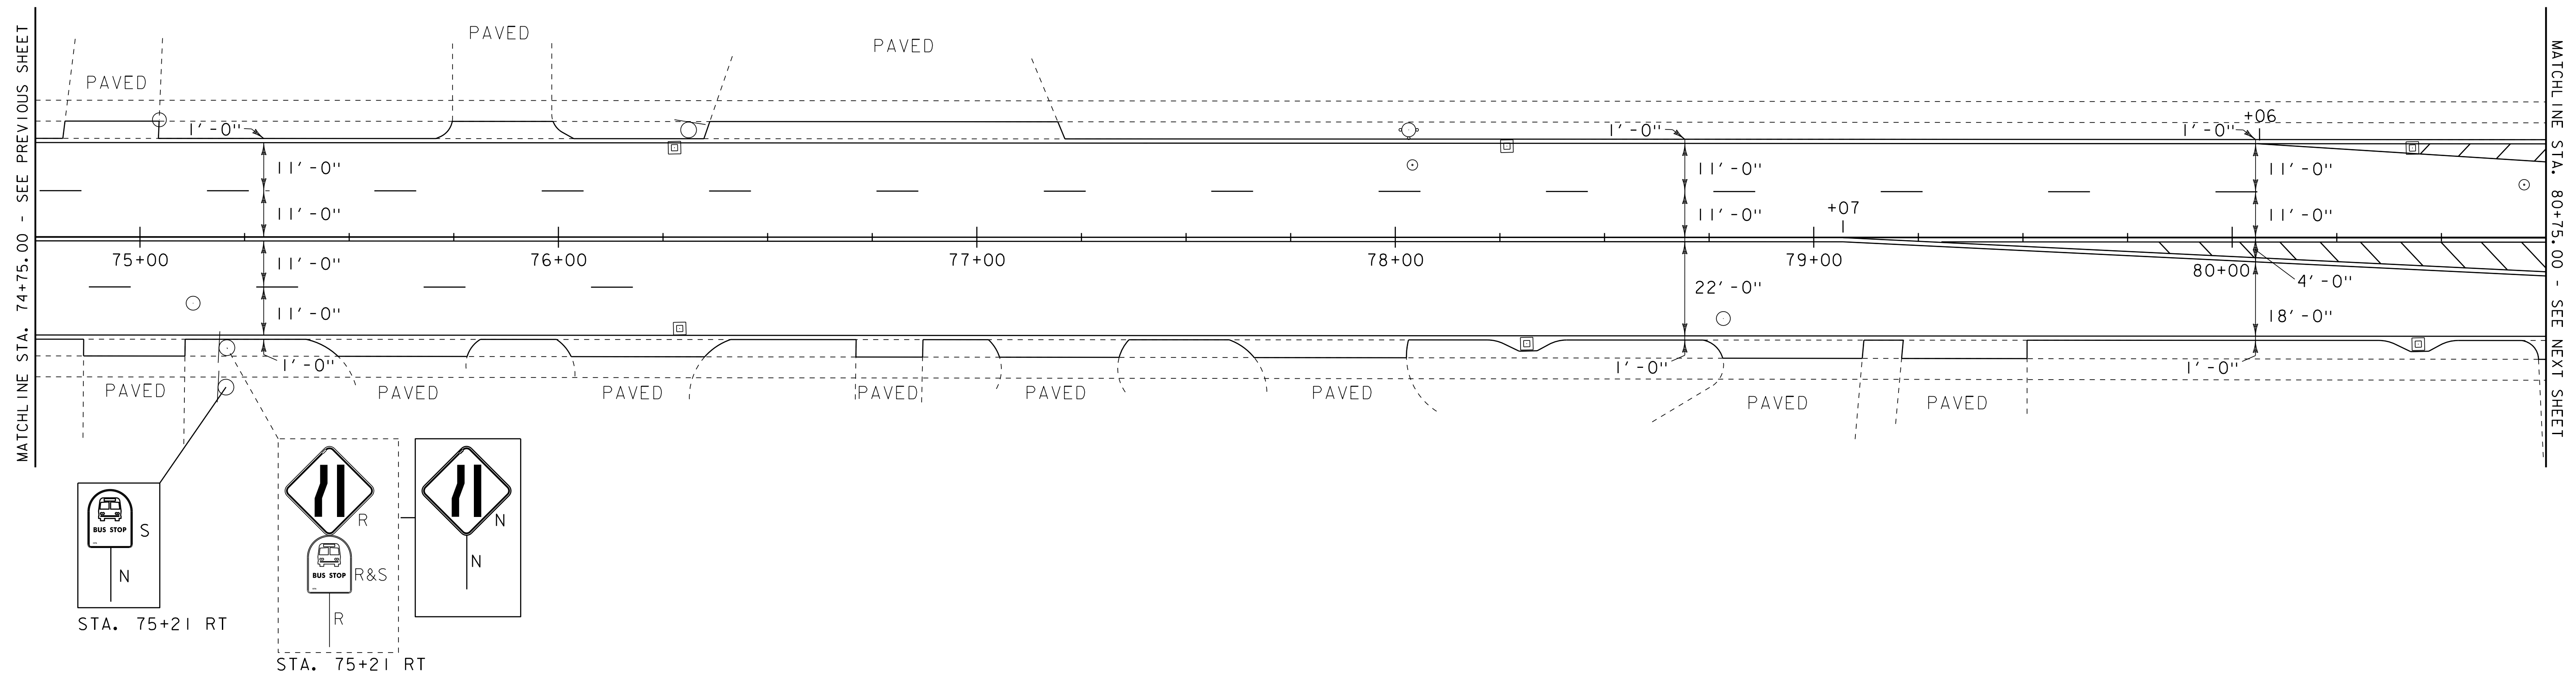

SEE REVISED SHEET

NOT TO SCALE

LEGEND		SIGN LEGEND	
⊕	HYDRANT	R	= REMOVE
○	MANHOLE	R&S	= REMOVE AND SALVAGE
⊙	WATER VALVE	RET	= RETAIN
⊙	GAS PIPELINE MARKER	S	= SALVAGE
⊠	CATCH BASIN / DROP INLET	N	= NEW
—	CURB INLET	B-B	= BACK TO BACK
⊠	TRAFFIC CONTROL BOX		
⊕	RAILROAD CROSSING SIGNAL		

DATUM	
VERTICAL	N/A
HORIZONTAL	N/A

PROJECT LAYOUT SHEET 26	PROJECT NAME: COLCHESTER-ESSEX	PLOT DATE: 30-OCT-2012 12:00
	PROJECT NUMBER: STP 2616(I)S	DRAWN BY: SJL
	FILE NAME: p06b062.dgn	CHECKED BY: EPD
	PROJECT LEADER: EPD	SHEET 34 OF \$SH\$
	DESIGNED BY: CDL	
	PLOT FILE: p06b062pl26.i	