

604.412, 604.415, 604.418 REHAB, DROP
INLETS, CATCH BASINS, OR MANHOLES, CLASS 1,
CLASS II OR CLASS III
STA. 76+28 LT "TYPE D GRATE"
STA. 76+29 RT "TYPE D GRATE"
STA. 78+27 LT "TYPE D GRATE"
STA. 78+31 RT "TYPE D GRATE"
STA. 80+43 LT "TYPE D GRATE"
STA. 80+44 RT "TYPE D GRATE"

616.21 VERTICAL GRANITE CURB
STA. 75+37 - STA. 75+74 LT

616.40 REMOVING AND RESETTING CURB
STA. 80+43 - STA. 80+53 RT

616.41 REMOVAL OF EXISTING CURB
STA. 75+37 - STA. 75+74 LT
STA. 76+00 - STA. 76+35 LT

~~646.402 DURABLE 4" WHITE LINE, THERMOPLASTIC~~

~~STA. 74+75 - STA. 80+06 (DASHED LT)~~
~~STA. 74+75 - STA. 76+18 (DASHED RT)~~
~~STA. 74+75 - STA. 80+75 (SOLID LT & RT) 1200~~
~~STA. 80+06 - STA. 80+75 (SOLID LT)~~
~~STA. 77+21 - STA. 80+00 (SOLID LT) 219~~
~~STA. 80+00 - STA. 80+75 (DOTTED LT) 24~~

646.602 TEMPORARY 4" WHITE LINE, PAINT

~~STA. 74+75 - STA. 80+06 (DASHED LT)~~
~~STA. 74+75 - STA. 76+18 (DASHED RT)~~
~~STA. 74+75 - STA. 80+75 (SOLID LT & RT)~~
~~STA. 80+06 - STA. 80+75 (SOLID LT)~~
~~STA. 77+21 - STA. 80+00 (SOLID LT)~~
~~STA. 80+00 - STA. 80+75 (DOTTED LT)~~

~~646.412 DURABLE 4" YELLOW LINE, THERMOPLASTIC~~

~~STA. 74+75 - STA. 80+75 (SOLID LT & RT, CENTERLINE)~~
~~STA. 79+07 - STA. 80+75 (SOLID RT, CENTERLINE)~~
~~STA. 74+75 - STA. 76+35 (SOLID LT & RT) 520~~
~~STA. 74+75 - STA. 76+35 (DASHED LT & RT) 80~~
~~STA. 77+21 - STA. 80+75 (SOLID RT, CENTERLINE) 708~~
~~STA. 80+00 - STA. 80+75 (SOLID RT, CENTERLINE) 150~~

~~646.442 DURABLE 6" WHITE LINE, THERMOPLASTIC~~
~~STA. 80+06 - STA. 80+75 (HATCHED LT)~~

~~646.642 TEMPORARY 8" WHITE LINE, PAINT~~
~~STA. 80+06 - STA. 80+75 (HATCHED LT)~~

~~646.452 DURABLE 8" YELLOW LINE, THERMOPLASTIC~~
~~STA. 79+07 - STA. 80+75 (HATCHED RT) 45~~

646.652 TEMPORARY 8" YELLOW LINE, PAINT
STA. 79+07 - STA. 80+75 (HATCHED RT)

675.50 REMOVING SIGNS
AS SHOWN - X 3

NOTE:

1.) ALL SEWER MANHOLE AND VALVE BOX ADJUSTMENTS TO BE DONE BY OTHERS UNLESS OTHERWISE NOTED IN THE PLANS.

646.612 TEMPORARY 4" YELLOW LINE, PAINT

~~STA. 74+75 - STA. 80+75 (SOLID LT & RT, CENTERLINE)~~
~~STA. 79+07 - STA. 80+75 (SOLID RT, CENTERLINE)~~
~~STA. 74+75 - STA. 76+35 (SOLID LT & RT)~~
~~STA. 74+75 - STA. 76+35 (DASHED LT & RT)~~
~~STA. 77+21 - STA. 80+75 (SOLID RT, CENTERLINE)~~
~~STA. 80+00 - STA. 80+75 (SOLID RT, CENTERLINE)~~

646.30

~~646.492 DURABLE LETTER OR SYMBOL, THERMOPLASTIC~~

~~STA. 75+96 CTR ARROW~~ ~~STA. 77+65 RT ARROW~~
~~STA. 76+16 CTR ARROW~~ ~~STA. 77+80 CTR ARROW~~
~~STA. 77+35 LT ARROW~~ ~~STA. 77+93 CTR ONLY~~
~~STA. 77+47 LT BIKE~~ ~~STA. 79+89 CTR ARROW~~
~~STA. 77+53 RT BIKE~~ ~~STA. 79+95 CTR ONLY~~

646.692 TEMPORARY LETTER OR SYMBOL, PAINT

STA. 75+96 CTR ARROW STA. 77+65 RT "LANE"
STA. 76+16 CTR ARROW STA. 77+80 CTR ARROW
STA. 77+35 LT "LANE" STA. 77+93 CTR ONLY
STA. 77+47 LT "BIKE" STA. 79+89 CTR ARROW
STA. 77+53 RT "BIKE" STA. 79+95 CTR ONLY


646.214

~~646.422 DURABLE 6" WHITE LINE, THERMOPLASTIC~~

STA. 74+75 - STA. 80+75 (SOLID LT & RT) (BIKE) 1200

~~646.622 TEMPORARY 6" WHITE LINE, PAINT~~

STA. 74+75 - STA. 80+75 (SOLID LT & RT) (BIKE)

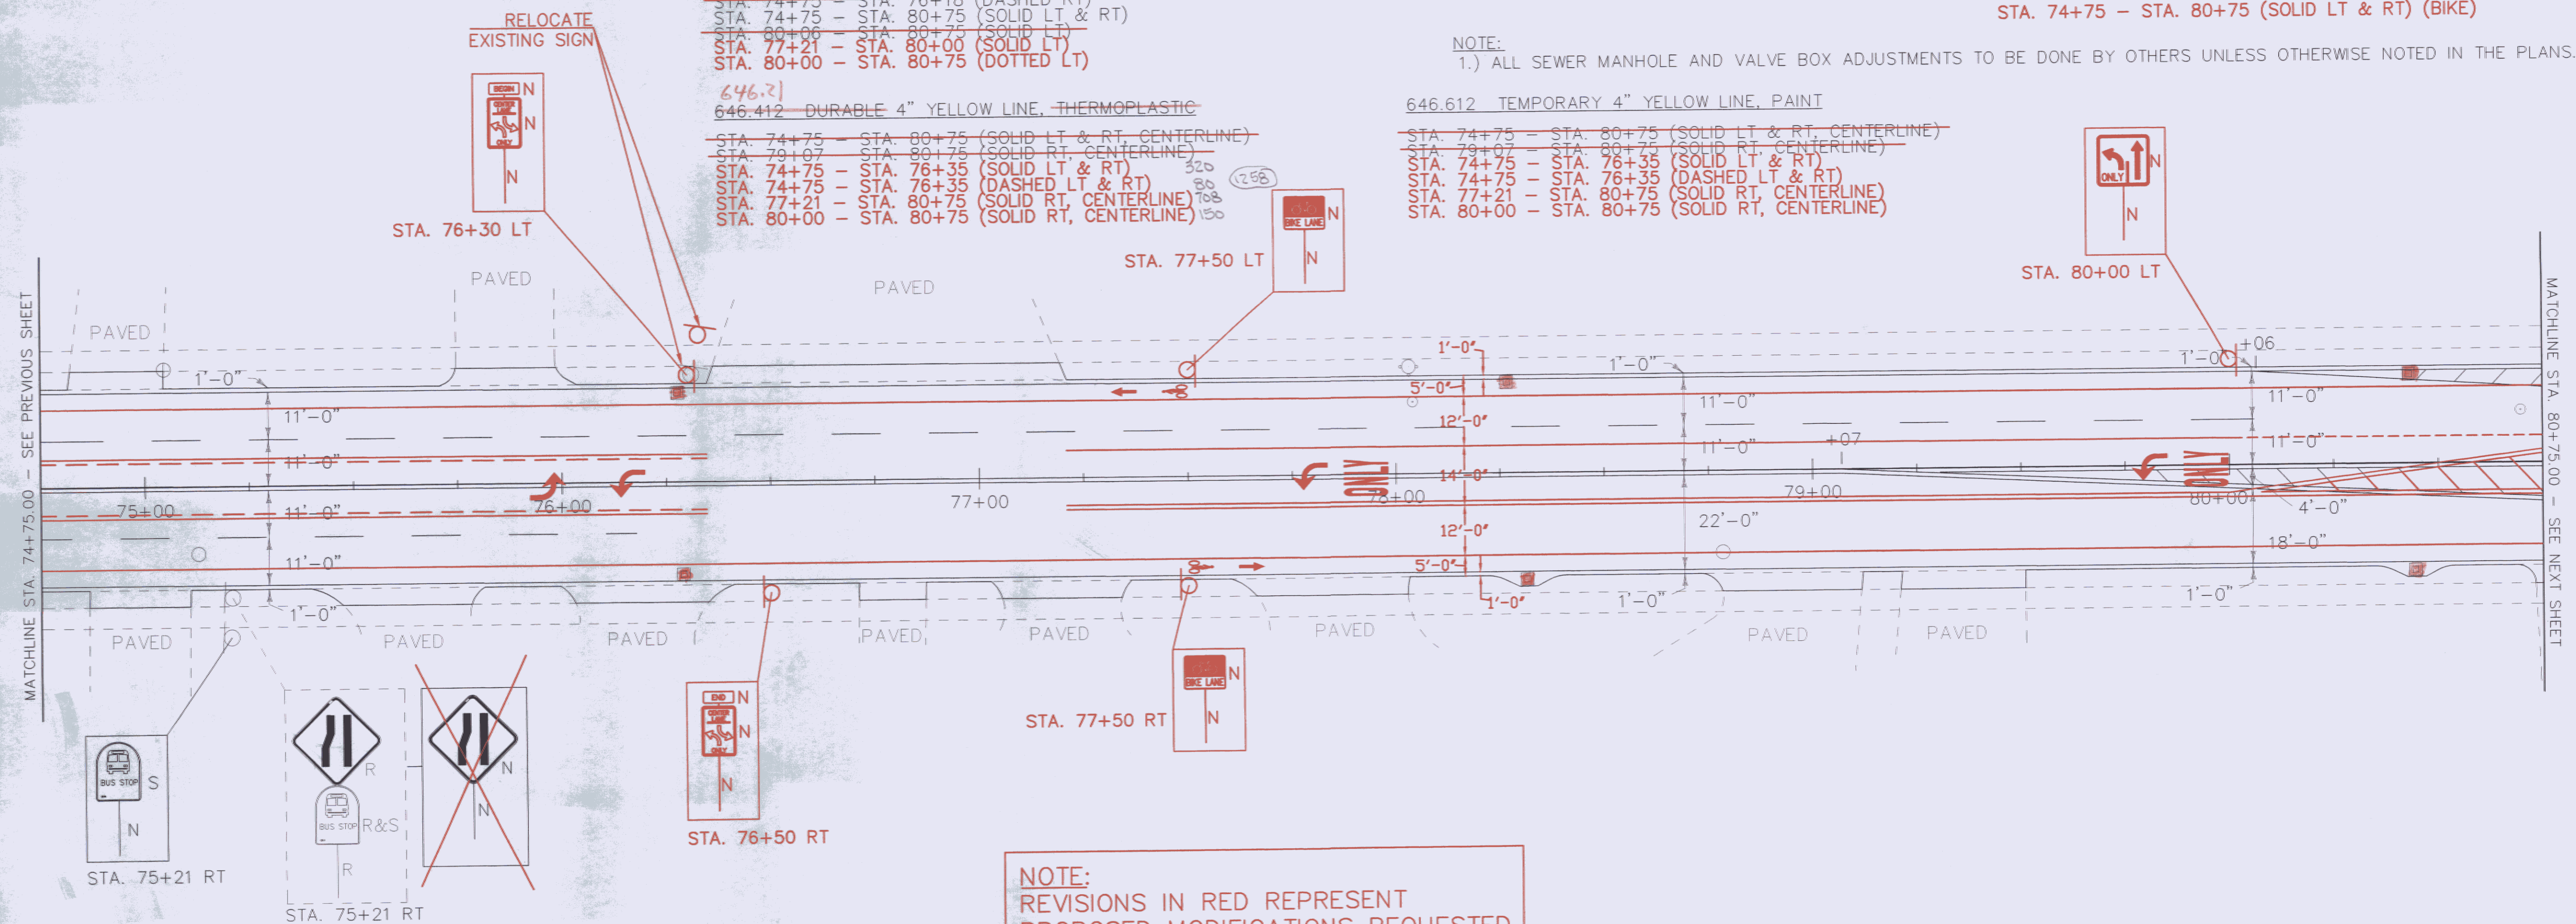

NOTE:
REVISIONS IN RED REPRESENT
PROPOSED MODIFICATIONS REQUESTED
BY THE VILLAGE OF ESSEX JUNCTION

- LEGEND
- HYDRANT
 - MANHOLE
 - WATER VALVE
 - GAS PIPELINE MARKER
 - CATCH BASIN / DROP INLET
 - CURB INLET
 - ⊠ TRAFFIC CONTROL BOX
 - ⊕ RAILROAD CROSSING SIGNAL
- SIGN LEGEND
- R = REMOVE
 - R&S = REMOVE AND SALVAGE
 - RET = RETAIN
 - S = SALVAGE
 - N = NEW
 - B-B = BACK TO BACK

NOT TO SCALE

DATUM
VERTICAL N/A
HORIZONTAL N/A

PROJECT LAYOUT SHEET 26	PROJECT NAME: COLCHESTER-ESSEX	PLOT DATE: \$\$\$DATE\$\$\$
	PROJECT NUMBER: STP 2616(1)	DRAWN BY: S.JL
	FILE NAME: p06b062.dgn	CHECKED BY: EPD
	PROJECT LEADER: EPD	SHEET 34 OF 45
	DESIGNED BY: CDL	
	PLOT FILE: p06b062p126.i	

04/13/09