


**VIDEO VEHICLE DETECTION SYSTEM EQUIPMENT LIST**

LIST OF MAJOR EQUIPMENT	
ITEM # 900.620, SPECIAL PROVISION (VIDEO VEHICLE DETECTION SYSTEM) (SUSIE WILSON RD. @ PINECREST DR.)	QUANTITY
ENCOM MODEL EP-5200S,RS-232,SHELF MOUNT RADIO	1
YAGI ANTENNA, 8.5 DB, 900 MHZ	1
LIGHTNING PROTECTION	1
6' RF JUMPER CABLE	1
ENCOM DATA CABLE, CB-112	1
LMR COAXIAL CABLE, CB-1055	1

VIDEO DETECTION SYSTEM NOTES:

- 1) THE MASTER CONTROLLER FOR THE SUSIE WILSON CORRIDOR IS LOCATED IN THE CABINET AT THE SUSIE WILSON RD. & PINECREST DR. INTERSECTION. WORK ASSOCIATED WITH THE INTERCONNECT EQUIPMENT INSTALLATION ALONG VT ROUTE 15 WILL BE PERFORMED AT THIS LOCATION.

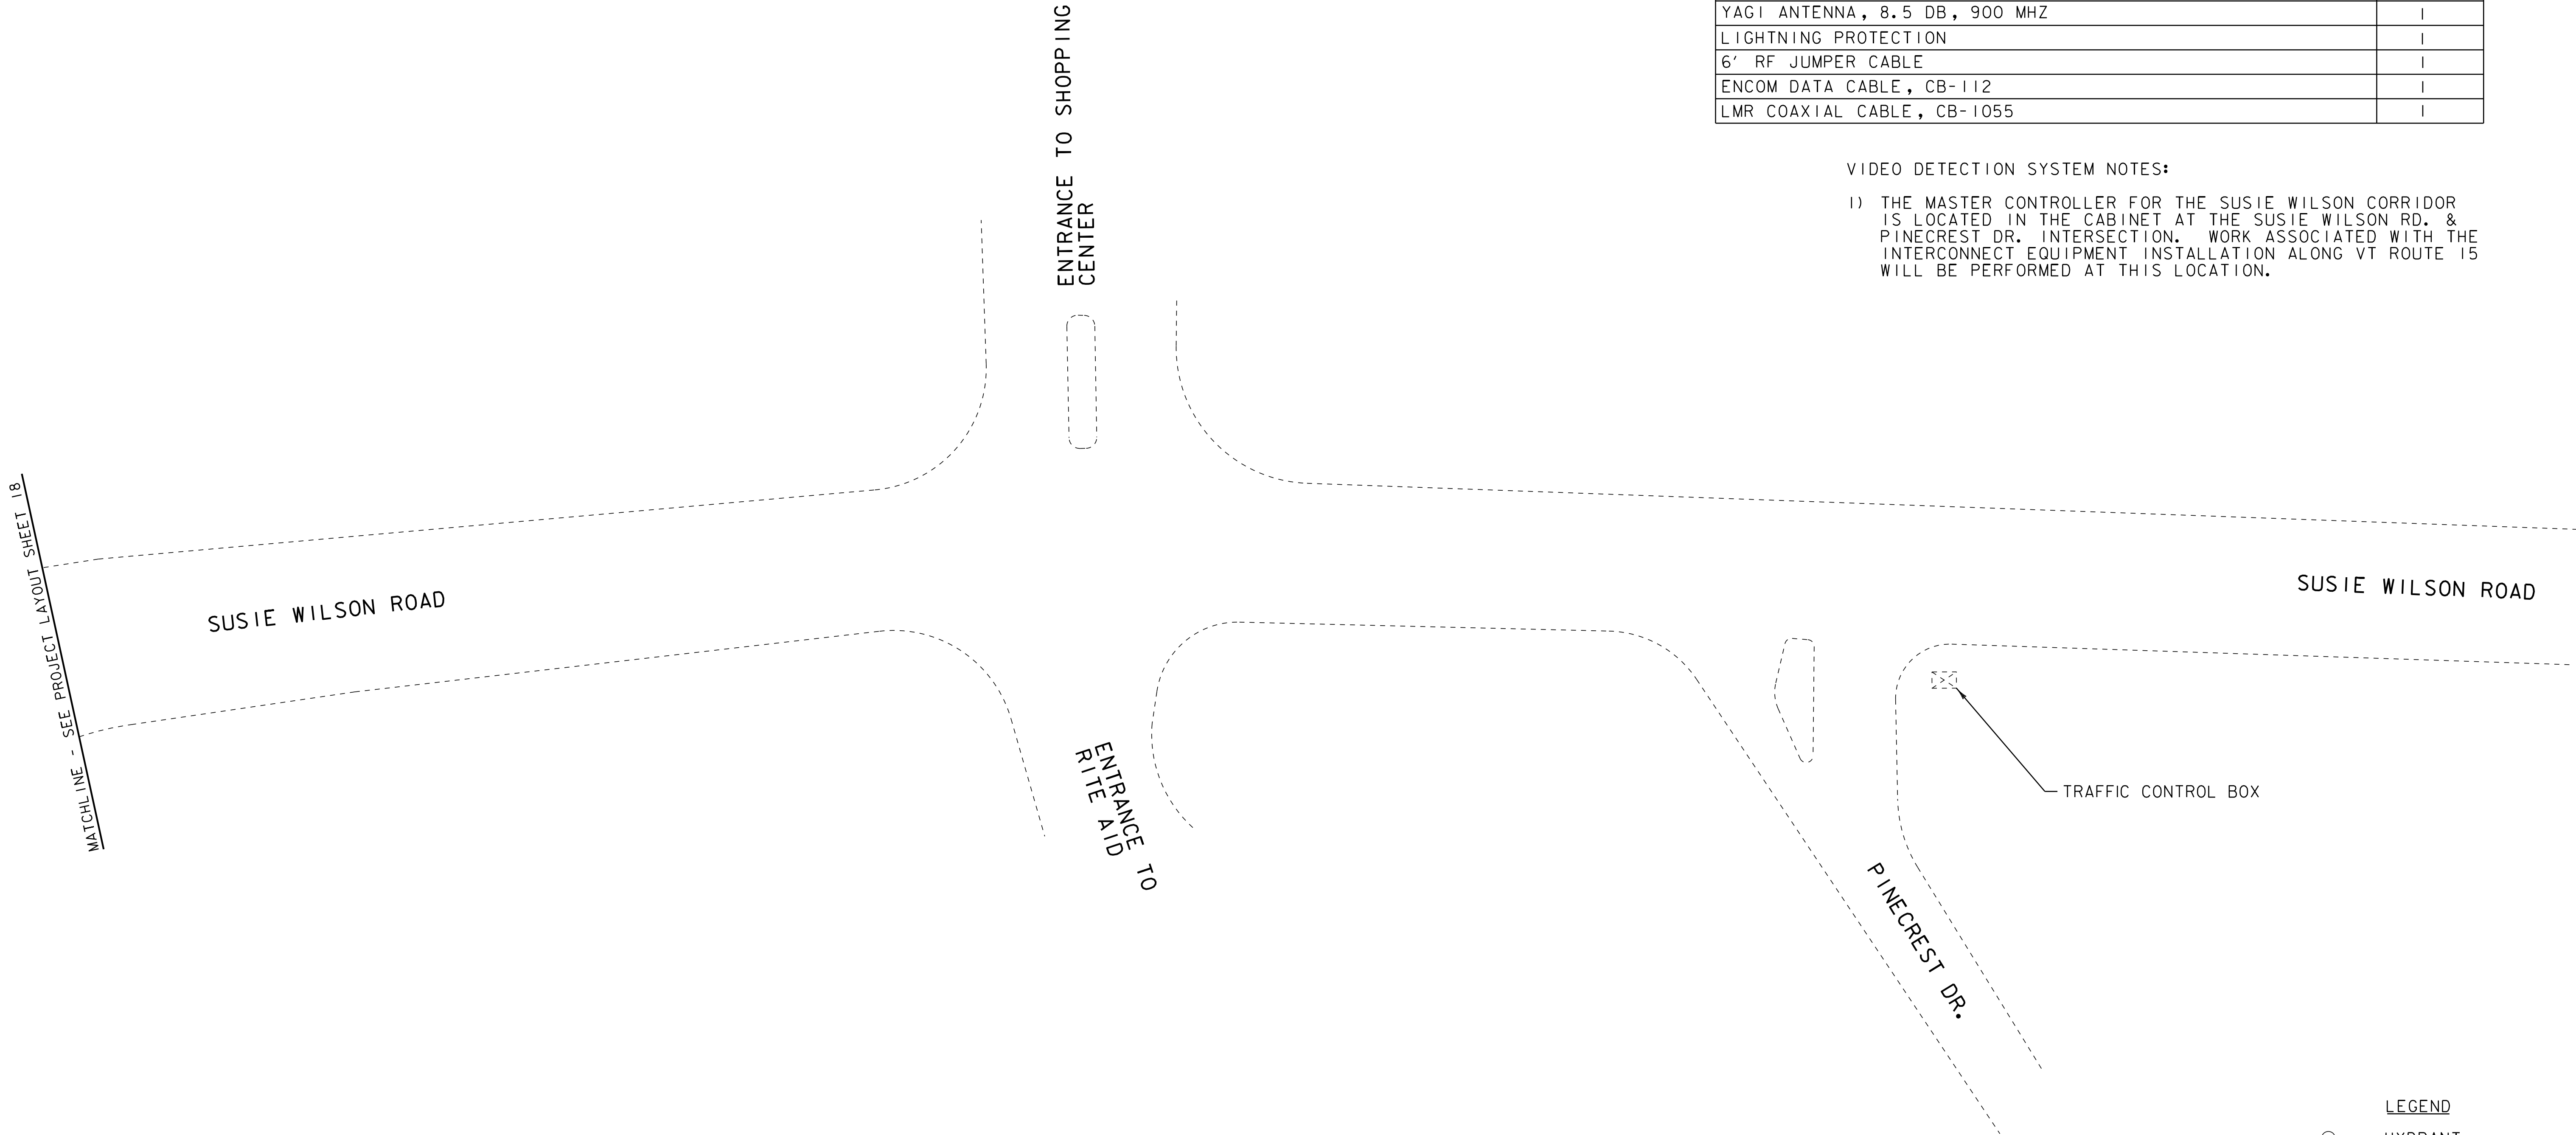

**LEGEND**

- ⊙ HYDRANT
- MANHOLE
- ⊙ WATER VALVE
- ⊙ GAS PIPELINE MARKER
- ⊠ CATCH BASIN / DROP INLET
- CURB INLET
- ⊠ TRAFFIC CONTROL BOX
- ⊕ RAILROAD CROSSING SIGNAL

DATUM	
VERTICAL	N/A
HORIZONTAL	N/A

NOT TO SCALE

**PROJECT LAYOUT SHEET 28**

PROJECT NAME: COLCHESTER-ESSEX	PLOT DATE: 30-OCT-2012 12:00
PROJECT NUMBER: STP 2616(I)	DRAWN BY: SJL
FILE NAME: p06b062.dgn	CHECKED BY: EPD
PROJECT LEADER: EPD	SHEET 36 OF 45
DESIGNED BY: CDL	
PLOT FILE: p06b062pl28.i	