



RECLAIM TYPICAL SECTION

U. S. ROUTE 4 BRIDGEWATER STA. 318+01.44 TO BRIDGEWATER STA. 350+59.20
 U. S. ROUTE 4 WOODSTOCK STA. 0+00.00 TO WOODSTOCK STA. 104+54.00
 U. S. ROUTE 4 WOODSTOCK STA. 117+74 TO 211+20.00

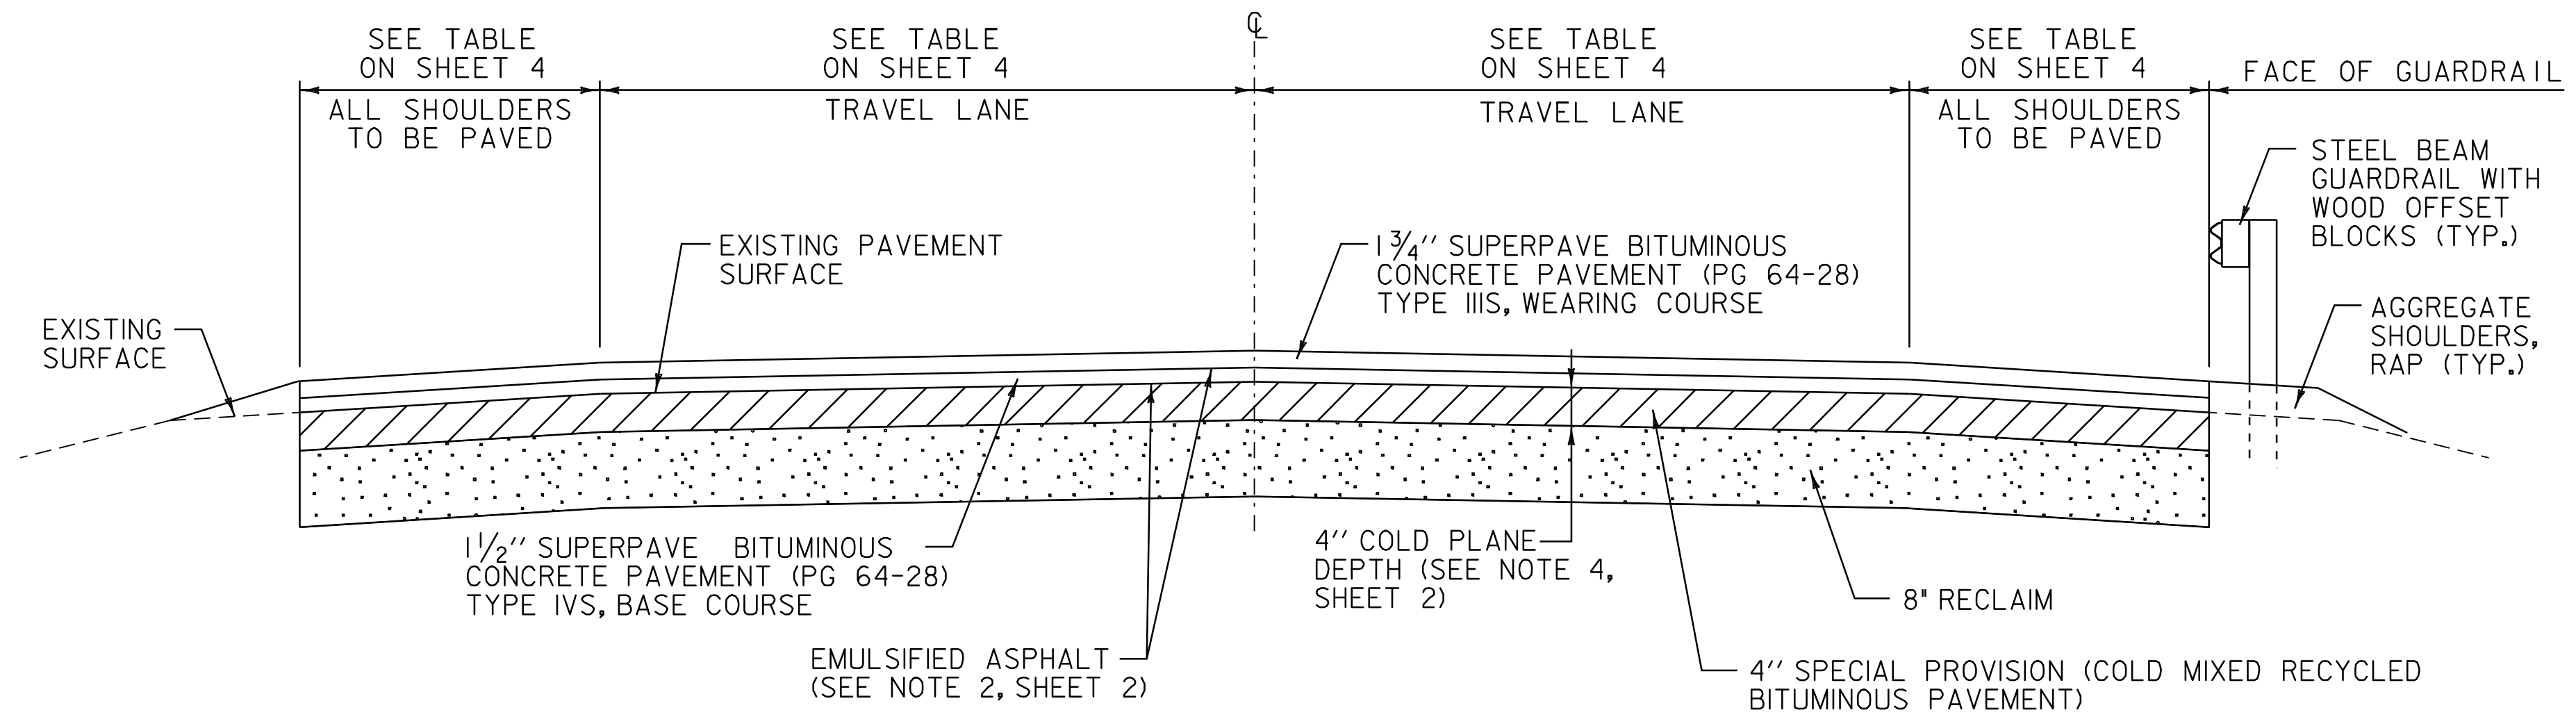

RECLAIM TYPICAL SECTION

U. S. ROUTE 4 WOODSTOCK STA. 104+54.00 TO WOODSTOCK STA. 117+74.00

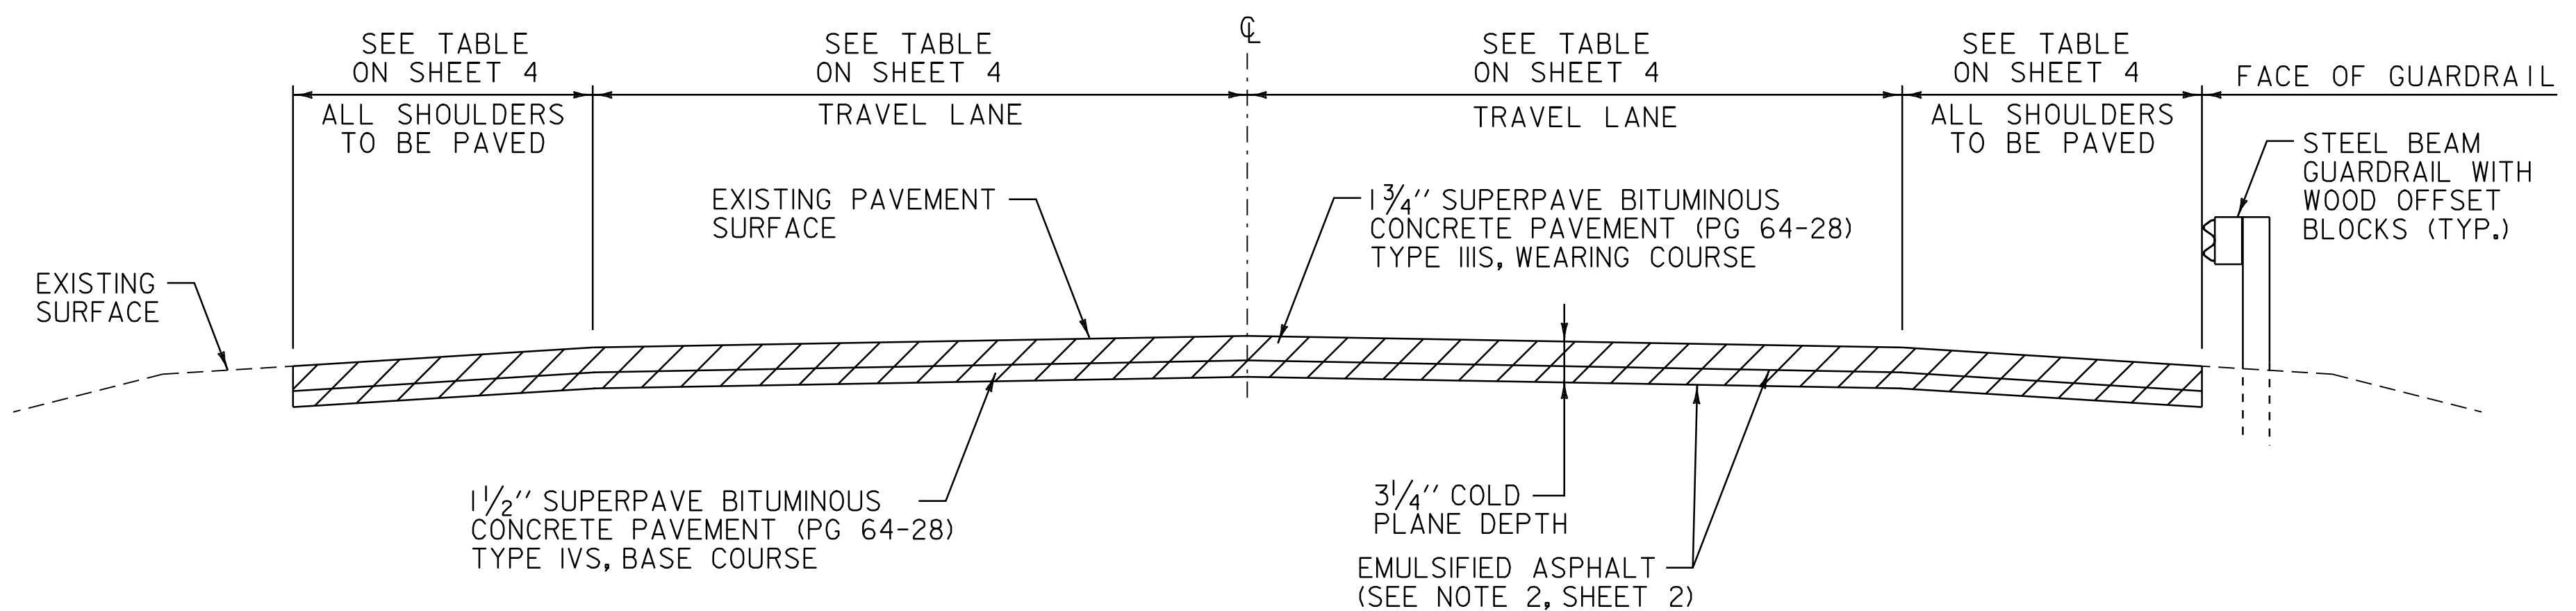

COLD PLANE TYPICAL SECTION

U. S. ROUTE 4 BRIDGEWATER STA. 350+59.20 TO BRIDGEWATER STA. 396+63.36
 U. S. ROUTE 4 WOODSTOCK STA. 211+20.00 TO WOODSTOCK STA. 298+32.00

CONSERVATION SEED MIX

RURAL AREA - SEED MIXTURE				
% WT.	LBS./A.	NAME	PUR. %	GERM. %
37.5	22.5	CREeping RED FESCUE	98	85
37.5	22.5	TALL FESCUE	95	90
5.0	3.0	RED TOP	95	90
15.0	9.0	BIRDSFOOT TREFOIL	98	85
5.0	3.0	ANNUAL RYEGRASS	95	85
100.0	60.0			

SEED MIXTURE:
 SHALL NOT HAVE A WEED CONTENT EXCEEDING 0.40% BY WEIGHT AND SHALL BE FREE OF ALL NOXIOUS WEED SEED.

SEED:
 TO BE APPLIED PER SEEDING FORMULA OR AS DIRECTED BY THE RESIDENT ENGINEER.

FERTILIZER:
 FORMULA 10-20-10 TO BE USED WITH SEED APPLIED AT THE RATE OF 500 LBS/ACRE (HYDRO SEEDERS MAY USE 19-19-19 FORMULA).

AGRICULTURAL LIMESTONE:
 TO BE APPLIED AT THE RATE OF 2 TONS/ACRE OR AS DIRECTED BY THE RESIDENT ENGINEER.

HAY MULCH:
 TO BE APPLIED ON EARTH SLOPES AT THE RATE OF 2 TONS/ACRE OR AS DIRECTED BY THE RESIDENT ENGINEER.

TOPSOIL:
 TO BE USED WITH SEED AS INDICATED ON THE PLANS OR AS DIRECTED BY THE RESIDENT ENGINEER.

NOT TO SCALE

PROJECT TYPICAL SHEET

PROJECT NAME: BRIDGEWATER_-_WOODSTOCK
 PROJECT NUMBER: NH_2611(S)

FILE NAME: p06b160.dgn__ PLOT DATE: 28-MAY-2010
 PROJECT LEADER: D.E.G. DRAWN BY: C.A.K.
 DESIGNED BY: D.W.E. CHECKED BY: D.E.G.
 IPARM FILE: p06b160ts01. SHEET 3 OF 80