

646.402 DURABLE 4 INCH WHITE LINE, THERMOPLASTIC
 (ALL LINES WILL INCLUDE EDGE LINE BREAKS AND
 RADIUS FOR TOWN HIGHWAYS)
 BRIDGEWATER:
 STA. 384+00.00 - STA. 396+63.36 LT & RT

WOODSTOCK:
 STA. 0+00.00 - STA. 2+00.00 LT & RT

646.412 DURABLE 4 INCH YELLOW LINE, THERMOPLASTIC
 (ALL LINES WILL INCLUDE C/L BREAKS FOR
 TOWN HIGHWAYS) S=SOLID, D=DASHED
 BRIDGEWATER: LT C RT
 STA. 384+00.00 - STA. 396+63.36 S - S
 STA. 387+81.60 DOUBLE SOLID RT, TH-46

WOODSTOCK:
 STA. 0+00.00 - STA. 2+00.00 S - S

646.602 TEMPORARY 4 INCH WHITE LINE, PAINT
 (ALL LINES WILL INCLUDE EDGE LINE BREAKS AND
 RADIUS FOR TOWN HIGHWAYS)
 BRIDGEWATER:
 STA. 384+00.00 - STA. 396+63.36 LT & RT

WOODSTOCK:
 STA. 0+00.00 - STA. 2+00.00 LT & RT

646.612 TEMPORARY 4 INCH YELLOW LINE, PAINT
 (ALL LINES WILL INCLUDE C/L BREAKS FOR
 TOWN HIGHWAYS) S=SOLID, D=DASHED
 BRIDGEWATER: LT C RT
 STA. 384+00.00 - STA. 396+63.36 S - S
 STA. 387+81.60 DOUBLE SOLID RT, TH-46

WOODSTOCK:
 STA. 0+00.00 - STA. 2+00.00 S - S

646.482 DURABLE 24 INCH STOP BAR, THERMOPLASTIC
 BRIDGEWATER:
 STA. 387+81.60 RT, TH-46

646.492 DURABLE LETTER OR SYMBOL, THERMOPLASTIC
 BRIDGEWATER:
 STA. 387+81.60 RT, TH-46 "S,T,O,P" (4 EA)
 STA. 390+38.0 LT, "S,C,H,O,O,L" (6 EA)

646.682 TEMPORARY 24 INCH STOP BAR, PAINT
 BRIDGEWATER:
 STA. 387+81.60 RT, TH-46

646.692 TEMPORARY LETTER OR SYMBOL, PAINT
 BRIDGEWATER:
 STA. 387+81.60 RT, TH-46 "S,T,O,P" (8 EA)
 STA. 390+38.0 LT, "S,C,H,O,O,L" (12 EA)


646.50 DURABLE CROSSWALK MARKING, TYPE ~~TTAPE~~ THERMOPLASTIC
 BRIDGEWATER:
 STA. 385+40.0, LT/RT

646.702 TEMPORARY CROSSWALK MARKING, PAINT
 BRIDGEWATER:
 STA. 385+40.0, LT/RT

675.50 REMOVING SIGNS
 AS SHOWN - 18


675.60 ERECTING SALVAGED SIGNS
 AS SHOWN - 1

U.S. ROUTE 4
 MM 7.512 = STA. 396+63.36
 MM 0.000 = STA. 0+00.00
 RESUME RECLAIM

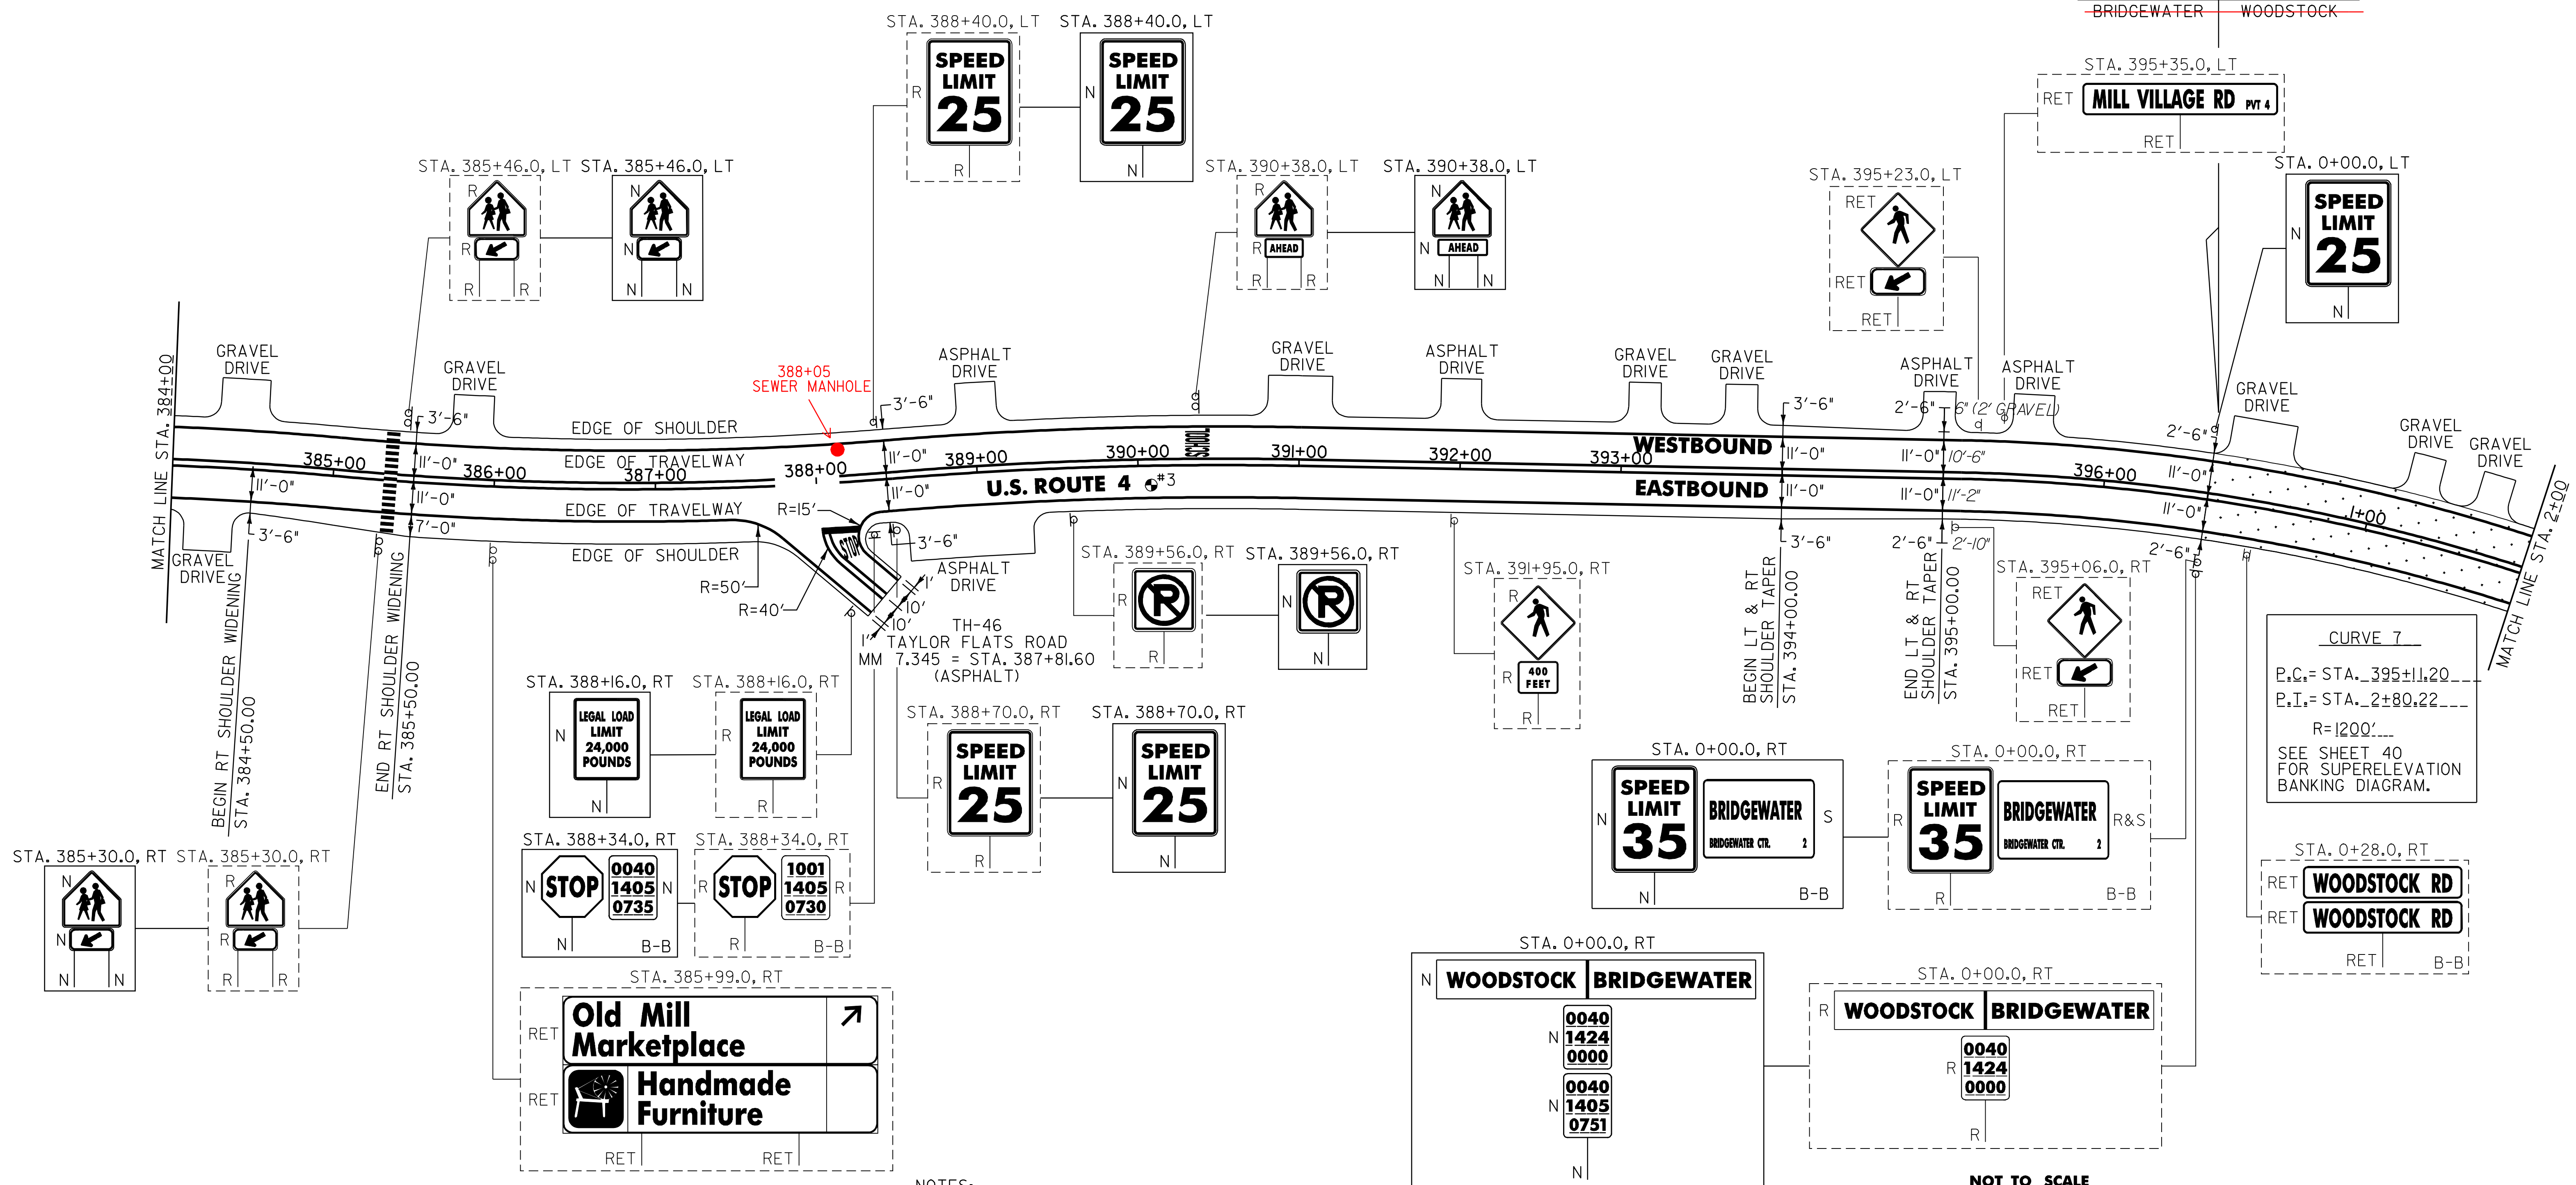

PAVEMENT CORES = ●

#	TOTAL DEPTH (INCH)	PCC	COMMENTS
3	10	NO	

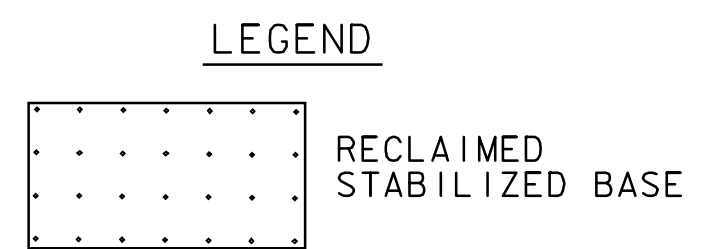

NOTES:

- PAVING LIMIT ON ALL TOWN HIGHWAYS SHALL BE MEASURED 25 FT BACK FROM U.S. ROUTE 4 EDGE OF SHOULDER UNLESS DENOTED OTHERWISE ON THE PLANS OR AS DIRECTED BY THE RESIDENT ENGINEER.
- SEE SHEET 79 FOR DETAIL OF CROSSWALK MARKINGS.

SIGN LEGEND

R = REMOVE
 S = SALVAGE
 N = NEW
 RET = RETAIN
 B-B = BACK TO BACK
 EXISTING =
 NEW =

NOT TO SCALE

PROJECT LAYOUT SHEET #6

PROJECT NAME: BRIDGEWATER - WOODSTOCK
 PROJECT NUMBER: NH_2611(S)

FILE NAME: p06b160.dgn
 PROJECT LEADER: D.E.G.
 DESIGNED BY: D.W.E.
 IPARM FILE: p06b160.i

PLOT DATE: 28-MAY-2010
 DRAWN BY: C.A.K.
 CHECKED BY: D.E.G.
 SHEET 17 OF 80