


646.402 DURABLE 4 INCH WHITE LINE, THERMOPLASTIC  
 (ALL LINES WILL INCLUDE EDGE LINE BREAKS AND RADIUS FOR TOWN HIGHWAYS)  
 WOODSTOCK:  
 STA. 64+00.00 - STA. 80+00.00 LT & RT

646.412 DURABLE 4 INCH YELLOW LINE, THERMOPLASTIC  
 (ALL LINES WILL INCLUDE C/L BREAKS FOR TOWN HIGHWAYS) S=SOLID, D=DASHED  
 WOODSTOCK:  
 STA. 64+00.00 - STA. 68+11.20 D - S  
 STA. 68+11.20 - STA. 73+39.20 S - S  
 STA. 73+39.20 - STA. 80+00.00 S - D

646.602 TEMPORARY 4 INCH WHITE LINE, PAINT  
 (ALL LINES WILL INCLUDE EDGE LINE BREAKS AND RADIUS FOR TOWN HIGHWAYS)  
 WOODSTOCK:  
 STA. 64+00.00 - STA. 80+00.00 LT & RT

646.612 TEMPORARY 4 INCH YELLOW LINE, PAINT  
 (ALL LINES WILL INCLUDE C/L BREAKS FOR TOWN HIGHWAYS) S=SOLID, D=DASHED  
 WOODSTOCK:  
 STA. 64+00.00 - STA. 68+11.20 D - S  
 STA. 68+11.20 - STA. 73+39.20 S - S  
 STA. 73+39.20 - STA. 80+00.00 S - D

675.50 REMOVING SIGNS  
 AS SHOWN - 6

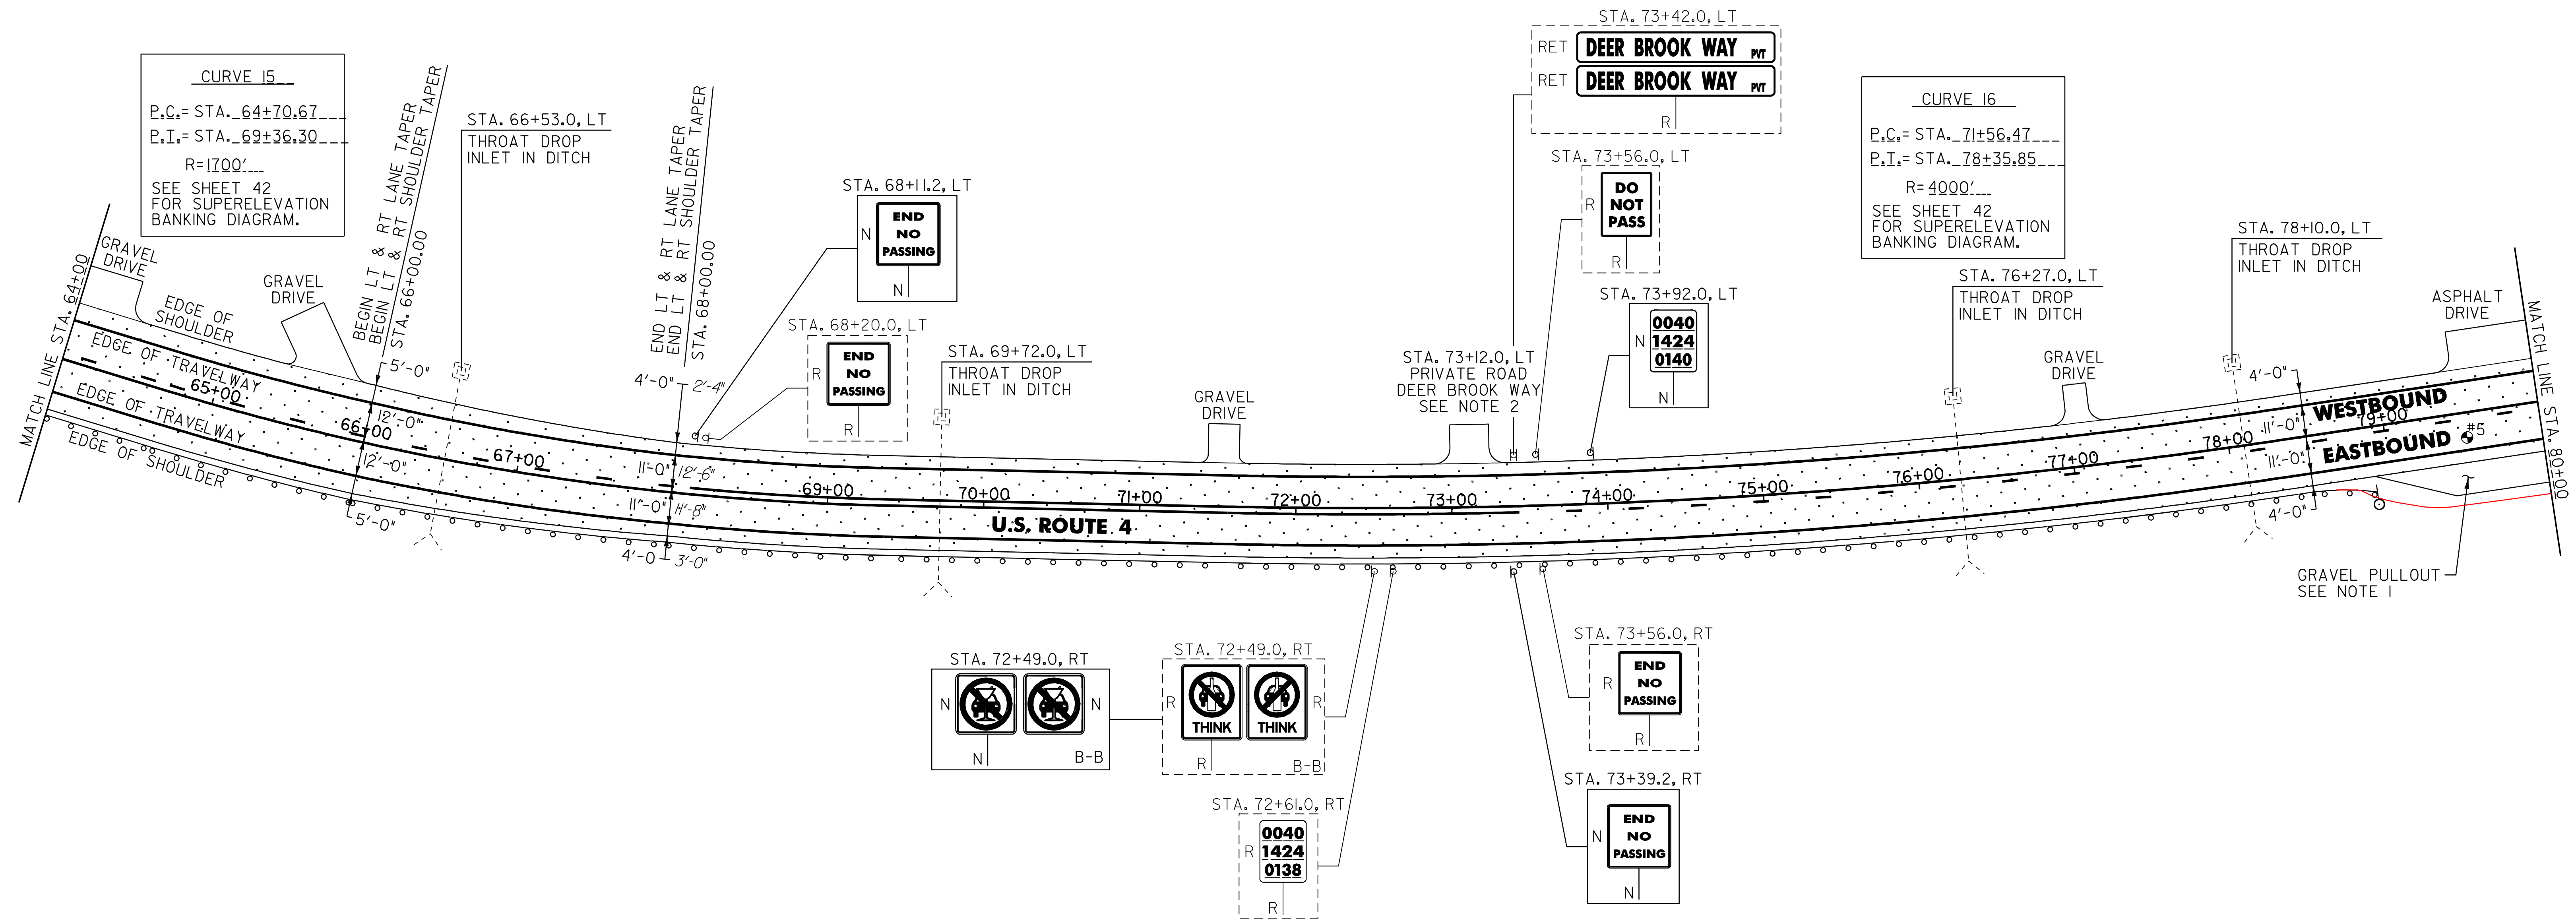

~~621.205 STEEL BEAM GUARDRAIL, GALV. W/ 8' POSTS~~  
~~74+15.3 - 80+00 - (586.5)~~

~~604.412 REHAB. DROP INLETS, CATCH BASINS OR MANHOLE, CLASS I~~  
 WOODSTOCK:  
 STA. 66+53.0 LT  
 STA. 69+72.0 LT  
 STA. 76+27.0 LT  
 STA. 78+10.0 LT

~~621.20 STEEL BEAM GUARDRAIL, GALVANIZED~~  
 WOODSTOCK: 74+15.3  
 STA. 64+00.0 - STA. 78+52.8 RT (4452.8 LF) (1015.3)

~~621.50 MANUFACTURED TERMINAL SECTION, FLARED~~  
~~WOODSTOCK:~~  
~~STA. 78+52.8 - STA. 78+90.3 RT~~

621.80 REMOVAL AND DISPOSAL OF GUARDRAIL  
 WOODSTOCK:  
 STA. 64+00.0 - STA. 78+86.0 RT (4486.0 LF)


676.10 DELINEATOR WITH STEEL POST  
 ♀ TYPE I WHITE

WOODSTOCK:  
 STA. 78+90.3 RT

PAVEMENT CORES = ●

#	TOTAL DEPTH (INCH)	PCC	COMMENTS
5	9 3/4	NO	

LEGEND

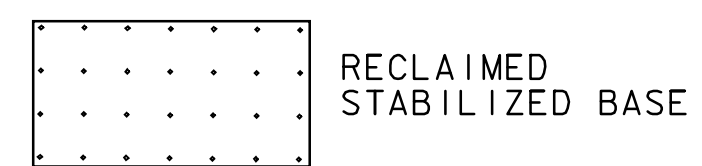

SIGN LEGEND  
 R = REMOVE  
 S = SALVAGE  
 N = NEW  
 RET = RETAIN  
 B-B = BACK TO BACK  
 EXISTING = - - - - -  
 NEW = \_\_\_\_\_

NOTES:

- PROVIDE A 5 FT WIDE, 1 3/4" TYPE III APRON FOR THE EXISTING GRAVEL PULLOUT. ANY REQUIRED EXCAVATION SHALL BE PERFORMED AS DIRECTED BY THE RESIDENT ENGINEER AND PAID FOR UNDER ITEM 608.25 ALL PURPOSE EXCAVATOR RENTAL, TYPE I.
- PROVIDE A 15 FT WIDE, 1 3/4" TYPE III APRON FOR THE EXISTING PRIVATE ROAD. ANY REQUIRED EXCAVATION SHALL BE PERFORMED AS DIRECTED BY THE RESIDENT ENGINEER AND PAID FOR UNDER ITEM 608.25 ALL PURPOSE EXCAVATOR RENTAL, TYPE I.

NOT TO SCALE

**PROJECT LAYOUT SHEET #11**

PROJECT NAME: BRIDGEWATER - WOODSTOCK  
 PROJECT NUMBER: NH\_2611(S)  
 FILE NAME: p06b160.dgn  
 PROJECT LEADER: D.E.G.  
 DESIGNED BY: D.W.E.  
 IPARM FILE: p06b16011.i  
 PLOT DATE: 28-MAY-2010  
 DRAWN BY: C.A.K.  
 CHECKED BY: D.E.G.  
 SHEET 22 OF 80