


646.402 DURABLE 4 INCH WHITE LINE, THERMOPLASTIC
 (ALL LINES WILL INCLUDE EDGE LINE BREAKS AND
 RADIUS FOR TOWN HIGHWAYS)
 WOODSTOCK:
 STA. 96+00.00 - STA. 112+00.00 LT & RT

646.412 DURABLE 4 INCH YELLOW LINE, THERMOPLASTIC
 (ALL LINES WILL INCLUDE C/L BREAKS FOR
 TOWN HIGHWAYS) S=SOLID, D=DASHED
 WOODSTOCK:
 STA. 96+00.00 - STA. 112+00.00 LT ☉ RT
 S - S

646.602 TEMPORARY 4 INCH WHITE LINE, PAINT
 (ALL LINES WILL INCLUDE EDGE LINE BREAKS AND
 RADIUS FOR TOWN HIGHWAYS)
 WOODSTOCK:
 STA. 96+00.00 - STA. 112+00.00 LT & RT

646.612 TEMPORARY 4 INCH YELLOW LINE, PAINT
 (ALL LINES WILL INCLUDE C/L BREAKS FOR
 TOWN HIGHWAYS) S=SOLID, D=DASHED
 WOODSTOCK:
 STA. 96+00.00 - STA. 112+00.00 LT ☉ RT
 S - S

675.50 REMOVING SIGNS
 AS SHOWN - 6

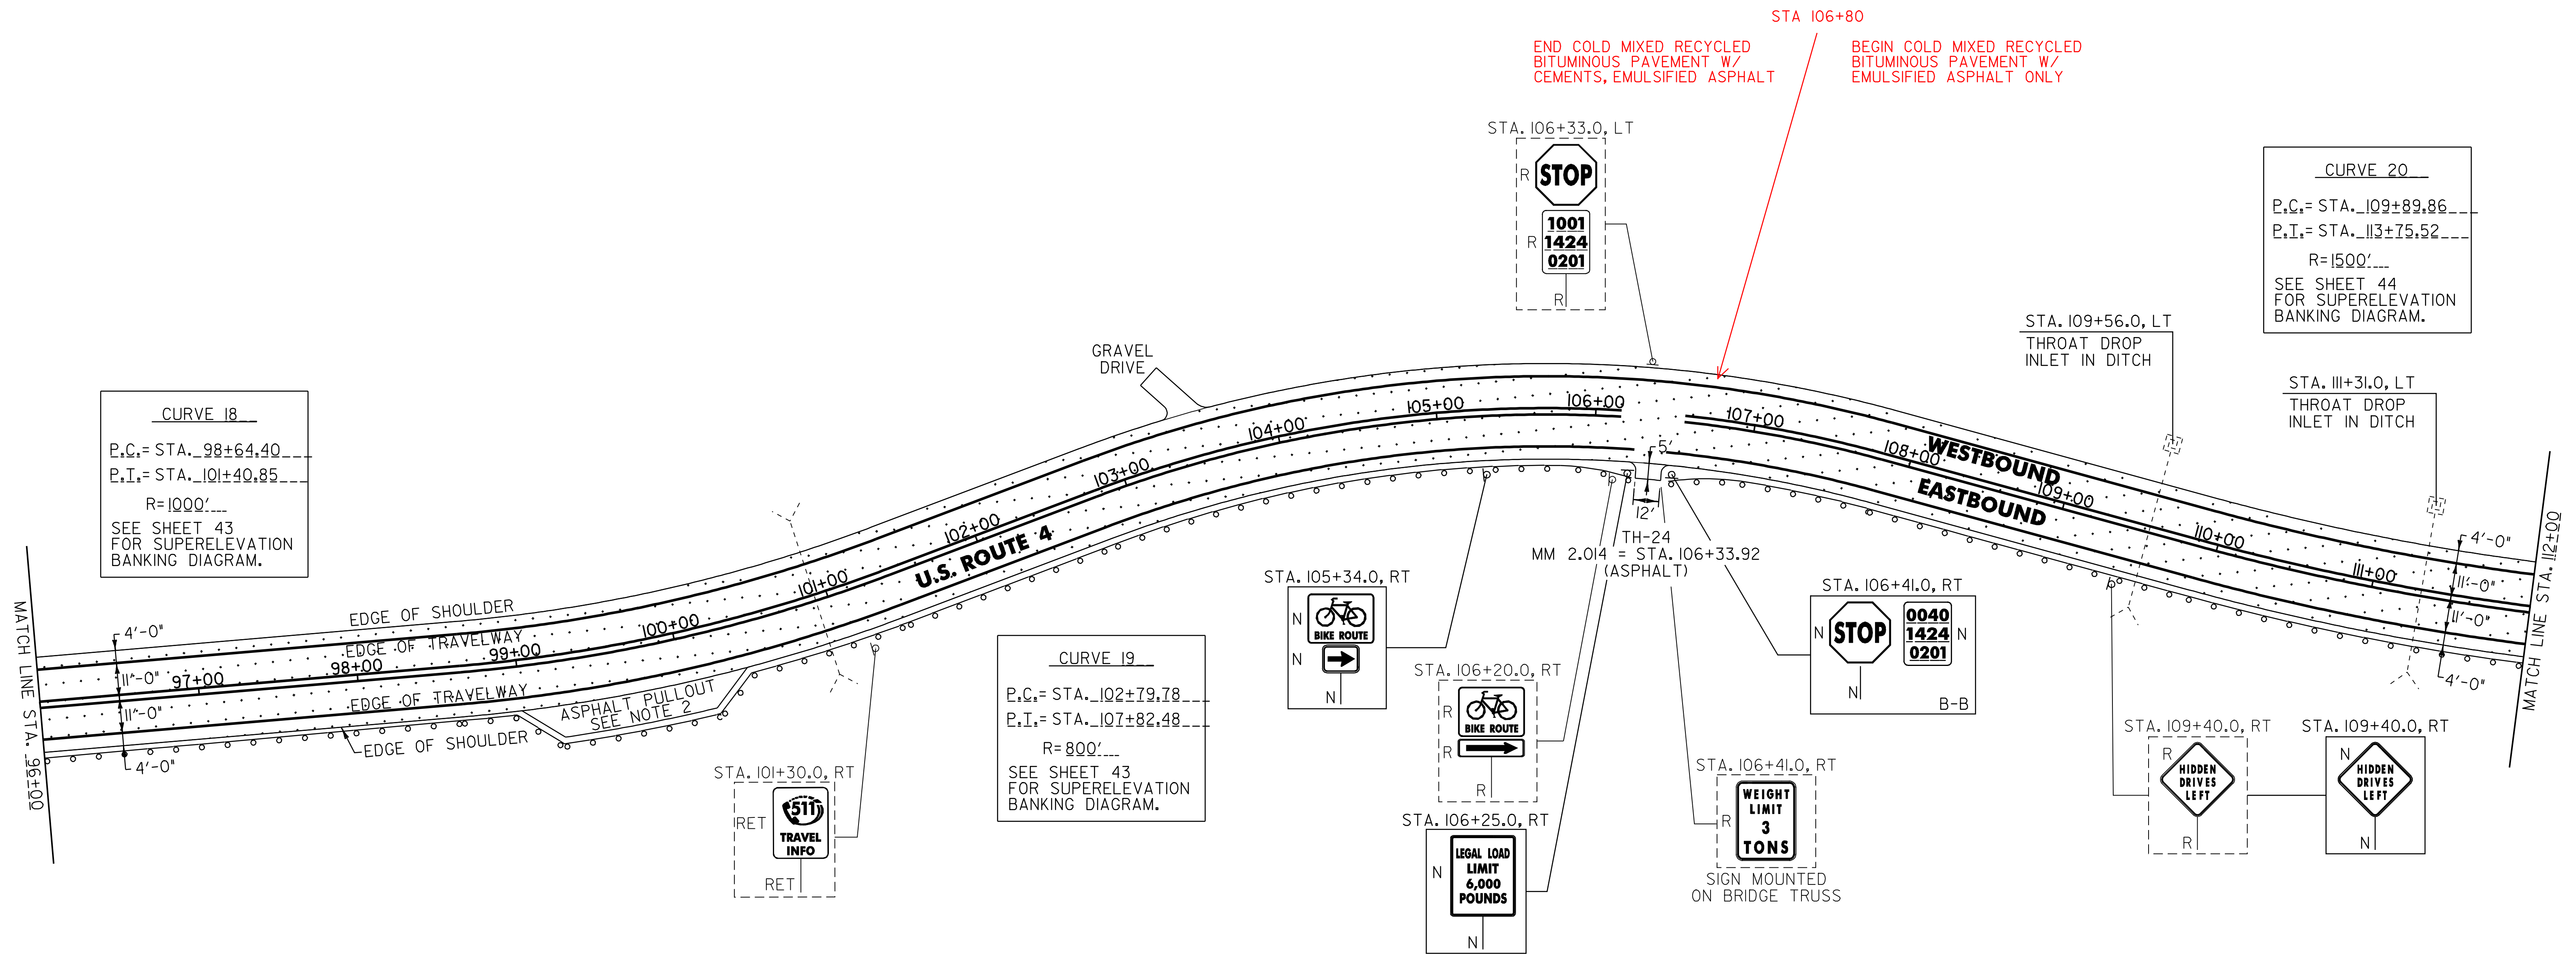

604.412 REHAB. DROP INLETS, CATCH BASINS OR MANHOLE, CLASS I
 WOODSTOCK:
 STA. 109+56.0 LT
 STA. 111+31.0 LT

621.205 STEEL BEAM GUARDRAIL, GALVANIZED W/8 FEET POSTS

WOODSTOCK:
 STA. 96+00.0 - STA. 105+74.0 RT (974.0 LF)
 STA. 106+92.0 - STA. 112+00.0 RT (508.0 LF) 520.5
 79.5

621.51 MANUFACTURED TERMINAL SECTION, TANGENT (FLARED)


WOODSTOCK:
~~STA. 105+74.0 - STA. 106+24.0 RT~~
~~STA. 106+42.0 - STA. 106+92.0 RT~~
 79.5

ANCHOR FOR STEEL BEAM GUARDRAIL
 106+24 RT

621.80 REMOVAL AND DISPOSAL OF GUARDRAIL

WOODSTOCK:
 STA. 96+00.0 - STA. 106+24.0 RT (1024.0 LF)
 STA. 106+42.0 - STA. 112+00.0 RT (558.0 LF)

LEGEND

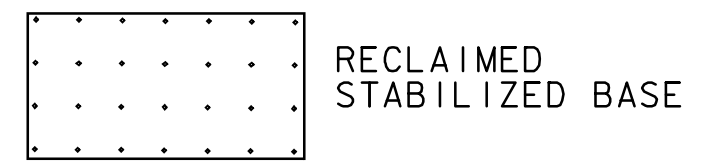

SIGN LEGEND

R = REMOVE
 S = SALVAGE
 N = NEW
 RET = RETAIN
 B-B = BACK TO BACK
 EXISTING = -----
 NEW = -----

NOTES:

- PAVING LIMIT ON ALL TOWN HIGHWAYS SHALL BE MEASURED 25 FT BACK FROM U.S. ROUTE 4 EDGE OF SHOULDER UNLESS DENOTED OTHERWISE ON THE PLANS OR AS DIRECTED BY THE RESIDENT ENGINEER.
- PROVIDE A 5 FT WIDE, 1 3/4" TYPE III APRON FOR THE EXISTING ASPHALT PULLOUT. ANY REQUIRED EXCAVATION SHALL BE PERFORMED AS DIRECTED BY THE RESIDENT ENGINEER AND PAID FOR UNDER ITEM 608.25 ALL PURPOSE EXCAVATOR RENTAL, TYPE I.

NOT TO SCALE

PROJECT LAYOUT SHEET #13

PROJECT NAME: BRIDGEWATER - WOODSTOCK
 PROJECT NUMBER: NH_2611(1)S

FILE NAME: p06b160.dgn PLOT DATE: 28-MAY-2010
 PROJECT LEADER: D.E.G. DRAWN BY: C.A.K.
 DESIGNED BY: D.W.E. CHECKED BY: D.E.G.
 IPARM FILE: p06b160i13.i SHEET 24 OF 80