


646.402 DURABLE 4 INCH WHITE LINE, THERMOPLASTIC
 (ALL LINES WILL INCLUDE EDGE LINE BREAKS AND RADIUS FOR TOWN HIGHWAYS)
 WOODSTOCK:
 STA. 112+00.00 - STA. 128+00.00 LT & RT

646.412 DURABLE 4 INCH YELLOW LINE, THERMOPLASTIC
 (ALL LINES WILL INCLUDE C/L BREAKS FOR TOWN HIGHWAYS) S=SOLID, D=DASHED
 WOODSTOCK:
 STA. 112+00.00 - STA. 128+00.00 LT C RT
 S - S

646.602 TEMPORARY 4 INCH WHITE LINE, PAINT
 (ALL LINES WILL INCLUDE EDGE LINE BREAKS AND RADIUS FOR TOWN HIGHWAYS)
 WOODSTOCK:
 STA. 112+00.00 - STA. 128+00.00 LT & RT

646.612 TEMPORARY 4 INCH YELLOW LINE, PAINT
 (ALL LINES WILL INCLUDE C/L BREAKS FOR TOWN HIGHWAYS) S=SOLID, D=DASHED
 WOODSTOCK:
 STA. 112+00.00 - STA. 128+00.00 LT C RT
 S - S

675.50 REMOVING SIGNS
 AS SHOWN - 6

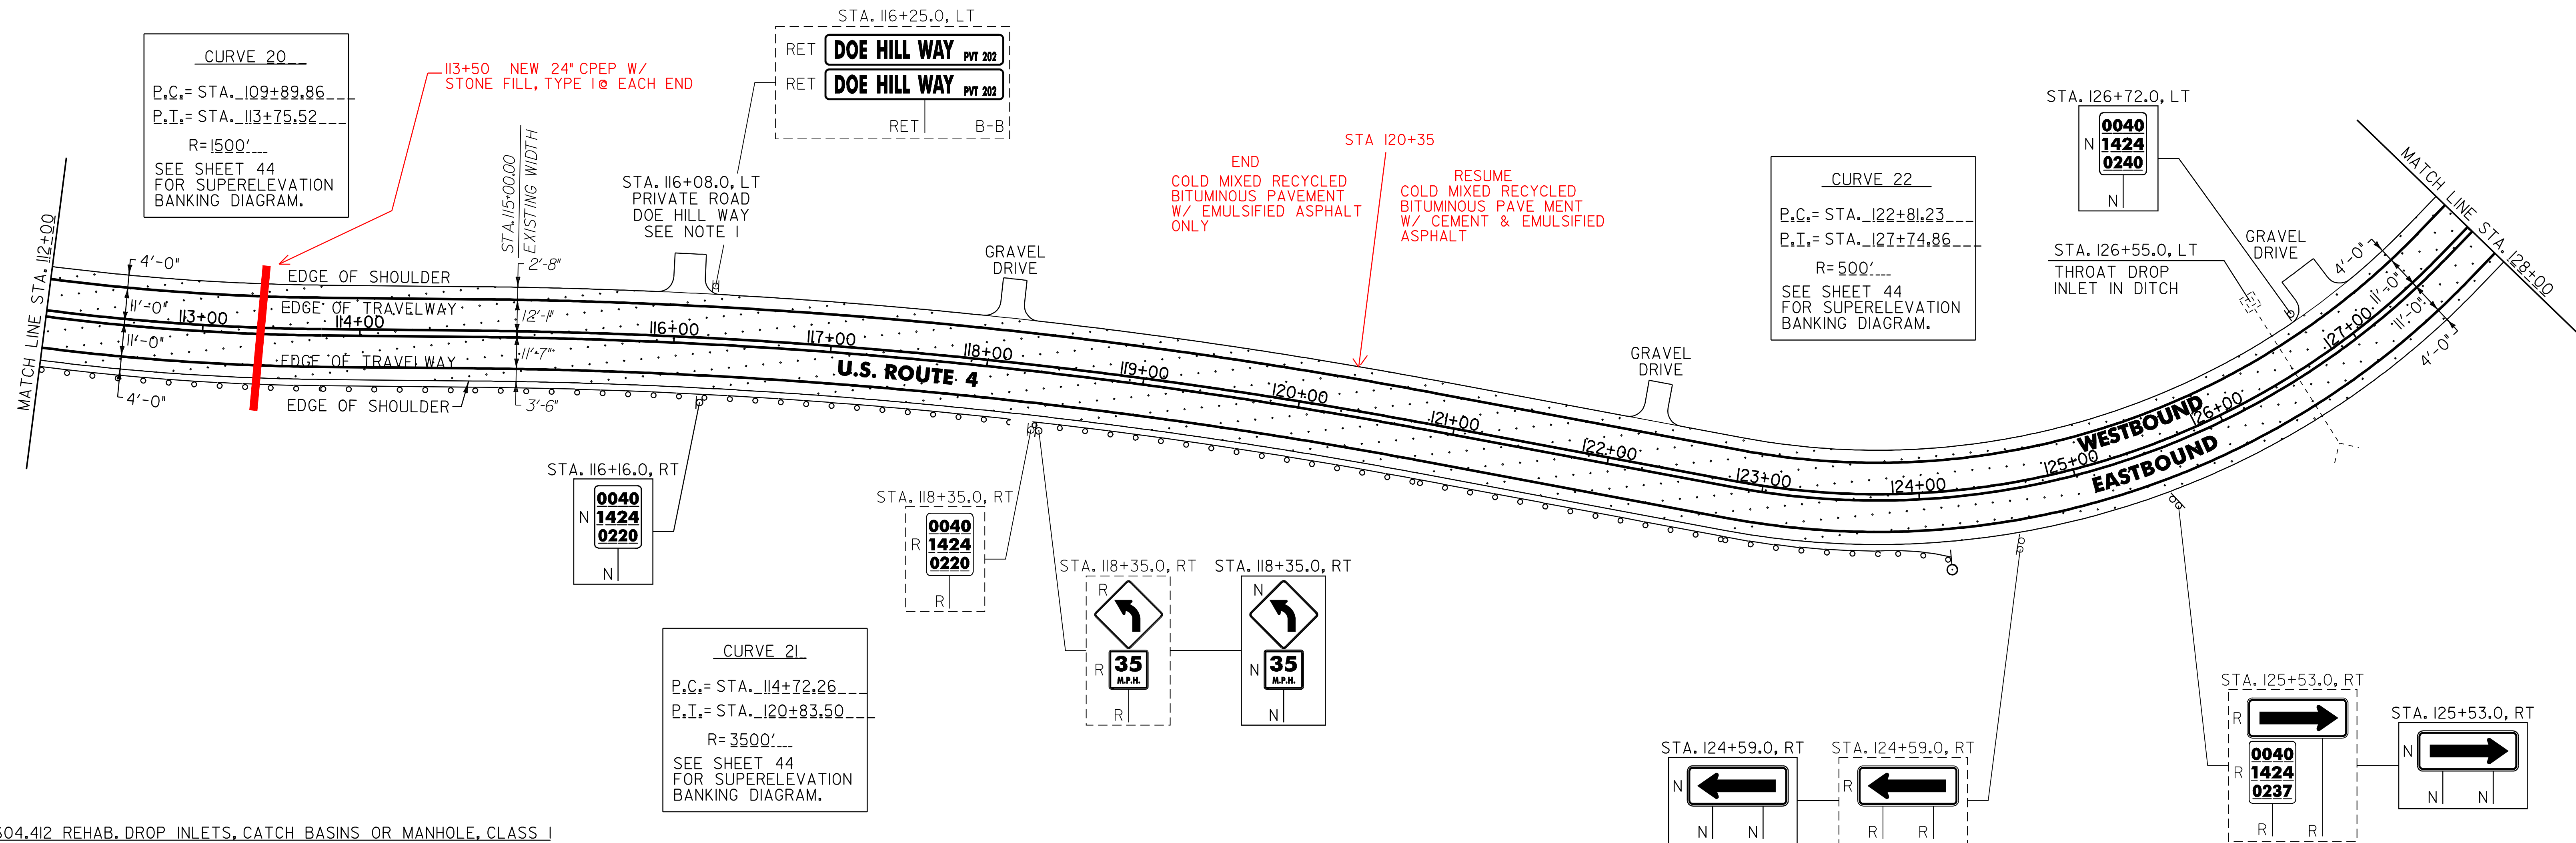

604.412 REHAB. DROP INLETS, CATCH BASINS OR MANHOLE, CLASS I

WOODSTOCK:
 STA. 126+55.0 LT

621.205 STEEL BEAM GUARDRAIL, GALVANIZED W/8 FEET POSTS

WOODSTOCK:
 STA. 112+00.0 - STA. 123+79.5 RT (1179.5 LF) (1217)

~~621.50 MANUFACTURED TERMINAL SECTION, FLARED ANCHOR FOR STEEL BEAM GUARDRAIL~~

WOODSTOCK:
~~STA. 123+79.5 - STA. 124+17.0 RT~~

621.80 REMOVAL AND DISPOSAL OF GUARDRAIL

WOODSTOCK:
 STA. 112+00.0 - STA. 124+17.0 RT (1217.0 LF)

676.10 DELINEATOR WITH STEEL POST


TYPE 1 WHITE

WOODSTOCK:
 STA. 124+17.0 RT

NOTES:

- PROVIDE A 15 FT WIDE, 1 3/4" TYPE III APRON FOR THE EXISTING PRIVATE ROAD. ANY REQUIRED EXCAVATION SHALL BE PERFORMED AS DIRECTED BY THE RESIDENT ENGINEER AND PAID FOR UNDER ITEM 608.25 ALL PURPOSE EXCAVATOR RENTAL, TYPE I.

LEGEND

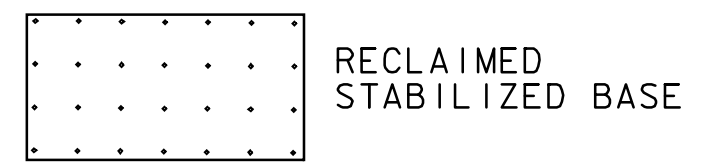

SIGN LEGEND

- R = REMOVE
- S = SALVAGE
- N = NEW
- RET = RETAIN
- B-B = BACK TO BACK
- EXISTING = - - - - -
- NEW = _____

NOT TO SCALE

PROJECT LAYOUT SHEET #14

PROJECT NAME: BRIDGEWATER - WOODSTOCK	PLOT DATE: 28-MAY-2010
PROJECT NUMBER: NH_2611(S)	DRAWN BY: C.A.K.
FILE NAME: p06b160.dgn	CHECKED BY: D.E.G.
DESIGNED BY: D.W.E.	SHEET 25 OF 80
IPARM FILE: p06b16014.i	