

646.402 DURABLE 4 INCH WHITE LINE, THERMOPLASTIC
 (ALL LINES WILL INCLUDE EDGE LINE BREAKS AND RADIUS FOR TOWN HIGHWAYS)
 WOODSTOCK:
 STA. 128+00.00 - STA. 144+00.00 LT & RT

646.412 DURABLE 4 INCH YELLOW LINE, THERMOPLASTIC
 (ALL LINES WILL INCLUDE C/L BREAKS FOR TOWN HIGHWAYS) S=SOLID, D=DASHED
 WOODSTOCK:
 STA. 128+00.00 - STA. 144+00.00 LT C RT
 STA. 142+03.20 DOUBLE SOLID LT, TH-28 S - S

646.482 DURABLE 24 INCH STOP BAR, THERMOPLASTIC
 WOODSTOCK:
 STA. 142+03.20 LT, TH-28


646.492 DURABLE LETTER OR SYMBOL, THERMOPLASTIC
 WOODSTOCK:
 STA. 142+03.20 LT, TH-28 "S,T,O,P" (4 EA)

646.602 TEMPORARY 4 INCH WHITE LINE, PAINT
 (ALL LINES WILL INCLUDE EDGE LINE BREAKS AND RADIUS FOR TOWN HIGHWAYS)
 WOODSTOCK:
 STA. 128+00.00 - STA. 144+00.00 LT & RT

646.612 TEMPORARY 4 INCH YELLOW LINE, PAINT
 (ALL LINES WILL INCLUDE C/L BREAKS FOR TOWN HIGHWAYS) S=SOLID, D=DASHED
 WOODSTOCK:
 STA. 128+00.00 - STA. 144+00.00 LT C RT
 S - S

675.50 REMOVING SIGNS
 AS SHOWN - 7

675.60 ERECTING SALVAGED SIGNS
 AS SHOWN - 2

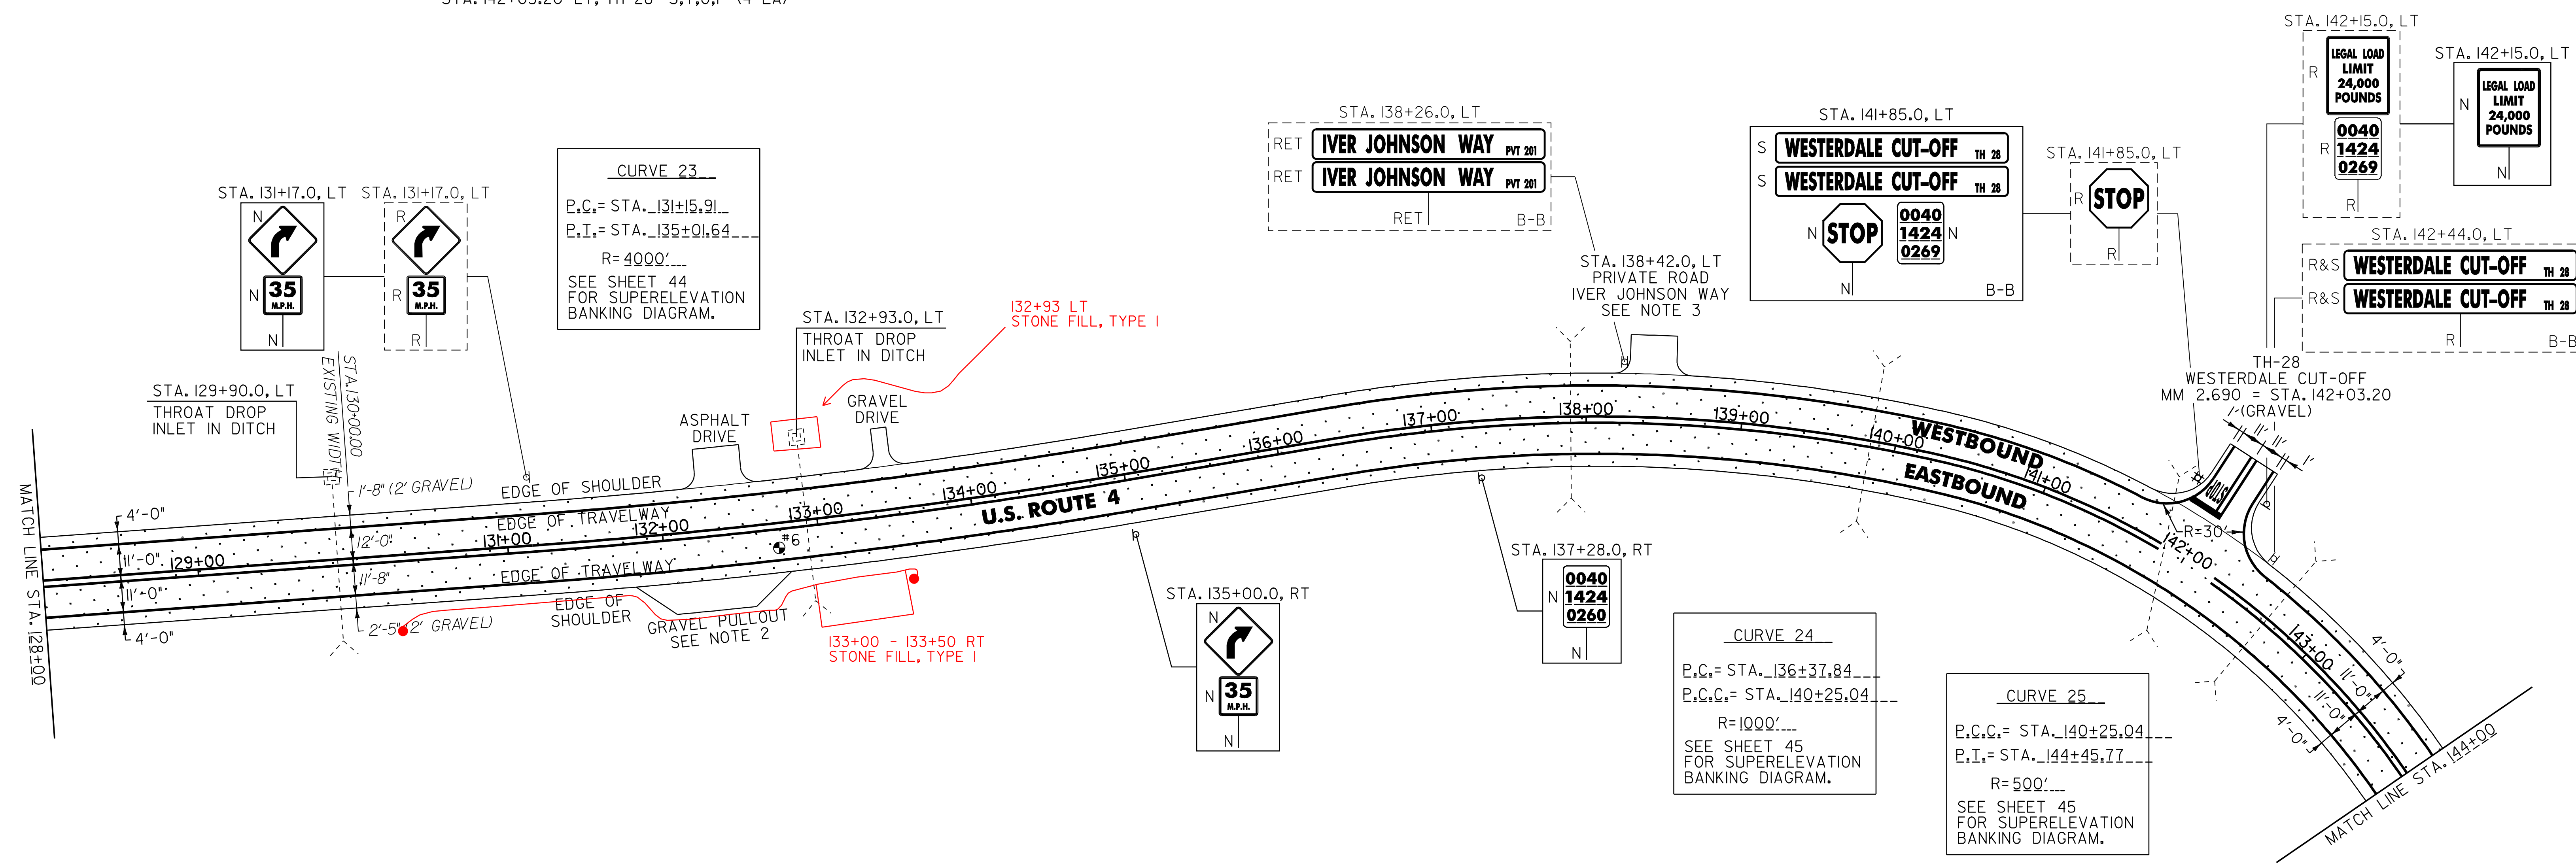

NOTES:


- PAVING LIMIT ON ALL TOWN HIGHWAYS SHALL BE MEASURED 25 FT BACK FROM U.S. ROUTE 4 EDGE OF SHOULDER UNLESS DENOTED OTHERWISE ON THE PLANS OR AS DIRECTED BY THE RESIDENT ENGINEER.
- PROVIDE A 5 FT WIDE, 1 3/4" TYPE IIIS APRON FOR THE EXISTING GRAVEL PULLOUT. ANY REQUIRED EXCAVATION SHALL BE PERFORMED AS DIRECTED BY THE RESIDENT ENGINEER AND PAID FOR UNDER ITEM 608.25 ALL PURPOSE EXCAVATOR RENTAL, TYPE I.
- PROVIDE A 15 FT WIDE, 1 3/4" TYPE IIIS APRON FOR THE EXISTING PRIVATE ROAD. ANY REQUIRED EXCAVATION SHALL BE PERFORMED AS DIRECTED BY THE RESIDENT ENGINEER AND PAID FOR UNDER ITEM 608.25 ALL PURPOSE EXCAVATOR RENTAL, TYPE I.

STEEL BEAM GUARDRAIL, GALV. W/ 8' POSTS
 130+04.5 - 133+39.5 RT (337.5')

MANUFACTURED TERMINAL SECTION, FLARED
 129+67 - 130+04.5 RT
 133+39.5 - 133+77 RT

604.412 REHAB. DROP INLETS, CATCH BASINS OR MANHOLE, CLASS I
 WOODSTOCK:
 STA. 129+90.0 LT
 STA. 132+93.0 LT

LEGEND

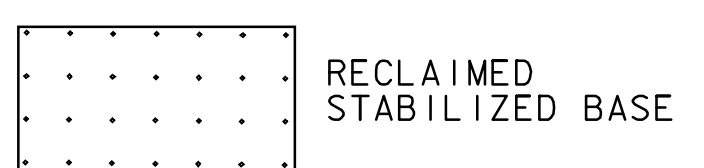

SIGN LEGEND
 R = REMOVE
 S = SALVAGE
 N = NEW
 RET = RETAIN
 B-B = BACK TO BACK
 EXISTING = -----
 NEW = _____

PAVEMENT CORES = ●

#	DEPTH (INCH)	PCC	COMMENTS
6	10 1/2	NO	

NOT TO SCALE

PROJECT LAYOUT SHEET #15

PROJECT NAME: BRIDGEWATER - WOODSTOCK	PLOT DATE: 28-MAY-2010
PROJECT NUMBER: NH_2611(1)S	DRAWN BY: C.A.K.
FILE NAME: p06b160.dgn	CHECKED BY: D.E.G.
DESIGNED BY: D.W.E.	SHEET 26 OF 80
IPARM FILE: p06b160i15.i	