

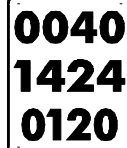




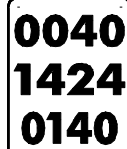


TRAFFIC SIGN SUMMARY SHEET 11

MILEMARKER, STATION, OR SIGN NUMBER	SIGN LEGEND	SIGN DIMENSIONS		NEW & SALVAGED SIGNS				EXIST POST		NEW SIGN POSTS																REMARKS	SIGN DETAIL					
		E A	WIDTH (In)	HEIGHT (In)	"A"	"B"	SALV SIGN	SALV TIS	RETA IN	SALV AGE	NO. OF POSTS	FLANGED CHANNEL			SQUARE STEEL (In)				TUBULAR ALUMINUM Ø (In)			TUBULAR STEEL Ø (In)					W-SHAPE STEEL			REQUI RE	DETAIL ON DWG. NUMBER	STD. SHEET NUMBER
												lb/ft	1.75	2.0	2.5	3.0	4.0	4.0 MOD	FOUND- ATION	3.0	3.5	4.0	5.0	FTG. SIZE			WEIGHT	POST SIZE				
																								1.12	2.0				3.0			

OPTION ITEMS																																
WOODSTOCK: 61+35.4, RT	 	I	48	36	5.56						2			X																SIGNS SHALL BE MOUNTED ON TWO FLANGED CHANNEL POSTS, BACK-TO-BACK SIGN ID CODE W14-3 SIGN ID CODE R4-1		E-152 E-141
63+36.0, RT		I	6	10	0.42						I	X			X															SIGN ID CODE VD-700		E-138
68+11.2, LT		I	30	30	6.25						I			X		X														SIGN ID CODE VR-417		E-141
72+49.0, RT	 	I	24	24	4.00						I			X		X														BACK-TO-BACK SIGN ID CODE VR-654 SIGN ID CODE VR-654		E-143 E-143
73+39.2, RT		I	30	30	6.25						I			X		X														SIGN ID CODE VR-417		E-141
73+92.0, LT		I	6	10	0.42						I	X			X															SIGN ID CODE VD-700		E-138

FINAL POST LENGTHS ARE TO BE DETERMINED IN THE FIELD. POST SIZES ARE COMPUTED BASED ON INFORMATION FURNISHED ON THE STANDARD SHEETS AND THE ROADWAY, TRAFFIC AND SAFETY SECTION'S "SIGN POST DESIGN GUIDELINE."	LF 28.0		LF 42.0 (28.0)		LF 28.0		LF 42.0		EA.	LB LB LB			LB LB LB LB				EA. EA. LB			TRAFFIC SIGN SUMMARY SHEET #11 PROJECT NAME: BRIDGEWATER_-_WOODSTOCK PROJECT NUMBER: NH_2611(1)S FILE NAME: p06b160.dgn_ PROJECT LEADER: D.E.G. DESIGNED BY: D.W.E. IPARM FILE: p06b160tss11.i PLOT DATE: 28-MAY-2010 DRAWN BY: C.A.K. CHECKED BY: D.E.G. SHEET 58 OF 80
	TOTALS	SF 31.90	SF	EA.	SF		LF 70.0 (28.0)	LF 70.0		EA.	LB			EA. EA. LB						