

INDEX OF SHEETS
SEE SHEET 2

STATE OF VERMONT AGENCY OF TRANSPORTATION




PROPOSED IMPROVEMENT TOWNS OF BRIDGEWATER & WOODSTOCK COUNTY OF WINDSOR U.S. ROUTE 4

BEGINNING IN THE TOWN OF BRIDGEWATER ON U.S. ROUTE 4 AT MILE MARKER 6.023 = STA. 318+01.44 AND EXTENDING EASTERLY FOR A DISTANCE OF 37,693.92 FEET (7.139 MILES) TO A POINT IN THE TOWN OF WOODSTOCK AT MILE MARKER 5.650 = STA. 298+32.00.



LENGTH OF ROADWAY 37,693.92 FT (7.139 MILES)
LENGTH OF PROJECT 37,693.92 FT (7.139 MILES)

WORK TO BE PERFORMED UNDER THIS PROJECT INCLUDES COLD PLANING, RECLAIMING, RESURFACING WITH A COLD MIXED RECYCLED PAVEMENT COURSE, BASE COURSE, AND WEARING COURSE, NEW PAVEMENT MARKINGS, DRAINAGE IMPROVEMENTS, GUARDRAIL IMPROVEMENTS, NEW SIGNS AND INCIDENTAL ITEMS.

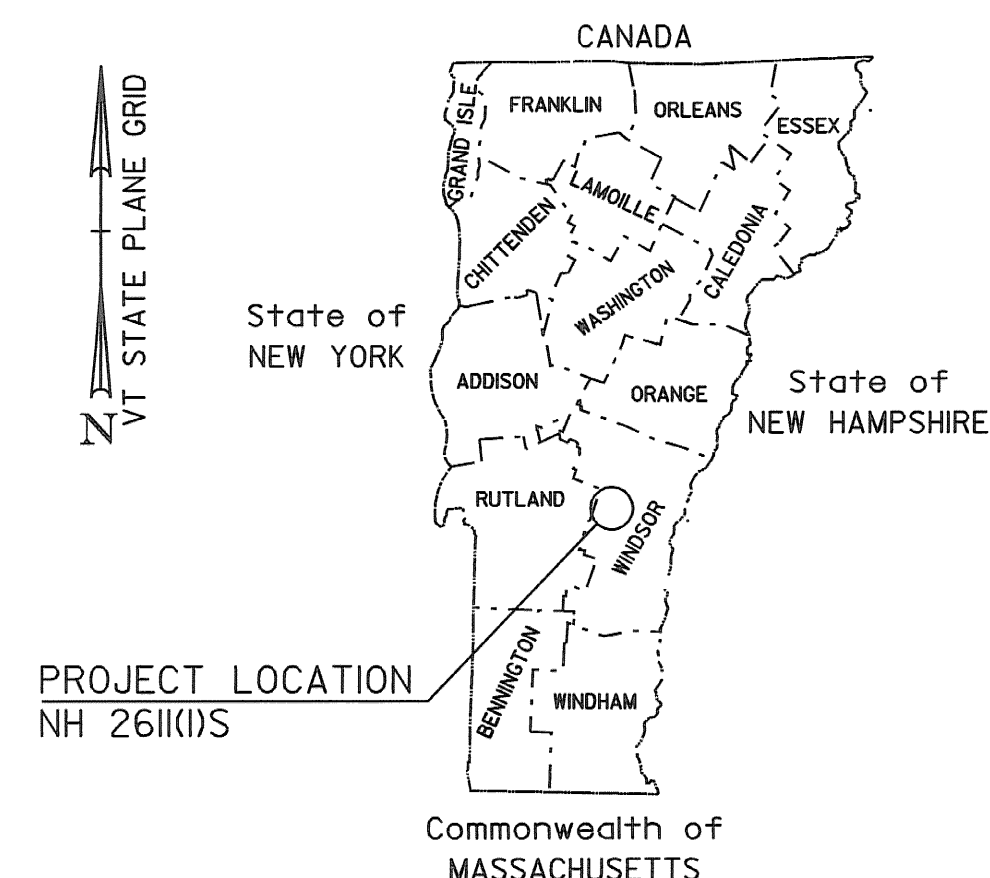

RECORD PLANS	
CONTRACTOR:	FW WHITCOMB CONSTRUCTION CORP. - WALPOLE, NH
RESIDENT ENGINEER:	CHRIS BARKER
CONSTRUCTION BEGAN:	MAY 5, 2008
CONSTRUCTION COMPLETE:	JUNE 25, 2009
RECORD PLANS BY:	CHRIS BARKER & C. PIERCE
I HEREBY CERTIFY THAT ALL THE CONSTRUCTION REQUIRED BY THIS SET OF DRAWINGS HAS BEEN ACCOMPLISHED AS INDICATED HEREIN.	
BY:	<i>Chris Barker</i> RESIDENT ENGINEER
DATE:	04/22/10
NOTE: Any further information concerning final quantities, amounts or other details relative to this project may be found at Central Files in the electronic archives.	

BITUMINOUS CONCRETE PAVEMENT SUPERPAVE MIXTURE DESIGN CRITERIA	
DESIGN LANE/DESIGN LIFE ESALS	2,156,000
DESIGN NUMBER OF GYRATIONS	75
PERFORMANCE GRADED ASPHALT BINDER	64-28

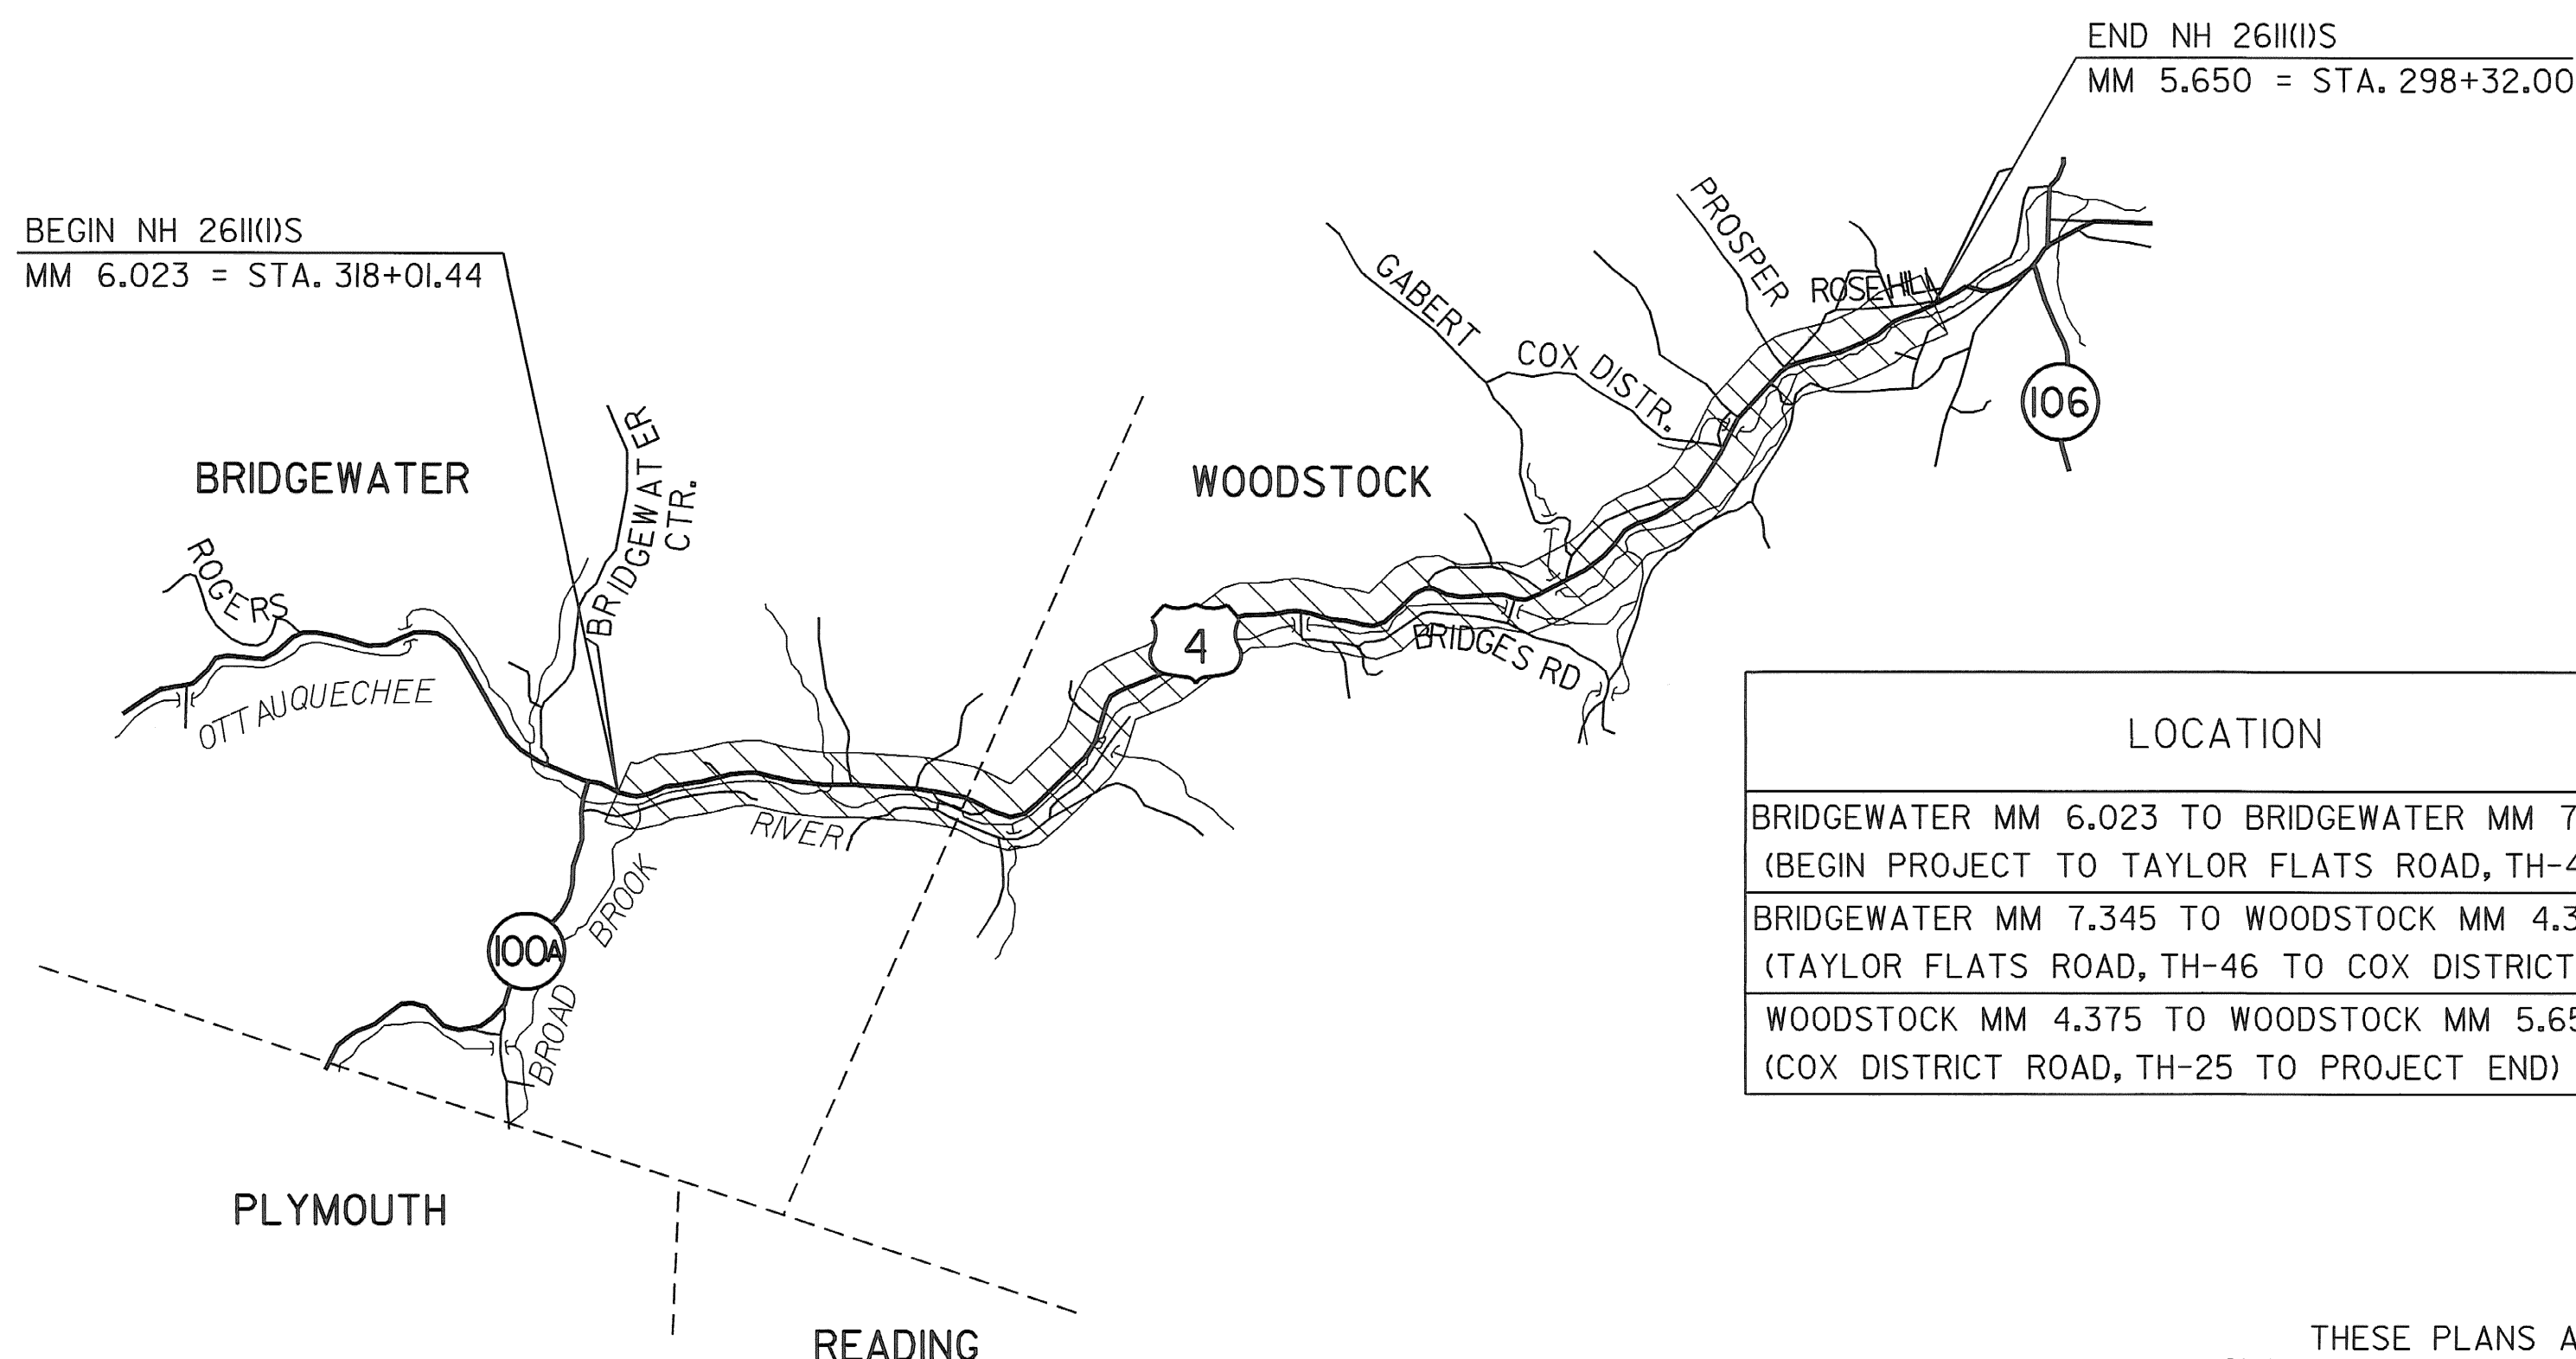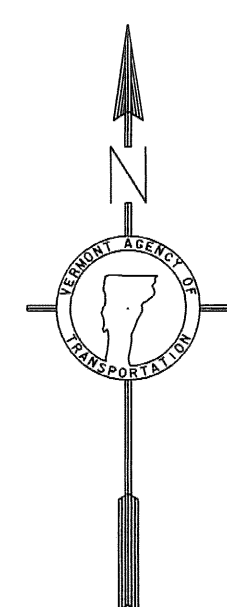

TRAFFIC DATA

LOCATION	ADT			DHV		ESALS	ESALS
	2008	2018	2028	2008	2018	2008-2018	2008-2028
BRIDGEWATER MM 6.023 TO BRIDGEWATER MM 7.345 (BEGIN PROJECT TO TAYLOR FLATS ROAD, TH-46)	6100	6900	7700	770	870	1,839,000	4,272,000
BRIDGEWATER MM 7.345 TO WOODSTOCK MM 4.375 (TAYLOR FLATS ROAD, TH-46 TO COX DISTRICT ROAD, TH-23)	6400	7300	8100	720	820	1,622,000	3,808,000
WOODSTOCK MM 4.375 TO WOODSTOCK MM 5.650 (COX DISTRICT ROAD, TH-25 TO PROJECT END)	9300	10,400	11,600	1000	1200	1,837,000	4,312,000

CONVENTIONAL SYMBOLS

COUNTY LINE	---
TOWN LINE	- - - - -
LIMITS OF ACCESS	○---○---○---○
POINT OF ACCESS	X
FENCE LINE	X---X---X---X
STONE WALL	○---○---○---○
TRAVELED WAY	—
GUARD RAIL	—
RAILROAD	—
SURVEY LINE	—
CULVERT	—
POWER POLE	⊕
TELEPHONE POLE	⊕
TREES	⊕
CONTROL OF ACCESS	—
PROPERTY LINE	—
R.O.W. TAKING LINE	—
SLOPE RIGHTS	○ SR ○ SR ○ SR
TOP OF CUT	△
TOE OF SLOPE	○

PLANS PREPARED BY



CLOUGH HARBOUR & ASSOCIATES LLP
111 Wilkins Circle, PO Box 5289 • Albany, NY 12205-0289
Main: (518) 453-4500 • www.cloughharbour.com

BY:

SURVEYED BY : NA
SURVEYED DATE : NA

DATUM

VERTICAL NA
HORIZONTAL NA

THESE PLANS ARE SUBJECT TO SUCH ENGINEERING CHANGES AS MAY BE REQUIRED BY THE FEDERAL HIGHWAY ADMINISTRATION OR THE DIRECTOR OF PROGRAM DEVELOPMENT.
CONSTRUCTION IS TO BE CARRIED ON IN ACCORDANCE WITH THESE PLANS AND THE STANDARD SPECIFICATIONS FOR CONSTRUCTION DATED 2006, AS APPROVED BY THE FEDERAL HIGHWAY ADMINISTRATION ON JUNE 15, 2006 FOR USE ON THIS PROJECT, INCLUDING ALL SUBSEQUENT REVISIONS AND SUCH REVISED SPECIFICATIONS AND SPECIAL PROVISIONS AS ARE INCORPORATED IN THESE PLANS.

DIRECTOR OF PROGRAM DEVELOPMENT
APPROVED: <i>Ted Domey</i> DATE 10-11-07
PROJECT MANAGER : TED DOMEY
PROJECT NAME : BRIDGEWATER - WOODSTOCK PROJECT NUMBER : NH 2611 (1) S
SHEET 1 OF 80 SHEETS

NOTES

1. THE WEARING COURSE SHALL BE TYPE IIIS SUPERPAVE BITUMINOUS CONCRETE PAVEMENT. THE BASE COURSE SHALL BE TYPE IVS SUPERPAVE BITUMINOUS CONCRETE PAVEMENT. ASPHALT CEMENT USED IN THE SUPERPAVE BITUMINOUS CONCRETE PAVEMENT SHALL BE PG 64-28.
2. EMULSIFIED ASPHALT, TYPE RS-1, SHALL BE APPLIED ON ALL EXISTING PAVEMENT SURFACES, BETWEEN ALL COURSES OF PAVEMENT (NOT INCLUDING RECLAIMED SURFACES) AT THE RATE OF 0.025 GAL/SY OR AS DIRECTED BY THE RESIDENT ENGINEER. EMULSIFIED ASPHALT, TYPE RS-1, SHALL BE APPLIED TO THE FINE GRADED RECLAIMED SURFACE FOR THE PURPOSE OF DUST CONTROL AT A RATE OF 0.10 TO 0.15 GAL/SY. QUANTITIES OF EMULSIFIED ASPHALT TO BE USED FOR DUST CONTROL HAVE BEEN ESTIMATED AT 0.125 GAL/SY. PAYMENT WILL BE UNDER ITEM 404.65, EMULSIFIED ASPHALT.
3. SUPERPAVE BITUMINOUS CONCRETE PAVEMENT TOLERANCE = +/- 1/4" (TOTAL PAVEMENT THICKNESS EXCLUDING LEVELING).
4. THE PORTLAND CEMENT STABILIZED COLD MIX SHALL BE PRODUCED FROM THE COLD PLANE GRINDINGS GENERATED FROM THE PROJECT AND PAID FOR UNDER ITEM 900.675 SPECIAL PROVISION (COLD MIXED RECYCLED BITUMINOUS PAVEMENT, PORTLAND CEMENT), IF THERE IS NOT A SUFFICIENT AMOUNT OF COLD PLANE GRINDINGS AVAILABLE TO PRODUCE THE 4" LIFT OF PORTLAND CEMENT STABILIZED COLD MIX, THE CONTRACTOR SHALL OBTAIN COLD PLANE GRINDINGS FROM ANOTHER SOURCE. THE COST ASSOCIATED WITH PROVIDING ADDITIONAL COLD PLANE GRINDINGS SHALL BE INCIDENTAL TO ITEM 900.675. ALL COLD PLANING PERFORMED WITHIN THE LIMITS OF THE PORTLAND CEMENT STABILIZED BASE SHALL BE CONSIDERED INCIDENTAL TO ITEM 900.675 SPECIAL PROVISION (COLD MIXED RECYCLED BITUMINOUS PAVEMENT, PORTLAND CEMENT). AN ESTIMATED QUANTITY OF ITEM 900.680 SPECIAL PROVISION (PORTLAND CEMENT FOR COLD MIXED RECYCLING) AT A QUANTITY OF 2% OF (PORTLAND CEMENT FOR COLD MIXED RECYCLING), HAS BEEN INCLUDED.
5. ITEM 415.25 EMULSIFIED ASPHALT, COLD MIX SHALL BE USED AS A LIQUID BINDER IN THE PORTLAND CEMENT STABILIZED COLD MIX AS DIRECTED BY THE RESIDENT ENGINEER. AN ESTIMATED QUANTITY OF EMULSIFIED ASPHALT AT A RATE OF 2.0 GAL/SY HAS BEEN INCLUDED IN THE PLANS.
6. PRIOR TO RECLAIMING, ANY EXISTING SHOULDER MATERIAL DEEMED UNSUITABLE BY THE RESIDENT ENGINEER WILL BE EXCAVATED TO A DEPTH OF RECLAIMING OR AS DIRECTED BY THE RESIDENT ENGINEER. EXCAVATED MATERIAL WILL BE SPREAD ON THE ADJACENT SLOPES OR REMOVED FROM THE PROJECT AS DIRECTED BY THE RESIDENT ENGINEER. THIS WORK WILL BE PAID FOR USING THE APPROPRIATE RENTAL ITEMS. THE METHOD OF REMOVAL AND THE USE OF RENTAL ITEMS SHALL BE APPROVED BY THE RESIDENT ENGINEER PRIOR TO ANY WORK BEING DONE. MATERIAL REMOVED SHALL BE REPLACED WITH ITEM 301.40 SUBBASE, RAP. AN ADDITIONAL QUANTITY OF ITEM 301.40 SUBBASE, RAP HAS BEEN INCLUDED TO CORRECT SUPERELEVATION AND GRADATION DEFICIENCIES WITHIN THE RECLAIMED SECTION. AN ESTIMATED THICKNESS OF 2" HAS BEEN INCLUDED FOR THE ENTIRE RECLAIMED SURFACE AREA. IF THERE IS NOT A SUFFICIENT AMOUNT OF COLD PLANE GRINDINGS AVAILABLE TO COMPLETE THESE REPAIRS, THE CONTRACTOR SHALL OBTAIN COLD PLANE GRINDINGS FROM ANOTHER SOURCE. THE COST ASSOCIATED WITH PROVIDING ADDITIONAL COLD PLANE GRINDINGS SHALL BE INCIDENTAL TO ITEM 301.40 SUBBASE, RAP.
7. PRIOR TO PAVING IN COLD PLANE AREAS, ANY EXISTING SHOULDER MATERIAL DEEMED UNSUITABLE BY THE RESIDENT ENGINEER SHALL BE EXCAVATED TO A DEPTH OF 3" OR AS DIRECTED BY THE RESIDENT ENGINEER. EXCAVATION WILL BE PAID FOR AS ALL PURPOSE EXCAVATOR RENTAL, TYPE I. MATERIAL REMOVED SHALL BE REPLACED WITH SUBBASE OF CRUSHED GRAVEL, FINE GRADED. EXCAVATED MATERIAL SHALL BE SPREAD ON THE ADJACENT SLOPES OR REMOVED FROM THE PROJECT AREA AS DIRECTED BY THE RESIDENT ENGINEER.
8. COLD PLANING SHALL BE COMPLETED ACCORDING TO THE TYPICAL OR AS OTHERWISE NOTED ON THE PLANS. A FULL-DEPTH BUTT JOINT SHALL BE CONSTRUCTED AT THE BEGINNING OF THE PROJECT AND AT ALL SIDE ROAD APPROACHES AS DENOTED ON THE PLANS OR AS OTHERWISE DIRECTED BY THE RESIDENT ENGINEER.
9. ALL EDGES OF PAVEMENT WITHIN THE COLD PLANE SECTION SHALL BE BACKED UP TO FULL HEIGHT WITH COLD PLANE GRINDINGS AS DIRECTED BY THE RESIDENT ENGINEER AND WILL BE PAID FOR UNDER ITEM 402.13 AGGREGATE SHOULDERS, RAP. ADDITIONAL MATERIAL REQUIRED AFTER THE COLD PLANE GRINDINGS HAVE BEEN USED WILL BE PAID FOR UNDER ITEM 402.12 AGGREGATE SHOULDERS.
10. A QUANTITY FOR ITEM 604.412 REHAB. DROP INLETS, CATCH BASINS OR MANHOLES, CLASS I HAS BEEN INCLUDED IN THE QUANTITIES TO BE USED AS DIRECTED BY THE RESIDENT ENGINEER. ALL DI'S SHALL BE RAISED OR REHABILITATED SUCH THAT THE NEW GRATE ELEVATION IS LEVEL WITH THE SURROUNDING TERRAIN.
11. DITCHING MATERIAL OR EARTH BORROW SHALL BE USED FOR THE CONSTRUCTION OF MANUFACTURED TERMINAL FLARES WHICH SHALL BE CAPPED WITH AN ESTIMATED 3" DEPTH OF AGGREGATE SHOULDER, RAP AS DIRECTED BY THE RESIDENT ENGINEER. THE QUANTITIES INCLUDED REFLECT 5 TONS OF AGGREGATE SHOULDER MATERIAL AND 25 CUBIC YARDS OF DITCHING MATERIAL OR EARTH BORROW FOR EACH GUARDRAIL TERMINAL.
12. THE PROPOSED GUARDRAIL SHALL BE INSTALLED IN A LOCATION THAT MAXIMIZES THE DISTANCE FROM THE CENTER OF THE ROAD TO THE FACE OF GUARDRAIL. 3' OF BACKING IS REQUIRED BEHIND THE FACE OF GUARDRAIL WITH 6' POSTS. IF THIS CANNOT BE OBTAINED, THEN 8' POSTS SHALL BE USED.
13. ALL DRIVES, MAILBOX TURNOUTS AND GRAVEL PULLOUTS SHALL RECEIVE A PAVED APRON AS DIRECTED BY THE RESIDENT ENGINEER. ANY AND ALL REQUIRED EXCAVATION OR GRADING IN DRIVE AREAS SHALL BE AS DIRECTED AND WILL BE PAID FOR UNDER THE APPLICABLE RENTAL ITEM(S). IF REQUIRED, A NEW DRIVEWAY SUBBASE SHALL BE CONSTRUCTED AND WILL BE PAID FOR UNDER ITEM 301.28 SUBBASE OF CRUSHED GRAVEL, FINE GRADED. A BITUMINOUS SURFACE SHALL BE CONSTRUCTED AS DIRECTED AND WILL BE PAID FOR UNDER ITEM 490.30 SUPERPAVE BITUMINOUS CONCRETE PAVEMENT (PG 64-28). ESTIMATED QUANTITIES OF THE ABOVE ITEMS HAVE BEEN INCLUDED TO PAY FOR THIS WORK.
14. ITEM 609.10 DUST CONTROL WITH WATER IS AN ESTIMATED QUANTITY TO BE USED AS DUST CONTROL ALONG THE RECLAIMED SECTION. ITEM 609.15 DUST AND ICE CONTROL WITH CALCIUM CHLORIDE IS AN ESTIMATED QUANTITY TO BE USED ON SIDE ROAD APPROACHES WHICH WILL BE PAVED.
15. STABILIZING AGENT FOR THE RECLAIMED STABILIZED BASE WILL BE WATER. PAYMENT SHALL BE CONSIDERED INCIDENTAL TO ITEM 310.20 RECLAIMED STABILIZED BASE.
16. AN ESTIMATED QUANTITY OF ITEM 619.17 YIELDING MARKER POSTS HAS BEEN INCLUDED TO DELINEATE PIPE INLETS, PIPE OUTLETS AND DROP INLETS LOCATED OUTSIDE OF THE PAVEMENT SURFACE OR AS DIRECTED BY THE RESIDENT ENGINEER.
17. ESTIMATED QUANTITIES OF ITEM 613.10 STONE FILL, TYPE I; ITEM 649.31 GEOTEXTILE UNDER STONE FILL; AND ITEM 608.25 ALL PURPOSE EXCAVATOR RENTAL, TYPE I HAVE BEEN INCLUDED TO PROVIDE FOR REPAIR OF EXISTING STONE LINED DRAINAGE OUTLETS OR WASHOUTS LOCATED ALONG THE ROADWAY SIDE SLOPES AS DIRECTED BY THE RESIDENT ENGINEER.
18. PIPE INLET AND OUTLET AREAS OF DITCH CLEANING THROUGHOUT THE PROJECT SHALL BE PERFORMED AT LOCATIONS SPECIFIED ON THE PLANS OR AS DIRECTED BY THE RESIDENT ENGINEER. PAYMENT SHALL BE MADE UNDER THE APPROPRIATE RENTAL ITEM(S).
19. AN ESTIMATED THICKNESS OF 2" OF IEM 301.40 SUBBASE, RAP HAS BEEN INCLUDED FOR THE PROVISION OF IMPROVING GRADATION DEFICIENCIES AND/OR CORRECTING SUPERELEVATION, AS NECESSARY, OR AS DIRECTED BY THE RESIDENT ENGINEER. THIS MATERIAL SHALL BE RECLAIMED INTO THE RECLAIMED STABILIZED BASE. PAYMENT FOR THIS SECOND OPERATION WILL BE OPERATION WILL BE INCIDENTAL TO ITEM 301.40 SUBBASE, RAP.

INDEX OF SHEETS

1	TITLE SHEET
2	INDEX OF SHEETS
3	PROJECT TYPICAL SHEET
4-5	PAVING DETAILS SHEETS
6-7	QUANTITY SHEETS
8-10	ITEM DETAIL SUMMARY SHEETS
11	DITCH CLEANING DETAIL SHEET
12-36	PROJECT LAYOUT SHEETS
37	TH-23/TH-114 INTERSECTION DETAIL SHEET
38	TH-3/TH-81 INTERSECTION DETAIL SHEET
39-47	SUPERELEVATION BANKING DIAGRAMS SHEETS
48-72	TRAFFIC SIGN SUMMARY SHEETS
73-74	TRAFFIC SIGN DETAIL SHEETS
75-78	BRIDGE DETAIL SHEETS
79	MISCELLANEOUS DETAILS SHEET
80	CONSTRUCTION APPROACH SIGNING DETAIL SHEET

INDEX OF SHEETS


VAOT STANDARDS

C-1	01-03-00
D-6	06-01-94
D-9	06-01-94
D-11	06-01-94
D-15	06-01-94
E-100	01-02-04
E-101	05-30-03
E-102	06-30-03
E-102A	05-01-04
E-106	03-01-04
E-107A	08-08-95
E-110	08-08-95
E-111	03-11-97
E-121	08-08-95
E-124	08-08-95
E-125	08-08-95
E-131B	05-30-03
E-134	08-08-95
E-138	05-30-03
E-140	08-30-96
E-141	09-20-95
E-142	09-20-95
E-143	06-15-04
E-145A	12-23-94
E-151	05-01-04
E-152	05-01-04
E-153	05-01-04
E-154	05-01-04
E-155	05-01-04
E-160	05-20-99
E-164	05-20-99
E-191	02-01-99
E-192	10-12-00
E-193	08-18-95
E-198	04-01-05
G-1	01-03-00
G-1D	01-03-00
G-19	11-15-02
SB-R6-82	01-06-95

INDEX OF SHEETS


PROJECT NAME: BRIDGEWATER_-_WOODSTOCK
 PROJECT NUMBER: NH_2611(S)-----

FILE NAME: <u>p06b160.dgn_</u>	PLOT DATE: <u>28-MAY-2010</u>
PROJECT LEADER: <u>D.E.G.</u>	DRAWN BY: <u>C.A.K.</u>
DESIGNED BY: <u>D.W.E.</u>	CHECKED BY: <u>D.E.G.</u>
IPARM FILE: <u>p06b160ind.i</u>	SHEET <u>2</u> OF <u>80</u>

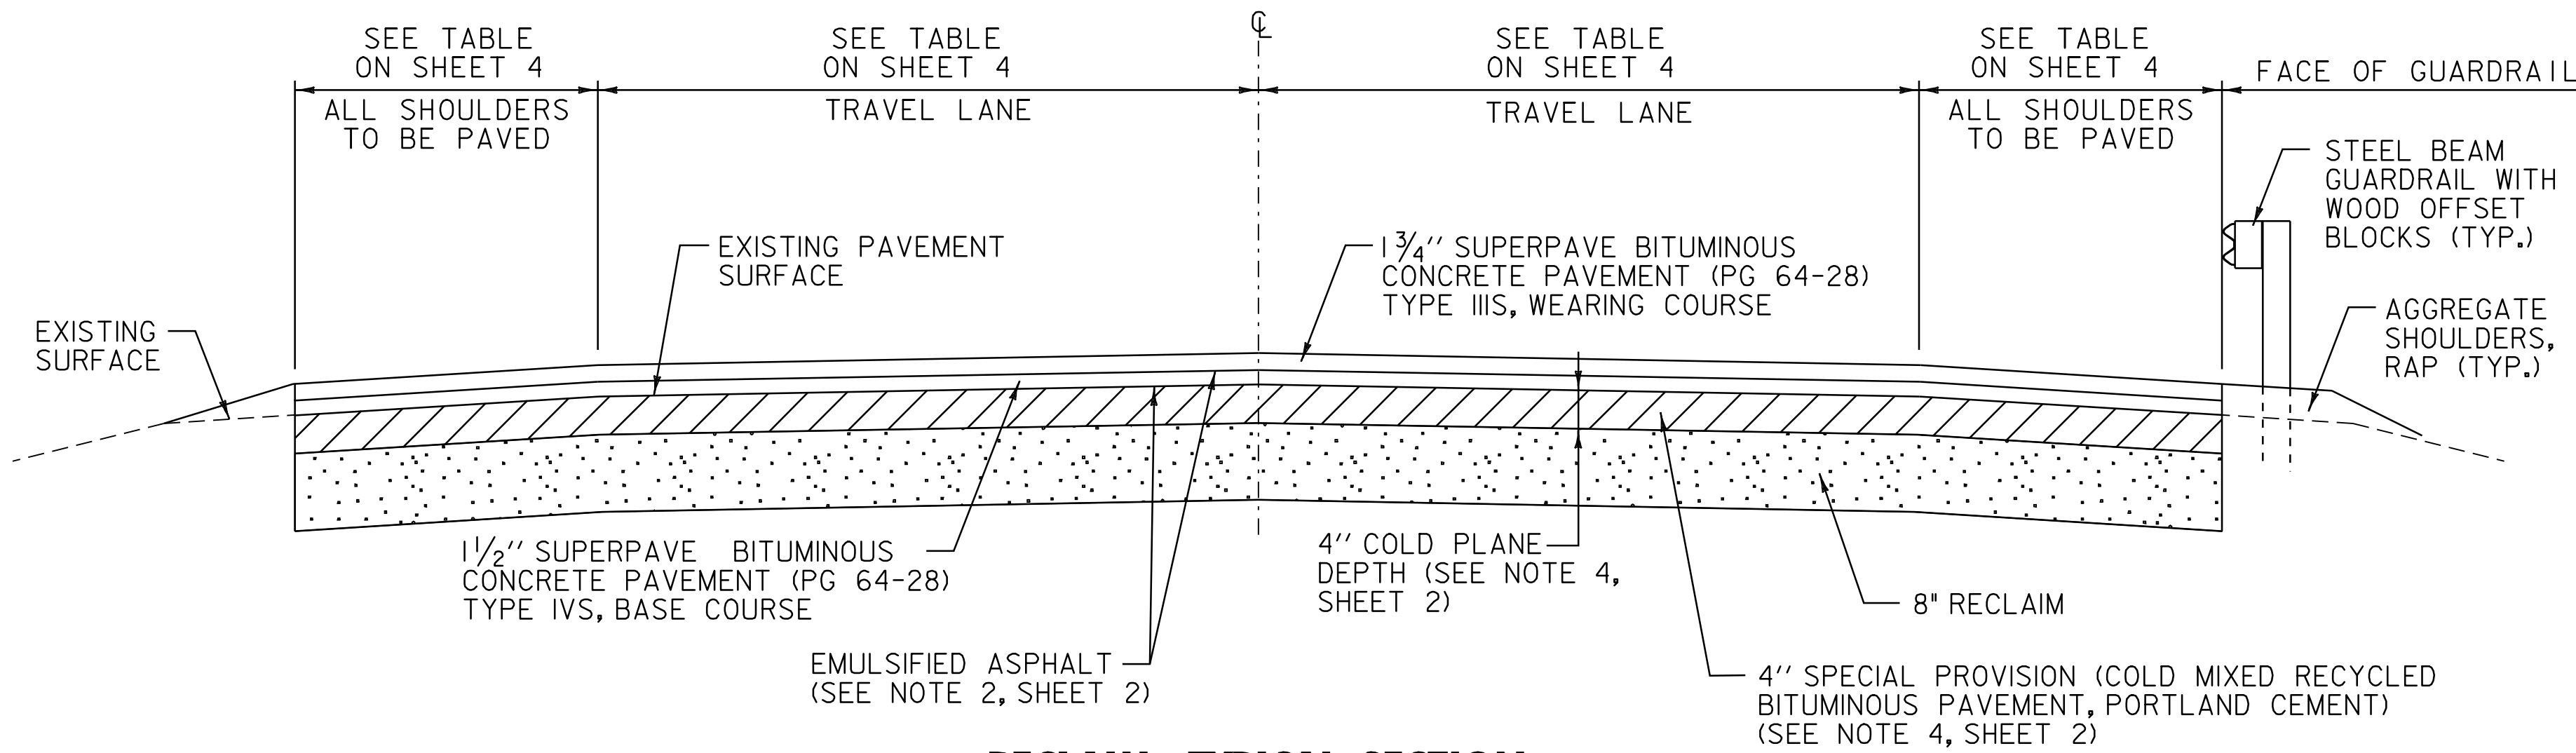


RECLAIM TYPICAL SECTION

U. S. ROUTE 4 BRIDGEWATER STA. 318+01.44 TO BRIDGEWATER STA. 350+59.20
 U. S. ROUTE 4 WOODSTOCK STA. 0+00.00 TO WOODSTOCK STA. 104+54.00
 U. S. ROUTE 4 WOODSTOCK STA. 117+74 TO 211+20.00

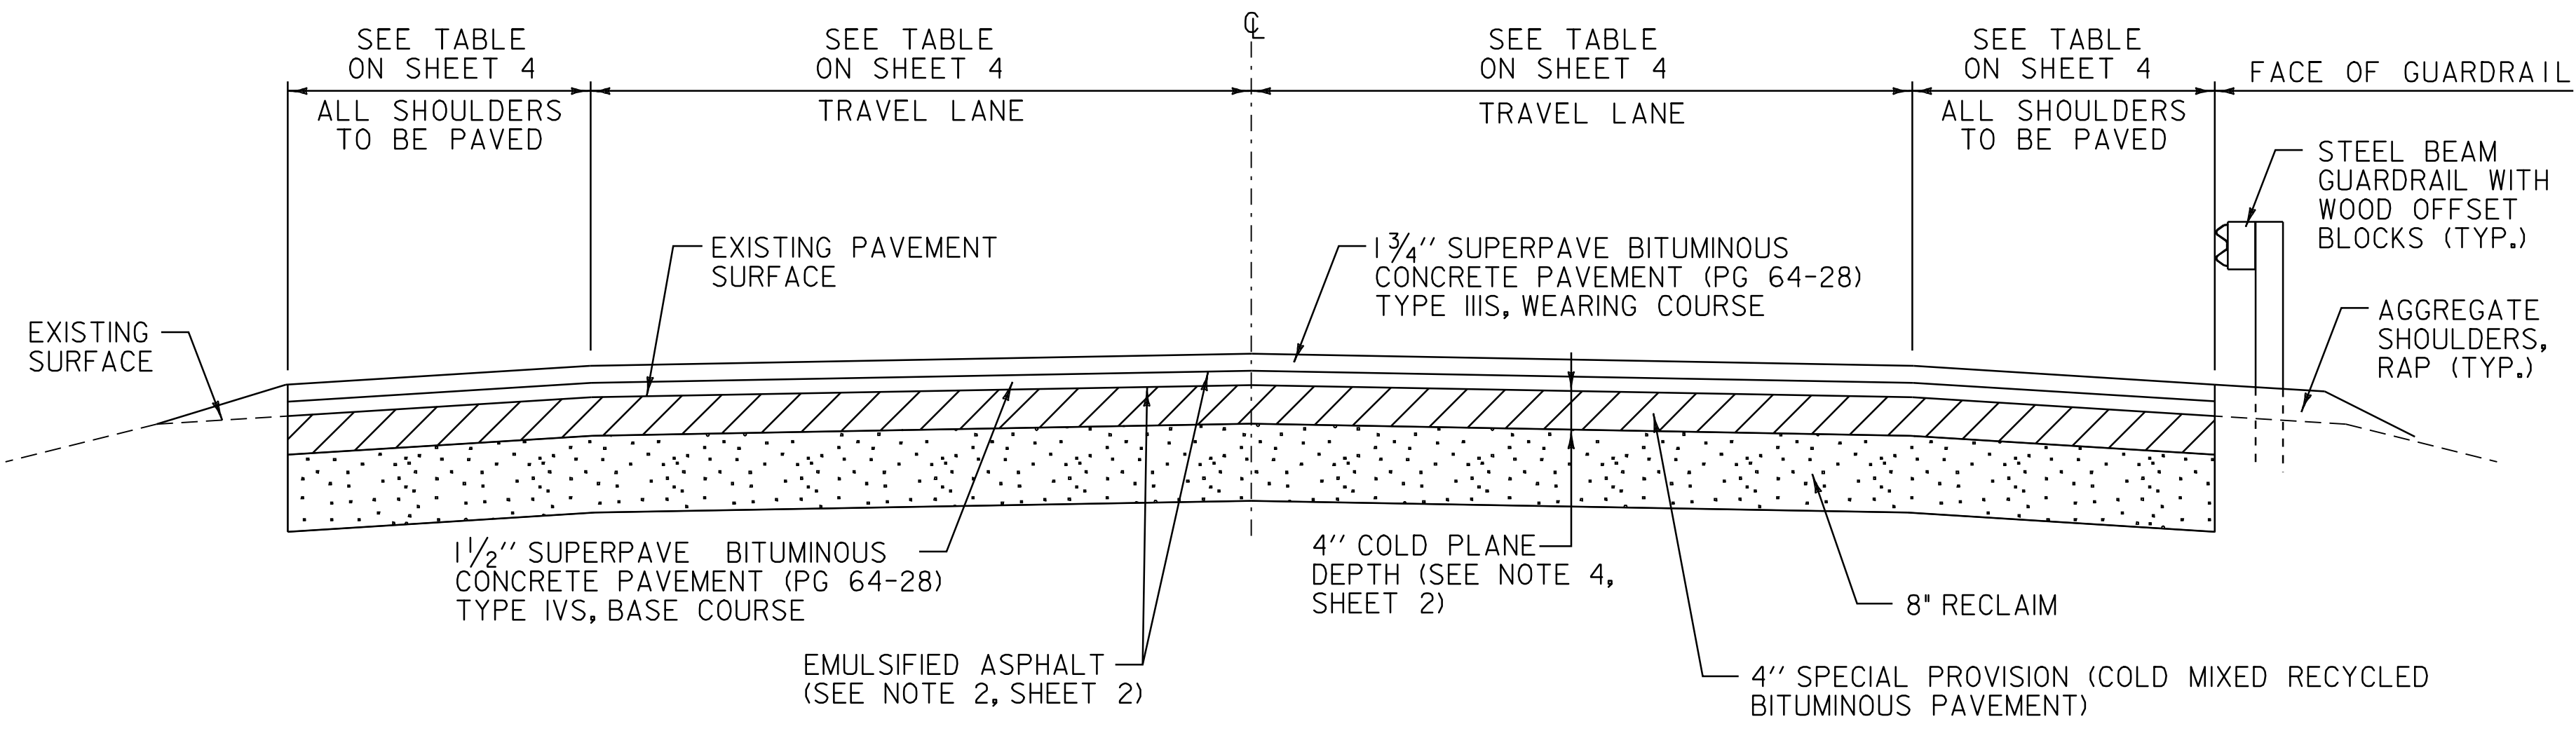

RECLAIM TYPICAL SECTION

U. S. ROUTE 4 WOODSTOCK STA. 104+54.00 TO WOODSTOCK STA. 117+74.00

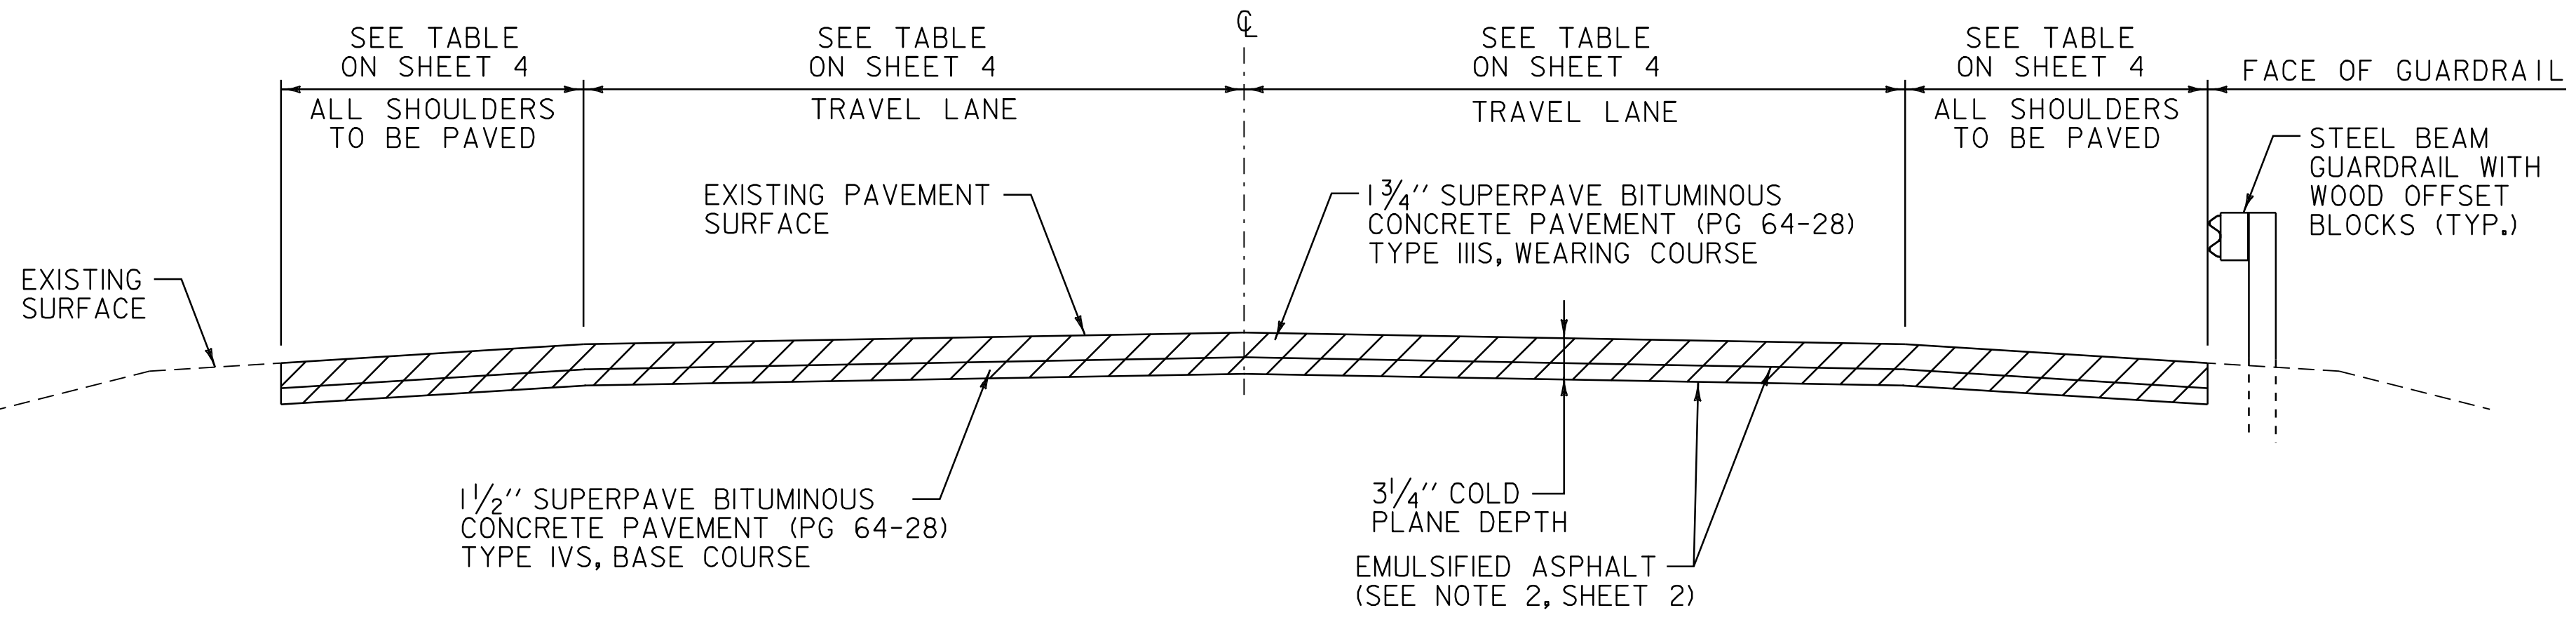

COLD PLANE TYPICAL SECTION

U. S. ROUTE 4 BRIDGEWATER STA. 350+59.20 TO BRIDGEWATER STA. 396+63.36
 U. S. ROUTE 4 WOODSTOCK STA. 211+20.00 TO WOODSTOCK STA. 298+32.00

CONSERVATION SEED MIX

RURAL AREA - SEED MIXTURE				
% WT.	LBS./A.	NAME	PUR. %	GERM. %
37.5	22.5	CREeping RED FESCUE	98	85
37.5	22.5	TALL FESCUE	95	90
5.0	3.0	RED TOP	95	90
15.0	9.0	BIRDSFOOT TREFOIL	98	85
5.0	3.0	ANNUAL RYEGRASS	95	85
100.0	60.0			

SEED MIXTURE:
 SHALL NOT HAVE A WEED CONTENT EXCEEDING 0.40% BY WEIGHT AND SHALL BE FREE OF ALL NOXIOUS WEED SEED.

SEED:
 TO BE APPLIED PER SEEDING FORMULA OR AS DIRECTED BY THE RESIDENT ENGINEER.

FERTILIZER:
 FORMULA 10-20-10 TO BE USED WITH SEED APPLIED AT THE RATE OF 500 LBS/ACRE (HYDRO SEEDERS MAY USE 19-19-19 FORMULA).

AGRICULTURAL LIMESTONE:
 TO BE APPLIED AT THE RATE OF 2 TONS/ACRE OR AS DIRECTED BY THE RESIDENT ENGINEER.


HAY MULCH:
 TO BE APPLIED ON EARTH SLOPES AT THE RATE OF 2 TONS/ACRE OR AS DIRECTED BY THE RESIDENT ENGINEER.

TOPSOIL:
 TO BE USED WITH SEED AS INDICATED ON THE PLANS OR AS DIRECTED BY THE RESIDENT ENGINEER.

NOT TO SCALE


PROJECT TYPICAL SHEET	PROJECT NAME: BRIDGEWATER_-_WOODSTOCK	FILE NAME: p06b160.dgn_	PLOT DATE: 28-MAY-2010
	PROJECT NUMBER: NH_2611(S)	PROJECT LEADER: D.E.G.	DRAWN BY: C.A.K.
	DESIGNED BY: D.W.E.	CHECKED BY: D.E.G.	SHEET 3 OF 80
	IPARM FILE: p06b160ts01_		

BEGIN NH 2611 (1) S
BRIDGEWATER
MM 6.023 = STA. 318+01.44

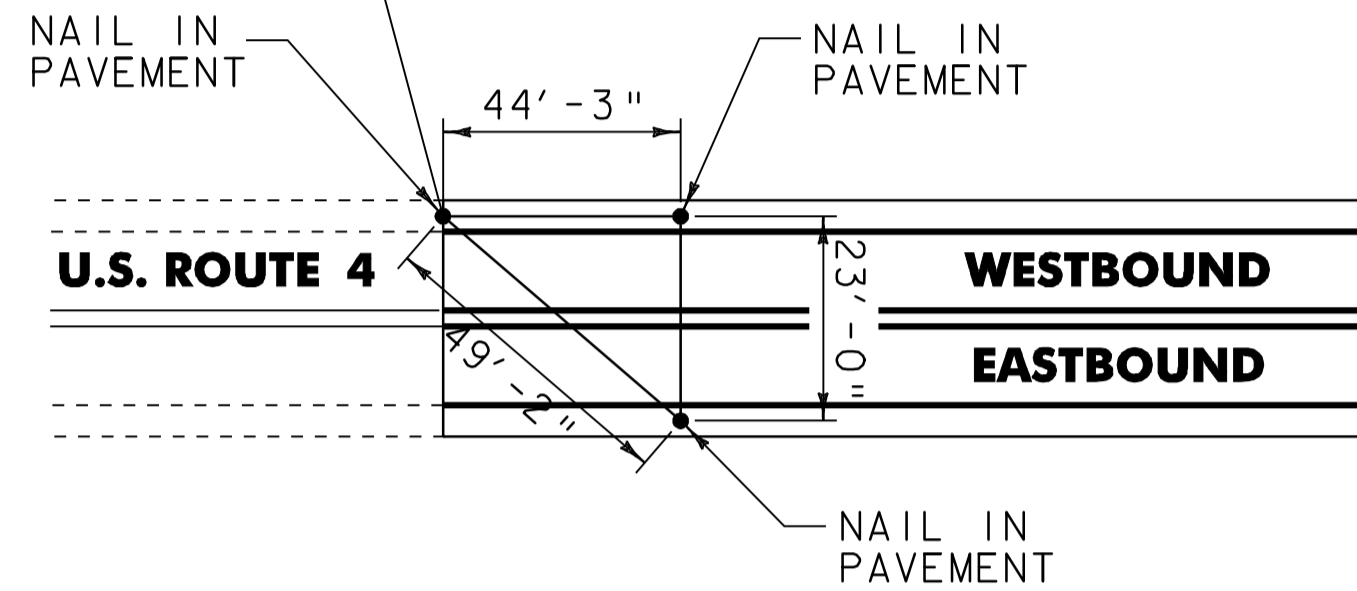

BEGIN PROJECT LOCATION TIES

END NH 2611 (1) S
WOODSTOCK
MM 5.650 = STA. 298+32.00

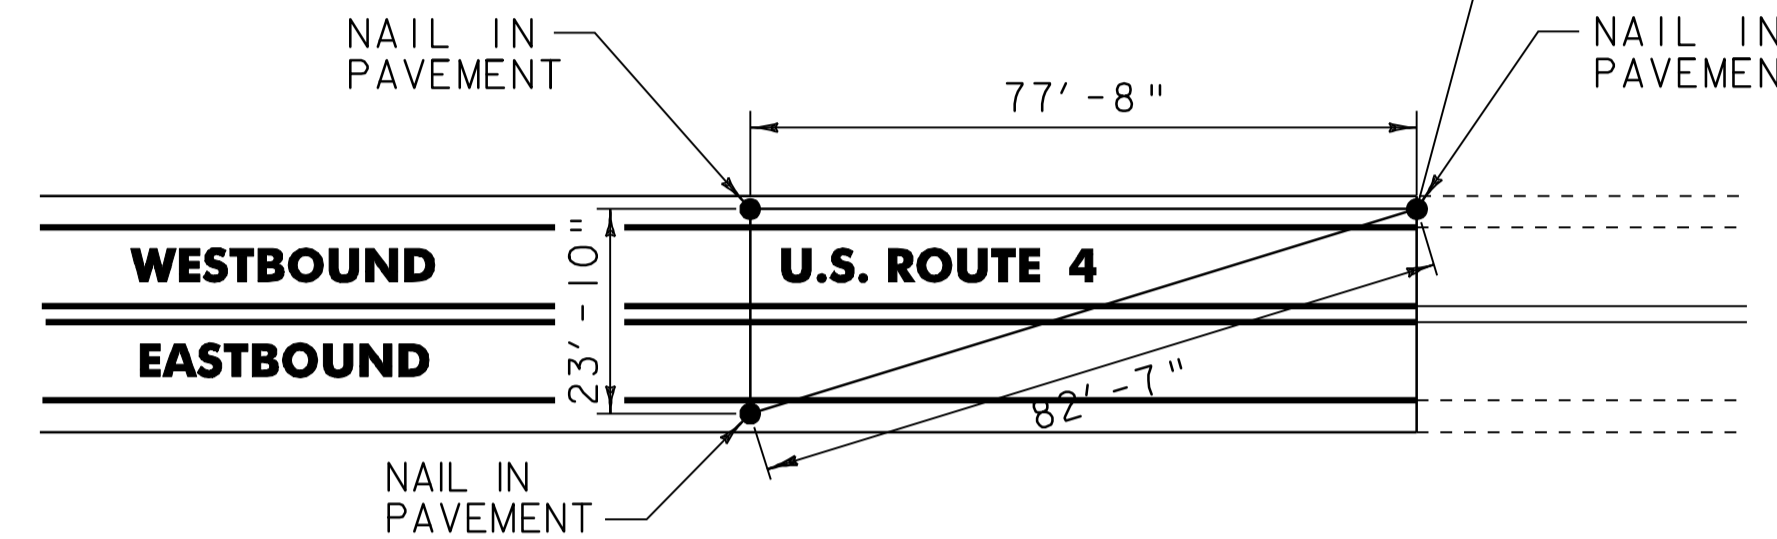

END PROJECT LOCATION TIES

PROJECT PAVING LIMITS

TOWN & ROUTE	BEGIN STATION	END STATION	LANE TYPICAL	WEARING DEPTH	LEVELING TON	NOTES
BRIDGEWATER:						
U.S. ROUTE 4	318+01.44	320+00.00	8'-3" - 12'-0" - 12'-0" - 8'-3"	1 3/4"	-	COLD PLANE 4", RECLAIM 8", PLACE 4" CEMENT STABILIZED COLD MIX, PAVE WITH 1/2" TYPE IVS & PAVE WITH 1 3/4" TYPE IIIS
U.S. ROUTE 4	320+00.00	350+59.20	2'-6" - 11'-0" - 11'-0" - 2'-6"	1 3/4"	-	COLD PLANE 4", RECLAIM 8", PLACE 4" CEMENT STABILIZED COLD MIX, PAVE WITH 1/2" TYPE IVS & PAVE WITH 1 3/4" TYPE IIIS
U.S. ROUTE 4	350+59.20	360+50.00	2'-6" - 11'-0" - 11'-0" - 2'-6"	1 3/4"	-	COLD PLANE 3 1/4", PAVE WITH 1/2" TYPE IVS & PAVE WITH 1 3/4" TYPE IIIS
U.S. ROUTE 4	360+50.00	362+02.00	3'-6" - 11'-0" - 11'-0" - 3'-6"	1 3/4"	-	COLD PLANE 3 1/4", PAVE WITH 1/2" TYPE IVS & PAVE WITH 1 3/4" TYPE IIIS
U.S. ROUTE 4	362+02.00	362+24.00	3'-6" - 11'-0" - 11'-0" - 3'-6"	1 1/4"	-	BR 46 COLD PLANE 1/4" & PAVE WITH 1/4" TYPE IVS
U.S. ROUTE 4	362+24.00	384+50.00	3'-6" - 11'-0" - 11'-0" - 3'-6"	1 3/4"	-	COLD PLANE 3 1/4", PAVE WITH 1/2" TYPE IVS & PAVE WITH 1 3/4" TYPE IIIS
U.S. ROUTE 4	384+50.00	388+00.00	3'-6" - 11'-0" - 11'-0" - 7'-0"	1 3/4"	-	COLD PLANE 3 1/4", PAVE WITH 1/2" TYPE IVS & PAVE WITH 1 3/4" TYPE IIIS
U.S. ROUTE 4	388+00.00	394+00.00	3'-6" - 11'-0" - 11'-0" - 3'-6"	1 3/4"	-	COLD PLANE 3 1/4", PAVE WITH 1/2" TYPE IVS & PAVE WITH 1 3/4" TYPE IIIS
U.S. ROUTE 4	394+00.00	396+63.36	2'-6" - 11'-0" - 11'-0" - 2'-6"	1 3/4"	-	COLD PLANE 3 1/4", PAVE WITH 1/2" TYPE IVS & PAVE WITH 1 3/4" TYPE IIIS
WOODSTOCK:						
U.S. ROUTE 4	0+00.00	60+00.00	2'-6" - 11'-0" - 11'-0" - 2'-6"	1 3/4"	-	COLD PLANE 4", RECLAIM 8", PLACE 4" CEMENT STABILIZED COLD MIX, PAVE WITH 1/2" TYPE IVS & PAVE WITH 1 3/4" TYPE IIIS
U.S. ROUTE 4	60+00.00	62+80.00	5'-0" - 12'-0" - 12'-0" - 5'-0"	1 3/4"	-	COLD PLANE 4", RECLAIM 8", PLACE 4" CEMENT STABILIZED COLD MIX, PAVE WITH 1/2" TYPE IVS & PAVE WITH 1 3/4" TYPE IIIS
U.S. ROUTE 4	62+80.00	63+00.00	5'-0" - 12'-0" - 12'-0" - 5'-0"	1 1/4"	-	BR 47 COLD PLANE 1/4" & PAVE WITH 1/4" TYPE IVS
U.S. ROUTE 4	63+00.00	68+00.00	5'-0" - 12'-0" - 12'-0" - 5'-0"	1 3/4"	-	COLD PLANE 4", RECLAIM 8", PLACE 4" CEMENT STABILIZED COLD MIX, PAVE WITH 1/2" TYPE IVS & PAVE WITH 1 3/4" TYPE IIIS
U.S. ROUTE 4	68+00.00	104+54.00	4'-0" - 11'-0" - 11'-0" - 4'-0"	1 3/4"	-	COLD PLANE 4", RECLAIM 8", PLACE 4" CEMENT STABILIZED COLD MIX, PAVE WITH 1/2" TYPE IVS & PAVE WITH 1 3/4" TYPE IIIS
U.S. ROUTE 4	104+54.00	117+74.00	4'-0" - 11'-0" - 11'-0" - 4'-0"	1 3/4"	-	COLD PLANE 4", RECLAIM 8", PLACE 4" COLD MIX, PAVE WITH 1/2" TYPE IVS & PAVE WITH 1 3/4" TYPE IIIS
U.S. ROUTE 4	117+74.00	161+25.00	4'-0" - 11'-0" - 11'-0" - 4'-0"	1 3/4"	-	COLD PLANE 4", RECLAIM 8", PLACE 4" CEMENT STABILIZED COLD MIX, PAVE WITH 1/2" TYPE IVS & PAVE WITH 1 3/4" TYPE IIIS
U.S. ROUTE 4	161+25.00	171+00.00	VARIES - SEE PLAN	1 3/4"	-	COLD PLANE 4", RECLAIM 8", PLACE 4" CEMENT STABILIZED COLD MIX, PAVE WITH 1/2" TYPE IVS & PAVE WITH 1 3/4" TYPE IIIS
U.S. ROUTE 4	171+00.00	176+39.00	4'-0" - 11'-0" - 11'-0" - 4'-0"	1 3/4"	-	COLD PLANE 4", RECLAIM 8", PLACE 4" CEMENT STABILIZED COLD MIX, PAVE WITH 1/2" TYPE IVS & PAVE WITH 1 3/4" TYPE IIIS
U.S. ROUTE 4	176+39.00	176+61.00	4'-0" - 11'-0" - 11'-0" - 4'-0"	1 1/4"	-	BR 48 COLD PLANE 1/4" & PAVE WITH 1/4" TYPE IVS
U.S. ROUTE 4	176+61.00	211+20.00	4'-0" - 11'-0" - 11'-0" - 4'-0"	1 3/4"	-	COLD PLANE 4", RECLAIM 8", PLACE 4" CEMENT STABILIZED COLD MIX, PAVE WITH 1/2" TYPE IVS & PAVE WITH 1 3/4" TYPE IIIS
U.S. ROUTE 4	211+20.00	227+75.00	4'-0" - 11'-0" - 11'-0" - 4'-0"	1 3/4"	-	COLD PLANE 3 1/4", PAVE WITH 1/2" TYPE IVS & PAVE WITH 1 3/4" TYPE IIIS
U.S. ROUTE 4	227+75.00	239+50.00	7'-0" - 12'-0" - 12'-0" - 7'-0"	1 3/4"	-	COLD PLANE 3 1/4", PAVE WITH 1/2" TYPE IVS & PAVE WITH 1 3/4" TYPE IIIS
U.S. ROUTE 4	239+50.00	247+00.00	VARIES - SEE PLAN	1 3/4"	-	COLD PLANE 3 1/4", PAVE WITH 1/2" TYPE IVS & PAVE WITH 1 3/4" TYPE IIIS
U.S. ROUTE 4	247+00.00	298+32.00	4'-0" - 11'-0" - 11'-0" - 4'-0"	1 3/4"	-	COLD PLANE 3 1/4", PAVE WITH 1/2" TYPE IVS & PAVE WITH 1 3/4" TYPE IIIS


NOT TO SCALE

**PAVING
DETAILS
SHEET #1**

PROJECT NAME: BRIDGEWATER - WOODSTOCK
PROJECT NUMBER: NH_2611(1)S


FILE NAME: p06b160.dgn
PROJECT LEADER: D.E.G.
DESIGNED BY: D.W.E.
IPARM FILE: p06b160p01.i

PLOT DATE: 28-MAY-2010
DRAWN BY: C.A.K.
CHECKED BY: D.E.G.
SHEET 4 OF 80

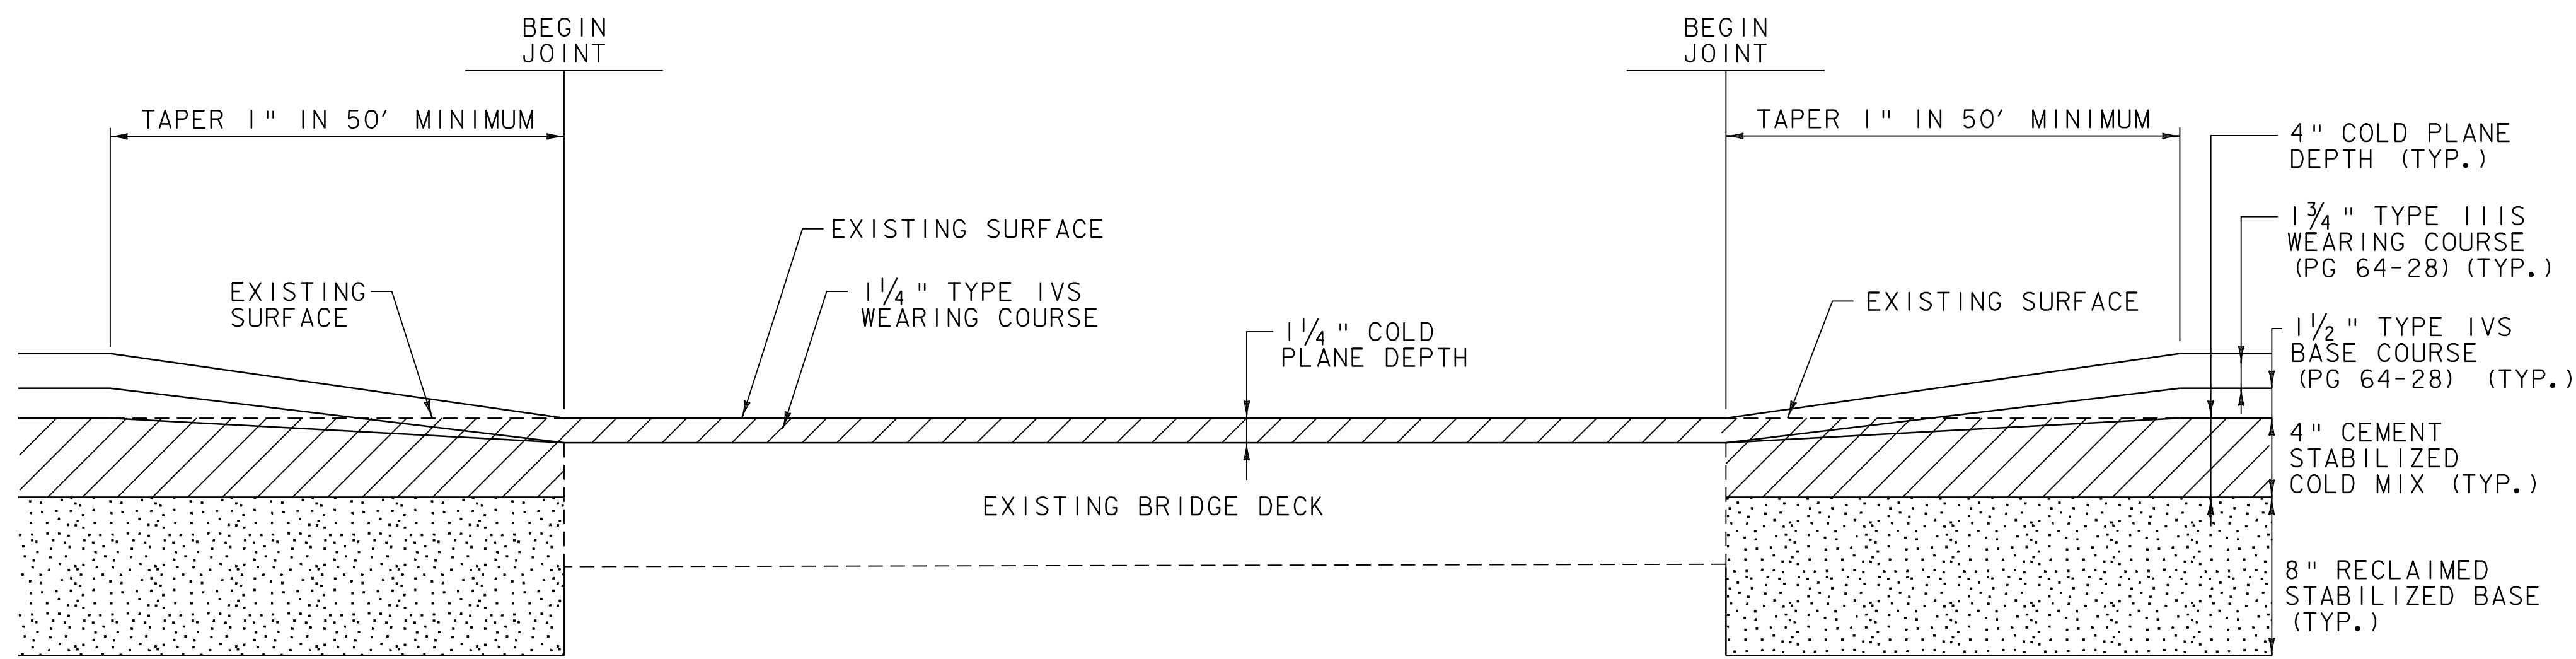


BRIDGE TRANSITION AREA DETAIL

BR 47 U.S. ROUTE 4 WOODSTOCK STA. 62+80.00 TO STA. 63+00.00
 BR 48 U.S. ROUTE 4 WOODSTOCK STA. 176+39.00 TO STA. 176+61.00

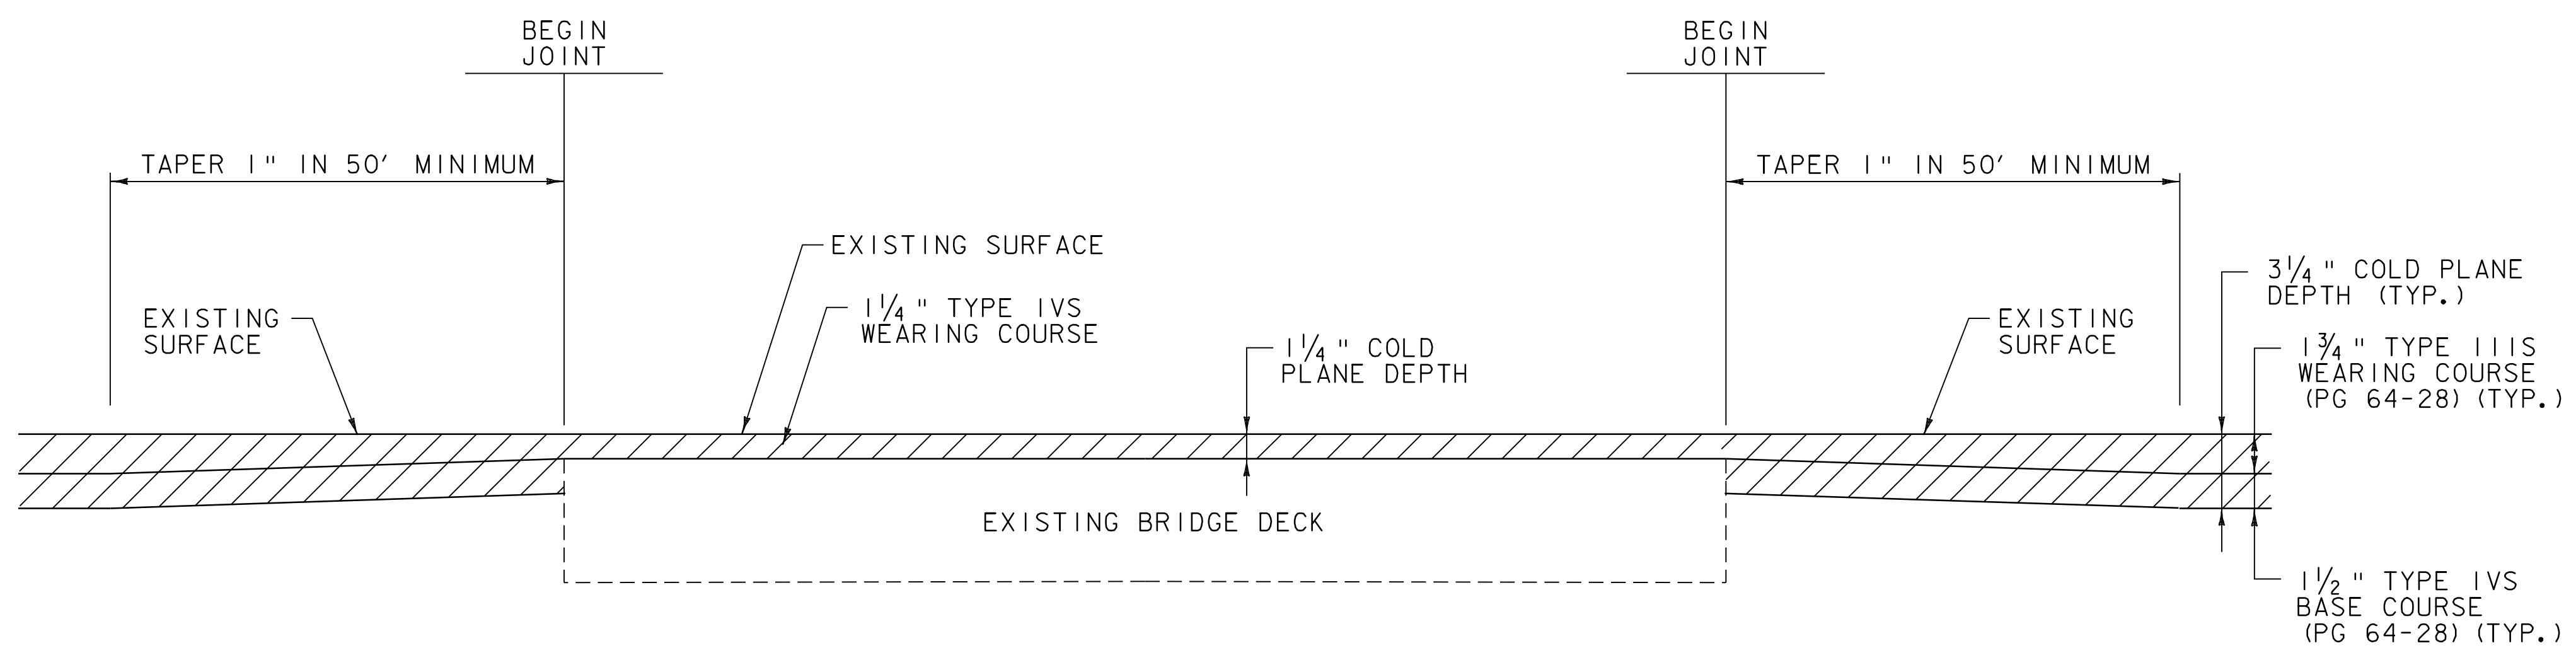


BRIDGE TRANSITION AREA DETAIL

BR 46 U.S. ROUTE 4 BRIDGEWATER STA. 362+02.00 TO STA. 362+24.00

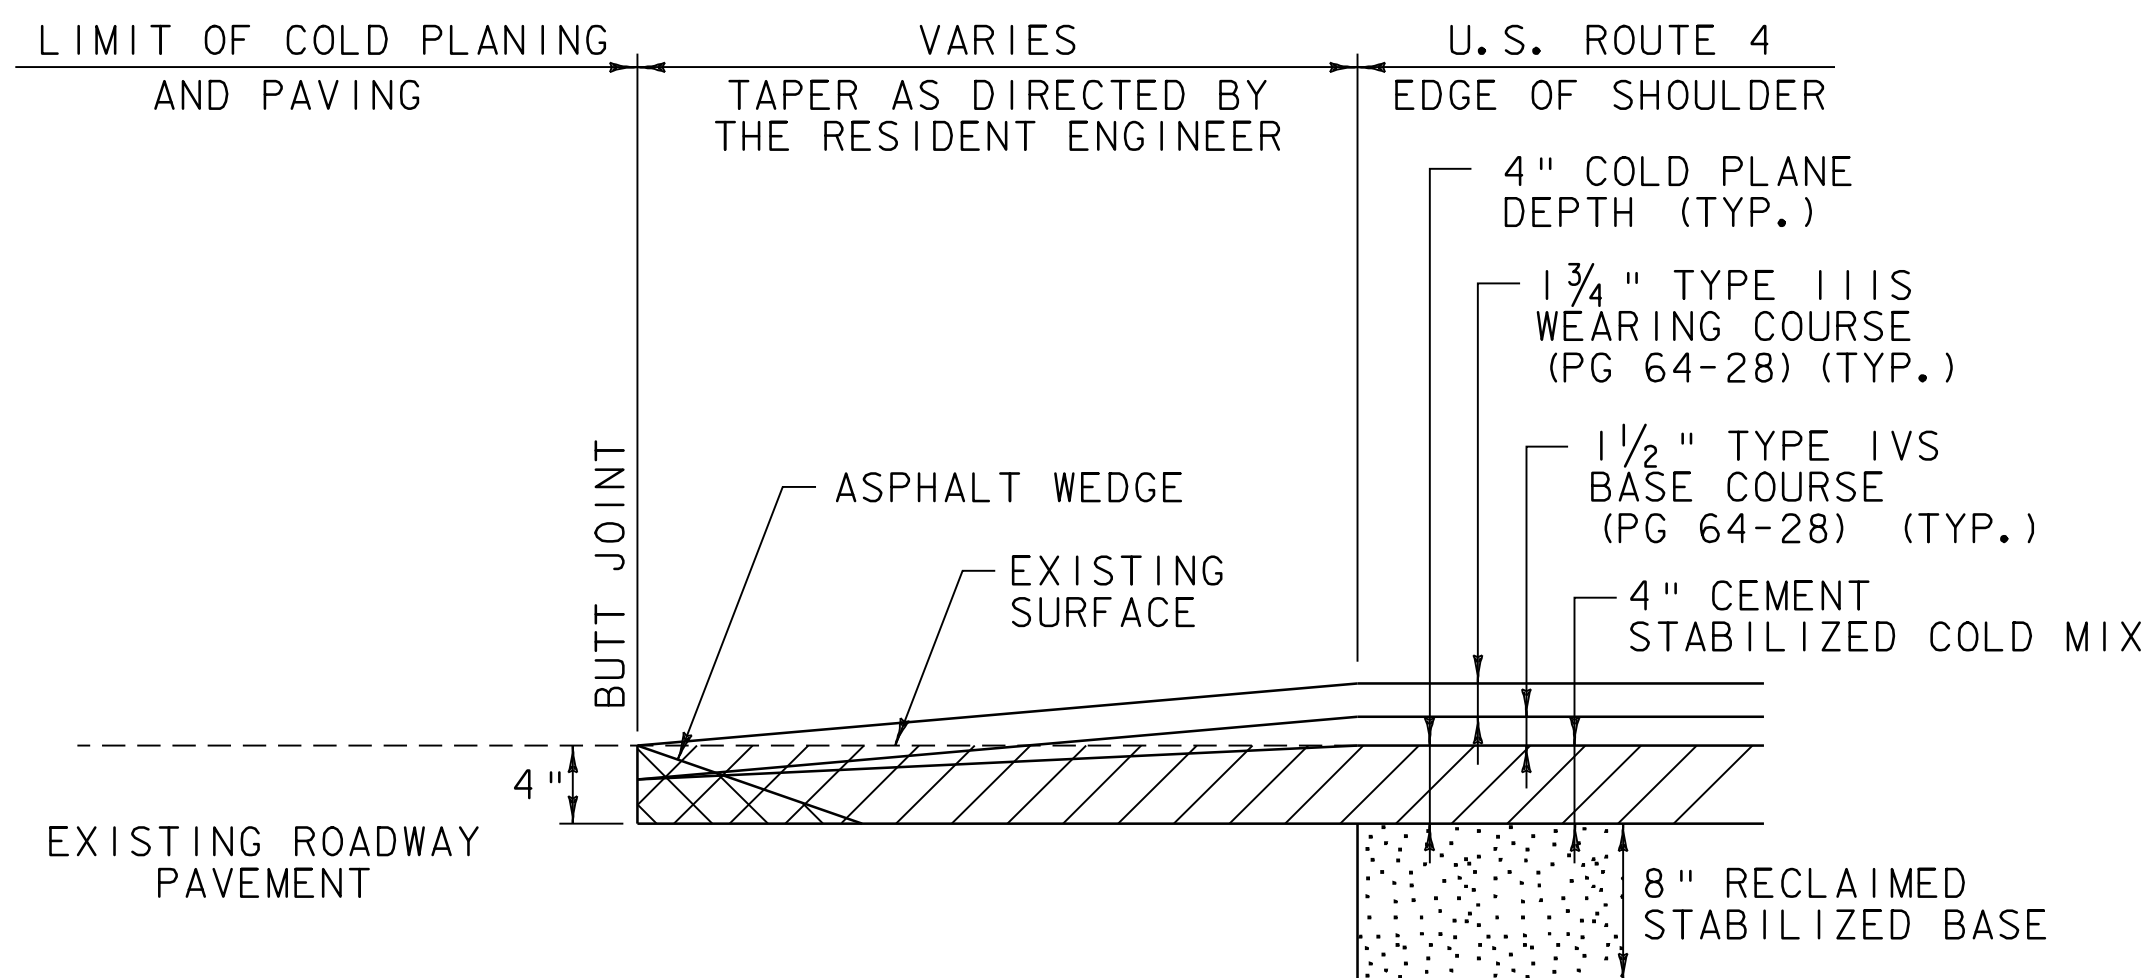


RECLAIM APPROACH AREA DETAIL

WOODSTOCK: TH-97
 TH-27
 TH-35
 TH-28

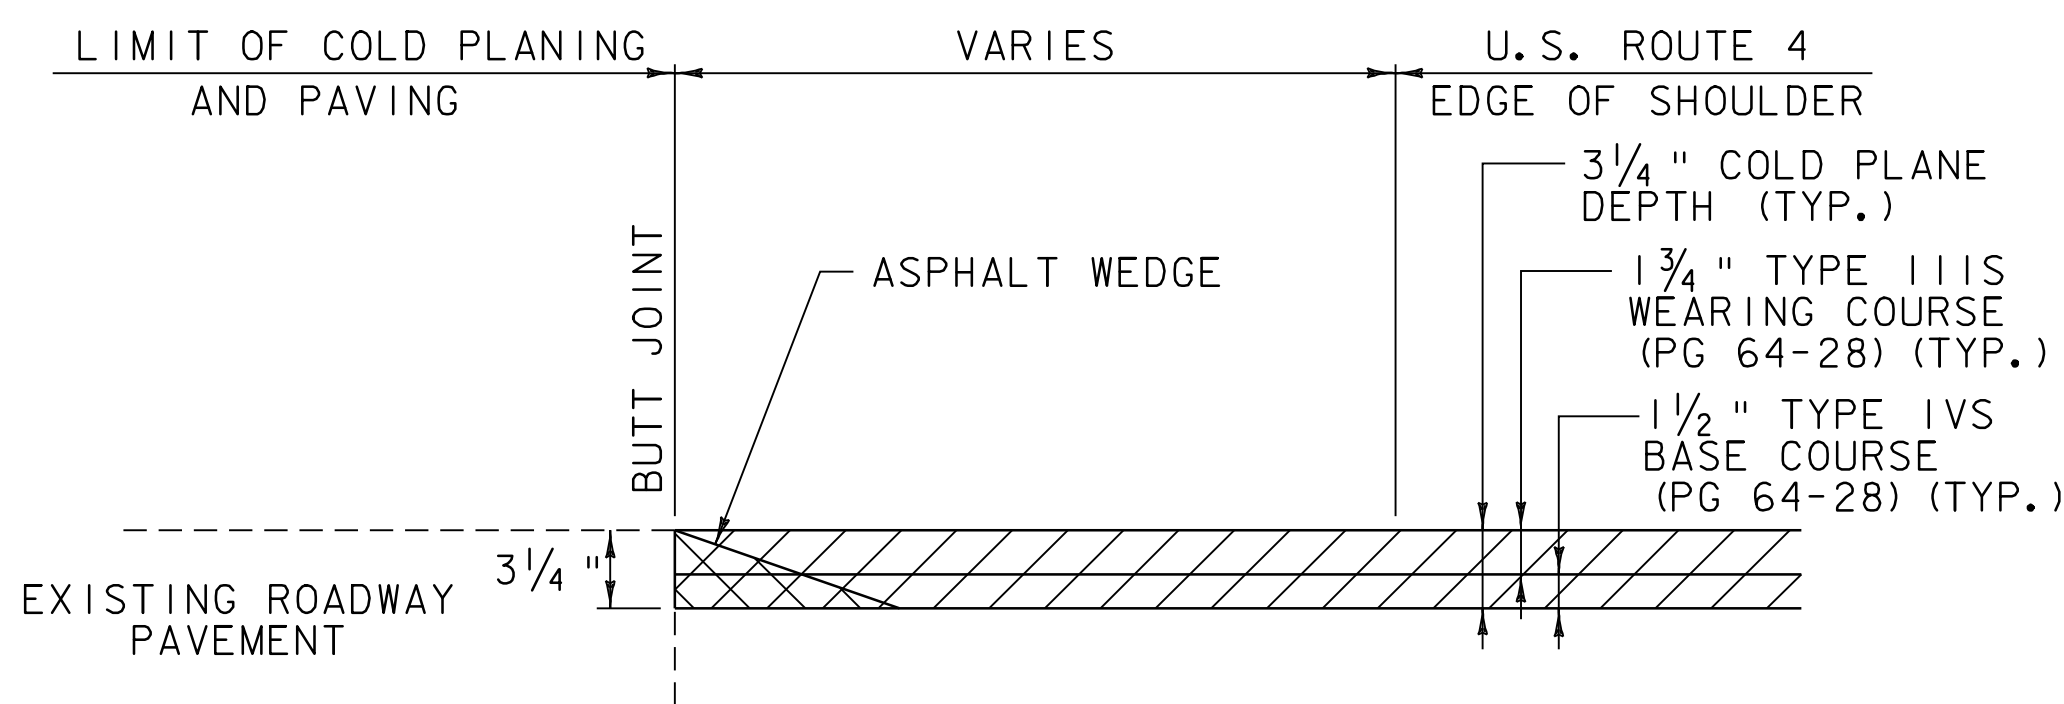


COLD PLANE APPROACH AREA DETAIL

WOODSTOCK: TH-23
 TH-30
 SCHOOL DRIVE
 TH-50
 TH-3

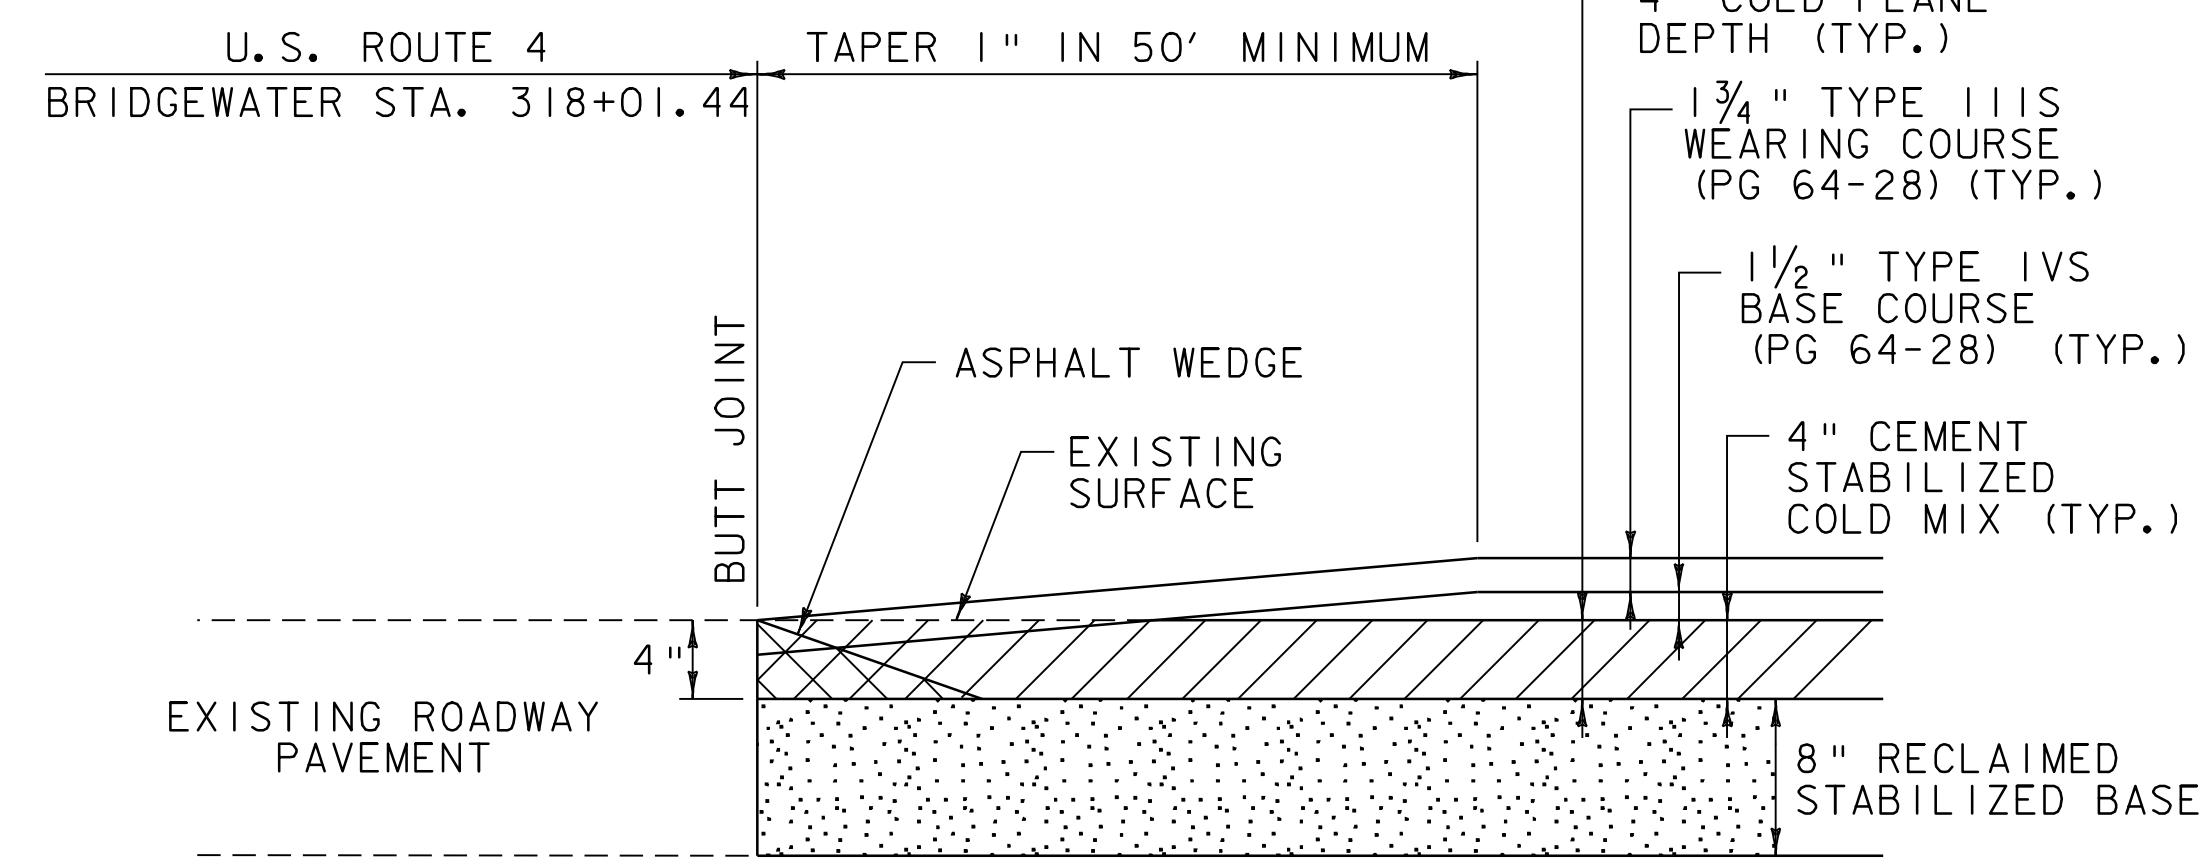


RECLAIM APPROACH AREA DETAIL

U.S. ROUTE 4 BRIDGEWATER STA 318+01.44 - BEGIN PROJECT

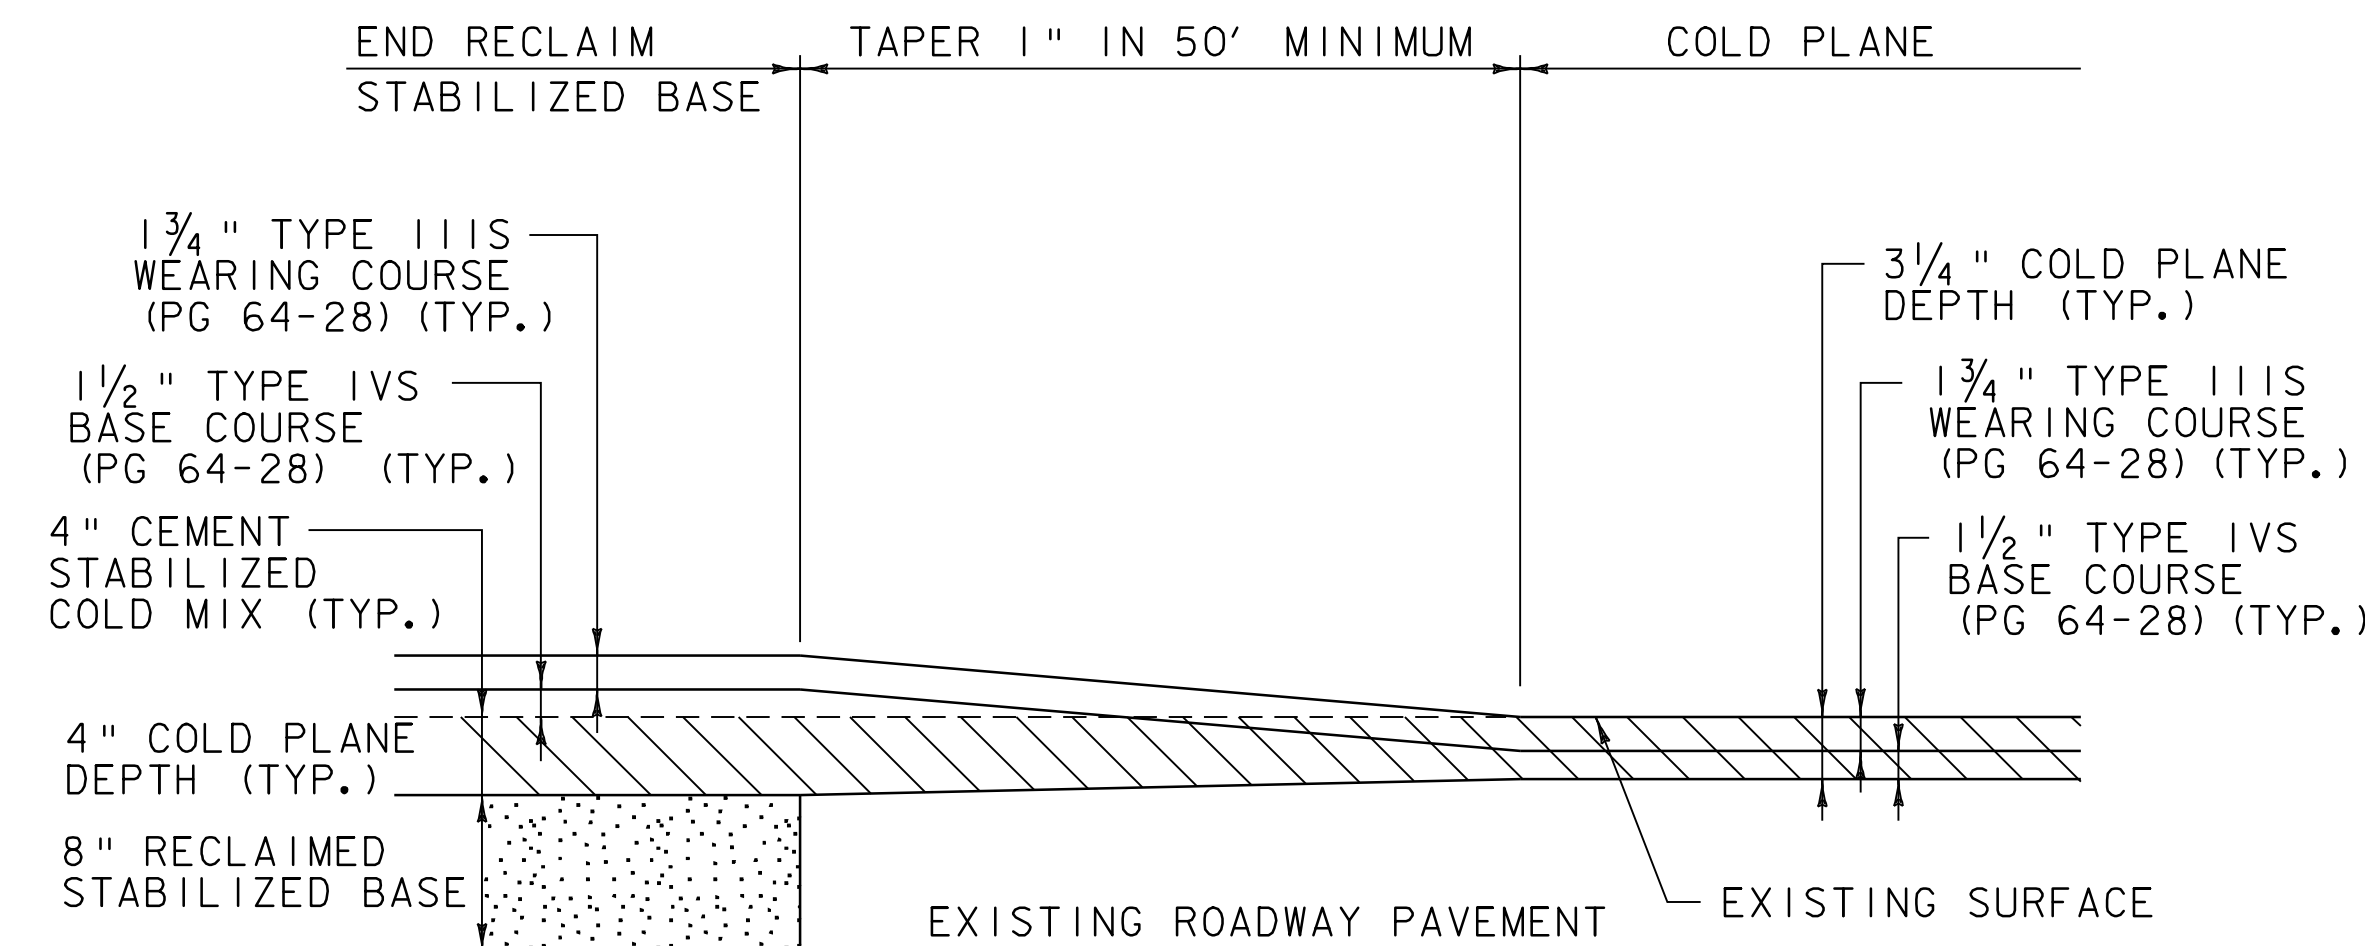

RECLAIM / COLD PLANE TRANSITION AREA DETAIL

U.S. ROUTE 4 BRIDGEWATER STA 350+59.20
 U.S. ROUTE 4 WOODSTOCK STA 0+00.00
 U.S. ROUTE 4 WOODSTOCK STA 211+20.00

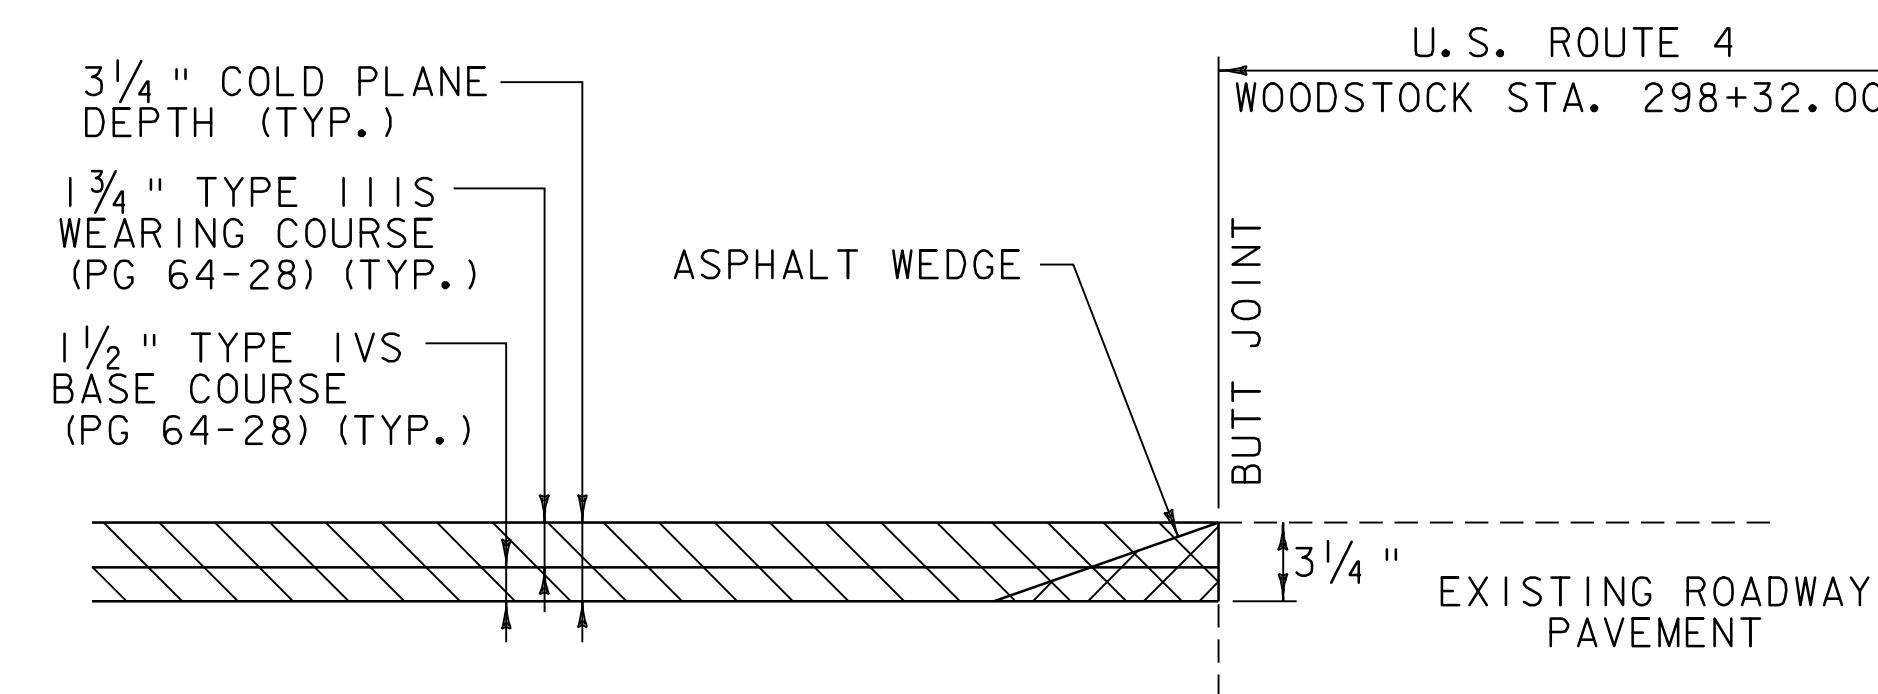

COLD PLANE APPROACH AREA DETAIL

U.S. ROUTE 4 WOODSTOCK STA. 298+32.00 - END PROJECT

NOT TO SCALE

**PAVING
 DETAILS
 SHEET #2**

PROJECT NAME: BRIDGEWATER - WOODSTOCK
 PROJECT NUMBER: NH_2611(S)

FILE NAME: p06b160.dgn -- PLOT DATE: 28-MAY-2010
 PROJECT LEADER: D.E.G. DRAWN BY: C.A.K.
 DESIGNED BY: D.W.E. CHECKED BY: D.E.G.
 IPARM FILE: p06b160pd02.i SHEET 5 OF 80

ITEM DETAIL SUMMARY SHEET 1

LOCATION			GUARDRAIL							MISCELLANEOUS										REMARKS	
BEGIN STATION	END STATION	POS.	621.20	621.205	621.21	621.50	621.51	621.60	621.80	900.640 *	EARTH BORROW/DITCHING MATERIAL	203.15	301.28	301.40	402.12/402.13	604.412	616.28	616.47	676.10		
			S.B. GR. GALV. LF	S.B. GR. GALV. W/ 8 FT POSTS LF	HD S.B. GR. GALV. LF	MTS. FLARED EA	MTS. TANGENT EA	ANCHOR FOR S.B. RAIL EA	REMOVAL & DISPOSAL OF GUARDRAIL LF	SPEC. PRO. (S.B.G., GAL./NEST.) LF		COMMON EXCAVATION CY	SUBBASE CRUSHED GRAVEL TON	SUBBASE, RAP TON	AGGREGATE SHOULDER MATERIAL TON	REHABING DI'S, CB'S OR MH'S, CLASS I EA	C.I.P. CONC. CURB, TYPE B LF	BIT. CONC. GUTTER AND TRAF. ISLAND. TON	DELIN. WITH S.P. EA		
BRIDGEWATER:																					
309+86.0	332+98.5	RT		2237.5		2			2042.0		50				10					2	INSTALL NEW MANUFACTURED TERMINAL SECTION, FLARED FROM STA. 309+86.0 TO STA. 310+23.5. INSTALL NEW MANUFACTURED TERMINAL SECTION, FLARED FROM STA. 332+61.0 TO STA. 332+98.5.
318+01.44	350+59.20	LT/RT												801							SPOT REPAIRS, BACK UP SHOULDERS TO FULL HEIGHT, AND CORRECT SUPERELEVATION AND GRADATION DEFICIENCIES AS DIRECTED BY THE RESIDENT ENGINEER
323+94.0		LT																			
326+49.0		LT																			
331+45.0		LT																			
335+59.0		LT																			
336+80.5	347+55.5 350+55.5	RT	300 *	775 -675.0		2			1042 -1000.0	25 *	50				10					2	INSTALL NEW MANUFACTURED TERMINAL SECTION, FLARED FROM STA. 336+80.5 TO STA. 337+18.0. INSTALL STEEL BEAM GUARDRAIL, GALVANIZED/NESTED FROM STA. 338+18.0 TO STA. 338+43.0. * INSTALL STEEL BEAM GUARDRAIL WITH 8 FEET POSTS FROM STA. 339+43.0 TO STA. 346+18.0. INSTALL NEW MANUFACTURED TERMINAL SECTION, FLARED FROM STA. 347+18.0 TO STA. 347+55.5.
338+00	339+00			75				2		25											
340+25.0		LT																			
346+91.0		LT																			
350+59.20	396+63.36	LT/RT												65		1026					SPOT REPAIRS AND BACK UP SHOULDERS TO FULL HEIGHT AS DIRECTED BY THE RESIDENT ENGINEER
361+20.8 20.5	361+95.8	RT	29 -42.5		124 -32.5	+		2	-6.8 98		25				5					1	INSTALL NEW MANUFACTURED TERMINAL SECTION, FLARED FROM STA. 361+20.8 TO STA. 361+58.3. CONNECT NEW HD STEEL BEAM GUARDRAIL TO NEW BRIDGE RAIL AT STA. 361+95.8. SEE SHEET 76 FOR BR 46 DETAILS.
361+71.8	361+98.8	LT	16.5		38.75 -32.0			+	2	-8.8 25											SEE VAOT STANDARD SHEET G-ID. PROVIDE ANCHOR AT STA. 361+81.3. CONNECT NEW HD STEEL BEAM GUARDRAIL TO NEW BRIDGE RAIL AT STA. 361+98.8. SEE SHEET 76 FOR BR 46 DETAILS.
362+27.1	363+33.4	RT	37.5		41.3	1			13.9		25				5					1	CONNECT NEW HD STEEL BEAM GUARDRAIL TO NEW BRIDGE RAIL AT STA. 362+27.1. SEE SHEET 76 FOR BR 46 DETAILS. INSTALL NEW MANUFACTURED TERMINAL SECTION, FLARED FROM STA. 362+95.9 TO STA. 363+33.4.
362+30.1	363+48.9	LT	50.0		41.3	1			14.9		25				5					1	CONNECT NEW HD STEEL BEAM GUARDRAIL TO NEW BRIDGE RAIL AT STA. 362+30.1. SEE SHEET 76 FOR BR 46 DETAILS. INSTALL NEW MANUFACTURED TERMINAL SECTION, FLARED FROM STA. 363+11.4 TO STA. 363+48.9.
372+71.0		LT																			
383+91.0		LT																			
WOODSTOCK:																					
0+00.0	211+20.0	LT/RT												5404							SPOT REPAIRS, BACK UP SHOULDERS TO FULL HEIGHT, AND CORRECT SUPERELEVATION AND GRADATION DEFICIENCIES AS DIRECTED BY THE RESIDENT ENGINEER
12+07.0 18+20	16+07.0 25+70	RT	352 -325.0			2 -2		1	356.0		50				10					2	INSTALL NEW MANUFACTURED TERMINAL SECTION, FLARED FROM STA. 12+07.0 TO STA. 12+44.5 & STA. 15+69.5 TO STA. 16+07.0.
22+86.0		LT																			
44+50.0 42+79.5 -44+83.0	58+92 59+00.0	RT	625 -475.0	862.5 -867.0		2			1305.0		50				10					2	INSTALL NEW MANUFACTURED TERMINAL SECTION, FLARED FROM STA. 44+83.0 TO STA. 45+20.5. INSTALL STEEL BEAM GUARDRAIL WITH 8 FEET POSTS FROM STA. 49+95.5 TO STA. 58+62.5. INSTALL NEW MANUFACTURED TERMINAL SECTION, FLARED FROM STA. 58+62.5 TO STA. 59+00.0.
54+02.0		LT																			
59+76.0		LT																			
61+02.8	62+77.8	RT	-112.5		65 -32.5	1			110 -52.8		25				5					1	INSTALL NEW MANUFACTURED TERMINAL SECTION, FLARED FROM STA. 61+02.8 TO STA. 61+40.3. CONNECT NEW HD STEEL BEAM GUARDRAIL TO NEW BRIDGE RAIL AT STA. 62+77.8. SEE SHEET 77 FOR BR 47 DETAILS.
61+63.3	62+75.8 63	LT	-50.0		65 -32.5	+	2		-35.8 75		25				5					1	INSTALL NEW MANUFACTURED TERMINAL SECTION, FLARED FROM STA. 61+63.3 TO STA. 62+00.8. CONNECT NEW HD STEEL BEAM GUARDRAIL. NEW BRIDGE RAIL AT STA. 62+75.8. SEE SHEET 77 FOR BR 47 DETAILS.
63+00.8	63+75.8	LT	-42.5		32.5	+			-32.2		25				5					1	CONNECT NEW HD STEEL BEAM GUARDRAIL TO NEW BRIDGE RAIL AT STA. 63+00.8. SEE SHEET 77 FOR BR 47 DETAILS. INSTALL NEW MANUFACTURED TERMINAL SECTION, FLARED FROM STA. 63+38.3 TO STA. 63+75.8.
SHEET SUBTOTALS:			1375.0 *	3779.5	244.6	14	-	1	4868.2	25.0 *	350	-	65	6205	1096	12	-	-	14		
															ITEM DETAIL SUMMARY SHEET #1		PROJECT NAME: BRIDGEWATER_-_WOODSTOCK PROJECT NUMBER: NH_2611(1)S_----- FILE NAME: p06b160.dgn_-- DESIGNED BY: D.W.E. IPARM FILE: p06b160ids1.i				
																	PLOT DATE: 28-MAY-2010 DRAWN BY: C.A.K. CHECKED BY: D.E.G. SHEET 8 OF 80				

ITEM DETAIL SUMMARY SHEET 2

LOCATION			GUARDRAIL							MISCELLANEOUS									REMARKS	
			621.20	621.205	621.21	621.50	621.51	621.60	621.80	900.640 *	EARTH BORROW/DITCHING MATERIAL	203.15	301.28	301.40	402.12/402.13	604.412	616.28	616.47		676.10
BEGIN STATION	END STATION	POS.	S.B. GR. GALV.	S.B. GR. GALV. W/ 8 FT POSTS	HD S.B. GR. GALV.	MTS, FLARED	MTS, TANGENT	ANCHOR FOR S.B. RAIL	REMOVAL & DISPOSAL OF GUARDRAIL	SPEC. PRO. (S.B.G., GAL./NEST.)	COMMON EXCAVATION	SUBBASE CRUSHED GRAVEL	SUBBASE, RAP	AGGREGATE SHOULDER MATERIAL	REHABING DI'S, CB'S OR MH'S, CLASS I	C.I.P. CONC. CURB, TYPE B	BIT. CONC. GUTTERS AND TRAFFIC ISLANDS	DELIN. WITH S.P.		
			LF	LF	LF	EA	EA	EA	LF	LF	CY	TON	TON	TON	EA	LF	TON	EA		
WOODSTOCK:																				
63+02.8	78+90.3 80+77	RT	1525.0 1087.5	662.5	32.5	+			1577.2 1645		25			5				1	CONNECT NEW HD STEEL BEAM GUARDRAIL TO NEW BRIDGE RAIL AT STA. 63+02.8. SEE SHEET 77 FOR BR 47 DETAILS. INSTALL NEW MANUFACTURED TERMINAL SECTION, FLARED FROM STA. 78+52.8 TO STA. 78+90.3.	
66+53.0		LT																		
69+72.0		LT																		
76+27.0		LT																		
78+10.0		LT																		
80+86.5 77	106+24.0	RT	175	2377 2450.0		+	+	1	2537.0		25			5				1	INSTALL NEW MANUFACTURED TERMINAL SECTION, FLARED FROM STA. 80+86.5 TO STA. 81+24.0. INSTALL NEW MANUFACTURED TERMINAL SECTION, TANGENT FROM STA. 105+74.0 TO STA. 106+24.0.	
89+89.0		LT																		
91+00.0		LT																		
93+93.0		LT																		
106+42.0	124+17.0	RT		1739.5 1687.5			1	+	1	1775.0	25			5				1	INSTALL NEW MANUFACTURED TERMINAL SECTION, TANGENT FROM STA. 106+42.0 TO STA. 106+92.0. INSTALL NEW MANUFACTURED TERMINAL SECTION, FLARED FROM STA. 123+79.5 TO STA. 124+17.0.	
109+56.0		LT																		
111+31.0		LT																		
126+55.0		LT																		
129+87	133+77	RT		337.5																
129+90.0		LT																		
132+93.0		LT																		
155+00	164+00	RT	414.5	450			1													
156+04.5	164+17.0	RT		775.0			1		765.0		25			5				1	INSTALL NEW MANUFACTURED TERMINAL SECTION, FLARED FROM STA. 156+04.5 TO STA. 156+42.0. CONNECT NEW STEEL BEAM GUARDRAIL TO EXISTING COVERED BRIDGE AT STA. 164+17.0.	
50	25		79																	
164+29.0	165+04.0	RT	37.5			+		1	50 36.0		25			5				1	CONNECT NEW STEEL BEAM GUARDRAIL TO EXISTING COVERED BRIDGE AT STA. 164+29.0. INSTALL NEW MANUFACTURED TERMINAL SECTION, FLARED FROM STA. 164+66.5 TO STA. 165+04.0.	
176+00	177+25																			
175+98.5	176+38.0	RT	14.5				1		65 32.5											SEE VAOT STANDARD SHEET G-ID. PROVIDE ANCHOR AT STA. 176+08.0. CONNECT NEW HD STEEL BEAM GUARDRAIL TO NEW BRIDGE RAIL AT STA. 176+38.0. SEE SHEET 78 FOR BR 48 DETAILS.
176+11.0	177+23 176+38.0	LT	2				1		65 32.0											SEE VAOT STANDARD SHEET G-ID. PROVIDE ANCHOR AT STA. 176+20.5. CONNECT NEW HD STEEL BEAM GUARDRAIL TO NEW BRIDGE RAIL AT STA. 176+38.0. SEE SHEET 78 FOR BR 48 DETAILS.
176+63.0	177+75.5	RT	50.0			+			24.0		25			5				1	CONNECT NEW HD STEEL BEAM GUARDRAIL TO NEW BRIDGE RAIL AT STA. 176+63.0. SEE SHEET 78 FOR BR 48 DETAILS. INSTALL NEW MANUFACTURED TERMINAL SECTION, FLARED FROM STA. 177+38.0 TO STA. 177+75.5.	
176+63.0	178+38.0	LT	112.5			+			24.0		25			5				1	CONNECT NEW HD STEEL BEAM GUARDRAIL TO NEW BRIDGE RAIL AT STA. 176+63.0. SEE SHEET 78 FOR BR 48 DETAILS. INSTALL NEW MANUFACTURED TERMINAL SECTION, FLARED FROM STA. 178+00.5 TO STA. 178+38.0.	
182+31.0	209+31.0	RT	687.5	2525 1937.5			2		2615 2599.0		50			10				2	INSTALL NEW MANUFACTURED TERMINAL SECTION, FLARED FROM STA. 182+31.0 TO STA. 182+68.5. INSTALL STEEL BEAM GUARDRAIL WITH 8 FEET POSTS FROM STA. 182+68.5 TO STA. 195+06.0 AND FROM STA. 201+93.5 TO STA. 208+93.5. INSTALL NEW MANUFACTURED TERMINAL SECTION, FLARED FROM STA. 208+93. TO STA. 209+31.0.	
183+02.0		LT																		
194+64.0		LT																		
198+87.0		LT																		
202+98.0		LT																		
207+40.0		LT																		
SHEET SUBTOTALS:			2427.0	6850.0	162.0	9	2	2	9393.2	-	225	-	-	-	45	17	-	-	9	

* REVISED 02-04-08

ITEM DETAIL SUMMARY SHEET #2	PROJECT NAME: BRIDGEWATER_-_WOODSTOCK
	PROJECT NUMBER: NH_2611(S)_____
	FILE NAME: p06b160.dgn_
	PLOT DATE: 28-MAY-2010
PROJECT LEADER: D.E.G.	DRAWN BY: C.A.K.
DESIGNED BY: D.W.E.	CHECKED BY: D.E.G.
IPARM FILE: p06b160ids2.i	SHEET 9 OF 80

ITEM DETAIL SUMMARY SHEET 3

LOCATION			GUARDRAIL							MISCELLANEOUS							REMARKS				
BEGIN STATION	END STATION	POS.	621.20	621.205	621.21	621.50	621.51	621.60	621.80	900.640 *	EARTH BORROW/DITCHING MATERIAL	203.15	301.28	301.40	402.12/402.13	604.412		616.28	616.47	676.10	
			S.B. GR. GALV. LF	S.B. GR. GALV. W/ 8 FT POSTS LF	HD S.B. GR. GALV. LF	MTS, FLARED EA	MTS, TANGENT EA	ANCHOR FOR S.B. RAIL EA	REMOVAL & DISPOSAL OF GUARDRAIL LF	SPEC. PRO. (S.B.G., GAL./NEST.) LF	CY	COMMON EXCAVATION CY	SUBBASE CRUSHED GRAVEL TON	SUBBASE, RAP TON	AGGREGATE SHOULDER MATERIAL TON	REHABING DI'S, CB'S OR MH'S, CLASS I EA		C.I.P. CONC. CURB, TYPE B LF	BIT. CONC. GUTTERS AND TRAFFIC ISLANDS TON	DELIN. WITH S.P. EA	
WOODSTOCK:																					
211+20.0	298+32.0	LT/RT													120	1904					SPOT REPAIRS AND BACK UP SHOULDERS TO FULL HEIGHT AS DIRECTED BY THE RESIDENT ENGINEER
231+00.0	239+75.0	RT	737.5 800.0			2			815 830.0		50					10				2	INSTALL NEW MANUFACTURED TERMINAL SECTION, FLARED FROM STA. 231+00.0 TO STA. 231+37.5 & STA. 239+37.5 TO STA. 239+75.0.
233+80.0		RT																			
235+80.0		RT																			
236+47.5	239+10.0	LT	264.5			1		2 +	264.5		25				5					1	INSTALL NEW MANUFACTURED TERMINAL SECTION, FLARED FROM STA. 236+47.5 TO STA. 236+85.0. SEE VAOT STANDARD SHEET G-ID. PROVIDE ANCHOR AT STA. 239+10.0
237+80.0		RT																			
255+85.0		RT																			
257+54.0	259+29.0	LT	89.5 100.0			-2		1	76.0		50				10					2	INSTALL NEW MANUFACTURED TERMINAL SECTION, FLARED FROM STA. 257+54.0 TO STA. 257+91.5 & STA. 258+91.5 TO STA. 259+29.0.
261+60.0		RT																			
262+93.0	264+94.0	RT										67	76				410.0	3			SEE SHEET 79 FOR BITUMINOUS CONCRETE TRAFFIC ISLAND DETAILS.
265+51.0	266+79.0	RT										43	49				264.0	2			SEE SHEET 79 FOR BITUMINOUS CONCRETE TRAFFIC ISLAND DETAILS.
264+85.0		RT																			
267+38.5	282+01.0	RT	278+15 282+01.0	470 1375.0		2 +			412 1320.0 910		25				5					1	INSTALL NEW MANUFACTURED TERMINAL SECTION, FLARED FROM STA. 267+38.5 TO STA. 267+76.0. INSTALL NEW MANUFACTURED TERMINAL SECTION, TANGENT FROM STA. 281+51.0 TO STA. 282+01.0.
272+86	282+01	RT		825		1		1													
271+33.0		LT																			
273+56.0		LT																			
278+56.0		LT																			
281+66.0		LT																			
283+93.0	297+55.5	RT		1327 1262.5		2		1	1355 1361.0												INSTALL NEW MANUFACTURED TERMINAL SECTION, TANGENT FROM STA. 283+93.0 TO STA. 284+43.0. INSTALL NEW MANUFACTURED TERMINAL SECTION, TANGENT FROM STA. 297+05.5 TO STA. 297+55.5.
287+67.0		LT																			
291+20.0		LT																			
293+08.0		LT																			
295+73.0		LT																			
298+28.0		LT																			
SHEET SUBTOTALS			1164.5	2637.5	-	6	3	1	3851.5	-	150	110	245	-	1934	15	674	5	6		
SHEET 8 SUBTOTALS:			1375.0 *	3779.5	244.6	14	-	1	4868.2	25.0 *	350	-	65	6205	1096	12	-	-	14		
SHEET 9 SUBTOTALS:			2427.0	6850.0	162.0	9	2	2	9393.2	-	225	-	-	-	45	17	-	-	9		
ROUNDINGS:			8.5	8	3.4	-	-	-	87.1	-	-	-	15	95	-	-	1	-	-		
TOTALS:			4975.0 *	13,275	410	29	5	4	18,200	25.0 *	725	110	325	6300	3075	44	675	5	29		

* REVISED 02-04-08


ITEM DETAIL SUMMARY SHEET #3	PROJECT NAME: BRIDGEWATER_-_WOODSTOCK	
	PROJECT NUMBER: NH_2611(1)S_____	
	FILE NAME: p06b160.dgn_	PLOT DATE: 28-MAY-2010
	DESIGNED BY: D.W.E.	CHECKED BY: D.E.G.
	IPARM FILE: p06b160ids3.i	SHEET 10 OF 80

646.402 DURABLE 4 INCH WHITE LINE, THERMOPLASTIC
(ALL LINES WILL INCLUDE EDGE LINE BREAKS AND
RADIUS FOR TOWN HIGHWAYS)
BRIDGEWATER:
STA. 318+01.44 - STA. 320+50.00 LT & RT

646.412 DURABLE 4 INCH YELLOW LINE, THERMOPLASTIC
(ALL LINES WILL INCLUDE C/L BREAKS FOR
TOWN HIGHWAYS) S=SOLID, D=DASHED
BRIDGEWATER:
STA. 318+01.44 - STA. 320+50.00 LT C RT
S - S

646.602 TEMPORARY 4 INCH WHITE LINE, PAINT
(ALL LINES WILL INCLUDE EDGE LINE BREAKS AND
RADIUS FOR TOWN HIGHWAYS)
BRIDGEWATER:
STA. 318+01.44 - STA. 320+50.00 LT & RT

646.612 TEMPORARY 4 INCH YELLOW LINE, PAINT
(ALL LINES WILL INCLUDE C/L BREAKS FOR
TOWN HIGHWAYS) S=SOLID, D=DASHED
BRIDGEWATER:
STA. 318+01.44 - STA. 320+50.00 LT C RT
S - S

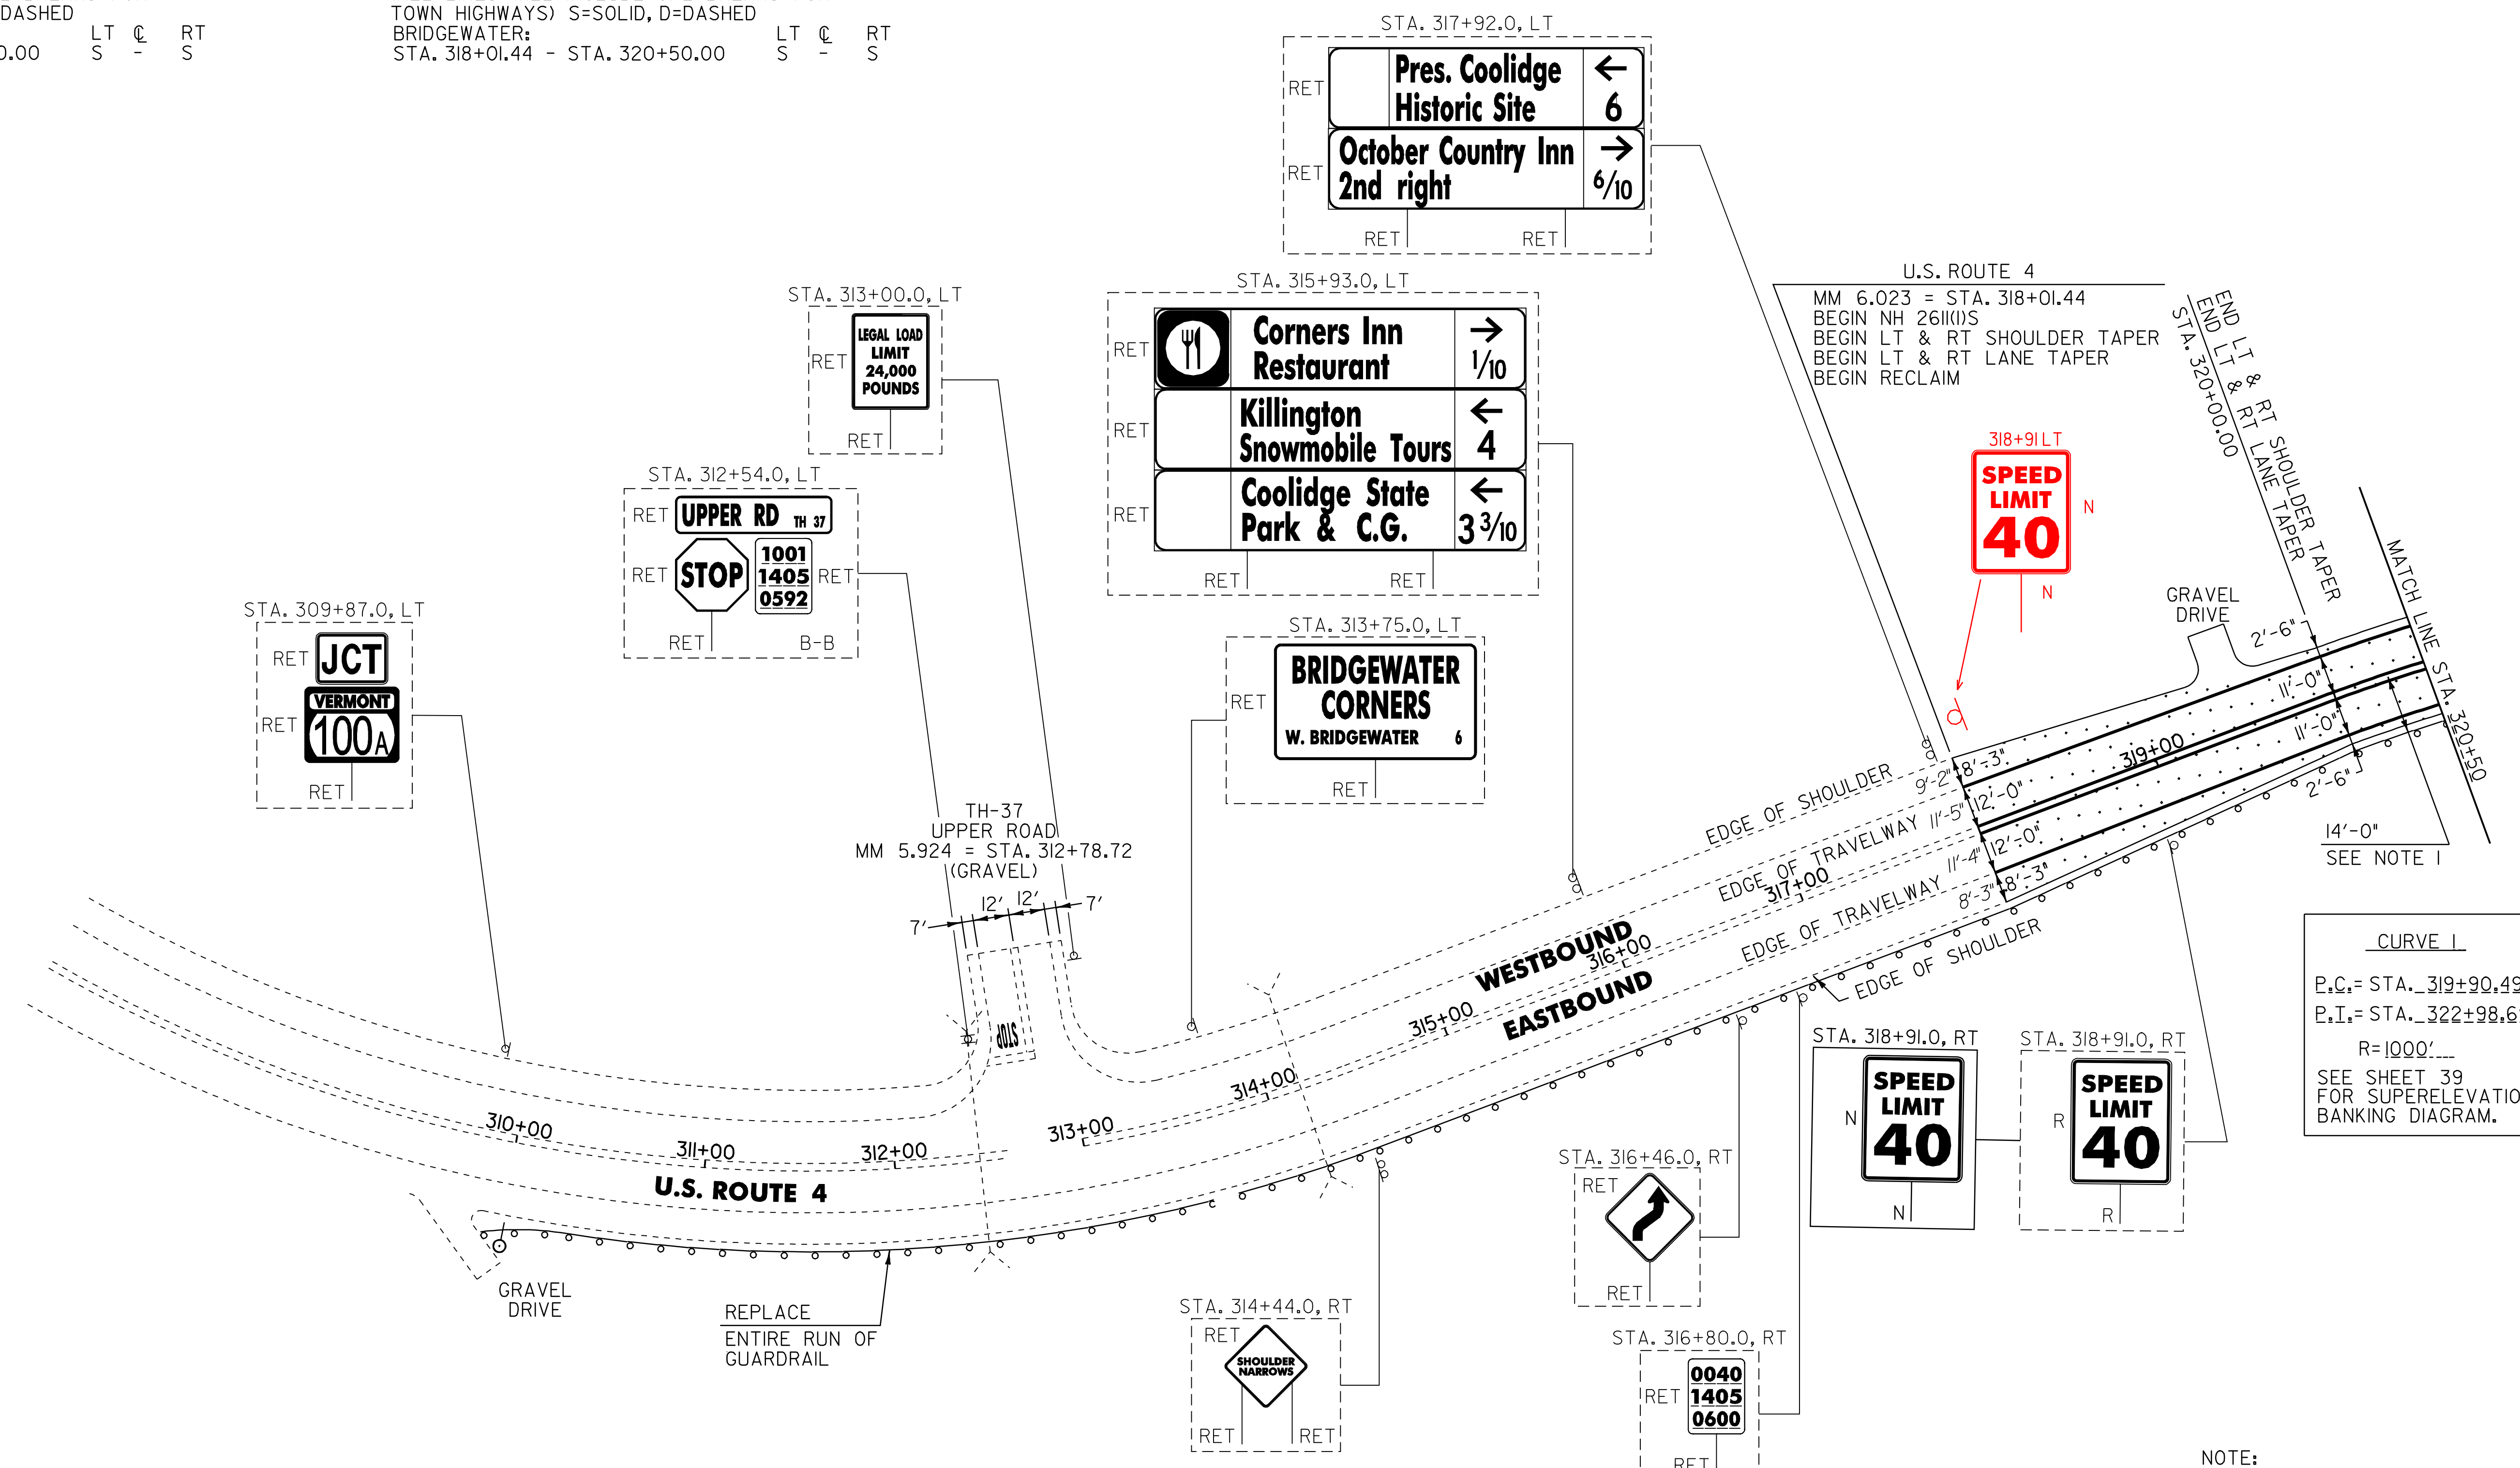

CURVE I
P.C.= STA. 319+90.49
P.T.= STA. 322+98.69
R=1000'
SEE SHEET 39
FOR SUPERELEVATION
BANKING DIAGRAM.


NOTE:
I. THE CONTRACTOR SHALL MAXIMIZE THE CLEAR ROADSIDE AREA BY INSTALLING THE PROPOSED GUARDRAIL A MINIMUM OF 14 FT FROM THE CENTERLINE OF U.S. ROUTE 4 OR AS DIRECTED BY THE RESIDENT ENGINEER. ANY REQUIRED EXCAVATION OR THE PLACEMENT OF AGGREGATE SHOULDER MATERIAL FOR ADDITIONAL BACKUP WILL BE COMPLETED AND PAID FOR UNDER THE APPLICABLE ITEM(S) AS DIRECTED BY THE RESIDENT ENGINEER.

621.205 STEEL BEAM GUARDRAIL, GALVANIZED W/8 FEET POSTS
BRIDGEWATER:
STA. 310+23.5 - STA. 320+50.0 RT (1026.5 LF)

621.50 MANUFACTURED TERMINAL SECTION, FLARED
BRIDGEWATER:
STA. 309+86.0 - STA. 310+23.5 RT

621.80 REMOVAL AND DISPOSAL OF GUARDRAIL
BRIDGEWATER:
STA. 309+86.0 - STA. 320+50.0 RT (1064.0 LF)

676.10 DELINEATOR WITH STEEL POST
TYPE I WHITE
BRIDGEWATER:
STA. 309+86.0 RT

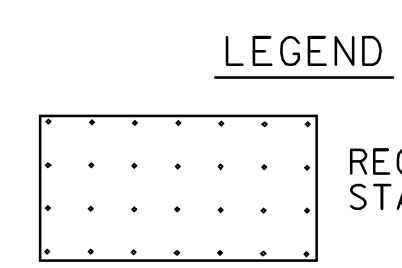

SIGN LEGEND
R = REMOVE
S = SALVAGE
N = NEW
RET = RETAIN
B-B = BACK TO BACK
EXISTING = _____
NEW = _____

NOT TO SCALE
PROJECT LAYOUT SHEET #1

PROJECT NAME: BRIDGEWATER - WOODSTOCK
PROJECT NUMBER: NH_2611(S)
FILE NAME: p06b160.dgn
PROJECT LEADER: D.E.G.
DESIGNED BY: D.W.E.
IPARM FILE: p06b160I.i.
PLOT DATE: 28-MAY-2010
DRAWN BY: C.A.K.
CHECKED BY: D.E.G.
SHEET 12 OF 80


646.402 DURABLE 4 INCH WHITE LINE, THERMOPLASTIC
 (ALL LINES WILL INCLUDE EDGE LINE BREAKS AND
 RADIUS FOR TOWN HIGHWAYS)
 BRIDGEWATER:
 STA. 320+50.00 - STA. 336+00.00 LT & RT

646.412 DURABLE 4 INCH YELLOW LINE, THERMOPLASTIC
 (ALL LINES WILL INCLUDE C/L BREAKS FOR
 TOWN HIGHWAYS) S=SOLID, D=DASHED
 BRIDGEWATER:
 STA. 320+50.00 - STA. 336+00.00 LT C RT
 S - S

646.602 TEMPORARY 4 INCH WHITE LINE, PAINT
 (ALL LINES WILL INCLUDE EDGE LINE BREAKS AND
 RADIUS FOR TOWN HIGHWAYS)
 BRIDGEWATER:
 STA. 320+50.00 - STA. 336+00.00 LT & RT

646.612 TEMPORARY 4 INCH YELLOW LINE, PAINT
 (ALL LINES WILL INCLUDE C/L BREAKS FOR
 TOWN HIGHWAYS) S=SOLID, D=DASHED
 BRIDGEWATER:
 STA. 320+50.00 - STA. 336+00.00 LT C RT
 S - S

675.50 REMOVING SIGNS
 AS SHOWN - 4

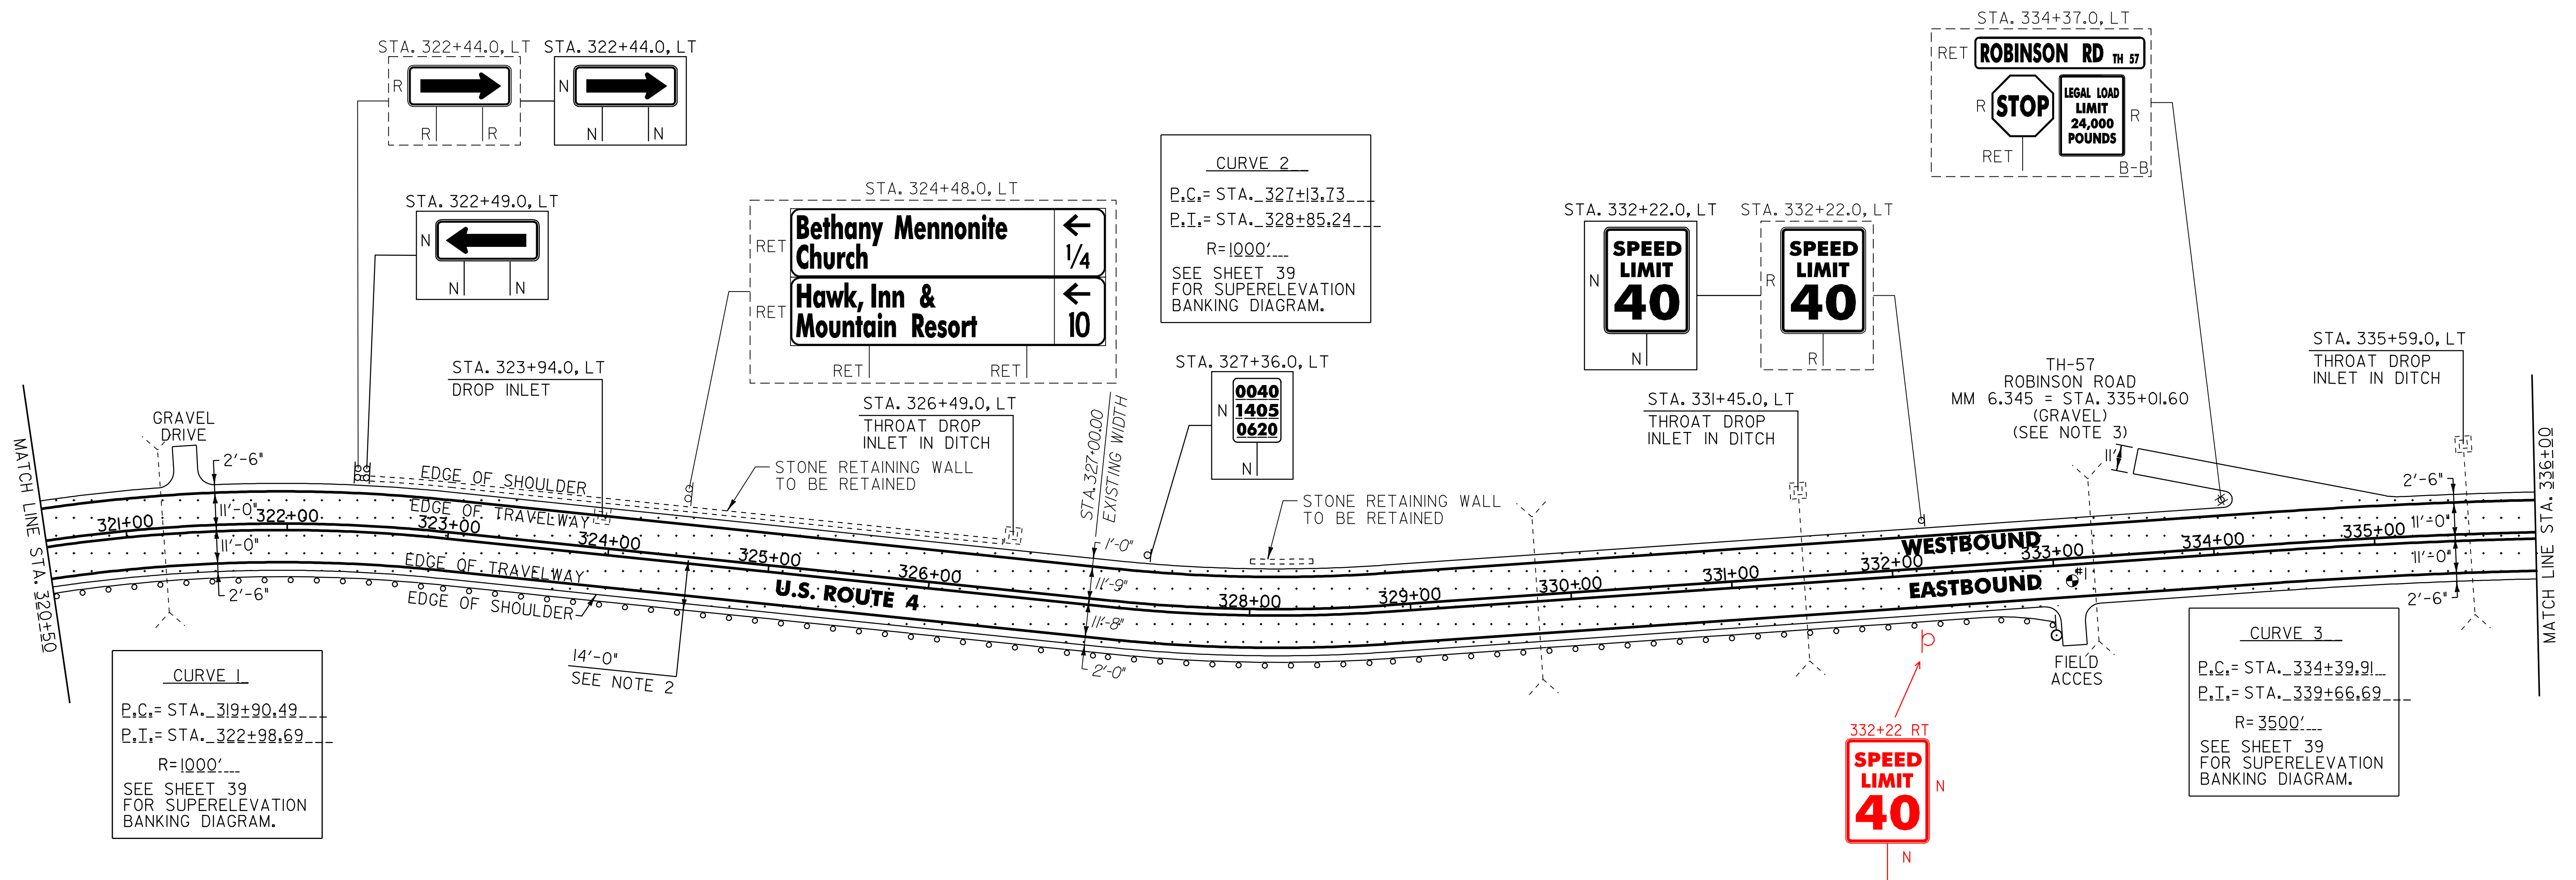


CURVE 1
 P.C. = STA. 319+90.49
 P.T. = STA. 322+98.69
 R = 1000'
 SEE SHEET 39
 FOR SUPERELEVATION
 BANKING DIAGRAM.

CURVE 2
 P.C. = STA. 327+13.73
 P.T. = STA. 328+85.24
 R = 1000'
 SEE SHEET 39
 FOR SUPERELEVATION
 BANKING DIAGRAM.

CURVE 3
 P.C. = STA. 334+39.91
 P.T. = STA. 339+66.69
 R = 3500'
 SEE SHEET 39
 FOR SUPERELEVATION
 BANKING DIAGRAM.

- NOTES:
- PAVING LIMIT ON ALL TOWN HIGHWAYS SHALL BE MEASURED 25 FT BACK FROM U.S. ROUTE 4 EDGE OF SHOULDER UNLESS DENOTED OTHERWISE ON THE PLANS OR AS DIRECTED BY THE RESIDENT ENGINEER.
 - THE CONTRACTOR SHALL MAXIMIZE THE CLEAR ROADSIDE AREA BY INSTALLING THE PROPOSED GUARDRAIL A MINIMUM OF 14 FT FROM THE CENTERLINE OF U.S. ROUTE 4 OR AS DIRECTED BY THE RESIDENT ENGINEER. ANY REQUIRED EXCAVATION OR THE PLACEMENT OF AGGREGATE SHOULDER MATERIAL FOR ADDITIONAL BACKUP WILL BE COMPLETED AND PAID FOR UNDER THE APPLICABLE ITEM(S) AS DIRECTED BY THE RESIDENT ENGINEER.
 - NO OPENING IN THE CENTERLINE OR EDGE LINE MARKINGS, NO STOP, AND NO LEGAL LOAD LIMIT SIGN WILL BE PROVIDED FOR TH-57 BECAUSE IT IS A CLASS IV TOWN HIGHWAY.

LEGEND

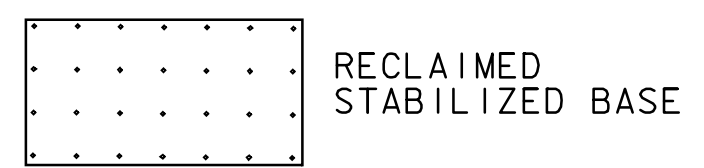

SIGN LEGEND
 R = REMOVE
 S = SALVAGE
 N = NEW
 RET = RETAIN
 B-B = BACK TO BACK
 EXISTING = ---
 NEW = - - -

PAVEMENT CORES = ●

#	DEPTH (INCH)	PCC	COMMENTS
1	9	NO	

NOT TO SCALE

PROJECT LAYOUT SHEET #2

PROJECT NAME: BRIDGEWATER - WOODSTOCK
 PROJECT NUMBER: NH_2611(S)
 FILE NAME: p06b160.dgn
 PROJECT LEADER: D.E.G.
 DESIGNED BY: D.W.E.
 IPARM FILE: p06b160102.i
 PLOT DATE: 28-MAY-2010
 DRAWN BY: C.A.K.
 CHECKED BY: D.E.G.
 SHEET 13 OF 80

604.412 REHAB. DROP INLETS, CATCH BASINS OR MANHOLE, CLASS I

BRIDGEWATER:
 STA. 323+94.0 LT
 STA. 326+49.0 LT
 STA. 331+45.0 LT
 STA. 335+59.0 LT

621.205 STEEL BEAM GUARDRAIL, GALVANIZED W/8 FEET POSTS

BRIDGEWATER:
 STA. 320+50.0 - STA. 332+61.0 RT (1211.0 LF)

621.50 MANUFACTURED TERMINAL SECTION, FLARED

BRIDGEWATER:
 STA. 332+61.0 - STA. 332+98.5 RT

621.80 REMOVAL AND DISPOSAL OF GUARDRAIL

BRIDGEWATER:
 STA. 320+50.0 - STA. 330+28.0 RT (978.0 LF)

676.10 DELINEATOR WITH STEEL POST

♀ TYPE I WHITE

BRIDGEWATER:
 STA. 332+98.5 RT

646.402 DURABLE 4 INCH WHITE LINE, THERMOPLASTIC
 (ALL LINES WILL INCLUDE EDGE LINE BREAKS AND
 RADIUS FOR TOWN HIGHWAYS)
 BRIDGEWATER:
 STA. 336+00.00 - STA. 352+00.00 LT & RT


646.412 DURABLE 4 INCH YELLOW LINE, THERMOPLASTIC
 (ALL LINES WILL INCLUDE C/L BREAKS FOR
 TOWN HIGHWAYS) S=SOLID, D=DASHED
 BRIDGEWATER:
 STA. 336+00.00 - STA. 352+00.00 LT C RT
 S - S

646.602 TEMPORARY 4 INCH WHITE LINE, PAINT
 (ALL LINES WILL INCLUDE EDGE LINE BREAKS AND
 RADIUS FOR TOWN HIGHWAYS)
 BRIDGEWATER:
 STA. 336+00.00 - STA. 352+00.00 LT & RT

646.612 TEMPORARY 4 INCH YELLOW LINE, PAINT
 (ALL LINES WILL INCLUDE C/L BREAKS FOR
 TOWN HIGHWAYS) S=SOLID, D=DASHED
 BRIDGEWATER:
 STA. 336+00.00 - STA. 352+00.00 LT C RT
 S - S

675.50 REMOVING SIGNS
 AS SHOWN - I

675.60 ERECTING SALVAGED SIGNS
 AS SHOWN - I

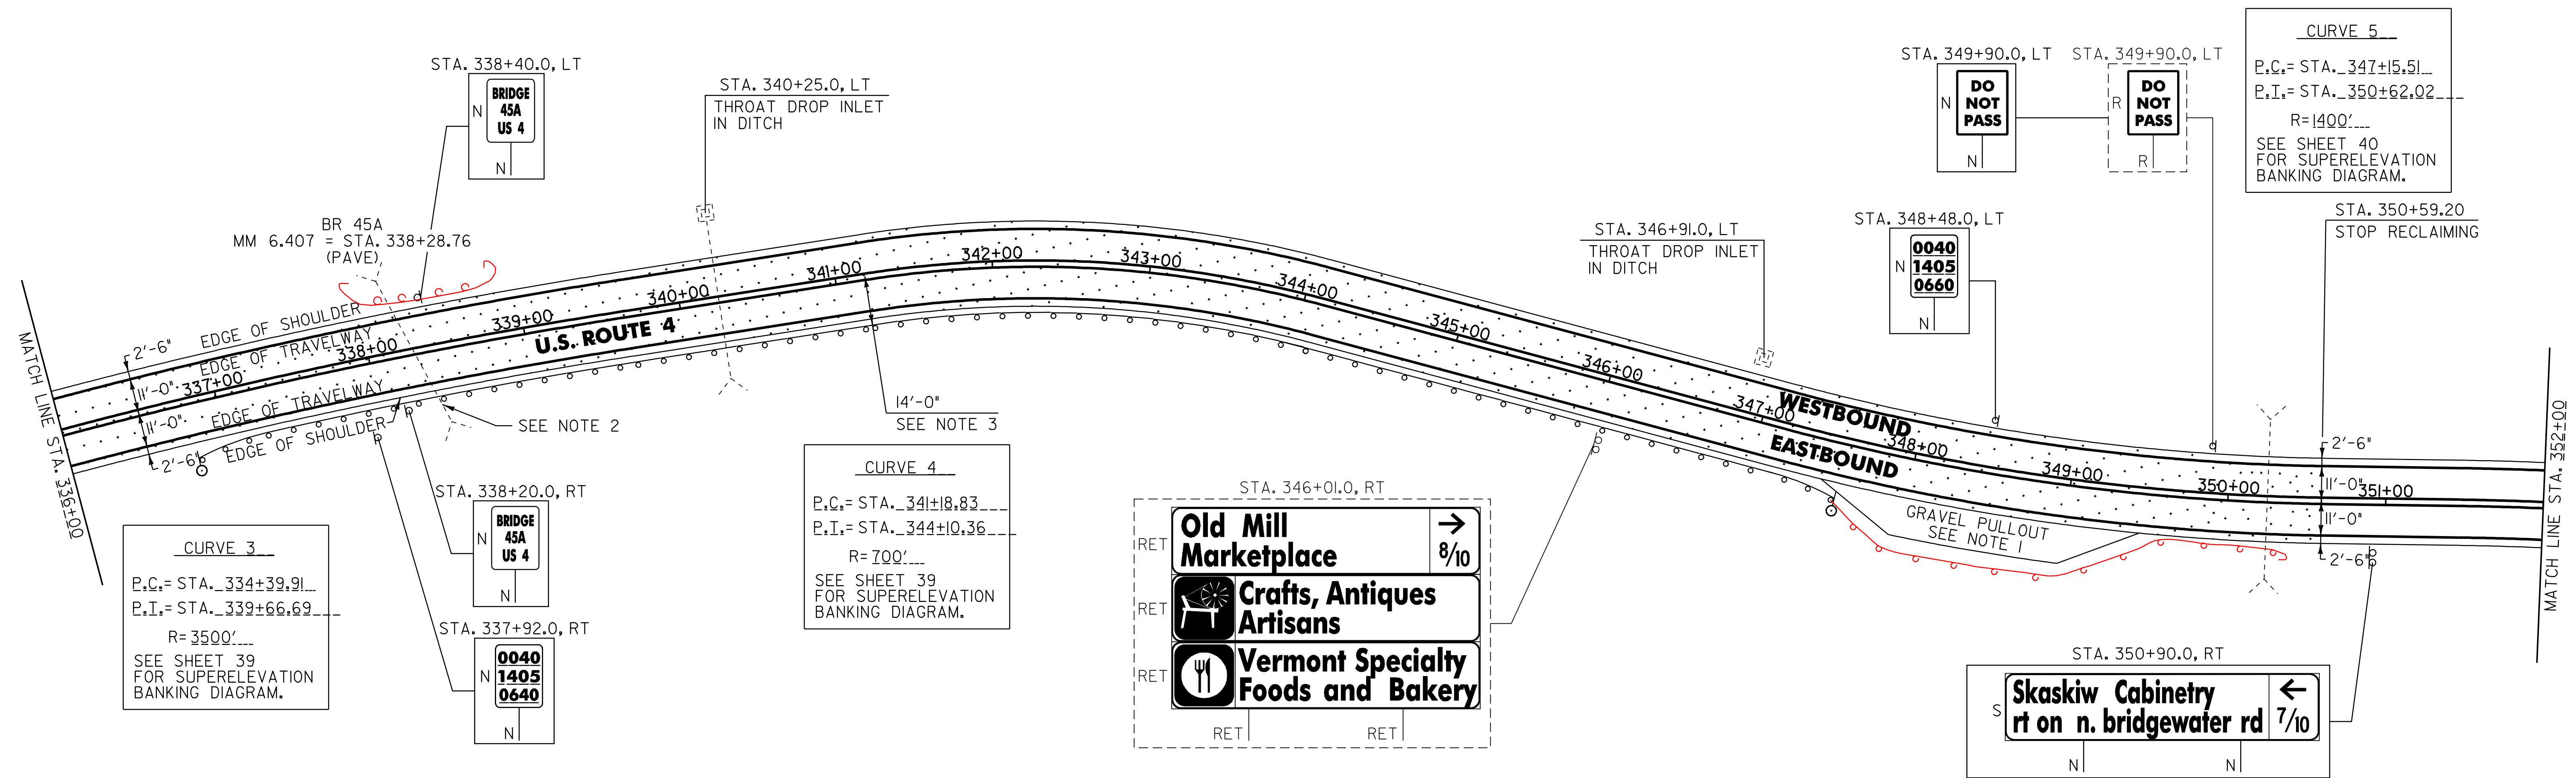

CURVE 3
 P.C.= STA. 334+39.91
 P.T.= STA. 339+66.69
 R=3500'
 SEE SHEET 39
 FOR SUPERELEVATION
 BANKING DIAGRAM.

CURVE 4
 P.C.= STA. 341+18.83
 P.T.= STA. 344+10.36
 R=700'
 SEE SHEET 39
 FOR SUPERELEVATION
 BANKING DIAGRAM.

CURVE 5
 P.C.= STA. 347+15.51
 P.T.= STA. 350+62.02
 R=1400'
 SEE SHEET 40
 FOR SUPERELEVATION
 BANKING DIAGRAM.

CURVE 6
 P.C.= STA. 351+46.57
 P.T.= STA. 352+62.42
 R=2000'
 SEE SHEET 40
 FOR SUPERELEVATION
 BANKING DIAGRAM.

STA. 346+01.0, RT

RET
Old Mill Marketplace → 8/10

RET
Crafts, Antiques Artisans

RET
Vermont Specialty Foods and Bakery

RET

STA. 350+90.0, RT

S
Skaskiw Cabinetry ← 7/10
 rt on n. bridgewater rd

N

338+00 - 338+75 LT (75')

ANCHOR FOR STEEL BEAM GUARDRAIL
 338+00 LT
 338+75 LT

604.412 REHAB. DROP INLETS, CATCH BASINS OR MANHOLE, CLASS I
 BRIDGEWATER:
 STA. 340+25.0 LT
 STA. 346+91.0 LT

621.80 REMOVAL AND DISPOSAL OF GUARDRAIL
 BRIDGEWATER:
 STA. 337+49.0 - STA. 347+49.0 RT (1000.0 LF)

621.20 STEEL BEAM GUARDRAIL, GALVANIZED
 BRIDGEWATER:
 STA. 346+18.0 - STA. 347+18.0 RT (100.0 LF)
 STA. 337+18.0 - STA. 338+18.0 RT (100.0 LF) *
 STA. 338+43.0 - STA. 339+43.0 RT (100.0 LF) *
 344+93

676.10 DELINEATOR WITH STEEL POST
 ♀ TYPE I WHITE

621.205 STEEL BEAM GUARDRAIL, GALVANIZED W/8 FEET POSTS
 BRIDGEWATER:
 STA. 339+43.0 - STA. 346+18.0 RT (675.0 LF)
 337+18 344+93

BRIDGEWATER:
 STA. 336+80.5 RT
 STA. 347+55.5 RT

621.50 MANUFACTURED TERMINAL SECTION, FLARED
 BRIDGEWATER:
 STA. 336+80.5 - STA. 337+18.0 RT
 STA. 347+18.0 - STA. 347+55.5 RT
 350 350

900.640 SPECIAL PROVISION (STEEL BEAM GUARDRAIL, GALVANIZED/NESTED)
 BRIDGEWATER:
 STA. 338+18.0 - STA. 338+43.0 RT (25.0 LF) *

SIGN LEGEND
 R = REMOVE
 S = SALVAGE
 N = NEW
 RET = RETAIN
 B-B = BACK TO BACK
 EXISTING = -----
 NEW = _____

NOT TO SCALE

* REVISED 02-04-08

PROJECT LAYOUT SHEET #3

PROJECT NAME: BRIDGEWATER - WOODSTOCK
 PROJECT NUMBER: NH_2611(S)
 FILE NAME:
 PROJECT LEADER: D.E.G.
 DESIGNED BY: D.W.E.
 IPARM FILE: p06b160103.I
 PLOT DATE: 28-MAY-2010
 DRAWN BY: C.A.K.
 CHECKED BY: D.E.G.
 SHEET 14 OF 80

LEGEND
 [Pattern] RECLAIMED STABILIZED BASE

NOTES:
 1. PROVIDE A 5 FT WIDE, 1 3/4" TYPE IIIS APRON FOR THE EXISTING GRAVEL PULLOUT. ANY REQUIRED EXCAVATION SHALL BE PERFORMED AS DIRECTED BY THE RESIDENT ENGINEER AND PAID FOR UNDER ITEM 608.25 ALL PURPOSE EXCAVATOR RENTAL, TYPE I.
 2. SEE SHEET 79 FOR STEEL BEAM GUARDRAIL AT SMALL CULVERT DETAILS.
 3. THE CONTRACTOR SHALL MAXIMIZE THE CLEAR ROADSIDE AREA BY INSTALLING THE PROPOSED GUARDRAIL A MINIMUM OF 14 FT FROM THE CENTERLINE OF U.S. ROUTE 4 OR AS DIRECTED BY THE RESIDENT ENGINEER. ANY REQUIRED EXCAVATION OR THE PLACEMENT OF AGGREGATE SHOULDER MATERIAL FOR ADDITIONAL BACKUP WILL BE COMPLETED AND PAID FOR UNDER THE APPLICABLE ITEM(S) AS DIRECTED BY THE RESIDENT ENGINEER.

646.402 DURABLE 4 INCH WHITE LINE, THERMOPLASTIC
 (ALL LINES WILL INCLUDE EDGE LINE BREAKS AND RADIUS FOR TOWN HIGHWAYS)
 BRIDGEWATER:
 STA. 352+00.00 - STA. 368+00.00 LT & RT

646.412 DURABLE 4 INCH YELLOW LINE, THERMOPLASTIC
 (ALL LINES WILL INCLUDE C/L BREAKS FOR TOWN HIGHWAYS) S=SOLID, D=DASHED
 BRIDGEWATER:
 STA. 352+00.00 - STA. 368+00.00 LT C RT
 S - S

646.602 TEMPORARY 4 INCH WHITE LINE, PAINT
 (ALL LINES WILL INCLUDE EDGE LINE BREAKS AND RADIUS FOR TOWN HIGHWAYS)
 BRIDGEWATER:
 STA. 352+00.00 - STA. 368+00.00 LT & RT



646.612 TEMPORARY 4 INCH YELLOW LINE, PAINT
 (ALL LINES WILL INCLUDE C/L BREAKS FOR TOWN HIGHWAYS) S=SOLID, D=DASHED
 BRIDGEWATER:
 STA. 352+00.00 - STA. 368+00.00 LT C RT
 S - S

675.50 REMOVING SIGNS
 AS SHOWN - 13

675.60 ERECTING SALVAGED SIGNS
 AS SHOWN - 3

BITUMINOUS CONCRETE GUTTER
 356+00 - 358+37 LT

STA. 354+01.0, LT STA. 354+01.0, LT

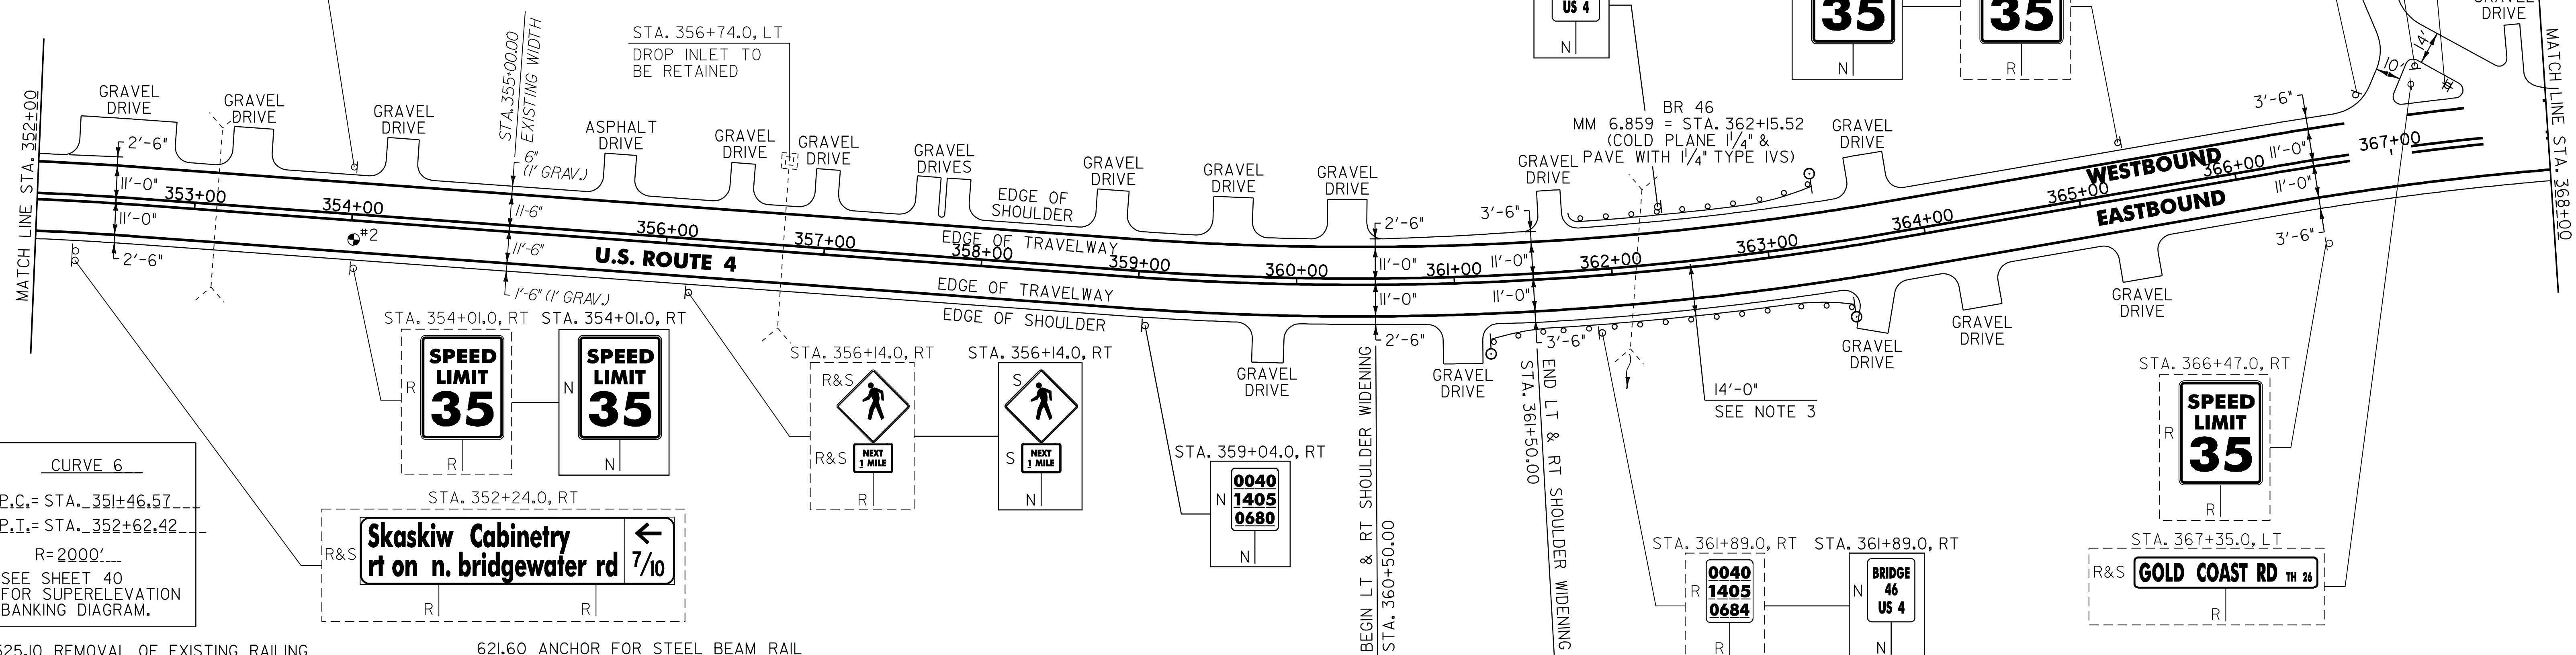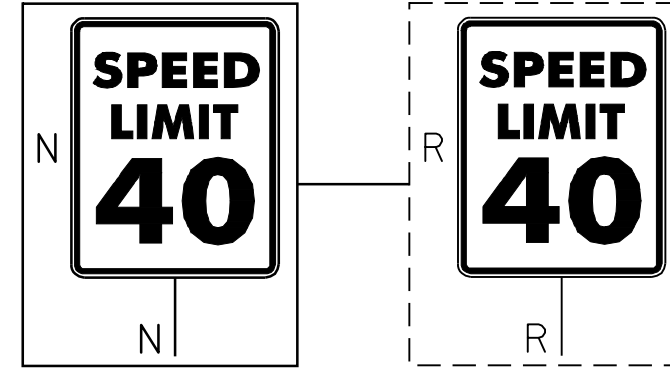

CURVE 6
 P.C. = STA. 351+46.57
 P.T. = STA. 352+62.42
 R = 2000'
 SEE SHEET 40 FOR SUPERELEVATION BANKING DIAGRAM.

525.10 REMOVAL OF EXISTING RAILING

BRIDGEWATER:
 STA. 361+95.8 - STA. 362+27.1 RT (31.3 LF)
 STA. 362+98.8 - STA. 362+30.1 LT (31.3 LF)

621.20 STEEL BEAM GUARDRAIL (GALVANIZED)

BRIDGEWATER:
~~STA. 361+58.3 - STA. 361+70.8 RT (12.5 LF)~~
~~STA. 362+58.4 - STA. 362+95.9 RT (37.5 LF) 77.1~~
~~STA. 362+61.4 - STA. 363+11.4 LT (50.0 LF) 25~~
 52.1 25 55.1 32.5

621.21 HD STEEL BEAM GUARDRAIL, GALVANIZED

BRIDGEWATER:
 STA. 361+70.8 - STA. 361+95.8 RT (24.0 LF)
 STA. 361+71.8 - STA. 361+98.8 LT (27.0 LF) 2675
 STA. 362+27.1 - STA. 362+58.4 RT (31.3 LF) 32.5
 STA. 362+30.1 - STA. 362+61.4 LT (31.3 LF)
 55.1 32.5

~~621.50 MANUFACTURED TERMINAL SECTION, FLARED~~

BRIDGEWATER:
~~STA. 361+20.8 - STA. 361+58.3 RT~~
~~STA. 362+95.9 - STA. 363+33.4 RT~~
~~STA. 363+11.4 - STA. 363+48.9 LT~~

621.60 ANCHOR FOR STEEL BEAM RAIL

BRIDGEWATER:
 STA. 361+70.8 RT
 STA. 361+81.3 LT
 80 362+67.6 RT
 362+67.6 LT

621.80 REMOVAL AND DISPOSAL OF GUARDRAIL

BRIDGEWATER:
 STA. 361+89.0 - STA. 361+95.8 RT (6.8 LF)
 STA. 361+90.0 - STA. 361+98.8 LT (8.8 LF)
 STA. 362+27.1 - STA. 362+41.0 RT (13.9 LF)
 STA. 362+30.4 - STA. 362+45.0 LT (14.6 LF)

676.10 DELINEATOR WITH STEEL POST
 ♀ TYPE I WHITE

BRIDGEWATER:
 STA. 361+20.8 RT
 STA. 363+33.4 RT
 STA. 363+48.9 LT

525.60 BRIDGE RAILING REPAIR, TYPE III

BRIDGEWATER:
 STA. 361+95.8 - STA. 362+27.1 RT (31.3 LF)
 STA. 362+98.8 - STA. 362+30.1 LT (31.3 LF)

NOTES:

- PAVING LIMIT ON ALL TOWN HIGHWAYS SHALL BE MEASURED 25 FT BACK FROM U.S. ROUTE 4 EDGE OF SHOULDER UNLESS DENOTED OTHERWISE ON THE PLANS OR AS DIRECTED BY THE RESIDENT ENGINEER.
- SEE SHEET 76 FOR BR 46 DETAILS
- THE CONTRACTOR SHALL MAXIMIZE THE CLEAR ROADSIDE AREA BY INSTALLING THE PROPOSED GUARDRAIL A MINIMUM OF 14 FT FROM THE CENTERLINE OF U.S. ROUTE 4 OR AS DIRECTED BY THE RESIDENT ENGINEER. ANY REQUIRED EXCAVATION OR THE PLACEMENT OF AGGREGATE SHOULDER MATERIAL FOR ADDITIONAL BACKUP WILL BE COMPLETED AND PAID FOR UNDER THE APPLICABLE ITEM(S) AS DIRECTED BY THE RESIDENT ENGINEER.

SIGN LEGEND

- R = REMOVE
- S = SALVAGE
- N = NEW
- RET = RETAIN
- B-B = BACK TO BACK
- EXISTING = - - - - -
- NEW = _____

NOT TO SCALE

PROJECT LAYOUT SHEET #4

PROJECT NAME: BRIDGEWATER - WOODSTOCK
 PROJECT NUMBER: NH_2611(S)

FILE NAME: p06b160.dgn
 PROJECT LEADER: D.E.G.
 DESIGNED BY: D.W.E.
 IPARM FILE: p06b160I04.i
 PLOT DATE: 28-MAY-2010
 DRAWN BY: C.A.K.
 CHECKED BY: D.E.G.
 SHEET 15 OF 80

PAVEMENT CORES =			
TOTAL	DEPTH	PCC	COMMENTS
(INCH)			
2	7 1/2	NO	

646.402 DURABLE 4 INCH WHITE LINE, THERMOPLASTIC
 (ALL LINES WILL INCLUDE EDGE LINE BREAKS AND
 RADIUS FOR TOWN HIGHWAYS)
 BRIDGEWATER:
 STA. 368+00.00 - STA. 384+00.00 LT & RT

646.412 DURABLE 4 INCH YELLOW LINE, THERMOPLASTIC
 (ALL LINES WILL INCLUDE C/L BREAKS FOR
 TOWN HIGHWAYS) S=SOLID, D=DASHED
 BRIDGEWATER:
 STA. 368+00.00 - STA. 384+00.00 LT @ RT
 STA. 383+48.64 DOUBLE SOLID LT, TH-3

646.482 DURABLE 24 INCH STOP BAR, THERMOPLASTIC

BRIDGEWATER:
 STA. 383+48.64 LT, TH-3

646.492 DURABLE LETTER OR SYMBOL, THERMOPLASTIC

BRIDGEWATER:
 STA. 381+30.0 RT, "S,C,H,O,O,L" (6 EA)
 STA. 383+48.64 LT, TH-3 "S,T,O,P" (4 EA)

646.602 TEMPORARY 4 INCH WHITE LINE, PAINT
 (ALL LINES WILL INCLUDE EDGE LINE BREAKS AND
 RADIUS FOR TOWN HIGHWAYS)
 BRIDGEWATER:
 STA. 368+00.00 - STA. 384+00.00 LT & RT

646.612 TEMPORARY 4 INCH YELLOW LINE, PAINT
 (ALL LINES WILL INCLUDE C/L BREAKS FOR
 TOWN HIGHWAYS) S=SOLID, D=DASHED
 BRIDGEWATER:
 STA. 368+00.00 - STA. 384+00.00 LT @ RT
 STA. 383+48.64 DOUBLE SOLID LT, TH-3

646.682 TEMPORARY 24 INCH STOP BAR, PAINT

BRIDGEWATER:
 STA. 383+48.64 LT, TH-3

646.692 TEMPORARY LETTER OR SYMBOL, PAINT


BRIDGEWATER:
 STA. 381+30.0 RT, "S,C,H,O,O,L" (12 EA)
 STA. 383+48.64 LT, TH-3 "S,T,O,P" (8 EA)

675.50 REMOVING SIGNS

AS SHOWN - II

675.60 ERECTING SALVAGED SIGNS

AS SHOWN - I

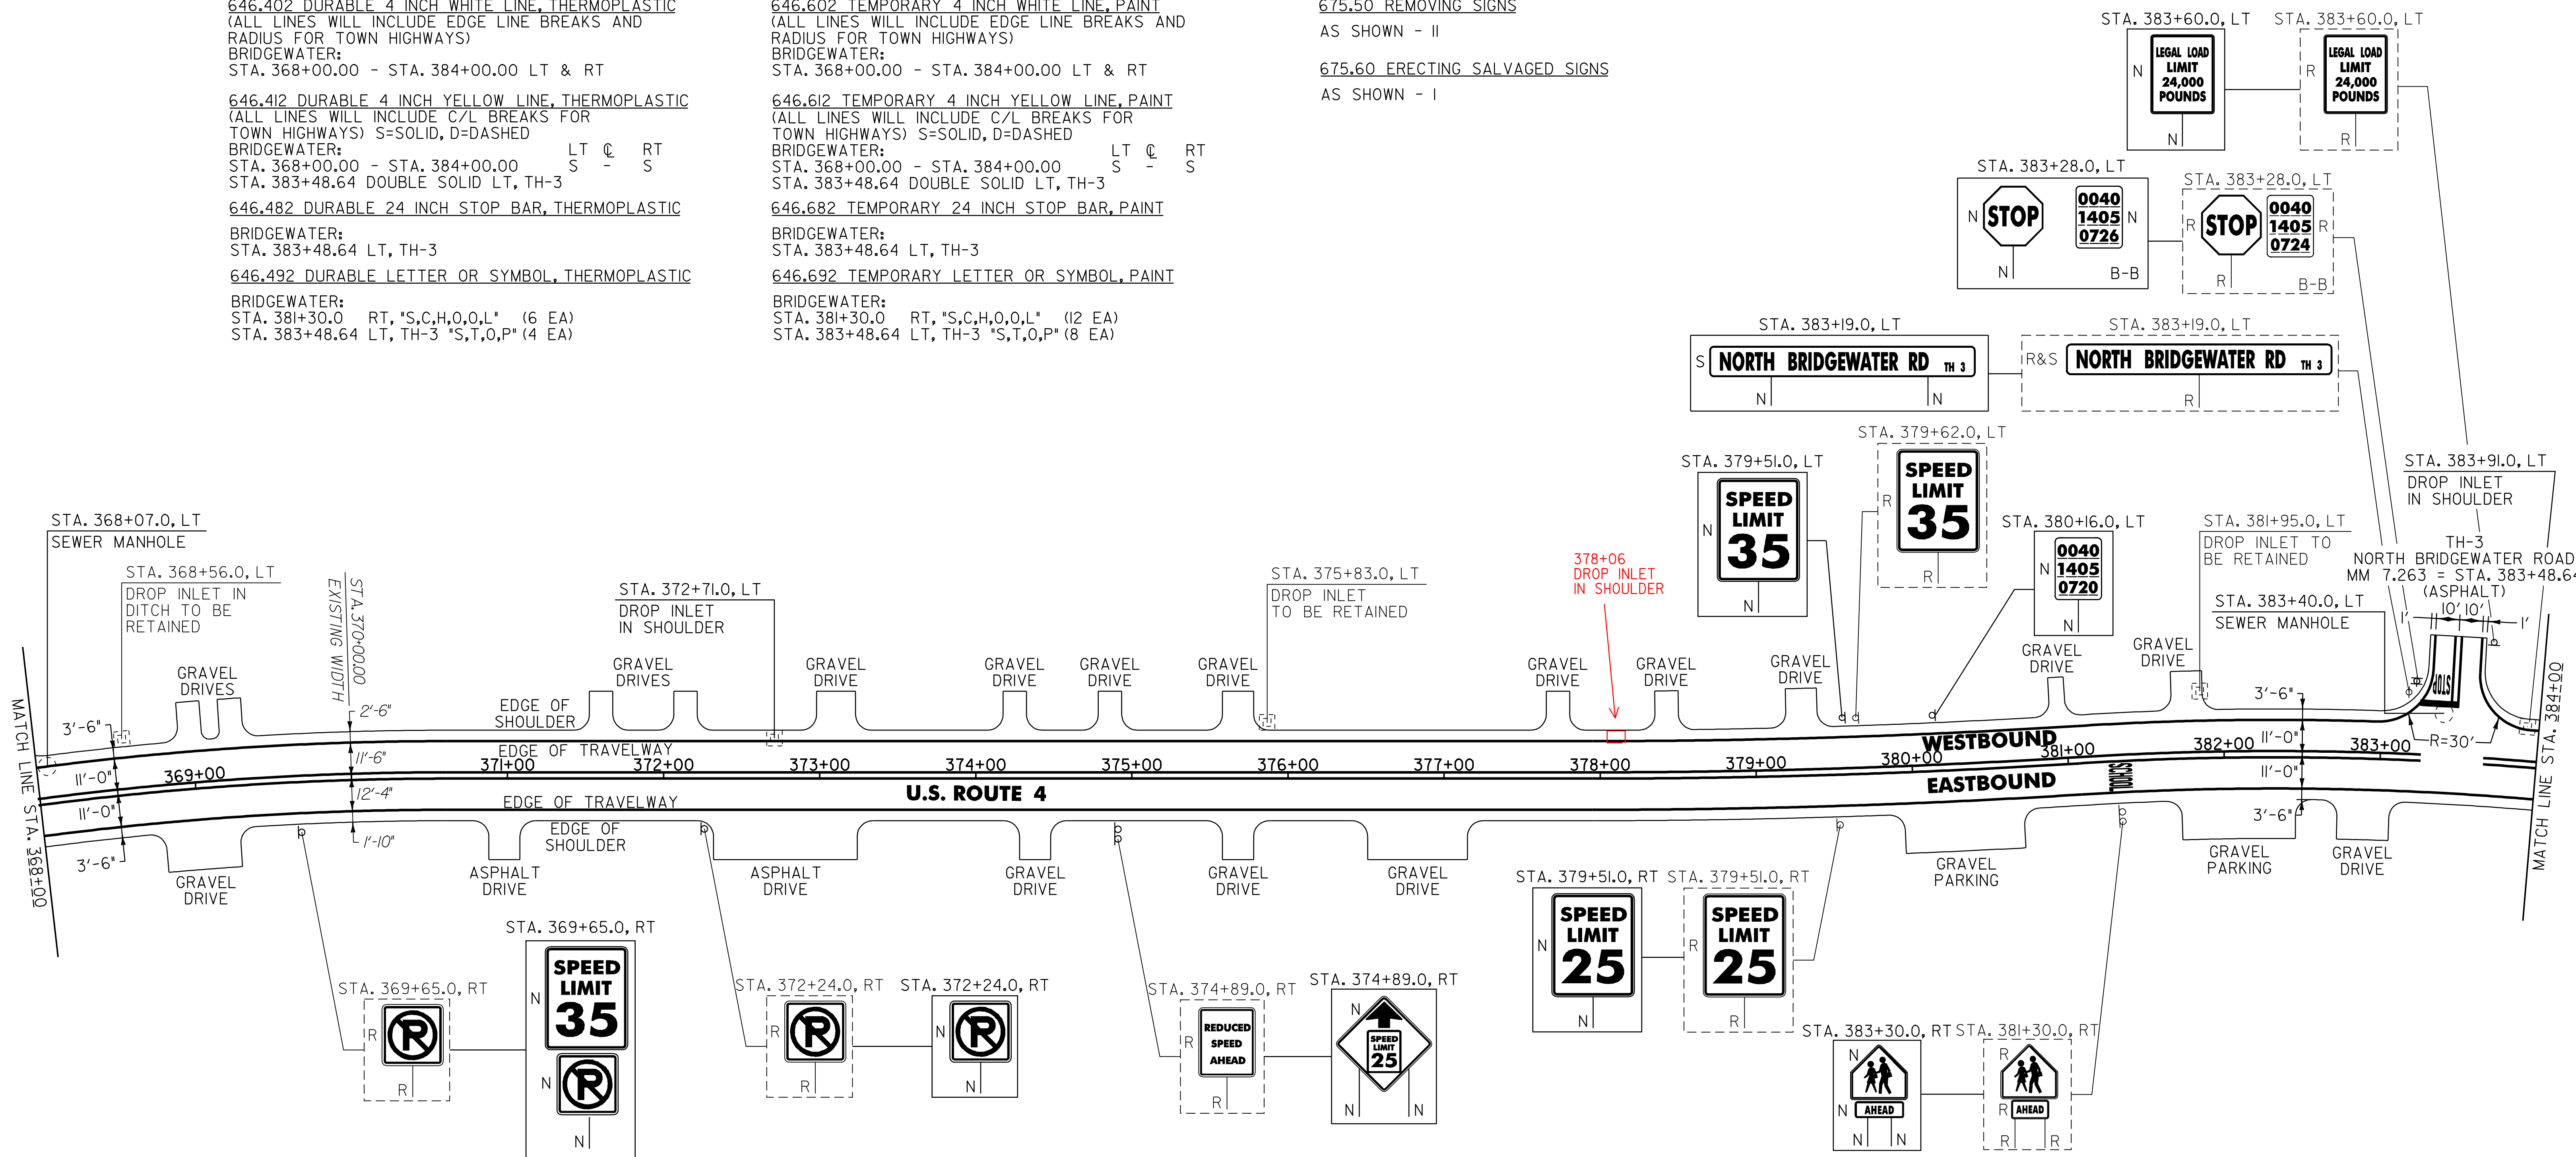

604.412 REHAB. DROP INLETS, CATCH BASINS OR MANHOLE, CLASS I

BRIDGEWATER:
 STA. 372+71.0 LT 378+60 LT
 STA. 383+91.0 LT

604.42 CHANGING ELEVATION OF SEWER MANHOLES

BRIDGEWATER:
 STA. 368+07.0 LT
 STA. 383+40.0 LT

NOTE:

I. PAVING LIMIT ON ALL TOWN HIGHWAYS SHALL BE MEASURED
 25 FT BACK FROM U.S. ROUTE 4 EDGE OF SHOULDER UNLESS
 DENOTED OTHERWISE ON THE PLANS OR AS DIRECTED BY
 THE RESIDENT ENGINEER.

SIGN LEGEND

R = REMOVE
 S = SALVAGE
 N = NEW
 RET = RETAIN
 B-B = BACK TO BACK
 EXISTING = -----
 NEW = _____

NOT TO SCALE

**PROJECT
 LAYOUT
 SHEET #5**

PROJECT NAME: BRIDGEWATER - WOODSTOCK
 PROJECT NUMBER: NH_2611(S)

FILE NAME: p06b160.dgn PLOT DATE: 28-MAY-2010
 PROJECT LEADER: D.E.G. DRAWN BY: C.A.K.
 DESIGNED BY: D.W.E. CHECKED BY: D.E.G.
 IPARM FILE: p06b160105.i SHEET 16 OF 80

646.402 DURABLE 4 INCH WHITE LINE, THERMOPLASTIC
 (ALL LINES WILL INCLUDE EDGE LINE BREAKS AND
 RADIUS FOR TOWN HIGHWAYS)
 BRIDGEWATER:
 STA. 384+00.00 - STA. 396+63.36 LT & RT

WOODSTOCK:
 STA. 0+00.00 - STA. 2+00.00 LT & RT

646.412 DURABLE 4 INCH YELLOW LINE, THERMOPLASTIC
 (ALL LINES WILL INCLUDE C/L BREAKS FOR
 TOWN HIGHWAYS) S=SOLID, D=DASHED
 BRIDGEWATER: LT C RT
 STA. 384+00.00 - STA. 396+63.36 S - S
 STA. 387+81.60 DOUBLE SOLID RT, TH-46

WOODSTOCK:
 STA. 0+00.00 - STA. 2+00.00 S - S

646.602 TEMPORARY 4 INCH WHITE LINE, PAINT
 (ALL LINES WILL INCLUDE EDGE LINE BREAKS AND
 RADIUS FOR TOWN HIGHWAYS)
 BRIDGEWATER:
 STA. 384+00.00 - STA. 396+63.36 LT & RT

WOODSTOCK:
 STA. 0+00.00 - STA. 2+00.00 LT & RT

646.612 TEMPORARY 4 INCH YELLOW LINE, PAINT
 (ALL LINES WILL INCLUDE C/L BREAKS FOR
 TOWN HIGHWAYS) S=SOLID, D=DASHED
 BRIDGEWATER: LT C RT
 STA. 384+00.00 - STA. 396+63.36 S - S
 STA. 387+81.60 DOUBLE SOLID RT, TH-46

WOODSTOCK:
 STA. 0+00.00 - STA. 2+00.00 S - S

646.482 DURABLE 24 INCH STOP BAR, THERMOPLASTIC
 BRIDGEWATER:
 STA. 387+81.60 RT, TH-46

646.492 DURABLE LETTER OR SYMBOL, THERMOPLASTIC
 BRIDGEWATER:
 STA. 387+81.60 RT, TH-46 "S,T,O,P" (4 EA)
 STA. 390+38.0 LT, "S,C,H,O,O,L" (6 EA)

646.682 TEMPORARY 24 INCH STOP BAR, PAINT
 BRIDGEWATER:
 STA. 387+81.60 RT, TH-46

646.692 TEMPORARY LETTER OR SYMBOL, PAINT
 BRIDGEWATER:
 STA. 387+81.60 RT, TH-46 "S,T,O,P" (8 EA)
 STA. 390+38.0 LT, "S,C,H,O,O,L" (12 EA)


646.50 DURABLE CROSSWALK MARKING, TYPE ~~TTAPE~~ THERMOPLASTIC
 BRIDGEWATER:
 STA. 385+40.0, LT/RT

646.702 TEMPORARY CROSSWALK MARKING, PAINT
 BRIDGEWATER:
 STA. 385+40.0, LT/RT

675.50 REMOVING SIGNS
 AS SHOWN - 18

675.60 ERECTING SALVAGED SIGNS
 AS SHOWN - 1


U.S. ROUTE 4
 MM 7.512 = STA. 396+63.36
 MM 0.000 = STA. 0+00.00
 RESUME RECLAIM

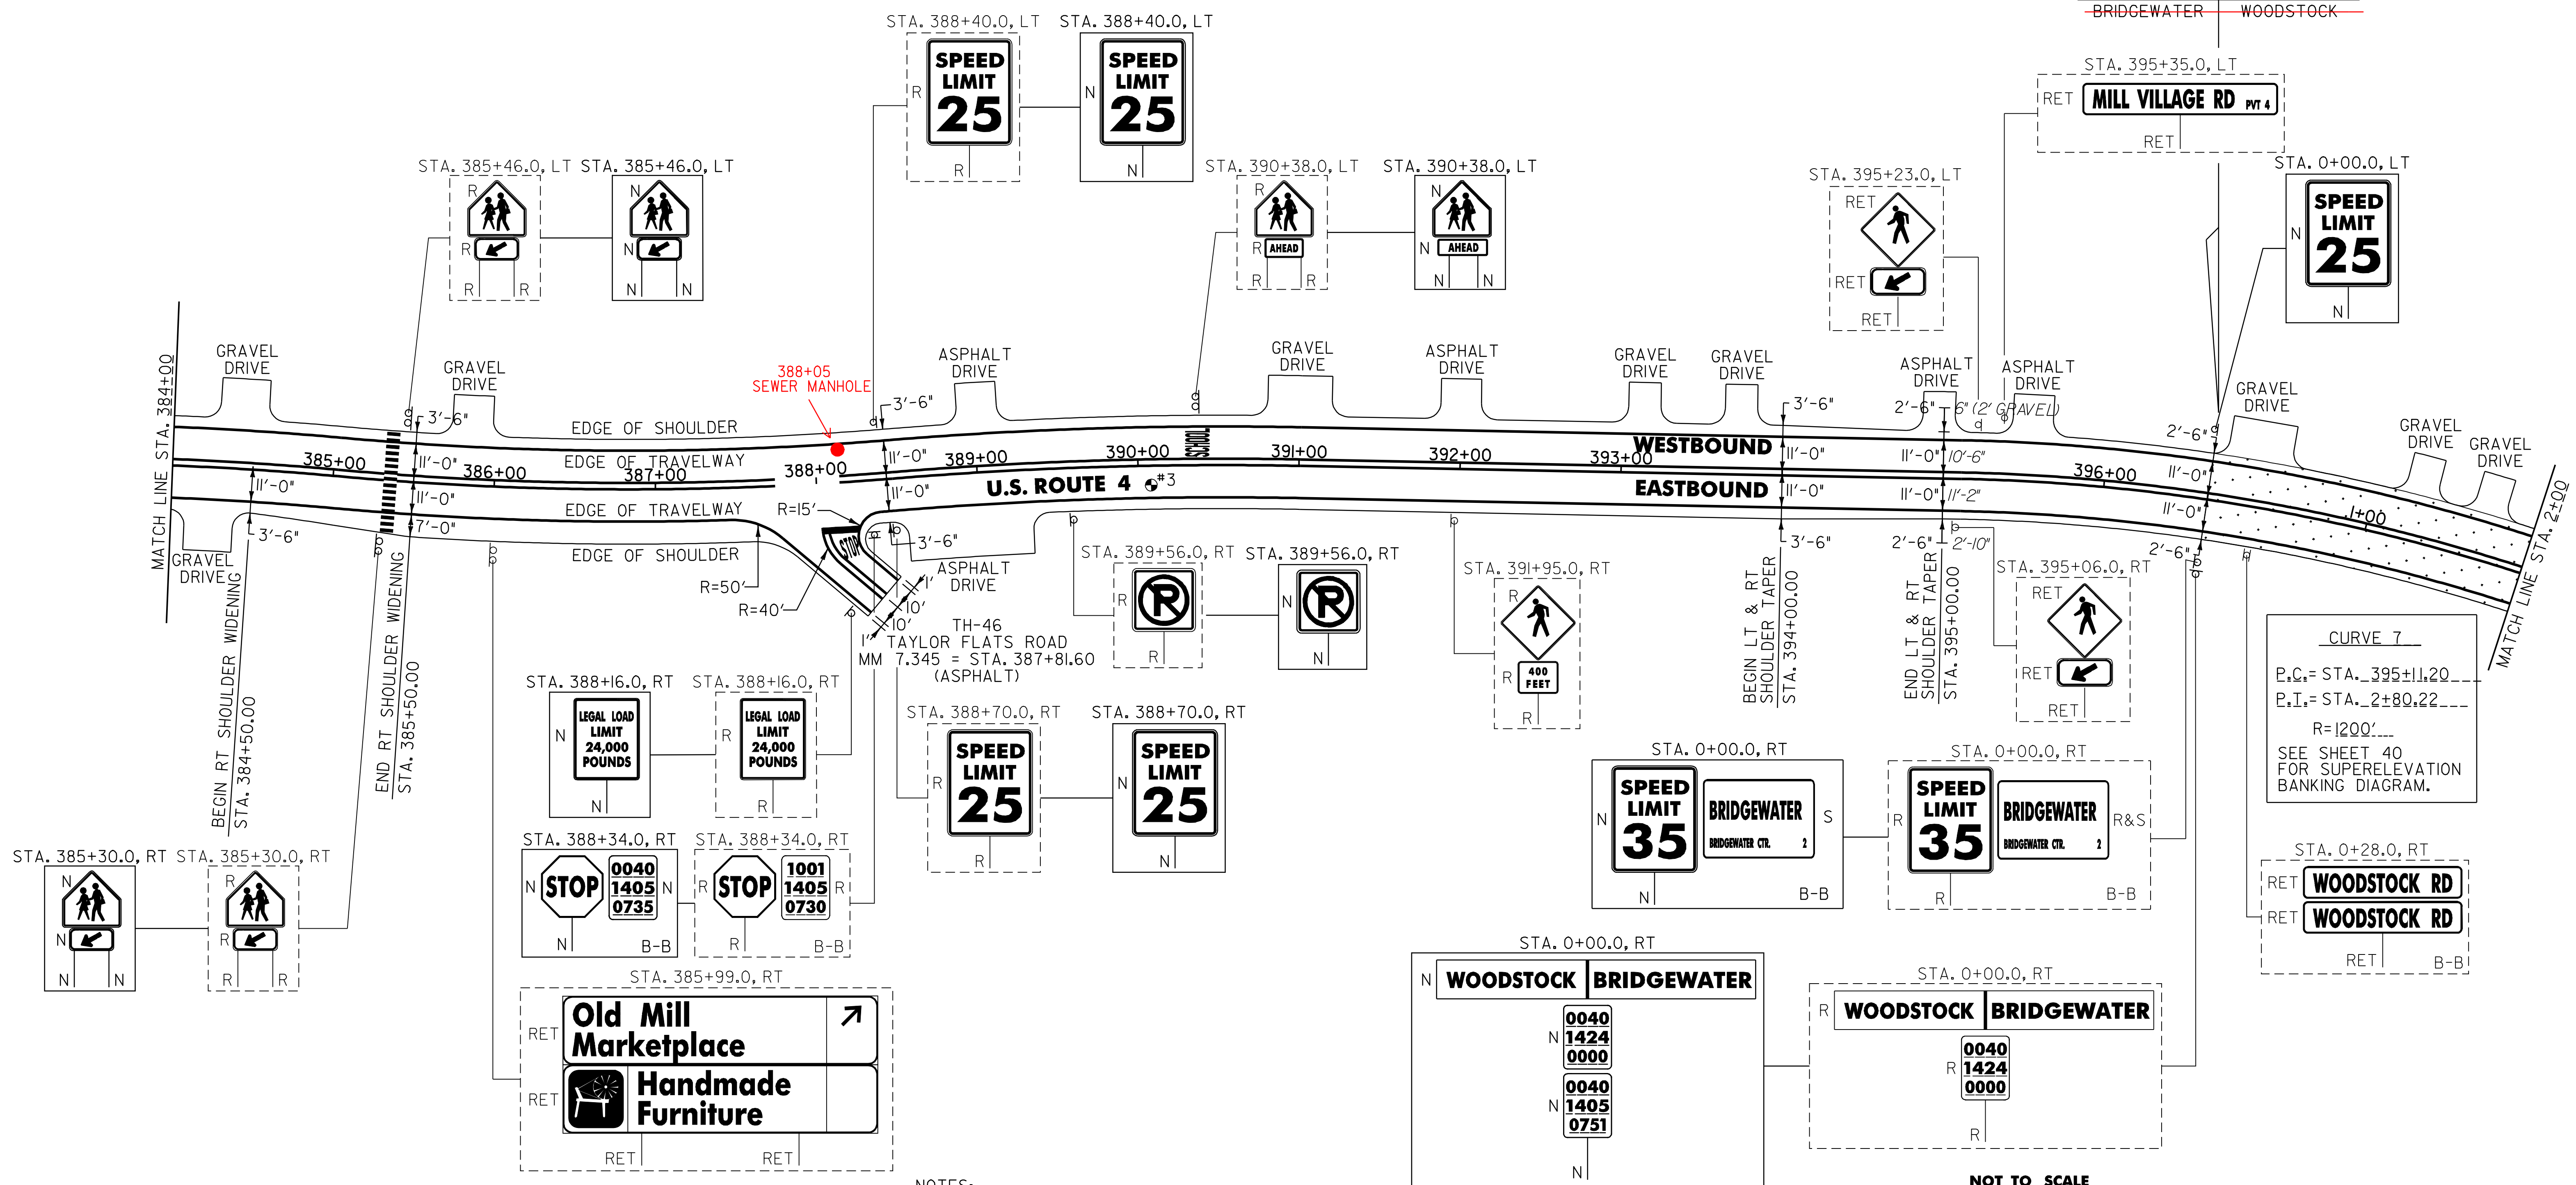

CURVE 7
 P.C. = STA. 395+11.20
 P.T. = STA. 2+80.22
 R = 1200'
 SEE SHEET 40
 FOR SUPERELEVATION
 BANKING DIAGRAM.

PAVEMENT CORES = ●

#	TOTAL DEPTH (INCH)	PCC	COMMENTS
3	10	NO	

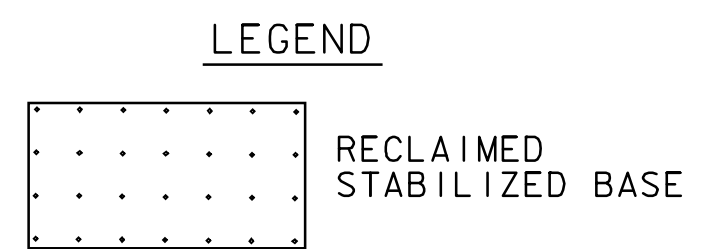

NOTES:

- PAVING LIMIT ON ALL TOWN HIGHWAYS SHALL BE MEASURED 25 FT BACK FROM U.S. ROUTE 4 EDGE OF SHOULDER UNLESS DENOTED OTHERWISE ON THE PLANS OR AS DIRECTED BY THE RESIDENT ENGINEER.
- SEE SHEET 79 FOR DETAIL OF CROSSWALK MARKINGS.

SIGN LEGEND

R = REMOVE
 S = SALVAGE
 N = NEW
 RET = RETAIN
 B-B = BACK TO BACK
 EXISTING =
 NEW =

NOT TO SCALE

PROJECT LAYOUT SHEET #6

PROJECT NAME: BRIDGEWATER - WOODSTOCK
 PROJECT NUMBER: NH_2611(S)

FILE NAME: p06b160.dgn
 PROJECT LEADER: D.E.G.
 DESIGNED BY: D.W.E.
 IPARM FILE: p06b160.i

PLOT DATE: 28-MAY-2010
 DRAWN BY: C.A.K.
 CHECKED BY: D.E.G.
 SHEET 17 OF 80

646.402 DURABLE 4 INCH WHITE LINE, THERMOPLASTIC
 (ALL LINES WILL INCLUDE EDGE LINE BREAKS AND RADIUS FOR TOWN HIGHWAYS)
 WOODSTOCK:
 STA. 2+00.00 - STA. 16+00.00 LT & RT

646.412 DURABLE 4 INCH YELLOW LINE, THERMOPLASTIC
 (ALL LINES WILL INCLUDE C/L BREAKS FOR TOWN HIGHWAYS) S=SOLID, D=DASHED
 WOODSTOCK:
 STA. 2+00.00 - STA. 16+00.00 LT & RT
 STA. 4+96.32 MEDIAN EDGE LINE RT, TH-97

646.482 DURABLE 24 INCH STOP BAR, THERMOPLASTIC
 WOODSTOCK:
 STA. 4+96.32 RT, TH-97

646.492 DURABLE LETTER OR SYMBOL, THERMOPLASTIC
 WOODSTOCK:
 STA. 4+96.32 RT, TH-97 'S,T,O,P' (4 EA)

646.602 TEMPORARY 4 INCH WHITE LINE, PAINT
 (ALL LINES WILL INCLUDE EDGE LINE BREAKS AND RADIUS FOR TOWN HIGHWAYS)
 WOODSTOCK:
 STA. 2+00.00 - STA. 16+00.00 LT & RT


646.612 TEMPORARY 4 INCH YELLOW LINE, PAINT
 (ALL LINES WILL INCLUDE C/L BREAKS FOR TOWN HIGHWAYS) S=SOLID, D=DASHED
 WOODSTOCK:
 STA. 2+00.00 - STA. 16+00.00 LT & RT
 STA. 4+96.32 MEDIAN EDGE LINE RT, TH-97

646.682 TEMPORARY 24 INCH STOP BAR, PAINT
 WOODSTOCK:
 STA. 4+96.32 RT, TH-97



646.692 TEMPORARY LETTER OR SYMBOL, PAINT
 WOODSTOCK:
 STA. 4+96.32 RT, TH-97 'S,T,O,P' (8 EA)

675.50 REMOVING SIGNS
 AS SHOWN - 12

675.60 ERECTING SALVAGED SIGNS
 AS SHOWN - 2

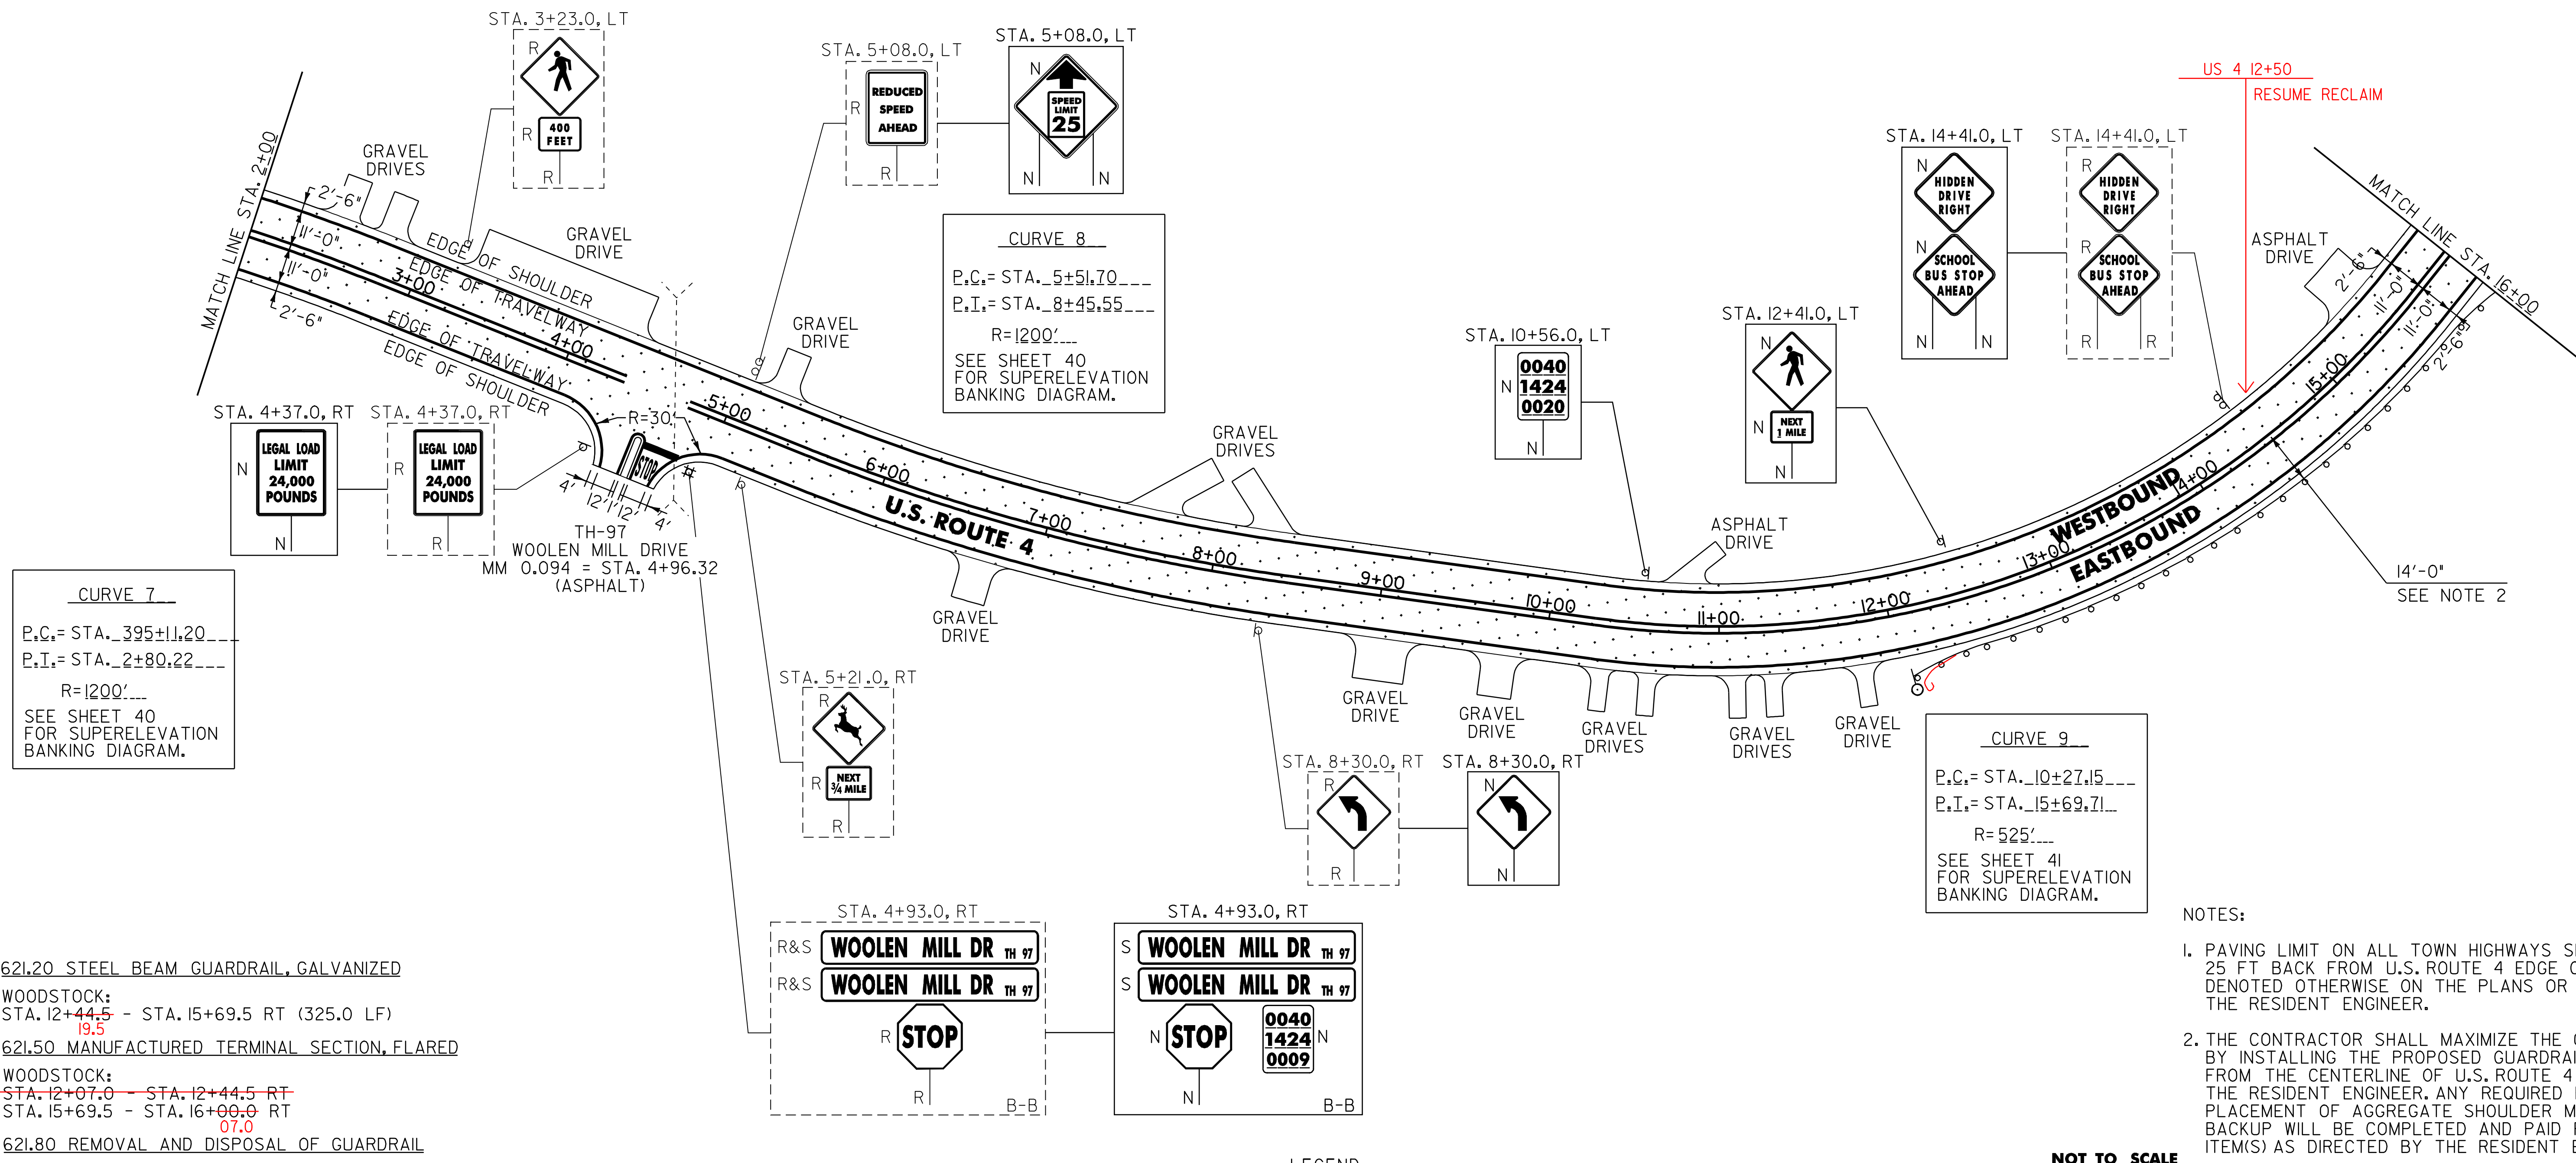

621.20 STEEL BEAM GUARDRAIL, GALVANIZED
 WOODSTOCK:
 STA. 12+44.5 - STA. 15+69.5 RT (325.0 LF)
 19.5
 621.50 MANUFACTURED TERMINAL SECTION, FLARED
 WOODSTOCK:
 STA. 12+07.0 - STA. 12+44.5 RT
 STA. 15+69.5 - STA. 16+00.0 RT
 07.0
 621.80 REMOVAL AND DISPOSAL OF GUARDRAIL
 WOODSTOCK:
 STA. 12+51.0 - STA. 16+00.0 RT (349.0 LF)
 07.0
 676.10 DELINEATOR WITH STEEL POST
 ANCHOR FOR STEEL BEAM GUARDRAIL
 12+19.5 RT
 ♀ TYPE I WHITE
 WOODSTOCK:
 STA. 12+07.0 RT

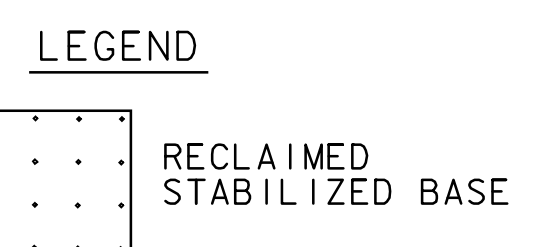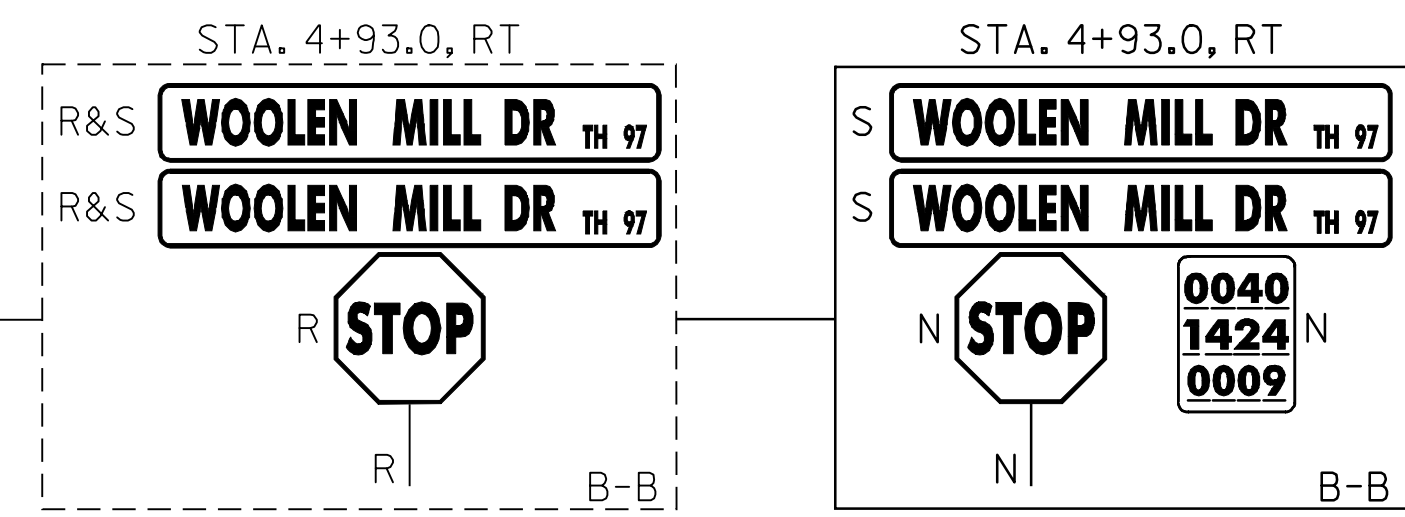

SIGN LEGEND
 R = REMOVE
 S = SALVAGE
 N = NEW
 RET = RETAIN
 B-B = BACK TO BACK
 EXISTING = -----
 NEW = -----

NOTES:
 1. PAVING LIMIT ON ALL TOWN HIGHWAYS SHALL BE MEASURED 25 FT BACK FROM U.S. ROUTE 4 EDGE OF SHOULDER UNLESS DENOTED OTHERWISE ON THE PLANS OR AS DIRECTED BY THE RESIDENT ENGINEER.
 2. THE CONTRACTOR SHALL MAXIMIZE THE CLEAR ROADSIDE AREA BY INSTALLING THE PROPOSED GUARDRAIL A MINIMUM OF 14 FT FROM THE CENTERLINE OF U.S. ROUTE 4 OR AS DIRECTED BY THE RESIDENT ENGINEER. ANY REQUIRED EXCAVATION OR THE PLACEMENT OF AGGREGATE SHOULDER MATERIAL FOR ADDITIONAL BACKUP WILL BE COMPLETED AND PAID FOR UNDER THE APPLICABLE ITEM(S) AS DIRECTED BY THE RESIDENT ENGINEER.

PROJECT LAYOUT SHEET #7	PROJECT NAME: BRIDGEWATER - WOODSTOCK	
	PROJECT NUMBER: NH_2611(S)	
	FILE NAME: p06b160.dgn	PLOT DATE: 28-MAY-2010
	PROJECT LEADER: D.E.G.	DRAWN BY: C.A.K.
DESIGNED BY: D.W.E.	CHECKED BY: D.E.G.	
IPARM FILE: p06b160I07.i	SHEET 18 OF 80	


646.402 DURABLE 4 INCH YELLOW LINE, THERMOPLASTIC
 (ALL LINES WILL INCLUDE EDGE LINE BREAKS AND
 RADIUS FOR TOWN HIGHWAYS)
 WOODSTOCK:
 STA. 16+00.00 - STA. 32+00.00 LT & RT

646.412 DURABLE 4 INCH YELLOW LINE, THERMOPLASTIC
 (ALL LINES WILL INCLUDE C/L BREAKS FOR
 TOWN HIGHWAYS) S=SOLID, D=DASHED
 WOODSTOCK:
 STA. 16+00.00 - STA. 16+89.60 S - S
 STA. 16+89.60 - STA. 22+44.00 S - D
 STA. 22+44.00 - STA. 29+83.20 - D -
 STA. 29+83.20 - STA. 32+00.00 D - S

646.602 TEMPORARY 4 INCH WHITE LINE, PAINT
 (ALL LINES WILL INCLUDE EDGE LINE BREAKS AND
 RADIUS FOR TOWN HIGHWAYS)
 WOODSTOCK:
 STA. 16+00.00 - STA. 32+00.00 LT & RT

646.612 TEMPORARY 4 INCH YELLOW LINE, PAINT
 (ALL LINES WILL INCLUDE C/L BREAKS FOR
 TOWN HIGHWAYS) S=SOLID, D=DASHED
 WOODSTOCK:
 STA. 16+00.00 - STA. 16+89.60 S - S
 STA. 16+89.60 - STA. 22+44.00 S - D
 STA. 22+44.00 - STA. 29+83.20 - D -
 STA. 29+83.20 - STA. 32+00.00 D - S

675.50 REMOVING SIGNS
 AS SHOWN - IO

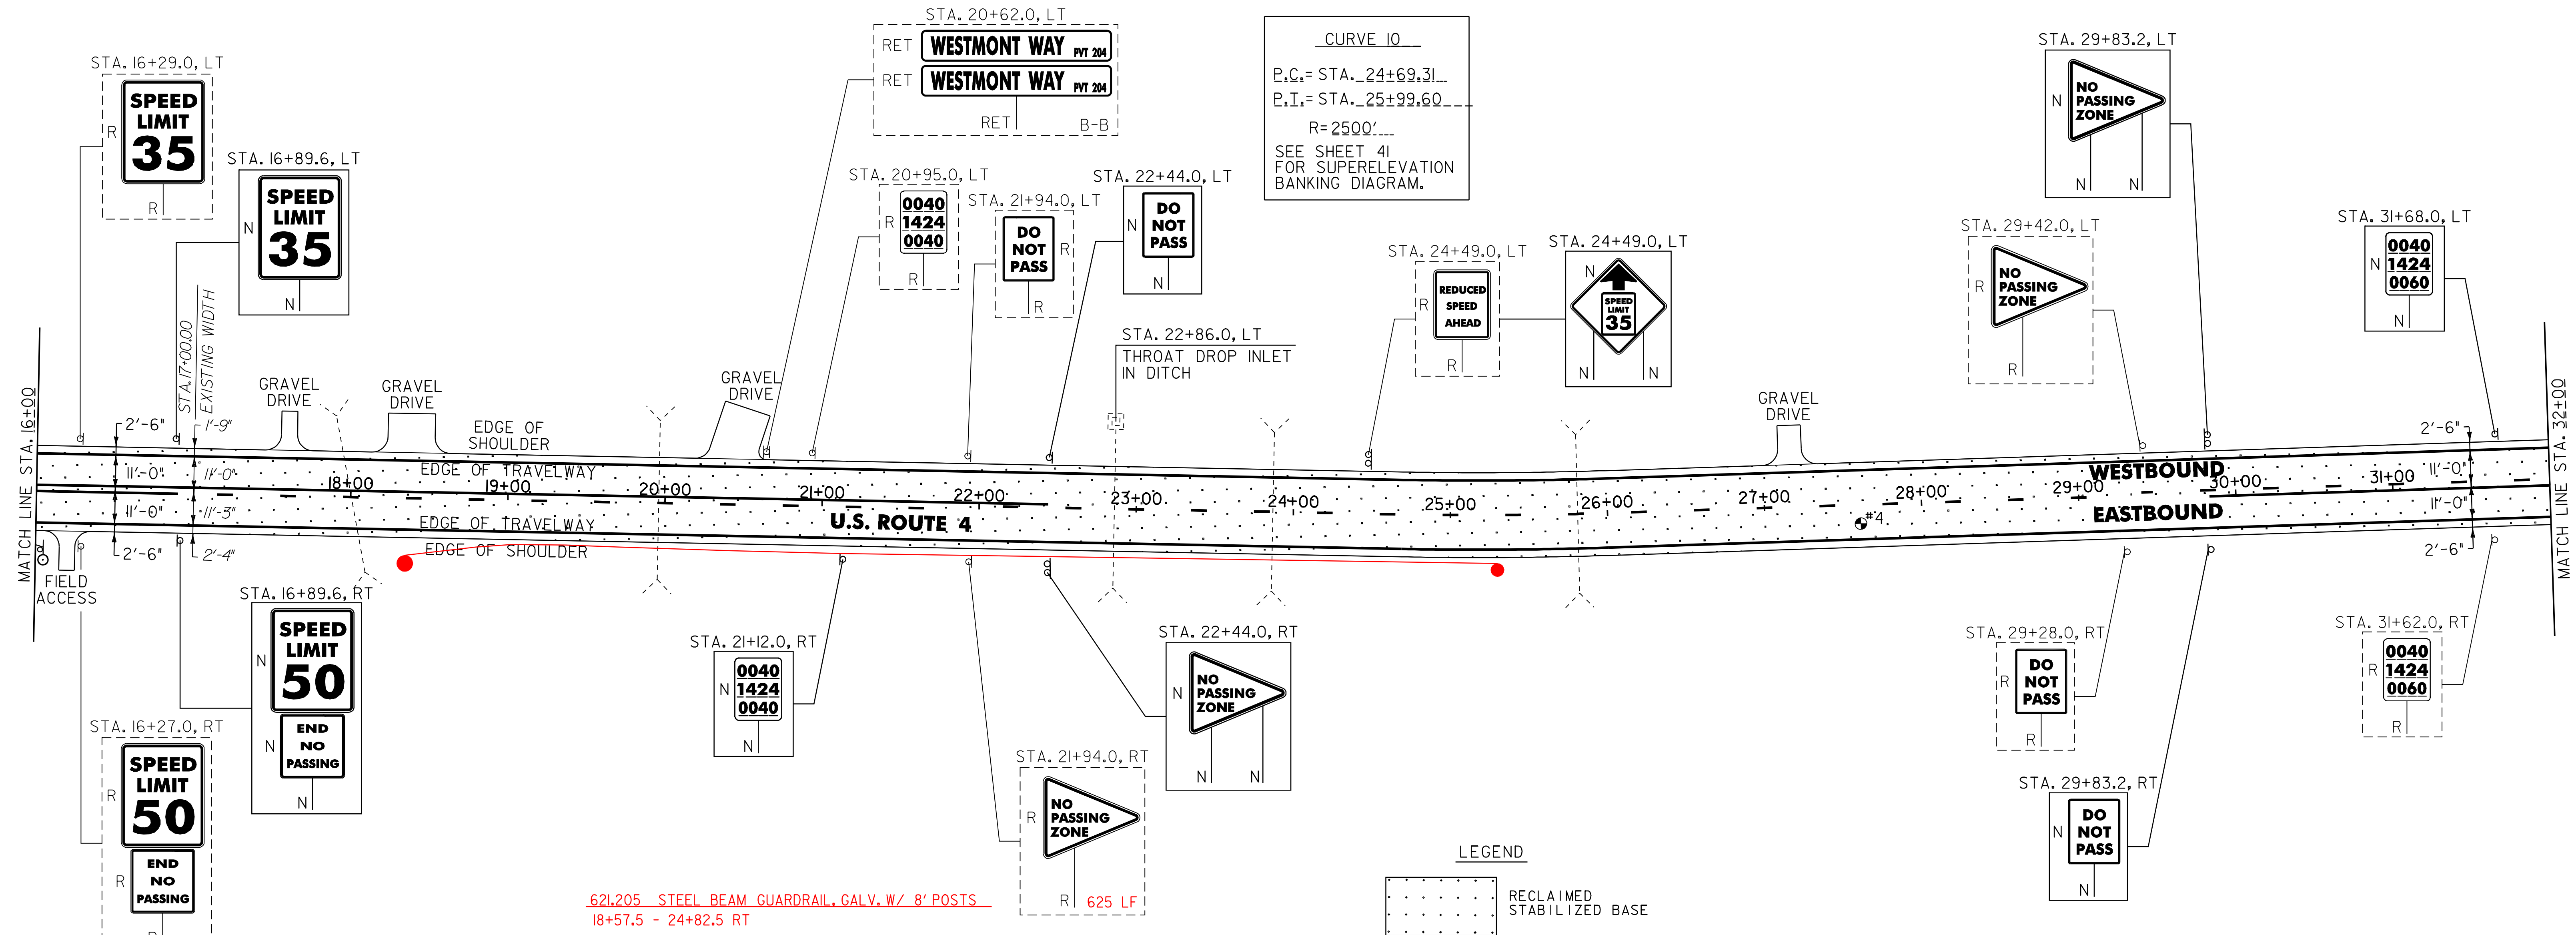

621.205 STEEL BEAM GUARDRAIL, GALV. W/ 8' POSTS
 18+57.5 - 24+82.5 RT

621.50 MANUFACTURED TERMINAL SECTION, FLARED
 WOODSTOCK:
 STA. 16+00.0 - STA. 16+07.0 RT
 15+69.5

18+20 - 18+57.5 RT
 24+82.5 - 25+20 RT

PAVEMENT CORES = ●

#	DEPTH (INCH)	PCC	COMMENTS
4	8	NO	

LEGEND

[Dotted Box]	RECLAIMED STABILIZED BASE
--------------	---------------------------

SIGN LEGEND
 R = REMOVE
 S = SALVAGE
 N = NEW
 RET = RETAIN
 B-B = BACK TO BACK
 EXISTING = - - - - -
 NEW = _____

NOT TO SCALE

PROJECT LAYOUT SHEET #8	PROJECT NAME: BRIDGEWATER - WOODSTOCK	PLOT DATE: 28-MAY-2010
	PROJECT NUMBER: NH_2611(S)	DRAWN BY: C.A.K.
	FILE NAME: p06b16Q.dgn	CHECKED BY: D.E.G.
	DESIGNED BY: D.W.E.	SHEET 19 OF 80

604.412 REHAB. DROP INLETS, CATCH BASINS OR MANHOLE, CLASS I
 WOODSTOCK:
 STA. 22+86.0 LT

621.80 REMOVAL AND DISPOSAL OF GUARDRAIL
 WOODSTOCK:
 STA. 16+00.0 - STA. 16+07.0 RT (7.0 LF)

676.10 DELINEATOR WITH STEEL POST
 ♀ TYPE I WHITE

WOODSTOCK:
 STA. 16+07.0 RT

646.402 DURABLE 4 INCH WHITE LINE, THERMOPLASTIC
 (ALL LINES WILL INCLUDE EDGE LINE BREAKS AND RADIUS FOR TOWN HIGHWAYS)
 WOODSTOCK:
 STA. 32+00.00 - STA. 48+00.00 LT & RT

646.412 DURABLE 4 INCH YELLOW LINE, THERMOPLASTIC
 (ALL LINES WILL INCLUDE C/L BREAKS FOR TOWN HIGHWAYS) S=SOLID, D=DASHED
 WOODSTOCK:
 STA. 32+00.00 - STA. 36+16.80 LT @ RT
 STA. 36+16.80 - STA. 48+00.00 D - S
 STA. 44+88.00 DOUBLE SOLID LT, TH-13

646.482 DURABLE 24 INCH STOP BAR, THERMOPLASTIC
 WOODSTOCK:
 STA. 44+88.00 LT, TH-13


646.492 DURABLE LETTER OR SYMBOL, THERMOPLASTIC
 WOODSTOCK:
 STA. 44+88.00 LT, TH-13 "S,T,O,P" (4 EA)

646.602 TEMPORARY 4 INCH WHITE LINE, PAINT
 (ALL LINES WILL INCLUDE EDGE LINE BREAKS AND RADIUS FOR TOWN HIGHWAYS)
 WOODSTOCK:
 STA. 32+00.00 - STA. 48+00.00 LT & RT

646.612 TEMPORARY 4 INCH YELLOW LINE, PAINT
 (ALL LINES WILL INCLUDE C/L BREAKS FOR TOWN HIGHWAYS) S=SOLID, D=DASHED
 WOODSTOCK:
 STA. 32+00.00 - STA. 36+16.80 LT @ RT
 STA. 36+16.80 - STA. 48+00.00 D - S
 STA. 44+88.00 DOUBLE SOLID LT, TH-13

675.50 REMOVING SIGNS
 AS SHOWN - 10

675.60 ERECTING SALVAGED SIGNS
 AS SHOWN - 2

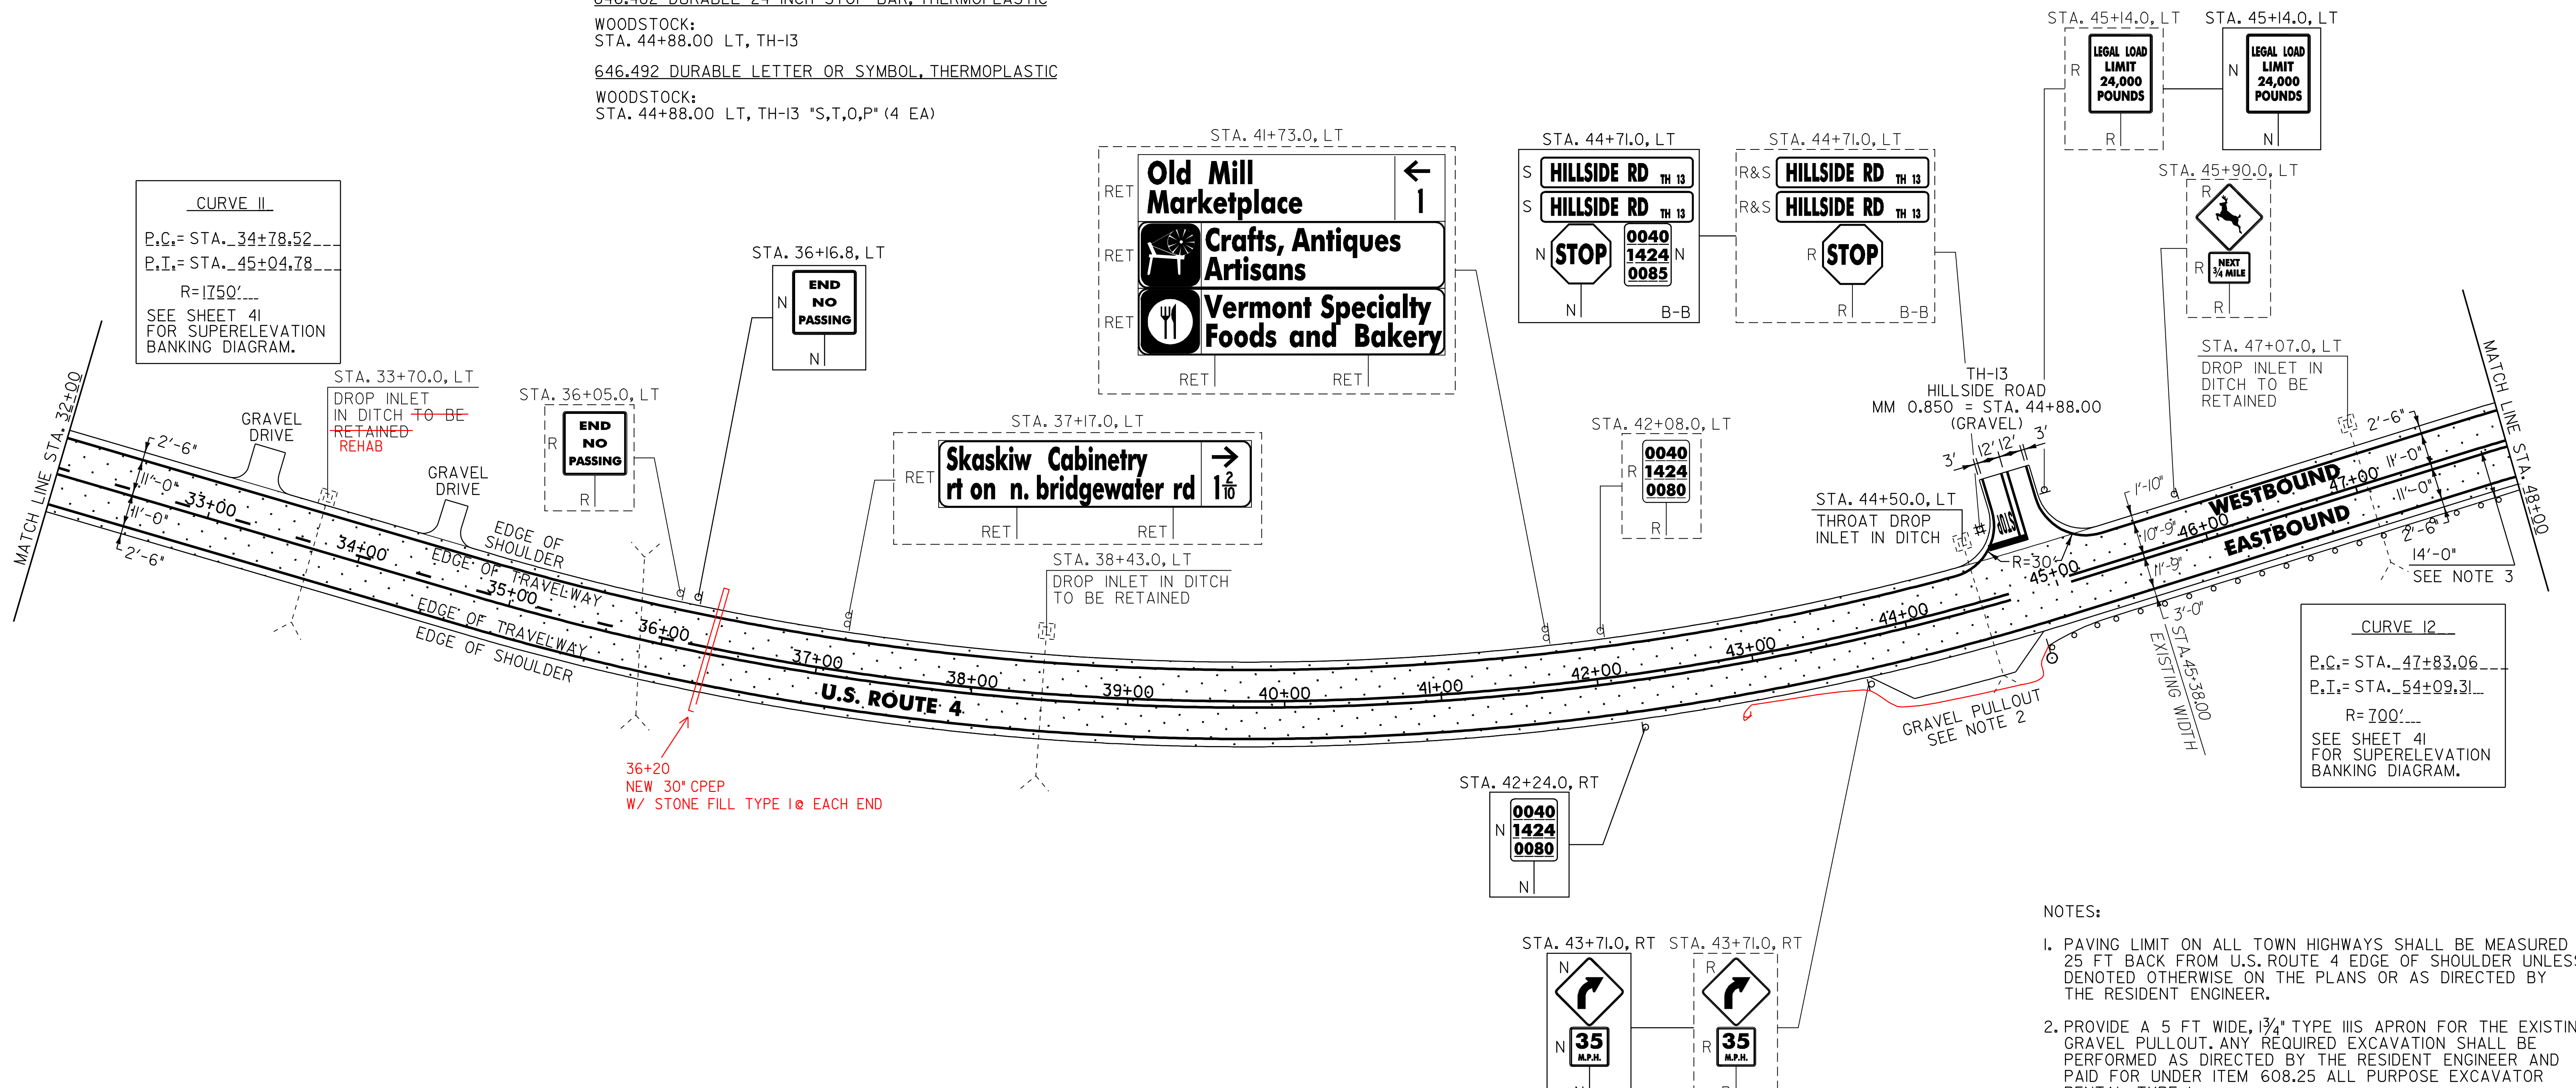

CURVE 11
 P.C. = STA. 34+78.52
 P.T. = STA. 45+04.78
 R = 1750'
 SEE SHEET 41 FOR SUPERELEVATION BANKING DIAGRAM.

CURVE 12
 P.C. = STA. 47+83.06
 P.T. = STA. 54+09.31
 R = 700'
 SEE SHEET 41 FOR SUPERELEVATION BANKING DIAGRAM.

LEGEND
 [Symbol] RECLAIMED STABILIZED BASE

604.412 REHAB. DROP INLETS, CATCH BASINS OR MANHOLE, CLASS I
 WOODSTOCK:
 STA. 44+50.0 LT 33+70 LT
 621.20 STEEL BEAM GUARDRAIL, GALVANIZED
 WOODSTOCK:
 STA. 45+20.5 - STA. 48+00.0 RT (279.5 LF) 483
 43+17
 621.50 MANUFACTURED TERMINAL SECTION, FLARED
 WOODSTOCK:
 STA. 44+83.0 - STA. 45+20.5 RT 42+79.5 43+17
 621.80 REMOVAL AND DISPOSAL OF GUARDRAIL
 WOODSTOCK:
 STA. 44+83.0 - STA. 48+00.0 RT (317.0 LF)

676.10 DELINEATOR WITH STEEL POST
 TYPE I WHITE
 WOODSTOCK:
 STA. 44+83.0 RT

STA. 42+24.0, RT
 0040
 1424
 0080

STA. 43+71.0, RT STA. 43+71.0, RT
 35 M.P.H. 35 M.P.H.

SIGN LEGEND
 R = REMOVE
 S = SALVAGE
 N = NEW
 RET = RETAIN
 B-B = BACK TO BACK
 EXISTING = [Symbol]
 NEW = [Symbol]

- NOTES:**
- PAVING LIMIT ON ALL TOWN HIGHWAYS SHALL BE MEASURED 25 FT BACK FROM U.S. ROUTE 4 EDGE OF SHOULDER UNLESS DENOTED OTHERWISE ON THE PLANS OR AS DIRECTED BY THE RESIDENT ENGINEER.
 - PROVIDE A 5 FT WIDE, 1 3/4" TYPE III APRON FOR THE EXISTING GRAVEL PULLOUT. ANY REQUIRED EXCAVATION SHALL BE PERFORMED AS DIRECTED BY THE RESIDENT ENGINEER AND PAID FOR UNDER ITEM 608.25 ALL PURPOSE EXCAVATOR RENTAL, TYPE I.
 - THE CONTRACTOR SHALL MAXIMIZE THE CLEAR ROADSIDE AREA BY INSTALLING THE PROPOSED GUARDRAIL A MINIMUM OF 14 FT FROM THE CENTERLINE OF U.S. ROUTE 4 OR AS DIRECTED BY THE RESIDENT ENGINEER. ANY REQUIRED EXCAVATION OR THE PLACEMENT OF AGGREGATE SHOULDER MATERIAL FOR ADDITIONAL BACKUP WILL BE COMPLETED AND PAID FOR UNDER THE APPLICABLE ITEM(S) AS DIRECTED BY RESIDENT ENGINEER.

PROJECT LAYOUT SHEET #9	PROJECT NAME: BRIDGEWATER - WOODSTOCK	PLOT DATE: 28-MAY-2010
	PROJECT NUMBER: NH_2611(S)	DRAWN BY: C.A.K.
	FILE NAME: p06b160.dgn	CHECKED BY: D.E.G.
	DESIGNED BY: D.W.E.	SHEET 20 OF 80


646.402 DURABLE 4 INCH WHITE LINE, THERMOPLASTIC
 (ALL LINES WILL INCLUDE EDGE LINE BREAKS AND RADIUS FOR TOWN HIGHWAYS)
 WOODSTOCK:
 STA. 48+00.00 - STA. 64+00.00 LT & RT

646.412 DURABLE 4 INCH YELLOW LINE, THERMOPLASTIC
 (ALL LINES WILL INCLUDE C/L BREAKS FOR TOWN HIGHWAYS) S=SOLID, D=DASHED
 WOODSTOCK:
 STA. 48+00.00 - STA. 54+38.40 S - S
 STA. 54+38.40 - STA. 61+35.40 S - D
 STA. 61+35.40 - STA. 64+00.00 D - S

646.602 TEMPORARY 4 INCH WHITE LINE, PAINT
 (ALL LINES WILL INCLUDE EDGE LINE BREAKS AND RADIUS FOR TOWN HIGHWAYS)
 WOODSTOCK:
 STA. 48+00.00 - STA. 64+00.00 LT & RT

646.612 TEMPORARY 4 INCH YELLOW LINE, PAINT
 (ALL LINES WILL INCLUDE C/L BREAKS FOR TOWN HIGHWAYS) S=SOLID, D=DASHED
 WOODSTOCK:
 STA. 48+00.00 - STA. 54+38.40 S - S
 STA. 54+38.40 - STA. 61+35.40 S - D
 STA. 61+35.40 - STA. 64+00.00 D - S

675.50 REMOVING SIGNS
 AS SHOWN - 9

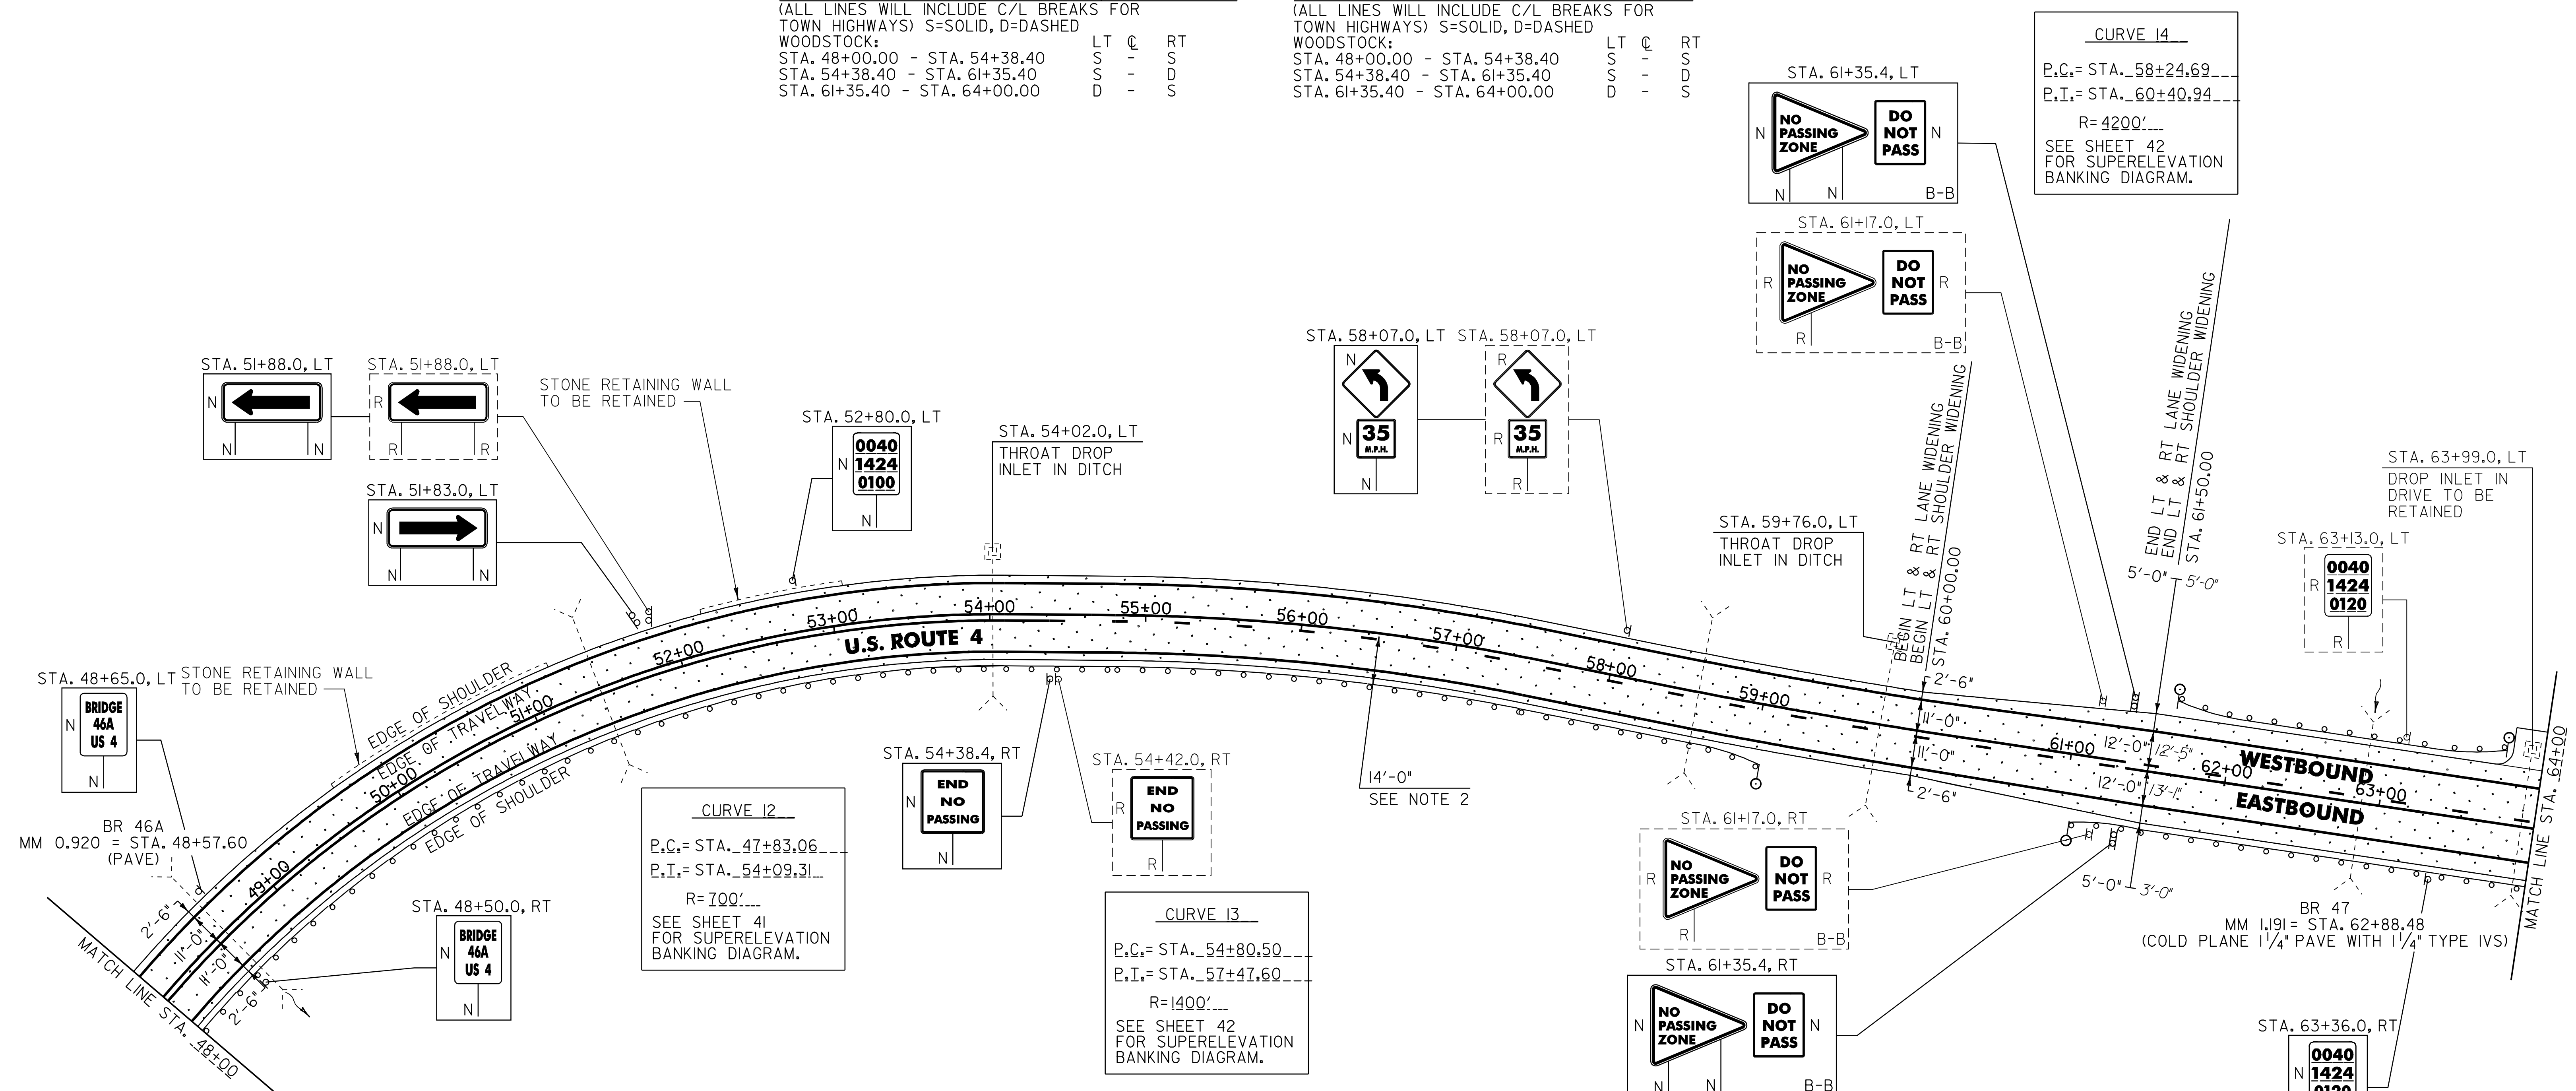

CURVE 12
 P.C.= STA. 47+83.06
 P.T.= STA. 54+09.31
 R=700'
 SEE SHEET 41 FOR SUPERELEVATION BANKING DIAGRAM.

CURVE 13
 P.C.= STA. 54+80.50
 P.T.= STA. 57+47.60
 R=1400'
 SEE SHEET 42 FOR SUPERELEVATION BANKING DIAGRAM.

CURVE 14
 P.C.= STA. 58+24.69
 P.T.= STA. 60+40.94
 R=4200'
 SEE SHEET 42 FOR SUPERELEVATION BANKING DIAGRAM.

- 525.10 REMOVAL OF EXISTING RAILING
 WOODSTOCK:
 STA. 62+75.8 - STA. 63+00.8 LT (25.0 LF)
 STA. 62+77.8 - STA. 63+02.8 RT (25.0 LF)
- 604.412 REHAB. DROP INLETS, CATCH BASINS OR MANHOLE, CLASS I
 WOODSTOCK:
 STA. 54+02.0 LT
 STA. 59+76.0 LT
- 621.20 STEEL BEAM GUARDRAIL, GALVANIZED
 WOODSTOCK:
 STA. 48+00.0 - STA. 49+95.5 RT (195.5 LF)
 STA. 61+40.3 - STA. 62+52.8 RT (112.5 LF)
 STA. 62+00.8 - STA. 62+50.8 LT (50.0 LF)
 STA. 63+25.8 - STA. 63+38.3 LT (12.5 LF)
 STA. 63+27.8 - STA. 64+00.0 RT (72.2 LF)
- 621.205 STEEL BEAM GUARDRAIL, GALVANIZED W/8 FEET POSTS
 WOODSTOCK:
 STA. 49+95.5 - STA. 58+62.5 RT (867.0 LF)

- 621.21 HD STEEL BEAM GUARDRAIL, GALVANIZED
 WOODSTOCK:
 STA. 62+50.8 - STA. 62+75.8 LT (32.5 LF)
 STA. 62+52.8 - STA. 62+77.8 RT (32.5 LF)
 STA. 63+00.8 - STA. 63+25.8 LT (32.5 LF)
 STA. 63+02.8 - STA. 63+27.8 RT (32.5 LF)
- 621.50 MANUFACTURED TERMINAL SECTION, FLARED
 WOODSTOCK:
 STA. 58+62.5 - STA. 59+00.0 RT
 STA. 61+02.8 - STA. 61+40.3 RT
 STA. 61+63.3 - STA. 62+00.8 LT
 STA. 63+38.3 - STA. 63+75.8 LT
- 621.80 REMOVAL AND DISPOSAL OF GUARDRAIL
 WOODSTOCK:
 STA. 48+00.0 - STA. 57+88.0 RT (988 LF)
 STA. 62+00.0 - STA. 62+52.8 RT (52.8 LF)
 STA. 62+40.0 - STA. 62+75.8 LT (35.8 LF)
 STA. 63+00.8 - STA. 63+33.0 LT (32.2 LF)
 STA. 63+02.8 - STA. 64+00.0 RT (91.2 LF)

- 676.10 DELINEATOR WITH STEEL POST
 TYPE I WHITE
- WOODSTOCK:
 STA. 59+00.0 RT
 STA. 61+02.8 RT
 STA. 61+63.3 LT
 STA. 63+75.8 LT
- 525.60 BRIDGE RAILING REPAIR, TYPE III
 WOODSTOCK:
 STA. 62+75.8 - STA. 63+00.8 LT (25.0 LF)
 STA. 62+77.8 - STA. 63+02.8 RT (25.0 LF)

LEGEND

RECLAIMED STABILIZED BASE

SIGN LEGEND
 R = REMOVE
 S = SALVAGE
 N = NEW
 RET = RETAIN
 B-B = BACK TO BACK
 EXISTING = - - - - -
 NEW = _____

- NOTES:**
- SEE SHEET 77 FOR BRIDGE 47 DETAILS.
 - THE CONTRACTOR SHALL MAXIMIZE THE CLEAR ROADSIDE AREA BY INSTALLING THE PROPOSED GUARDRAIL A MINIMUM OF 14 FT FROM THE CENTERLINE OF U.S. ROUTE 4 OR AS DIRECTED BY THE RESIDENT ENGINEER. ANY REQUIRED EXCAVATION OR THE PLACEMENT OF AGGREGATE SHOULDER MATERIAL FOR ADDITIONAL BACKUP WILL BE COMPLETED AND PAID FOR UNDER THE APPLICABLE ITEM(S) AS DIRECTED BY THE RESIDENT ENGINEER.

NOT TO SCALE

PROJECT LAYOUT SHEET #10

PROJECT NAME: BRIDGEWATER - WOODSTOCK
 PROJECT NUMBER: NH_2611(S)

FILE NAME: p06b160.dgn
 PROJECT LEADER: D.E.G.
 DESIGNED BY: D.W.E.
 IPARM FILE: p06b160.i

PLOT DATE: 28-MAY-2010
 DRAWN BY: C.A.K.
 CHECKED BY: D.E.G.
 SHEET 21 OF 80


646.402 DURABLE 4 INCH WHITE LINE, THERMOPLASTIC
 (ALL LINES WILL INCLUDE EDGE LINE BREAKS AND RADIUS FOR TOWN HIGHWAYS)
 WOODSTOCK:
 STA. 64+00.00 - STA. 80+00.00 LT & RT

646.412 DURABLE 4 INCH YELLOW LINE, THERMOPLASTIC
 (ALL LINES WILL INCLUDE C/L BREAKS FOR TOWN HIGHWAYS) S=SOLID, D=DASHED
 WOODSTOCK:
 STA. 64+00.00 - STA. 68+11.20 D - S
 STA. 68+11.20 - STA. 73+39.20 S - S
 STA. 73+39.20 - STA. 80+00.00 S - D

646.602 TEMPORARY 4 INCH WHITE LINE, PAINT
 (ALL LINES WILL INCLUDE EDGE LINE BREAKS AND RADIUS FOR TOWN HIGHWAYS)
 WOODSTOCK:
 STA. 64+00.00 - STA. 80+00.00 LT & RT

646.612 TEMPORARY 4 INCH YELLOW LINE, PAINT
 (ALL LINES WILL INCLUDE C/L BREAKS FOR TOWN HIGHWAYS) S=SOLID, D=DASHED
 WOODSTOCK:
 STA. 64+00.00 - STA. 68+11.20 D - S
 STA. 68+11.20 - STA. 73+39.20 S - S
 STA. 73+39.20 - STA. 80+00.00 S - D

675.50 REMOVING SIGNS
 AS SHOWN - 6

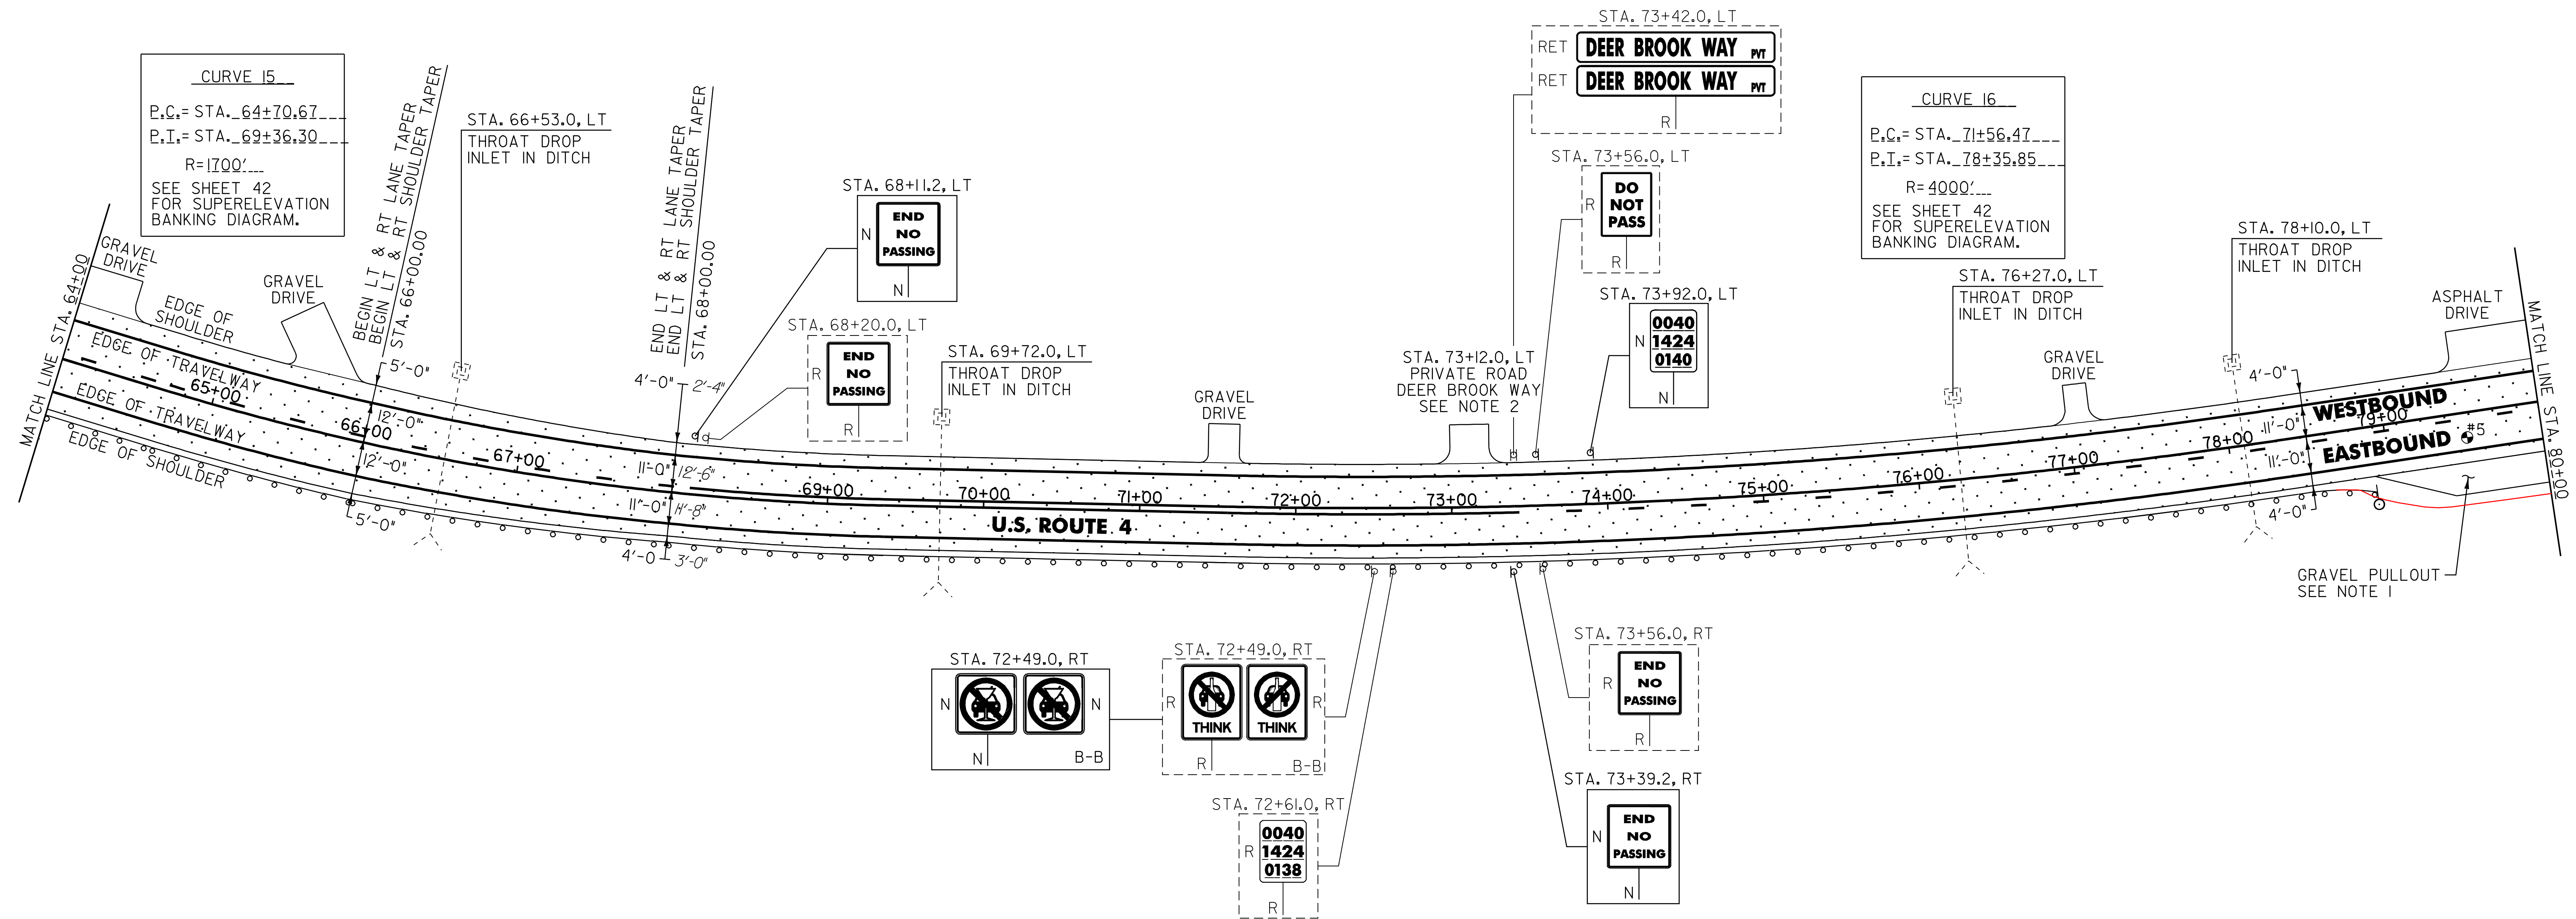

~~621.205 STEEL BEAM GUARDRAIL, GALV. W/ 8' POSTS~~
~~74+15.3 - 80+00 - (586.5)~~

~~604.412 REHAB. DROP INLETS, CATCH BASINS OR MANHOLE, CLASS I~~
 WOODSTOCK:
 STA. 66+53.0 LT
 STA. 69+72.0 LT
 STA. 76+27.0 LT
 STA. 78+10.0 LT

~~621.20 STEEL BEAM GUARDRAIL, GALVANIZED~~
 WOODSTOCK: 74+15.3
 STA. 64+00.0 - STA. 78+52.8 RT (4452.8 LF) (1015.3)

~~621.50 MANUFACTURED TERMINAL SECTION, FLARED~~
~~WOODSTOCK:~~
~~STA. 78+52.8 - STA. 78+90.3 RT~~

621.80 REMOVAL AND DISPOSAL OF GUARDRAIL
 WOODSTOCK:
 STA. 64+00.0 - STA. 78+86.0 RT (4486.0 LF)


676.10 DELINEATOR WITH STEEL POST
 ♀ TYPE I WHITE

WOODSTOCK:
 STA. 78+90.3 RT

PAVEMENT CORES = ●

#	TOTAL DEPTH (INCH)	PCC	COMMENTS
5	9 3/4	NO	

LEGEND

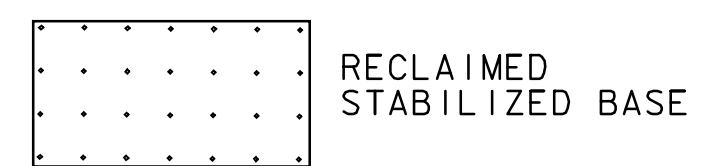

SIGN LEGEND
 R = REMOVE
 S = SALVAGE
 N = NEW
 RET = RETAIN
 B-B = BACK TO BACK
 EXISTING = - - - - -
 NEW = _____

NOTES:

- PROVIDE A 5 FT WIDE, 1 3/4" TYPE III APRON FOR THE EXISTING GRAVEL PULLOUT. ANY REQUIRED EXCAVATION SHALL BE PERFORMED AS DIRECTED BY THE RESIDENT ENGINEER AND PAID FOR UNDER ITEM 608.25 ALL PURPOSE EXCAVATOR RENTAL, TYPE I.
- PROVIDE A 15 FT WIDE, 1 3/4" TYPE III APRON FOR THE EXISTING PRIVATE ROAD. ANY REQUIRED EXCAVATION SHALL BE PERFORMED AS DIRECTED BY THE RESIDENT ENGINEER AND PAID FOR UNDER ITEM 608.25 ALL PURPOSE EXCAVATOR RENTAL, TYPE I.

NOT TO SCALE

PROJECT LAYOUT SHEET #11

PROJECT NAME: BRIDGEWATER - WOODSTOCK
 PROJECT NUMBER: NH_2611(S)

FILE NAME: p06b160.dgn
 PROJECT LEADER: D.E.G.
 DESIGNED BY: D.W.E.
 IPARM FILE: p06b16011.i

PLOT DATE: 28-MAY-2010
 DRAWN BY: C.A.K.
 CHECKED BY: D.E.G.
 SHEET 22 OF 80


646.402 DURABLE 4 INCH WHITE LINE, THERMOPLASTIC
 (ALL LINES WILL INCLUDE EDGE LINE BREAKS AND RADIUS FOR TOWN HIGHWAYS)
 WOODSTOCK:
 STA. 80+00.00 - STA. 96+00.00 LT & RT

646.412 DURABLE 4 INCH YELLOW LINE, THERMOPLASTIC
 (ALL LINES WILL INCLUDE C/L BREAKS FOR TOWN HIGHWAYS) S=SOLID, D=DASHED
 WOODSTOCK:
 STA. 80+00.00 - STA. 81+84.00 S - D
 STA. 81+84.00 - STA. 92+40.00 D - S
 STA. 92+40.00 - STA. 96+00.00 S - S

646.602 TEMPORARY 4 INCH WHITE LINE, PAINT
 (ALL LINES WILL INCLUDE EDGE LINE BREAKS AND RADIUS FOR TOWN HIGHWAYS)
 WOODSTOCK:
 STA. 80+00.00 - STA. 96+00.00 LT & RT

646.612 TEMPORARY 4 INCH YELLOW LINE, PAINT
 (ALL LINES WILL INCLUDE C/L BREAKS FOR TOWN HIGHWAYS) S=SOLID, D=DASHED
 WOODSTOCK:
 STA. 80+00.00 - STA. 81+84.00 S - D
 STA. 81+84.00 - STA. 92+40.00 D - S
 STA. 92+40.00 - STA. 96+00.00 S - S

675.50 REMOVING SIGNS
 AS SHOWN - 5

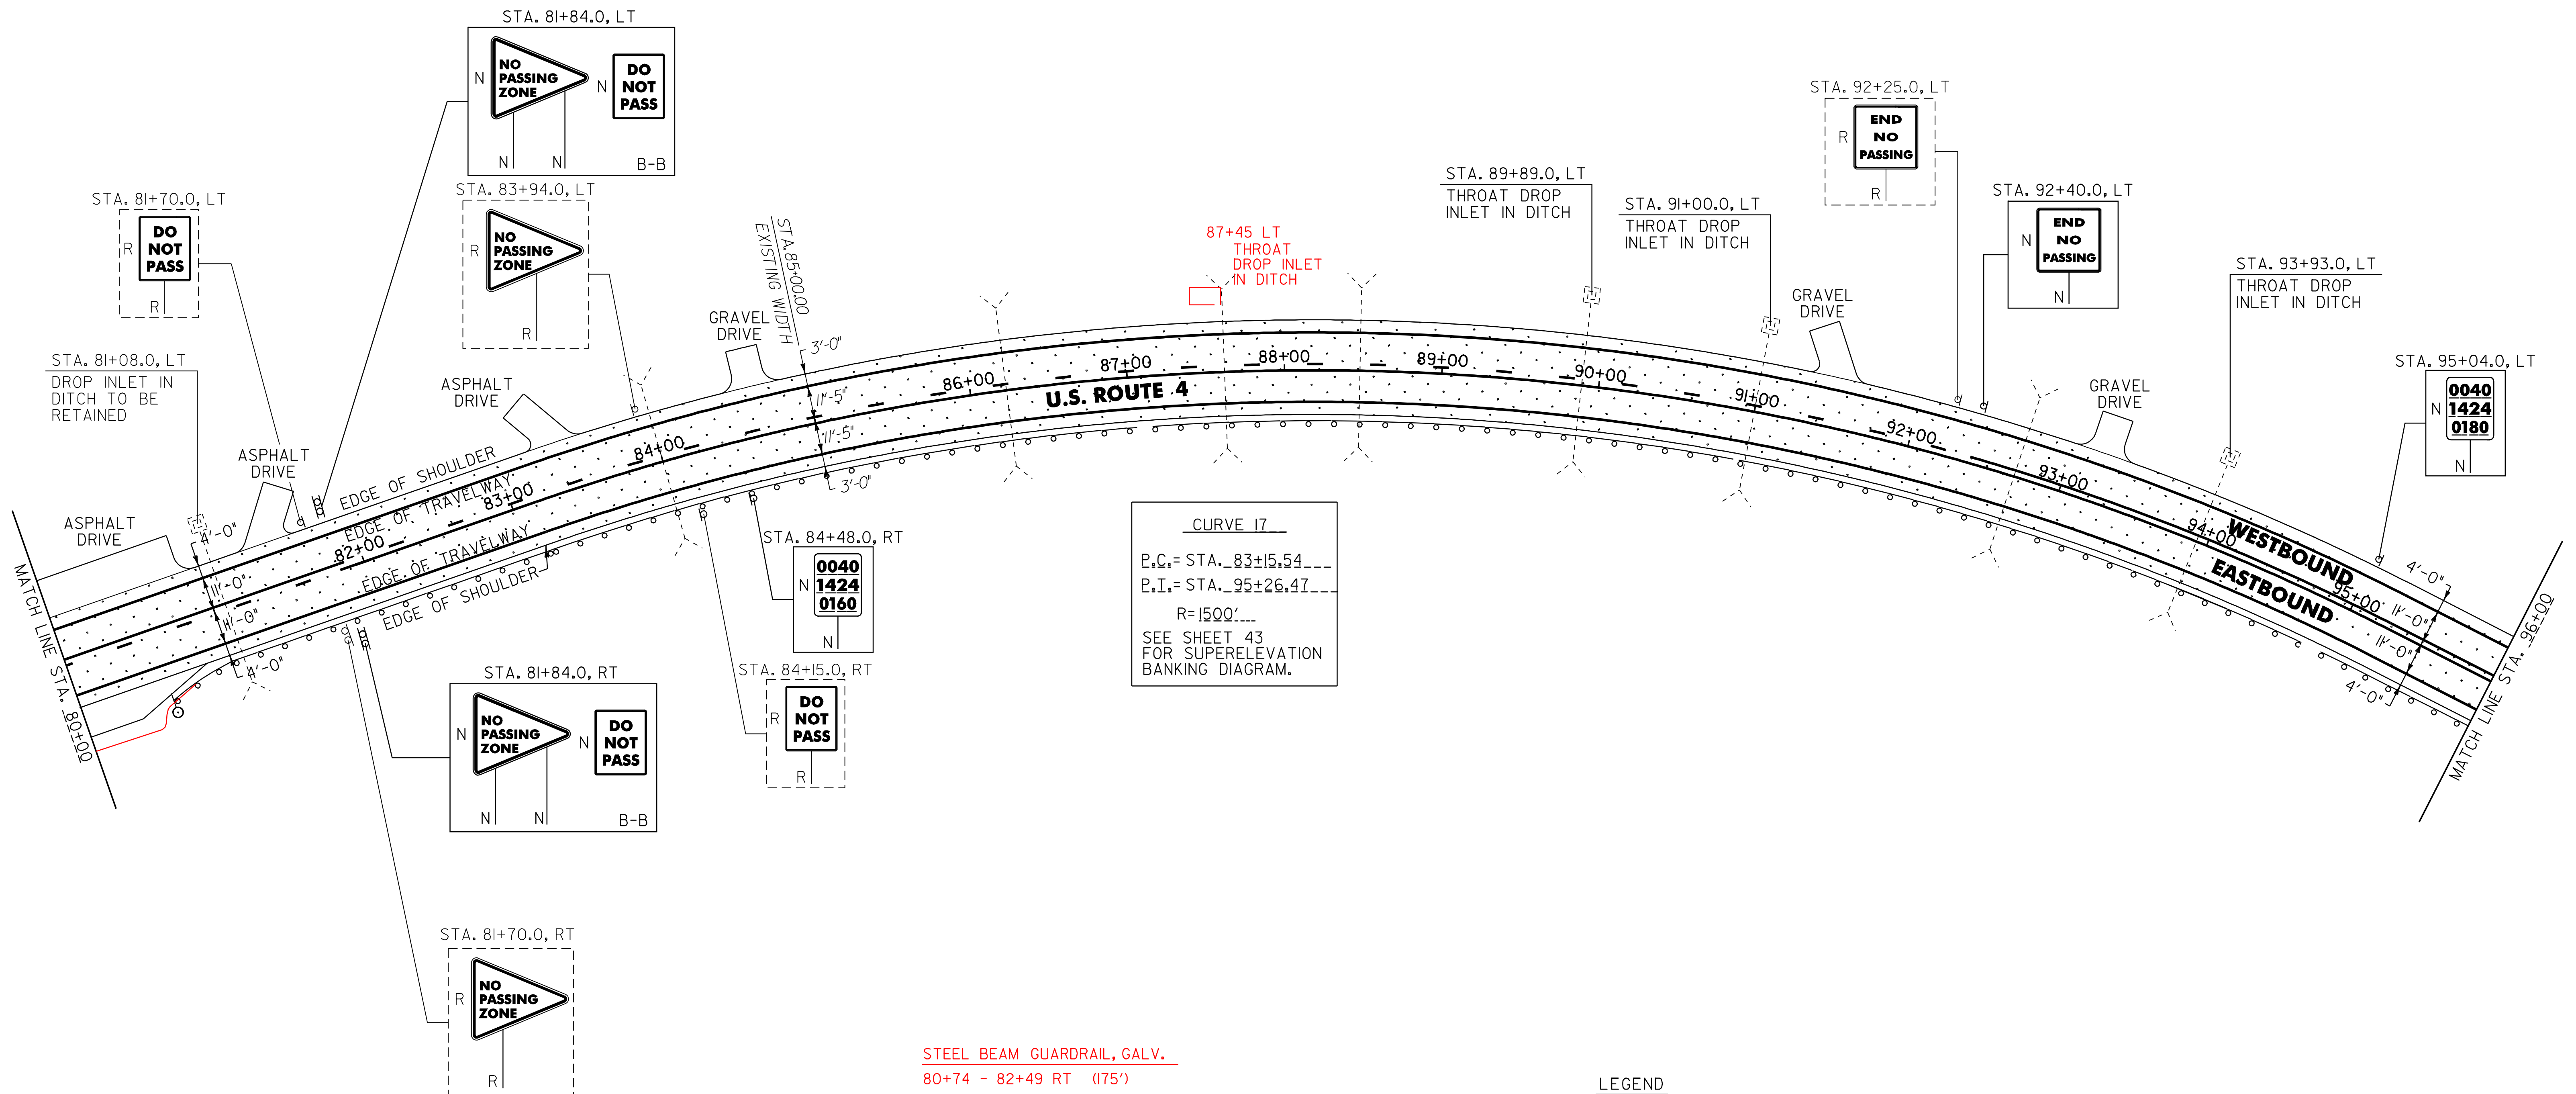

CURVE 17
 P.C. = STA. 83+15.54
 P.T. = STA. 95+26.47
 R = 1500'
 SEE SHEET 43 FOR SUPERELEVATION BANKING DIAGRAM.

STEEL BEAM GUARDRAIL, GALV.
 80+74 - 82+49 RT (175')

LEGEND
 [Dotted Box] RECLAIMED STABILIZED BASE

604.412 REHAB. DROP INLETS, CATCH BASINS OR MANHOLE, CLASS I
 WOODSTOCK:
 STA. 89+89.0 LT 87+45 LT
 STA. 91+00.0 LT
 STA. 93+93.0 LT

621.205 STEEL BEAM GUARDRAIL, GALVANIZED W/8 FEET POSTS
 WOODSTOCK:
 STA. 81+24.0 - STA. 96+00.0 RT (1476.0 LF)
 82+49 1351
 80+00 - 80+74 RT (76.0 LF)

~~621.50 MANUFACTURED TERMINAL SECTION, FLARED~~
~~WOODSTOCK:~~
~~STA. 80+86.5 - STA. 81+24.0 RT~~

621.80 REMOVAL AND DISPOSAL OF GUARDRAIL
 WOODSTOCK:
 STA. 80+87.0 - STA. 96+00.0 RT (1513.0 LF)

676.10 DELINEATOR WITH STEEL POST
 ♀ TYPE I WHITE
 WOODSTOCK:
 STA. 80+86.5 RT

SIGN LEGEND
 R = REMOVE
 S = SALVAGE
 N = NEW
 RET = RETAIN
 B-B = BACK TO BACK
 EXISTING = -----
 NEW = -----

NOT TO SCALE

PROJECT LAYOUT SHEET #12

PROJECT NAME: BRIDGEWATER - WOODSTOCK
 PROJECT NUMBER: NH_2611(S)

FILE NAME: p06b160.dgn PLOT DATE: 28-MAY-2010
 PROJECT LEADER: D.E.G. DRAWN BY: C.A.K.
 DESIGNED BY: D.W.E. CHECKED BY: D.E.G.
 IPARM FILE: p06b16012.i SHEET 23 OF 80


646.402 DURABLE 4 INCH WHITE LINE, THERMOPLASTIC
 (ALL LINES WILL INCLUDE EDGE LINE BREAKS AND
 RADIUS FOR TOWN HIGHWAYS)
 WOODSTOCK:
 STA. 96+00.00 - STA. 112+00.00 LT & RT

646.412 DURABLE 4 INCH YELLOW LINE, THERMOPLASTIC
 (ALL LINES WILL INCLUDE C/L BREAKS FOR
 TOWN HIGHWAYS) S=SOLID, D=DASHED
 WOODSTOCK:
 STA. 96+00.00 - STA. 112+00.00 LT ☉ RT
 S - S

646.602 TEMPORARY 4 INCH WHITE LINE, PAINT
 (ALL LINES WILL INCLUDE EDGE LINE BREAKS AND
 RADIUS FOR TOWN HIGHWAYS)
 WOODSTOCK:
 STA. 96+00.00 - STA. 112+00.00 LT & RT

646.612 TEMPORARY 4 INCH YELLOW LINE, PAINT
 (ALL LINES WILL INCLUDE C/L BREAKS FOR
 TOWN HIGHWAYS) S=SOLID, D=DASHED
 WOODSTOCK:
 STA. 96+00.00 - STA. 112+00.00 LT ☉ RT
 S - S

675.50 REMOVING SIGNS
 AS SHOWN - 6

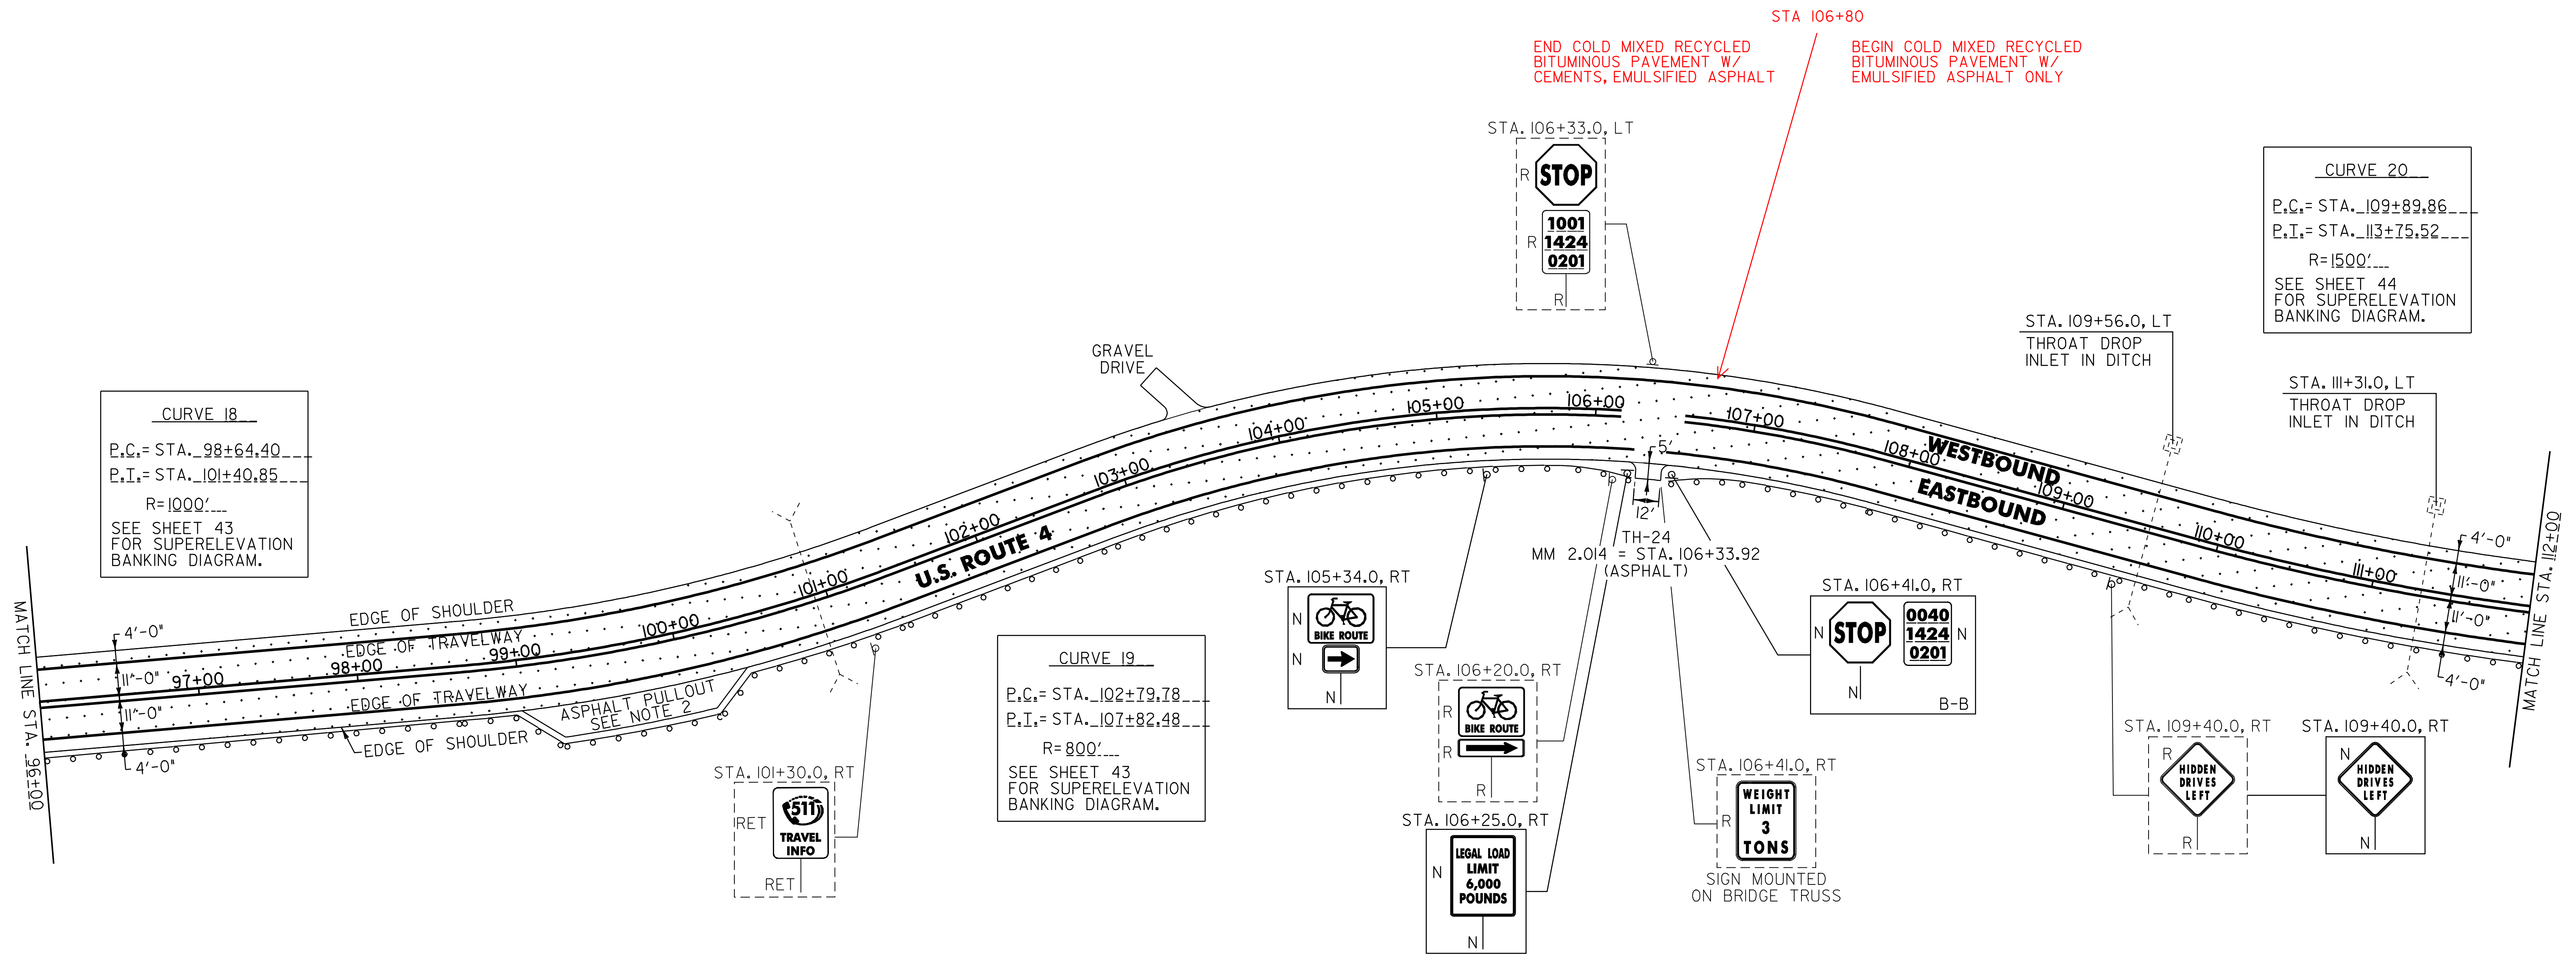


CURVE 18
 P.C. = STA. 98+64.40
 P.T. = STA. 101+40.85
 R = 1000'
 SEE SHEET 43
 FOR SUPERELEVATION
 BANKING DIAGRAM.

CURVE 19
 P.C. = STA. 102+79.78
 P.T. = STA. 107+82.48
 R = 800'
 SEE SHEET 43
 FOR SUPERELEVATION
 BANKING DIAGRAM.

CURVE 20
 P.C. = STA. 109+89.86
 P.T. = STA. 113+75.52
 R = 1500'
 SEE SHEET 44
 FOR SUPERELEVATION
 BANKING DIAGRAM.

LEGEND

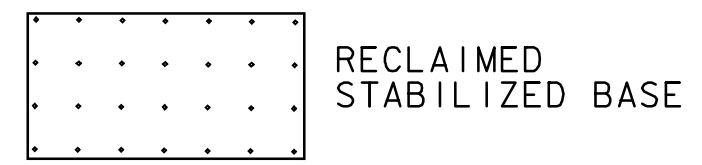

SIGN LEGEND
 R = REMOVE
 S = SALVAGE
 N = NEW
 RET = RETAIN
 B-B = BACK TO BACK
 EXISTING = -----
 NEW = _____

NOTES:

- PAVING LIMIT ON ALL TOWN HIGHWAYS SHALL BE MEASURED 25 FT BACK FROM U.S. ROUTE 4 EDGE OF SHOULDER UNLESS DENOTED OTHERWISE ON THE PLANS OR AS DIRECTED BY THE RESIDENT ENGINEER.
- PROVIDE A 5 FT WIDE, 1 3/4" TYPE III APRON FOR THE EXISTING ASPHALT PULLOUT. ANY REQUIRED EXCAVATION SHALL BE PERFORMED AS DIRECTED BY THE RESIDENT ENGINEER AND PAID FOR UNDER ITEM 608.25 ALL PURPOSE EXCAVATOR RENTAL, TYPE I.

604.412 REHAB. DROP INLETS, CATCH BASINS OR MANHOLE, CLASS I

WOODSTOCK:
 STA. 109+56.0 LT
 STA. 111+31.0 LT

621.205 STEEL BEAM GUARDRAIL, GALVANIZED W/8 FEET POSTS

WOODSTOCK:
 STA. 96+00.0 - STA. 105+74.0 RT (974.0 LF)
 STA. 106+92.0 - STA. 112+00.0 RT (508.0 LF) 520.5
 79.5

621.51 MANUFACTURED TERMINAL SECTION, TANGENT (FLARED)

WOODSTOCK:
 STA. 105+74.0 - STA. 106+24.0 RT
 STA. 106+42.0 - STA. 106+92.0 RT
 79.5

ANCHOR FOR STEEL BEAM GUARDRAIL

106+24 RT

621.80 REMOVAL AND DISPOSAL OF GUARDRAIL

WOODSTOCK:
 STA. 96+00.0 - STA. 106+24.0 RT (1024.0 LF)
 STA. 106+42.0 - STA. 112+00.0 RT (558.0 LF)

NOT TO SCALE

PROJECT LAYOUT SHEET #13

PROJECT NAME: BRIDGEWATER - WOODSTOCK
 PROJECT NUMBER: NH_2611(1)S

FILE NAME: p06b160.dgn PLOT DATE: 28-MAY-2010
 PROJECT LEADER: D.E.G. DRAWN BY: C.A.K.
 DESIGNED BY: D.W.E. CHECKED BY: D.E.G.
 IPARM FILE: p06b160i13.i SHEET 24 OF 80


646.402 DURABLE 4 INCH WHITE LINE, THERMOPLASTIC
 (ALL LINES WILL INCLUDE EDGE LINE BREAKS AND
 RADIUS FOR TOWN HIGHWAYS)
 WOODSTOCK:
 STA. 112+00.00 - STA. 128+00.00 LT & RT

646.412 DURABLE 4 INCH YELLOW LINE, THERMOPLASTIC
 (ALL LINES WILL INCLUDE C/L BREAKS FOR
 TOWN HIGHWAYS) S=SOLID, D=DASHED
 WOODSTOCK:
 STA. 112+00.00 - STA. 128+00.00 LT C RT
 S - S

646.602 TEMPORARY 4 INCH WHITE LINE, PAINT
 (ALL LINES WILL INCLUDE EDGE LINE BREAKS AND
 RADIUS FOR TOWN HIGHWAYS)
 WOODSTOCK:
 STA. 112+00.00 - STA. 128+00.00 LT & RT

646.612 TEMPORARY 4 INCH YELLOW LINE, PAINT
 (ALL LINES WILL INCLUDE C/L BREAKS FOR
 TOWN HIGHWAYS) S=SOLID, D=DASHED
 WOODSTOCK:
 STA. 112+00.00 - STA. 128+00.00 LT C RT
 S - S

675.50 REMOVING SIGNS
 AS SHOWN - 6

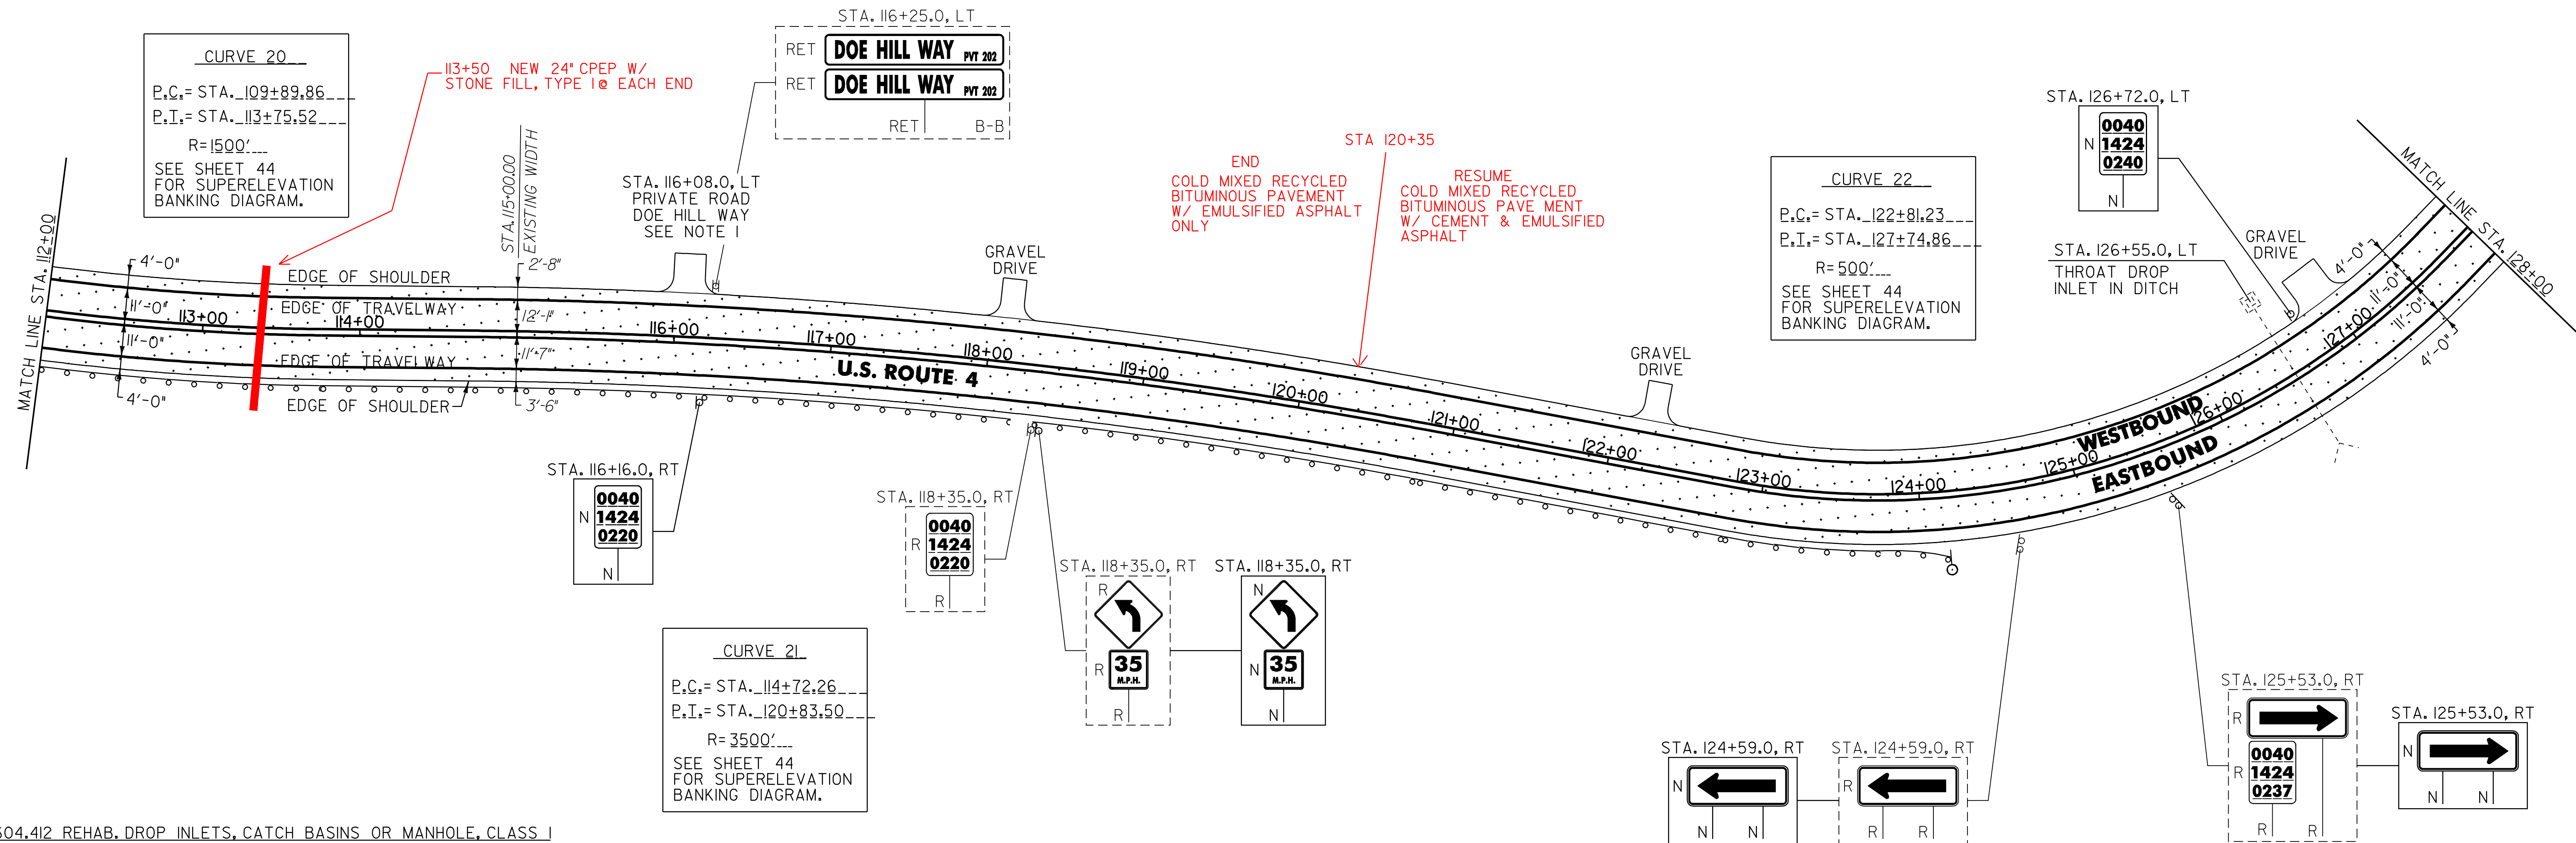

604.412 REHAB. DROP INLETS, CATCH BASINS OR MANHOLE, CLASS I

WOODSTOCK:
 STA. 126+55.0 LT

621.205 STEEL BEAM GUARDRAIL, GALVANIZED W/8 FEET POSTS

WOODSTOCK:
 STA. 112+00.0 - STA. 123+79.5 RT (1179.5 LF) (1217)

~~621.50 MANUFACTURED TERMINAL SECTION, FLARED ANCHOR FOR STEEL BEAM GUARDRAIL~~

WOODSTOCK:
~~STA. 123+79.5 - STA. 124+17.0 RT~~

621.80 REMOVAL AND DISPOSAL OF GUARDRAIL

WOODSTOCK:
 STA. 112+00.0 - STA. 124+17.0 RT (1217.0 LF)

676.10 DELINEATOR WITH STEEL POST


☉ TYPE 1 WHITE

WOODSTOCK:
 STA. 124+17.0 RT

NOTES:

- PROVIDE A 15 FT WIDE, 1 3/4" TYPE III APRON FOR THE EXISTING PRIVATE ROAD. ANY REQUIRED EXCAVATION SHALL BE PERFORMED AS DIRECTED BY THE RESIDENT ENGINEER AND PAID FOR UNDER ITEM 608.25 ALL PURPOSE EXCAVATOR RENTAL, TYPE I.

LEGEND

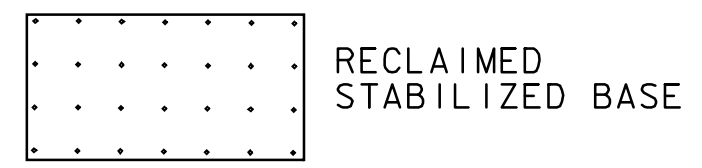

SIGN LEGEND

- R = REMOVE
- S = SALVAGE
- N = NEW
- RET = RETAIN
- B-B = BACK TO BACK
- EXISTING = - - - - -
- NEW = _____

NOT TO SCALE

PROJECT LAYOUT SHEET #14

PROJECT NAME: BRIDGEWATER - WOODSTOCK
 PROJECT NUMBER: NH_2611(S)
 FILE NAME: p06b160.dgn
 PROJECT LEADER: D.E.G.
 DESIGNED BY: D.W.E.
 IPARM FILE: p06b160i14.i
 PLOT DATE: 28-MAY-2010
 DRAWN BY: C.A.K.
 CHECKED BY: D.E.G.
 SHEET 25 OF 80

646.402 DURABLE 4 INCH WHITE LINE, THERMOPLASTIC
 (ALL LINES WILL INCLUDE EDGE LINE BREAKS AND RADIUS FOR TOWN HIGHWAYS)
 WOODSTOCK:
 STA. 128+00.00 - STA. 144+00.00 LT & RT

646.412 DURABLE 4 INCH YELLOW LINE, THERMOPLASTIC
 (ALL LINES WILL INCLUDE C/L BREAKS FOR TOWN HIGHWAYS) S=SOLID, D=DASHED
 WOODSTOCK:
 STA. 128+00.00 - STA. 144+00.00 LT @ RT
 STA. 142+03.20 DOUBLE SOLID LT, TH-28

646.482 DURABLE 24 INCH STOP BAR, THERMOPLASTIC
 WOODSTOCK:
 STA. 142+03.20 LT, TH-28


646.492 DURABLE LETTER OR SYMBOL, THERMOPLASTIC
 WOODSTOCK:
 STA. 142+03.20 LT, TH-28 "S,T,O,P" (4 EA)

646.602 TEMPORARY 4 INCH WHITE LINE, PAINT
 (ALL LINES WILL INCLUDE EDGE LINE BREAKS AND RADIUS FOR TOWN HIGHWAYS)
 WOODSTOCK:
 STA. 128+00.00 - STA. 144+00.00 LT & RT

646.612 TEMPORARY 4 INCH YELLOW LINE, PAINT
 (ALL LINES WILL INCLUDE C/L BREAKS FOR TOWN HIGHWAYS) S=SOLID, D=DASHED
 WOODSTOCK:
 STA. 128+00.00 - STA. 144+00.00 LT @ RT
 STA. 128+00.00 - STA. 144+00.00 S - S

675.50 REMOVING SIGNS
 AS SHOWN - 7

675.60 ERECTING SALVAGED SIGNS
 AS SHOWN - 2

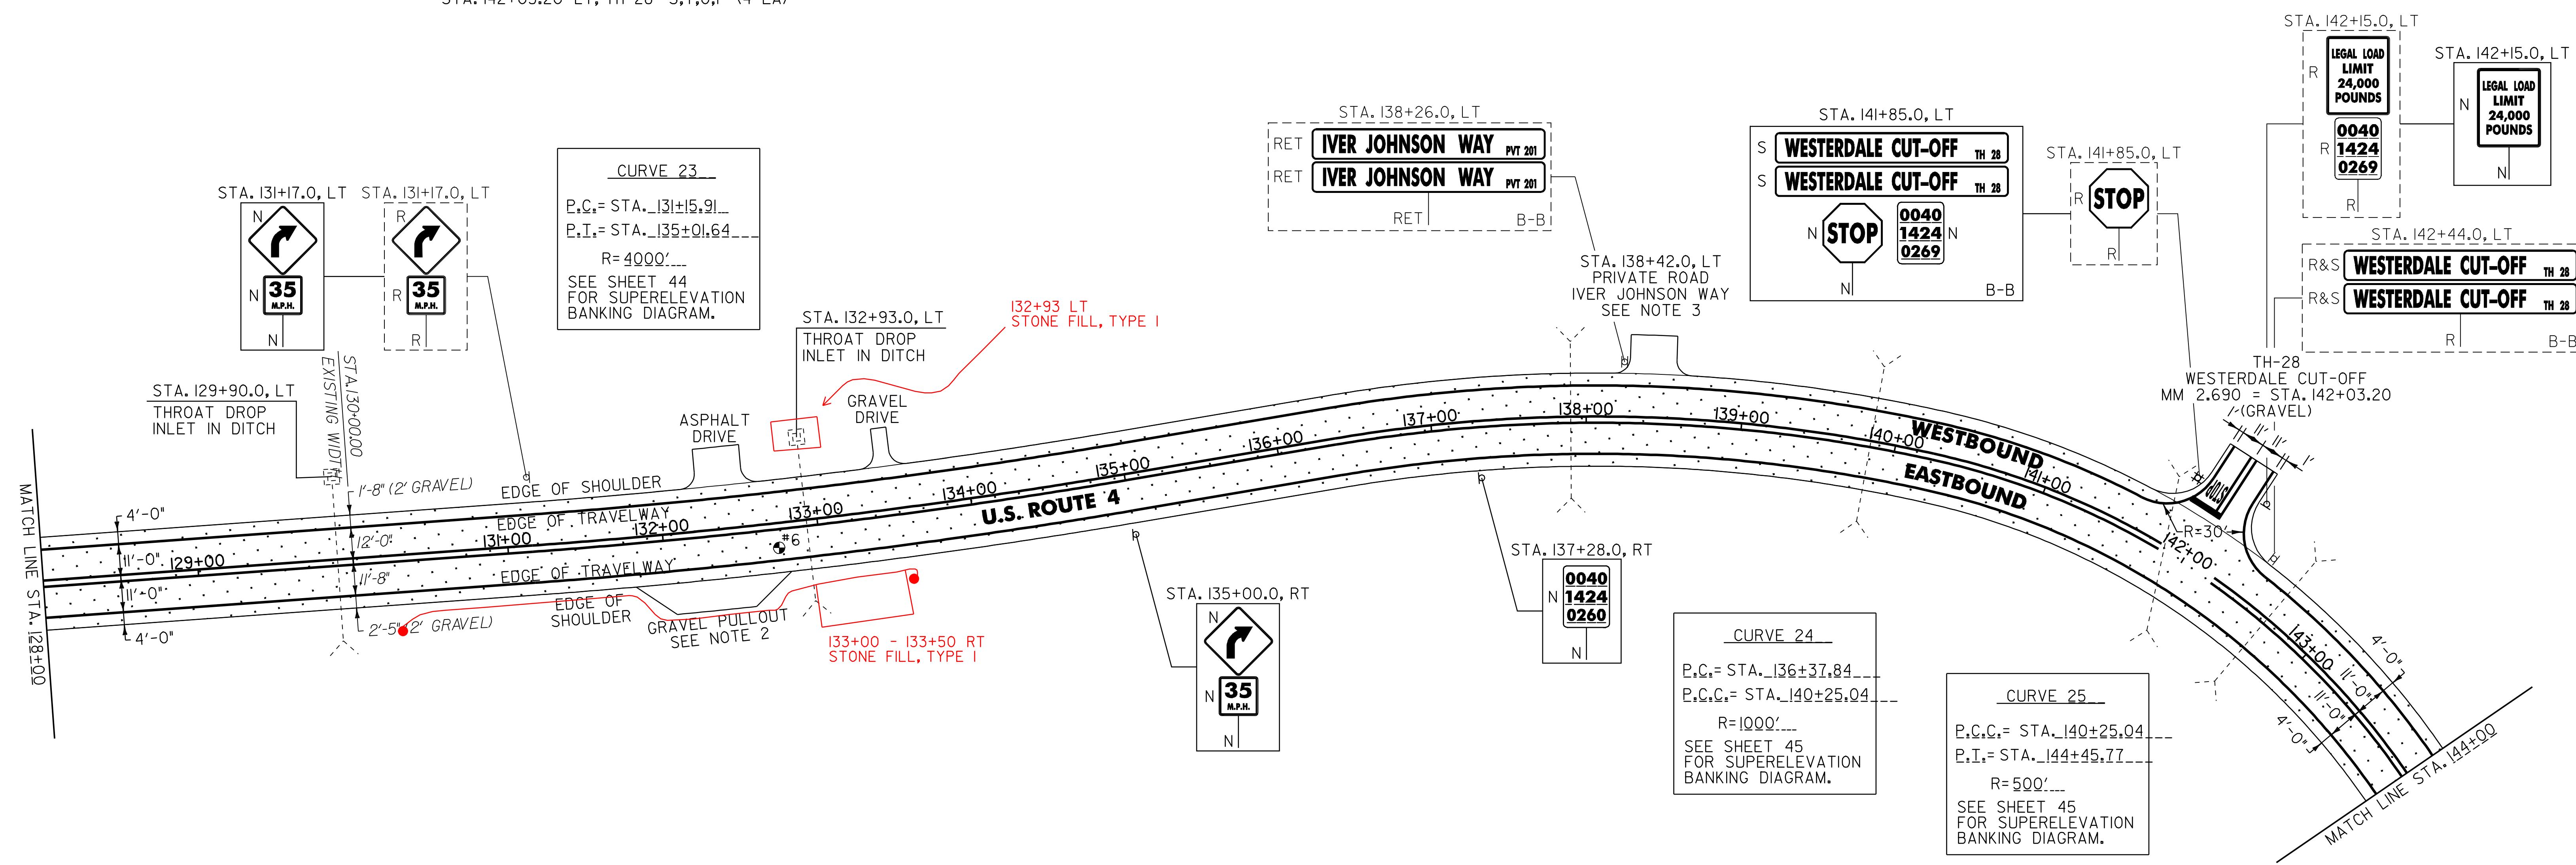

NOTES:


- PAVING LIMIT ON ALL TOWN HIGHWAYS SHALL BE MEASURED 25 FT BACK FROM U.S. ROUTE 4 EDGE OF SHOULDER UNLESS DENOTED OTHERWISE ON THE PLANS OR AS DIRECTED BY THE RESIDENT ENGINEER.
- PROVIDE A 5 FT WIDE, 1 3/4" TYPE IIIS APRON FOR THE EXISTING GRAVEL PULLOUT. ANY REQUIRED EXCAVATION SHALL BE PERFORMED AS DIRECTED BY THE RESIDENT ENGINEER AND PAID FOR UNDER ITEM 608.25 ALL PURPOSE EXCAVATOR RENTAL, TYPE I.
- PROVIDE A 15 FT WIDE, 1 3/4" TYPE IIIS APRON FOR THE EXISTING PRIVATE ROAD. ANY REQUIRED EXCAVATION SHALL BE PERFORMED AS DIRECTED BY THE RESIDENT ENGINEER AND PAID FOR UNDER ITEM 608.25 ALL PURPOSE EXCAVATOR RENTAL, TYPE I.

STEEL BEAM GUARDRAIL, GALV. W/ 8' POSTS
 130+04.5 - 133+39.5 RT (337.5')

MANUFACTURED TERMINAL SECTION, FLARED
 129+67 - 130+04.5 RT
 133+39.5 - 133+77 RT

604.412 REHAB. DROP INLETS, CATCH BASINS OR MANHOLE, CLASS I
 WOODSTOCK:
 STA. 129+90.0 LT
 STA. 132+93.0 LT

LEGEND

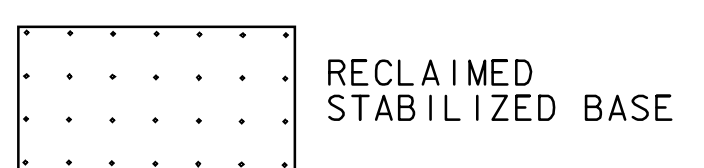

SIGN LEGEND
 R = REMOVE
 S = SALVAGE
 N = NEW
 RET = RETAIN
 B-B = BACK TO BACK
 EXISTING = -----
 NEW = _____

PAVEMENT CORES = ●

#	DEPTH (INCH)	PCC	COMMENTS
6	10 1/2	NO	

NOT TO SCALE

PROJECT LAYOUT SHEET #15

PROJECT NAME: BRIDGEWATER - WOODSTOCK
 PROJECT NUMBER: NH_2611(1)S
 FILE NAME: p06b160.dgn
 PROJECT LEADER: D.E.G.
 DESIGNED BY: D.W.E.
 IPARM FILE: p06b160i15.i
 PLOT DATE: 28-MAY-2010
 DRAWN BY: C.A.K.
 CHECKED BY: D.E.G.
 SHEET 26 OF 80


646.402 DURABLE 4 INCH WHITE LINE, THERMOPLASTIC
 (ALL LINES WILL INCLUDE EDGE LINE BREAKS AND
 RADIUS FOR TOWN HIGHWAYS)
 WOODSTOCK:
 STA. 144+00.00 - STA. 160+00.00 LT & RT

646.412 DURABLE 4 INCH YELLOW LINE, THERMOPLASTIC
 (ALL LINES WILL INCLUDE C/L BREAKS FOR
 TOWN HIGHWAYS) S=SOLID, D=DASHED
 WOODSTOCK:
 STA. 144+00.00 - STA. 160+00.00 LT C RT
 S - S

646.602 TEMPORARY 4 INCH WHITE LINE, PAINT
 (ALL LINES WILL INCLUDE EDGE LINE BREAKS AND
 RADIUS FOR TOWN HIGHWAYS)
 WOODSTOCK:
 STA. 144+00.00 - STA. 160+00.00 LT & RT

646.612 TEMPORARY 4 INCH YELLOW LINE, PAINT
 (ALL LINES WILL INCLUDE C/L BREAKS FOR
 TOWN HIGHWAYS) S=SOLID, D=DASHED
 WOODSTOCK:
 STA. 144+00.00 - STA. 160+00.00 LT C RT
 S - S

675.50 REMOVING SIGNS
 AS SHOWN - 4

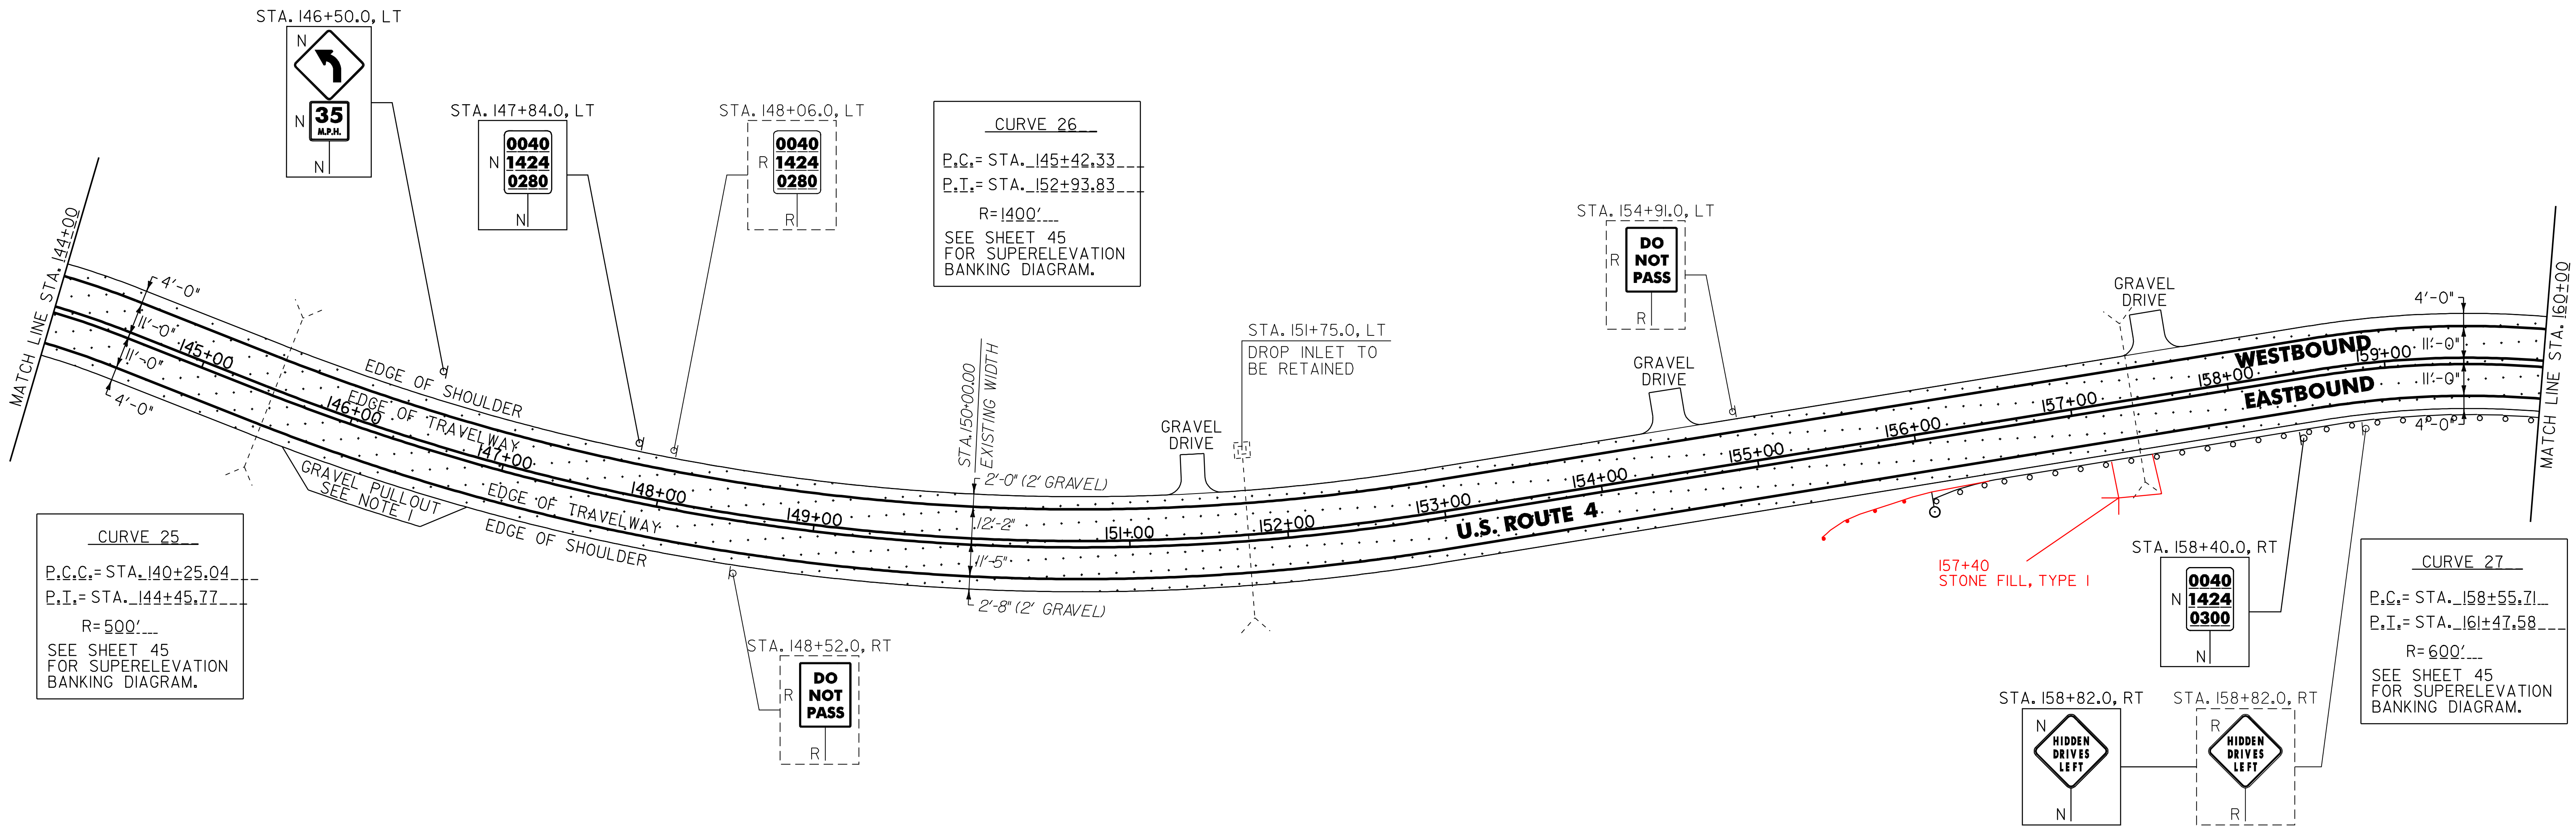

CURVE 25
 P.C.C. = STA. 140+25.04
 P.T. = STA. 144+45.77
 R = 500'
 SEE SHEET 45
 FOR SUPERELEVATION
 BANKING DIAGRAM.

CURVE 26
 P.C. = STA. 145+42.33
 P.T. = STA. 152+93.83
 R = 1400'
 SEE SHEET 45
 FOR SUPERELEVATION
 BANKING DIAGRAM.

CURVE 27
 P.C. = STA. 158+55.71
 P.T. = STA. 161+47.58
 R = 600'
 SEE SHEET 45
 FOR SUPERELEVATION
 BANKING DIAGRAM.

621.205 STEEL BEAM GUARDRAIL, GALVANIZED W/8 FEET POSTS

WOODSTOCK:
 STA. 156+42.0 - STA. 160+00.0 RT (358.0 LF) 445.5
 155+54.5

621.50 MANUFACTURED TERMINAL SECTION, FLARED

WOODSTOCK:
 STA. 156+04.5 - STA. 156+42.0 RT
 155+17 155+54.5

621.80 REMOVAL AND DISPOSAL OF GUARDRAIL


WOODSTOCK:
 STA. 156+52.0 - STA. 160+00.0 RT (348.0 LF)

676.10 DELINEATOR WITH STEEL POST

♀ TYPE 1 WHITE

WOODSTOCK:
 STA. 156+04.5 RT

LEGEND

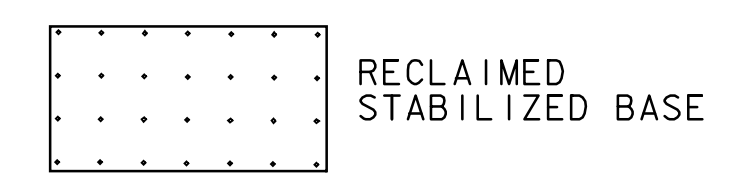

SIGN LEGEND
 R = REMOVE
 S = SALVAGE
 N = NEW
 RET = RETAIN
 B-B = BACK TO BACK
 EXISTING = - - - - -
 NEW = _____

NOTE:

I. PROVIDE A 5 FT WIDE, 1 3/4" TYPE III APRON FOR THE EXISTING GRAVEL PULLOUT. ANY REQUIRED EXCAVATION SHALL BE PERFORMED AS DIRECTED BY THE RESIDENT ENGINEER AND PAID FOR UNDER ITEM 608.25 ALL PURPOSE EXCAVATOR RENTAL, TYPE I.

NOT TO SCALE

PROJECT LAYOUT SHEET #16

PROJECT NAME: BRIDGEWATER - WOODSTOCK
 PROJECT NUMBER: NH_2611(S)
 FILE NAME: p06b160.dgn
 PROJECT LEADER: D.E.G.
 DESIGNED BY: D.W.E.
 IPARM FILE: p06b16016.i
 PLOT DATE: 28-MAY-2010
 DRAWN BY: C.A.K.
 CHECKED BY: D.E.G.
 SHEET 27 OF 80

646.402 DURABLE 4 INCH WHITE LINE, THERMOPLASTIC
(ALL LINES WILL INCLUDE EDGE LINE BREAKS AND RADIUS FOR TOWN HIGHWAYS)

WOODSTOCK:
STA. 160+00.00 - STA. 176+00.00 LT & RT
STA. 164+20.00 - STA. 165+80.00 SOLID LINE LT
STA. 165+80.00 - STA. 167+50.00 DOTTED LINE LT

646.412 DURABLE 4 INCH YELLOW LINE, THERMOPLASTIC
(ALL LINES WILL INCLUDE C/L BREAKS FOR TOWN HIGHWAYS)

WOODSTOCK:
STA. 160+00.00 - STA. 161+25.00 DOUBLE SOLID C/L
STA. 161+25.00 - STA. 164+00.00 DOUBLE SOLID MEDIAN C/L
STA. 164+20.80 DOUBLE SOLID RT, TH-35
STA. 164+40.00 - STA. 165+80.00 DOUBLE SOLID RT
STA. 165+80.00 - STA. 171+00.00 DOUBLE SOLID MEDIAN LT/RT
STA. 171+00.00 - STA. 176+00.00 DOUBLE SOLID C/L
STA. 172+07.52 DOUBLE SOLID LT, TH-28

646.452 DURABLE 8 INCH YELLOW LINE, THERMOPLASTIC

WOODSTOCK:
STA. 161+25.00 - STA. 164+00.00 HATCHED MEDIAN C/L
STA. 165+80.00 - STA. 171+00.00 HATCHED MEDIAN C/L

646.602 TEMPORARY 3 INCH WHITE LINE, PAINT
(ALL LINES WILL INCLUDE EDGE LINE BREAKS AND RADIUS FOR TOWN HIGHWAYS)

WOODSTOCK:
STA. 160+00.00 - STA. 176+00.00 LT & RT
STA. 164+20.00 - STA. 165+80.00 SOLID LINE LT
STA. 165+80.00 - STA. 167+50.00 DOTTED LINE LT

646.612 TEMPORARY 4 INCH YELLOW LINE, PAINT
(ALL LINES WILL INCLUDE C/L BREAKS FOR TOWN HIGHWAYS)

WOODSTOCK:
STA. 160+00.00 - STA. 161+25.00 DOUBLE SOLID C/L
STA. 161+25.00 - STA. 164+00.00 DOUBLE SOLID MEDIAN C/L
STA. 164+20.80 DOUBLE SOLID RT, TH-35
STA. 164+40.00 - STA. 165+80.00 DOUBLE SOLID RT
STA. 165+80.00 - STA. 171+00.00 DOUBLE SOLID MEDIAN LT/RT
STA. 171+00.00 - STA. 176+00.00 DOUBLE SOLID C/L
STA. 172+07.52 DOUBLE SOLID LT, TH-28

646.482 DURABLE 24 INCH STOP BAR, THERMOPLASTIC

WOODSTOCK:
STA. 164+20.80 RT, TH-35
STA. 172+07.52 LT, TH-28

646.492 DURABLE LETTER OR SYMBOL, THERMOPLASTIC

WOODSTOCK:
STA. 164+20.80 RT, TH-35, "S,T,O,P" (4 EA)
STA. 164+44.3 C/L, ARROW (1 EA)
STA. 164+88.2 C/L, "O,N,L,Y" (4 EA)
STA. 165+32.1 C/L, ARROW (1 EA)
STA. 165+75.9 C/L, "O,N,L,Y" (4 EA)
STA. 172+07.52 LT, TH-28, "S,T,O,P" (4 EA)

646.620 TEMPORARY 24 INCH STOP BAR, PAINT

WOODSTOCK:
STA. 164+20.80 RT, TH-35
STA. 172+07.52 LT, TH-28

646.692 TEMPORARY LETTER OR SYMBOL, PAINT


WOODSTOCK:
STA. 164+20.80 RT, TH-35, "S,T,O,P" (8 EA)
STA. 164+44.3 C/L, ARROW (2 EA)
STA. 165+32.1 C/L, ARROW (2 EA)
STA. 172+07.52 LT, TH-28, "S,T,O,P" (8 EA)

675.50 REMOVING SIGNS

AS SHOWN - 20

675.60 ERECTING SALVAGED SIGNS

AS SHOWN - 2

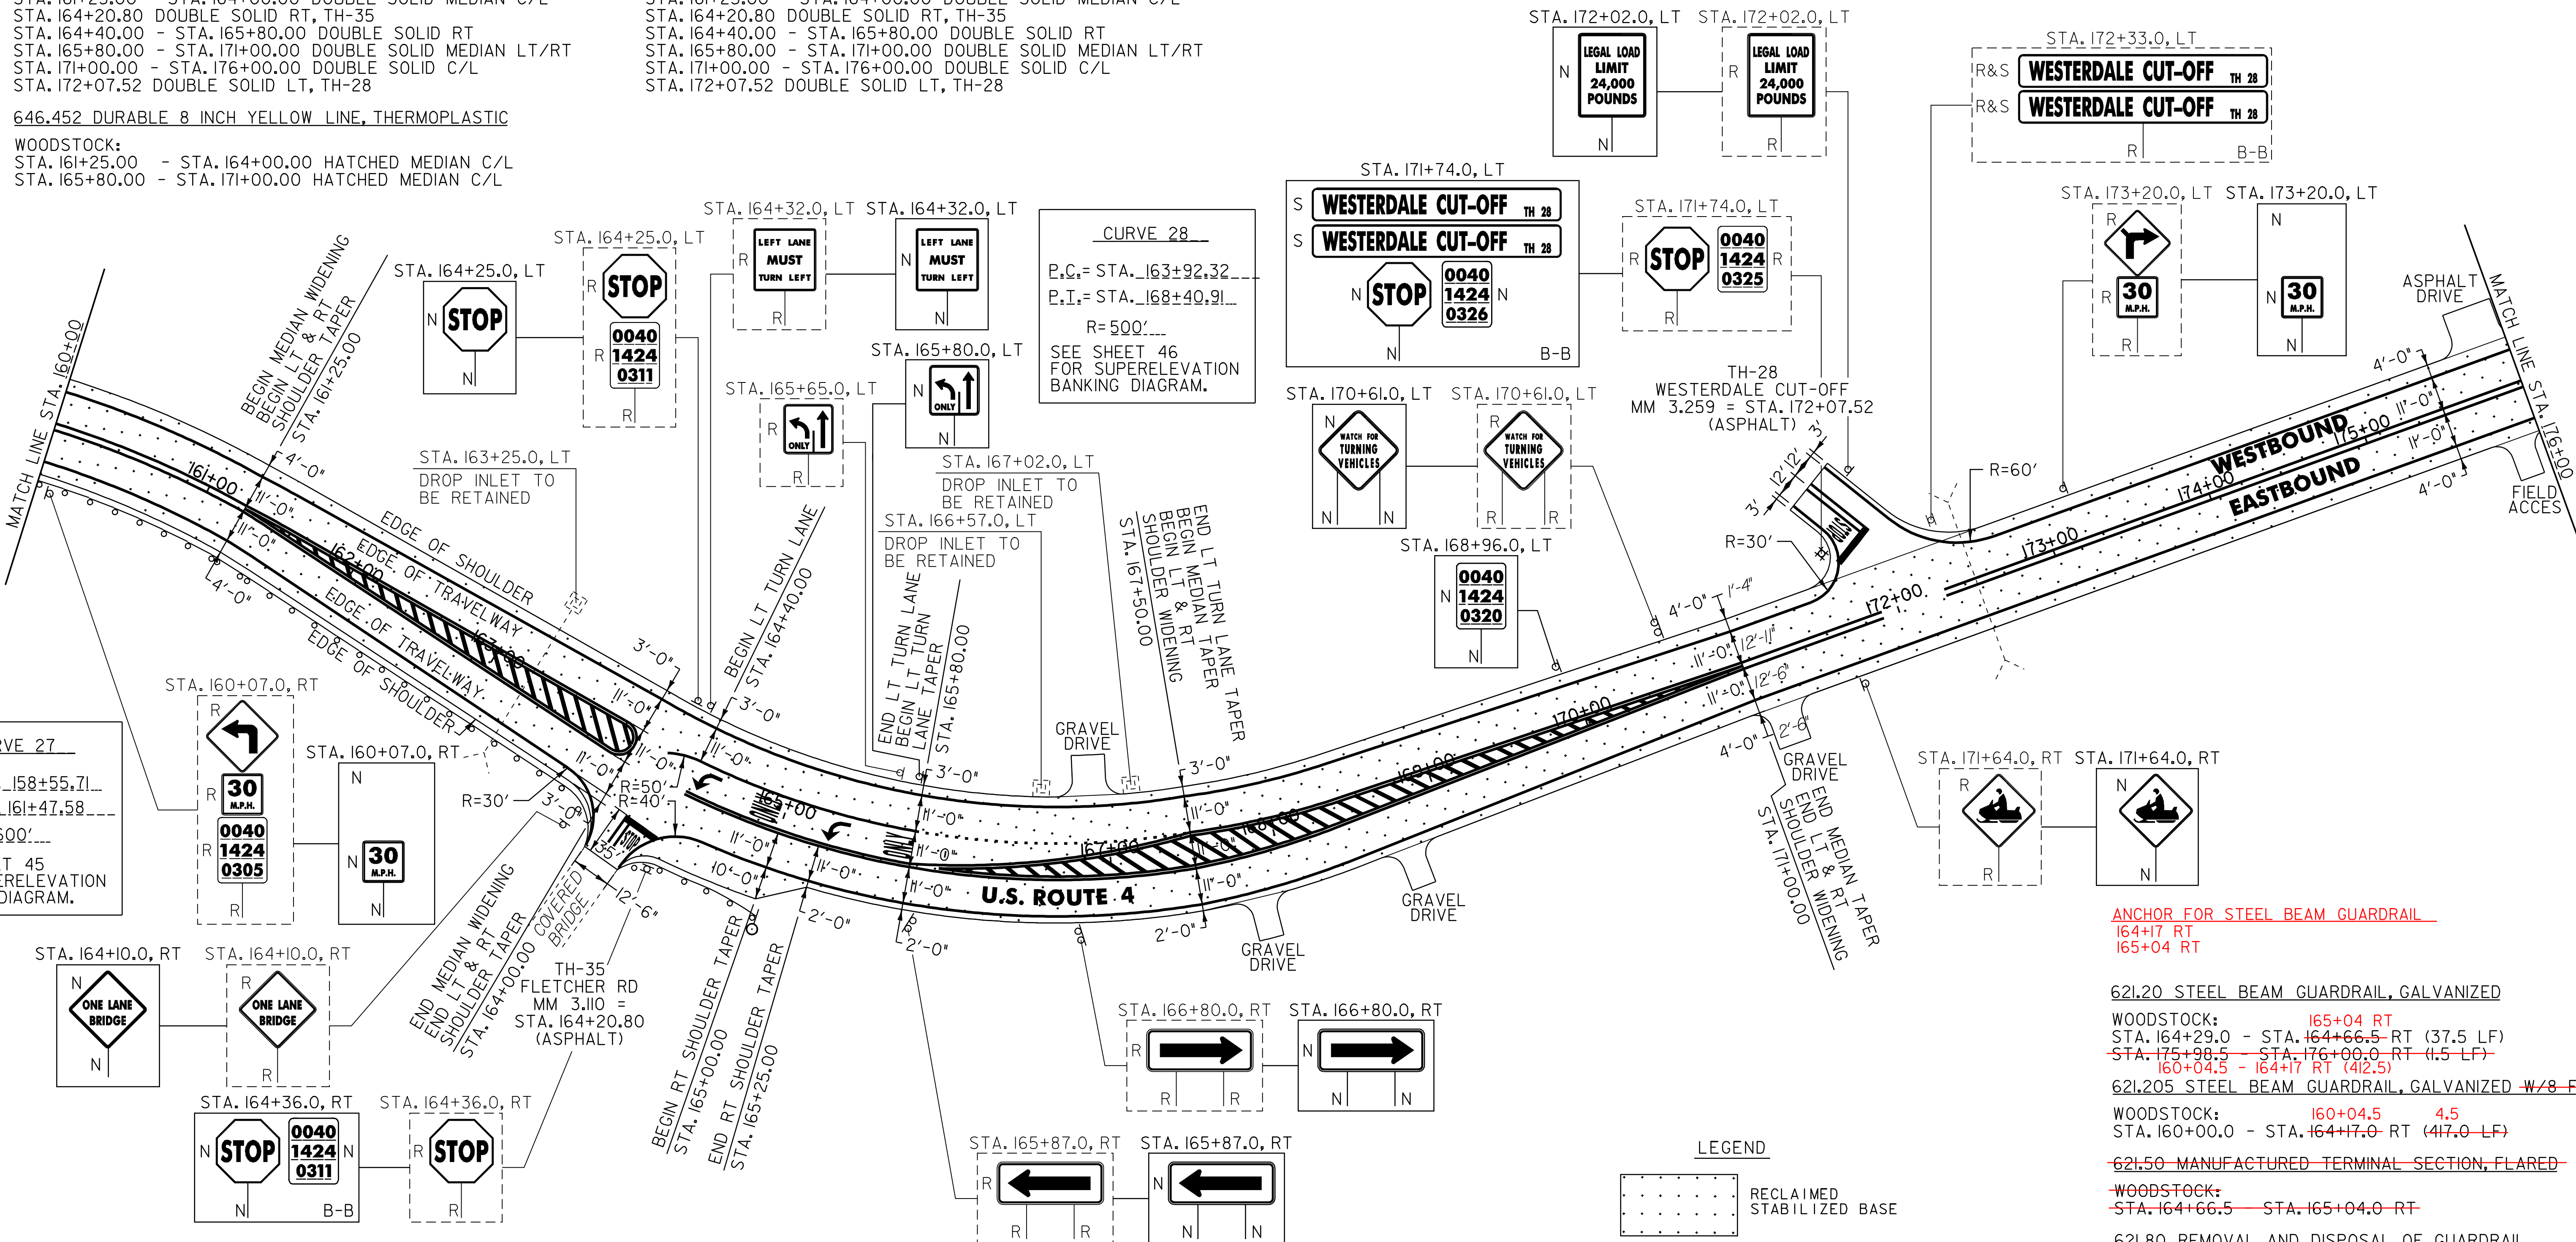

ANCHOR FOR STEEL BEAM GUARDRAIL
164+17 RT
165+04 RT

621.20 STEEL BEAM GUARDRAIL, GALVANIZED

WOODSTOCK:
165+04 RT
STA. 164+29.0 - STA. 164+66.5 RT (37.5 LF)
~~STA. 175+98.5 - STA. 176+00.0 RT (11.5 LF)~~
~~160+04.5 - 164+17 RT (412.5)~~

~~621.205 STEEL BEAM GUARDRAIL, GALVANIZED w/8 FEET POSTS~~

WOODSTOCK:
160+04.5 4.5
STA. 160+00.0 - STA. 164+17.0 RT (417.0 LF)

~~621.50 MANUFACTURED TERMINAL SECTION, FLARED~~

~~WOODSTOCK:
STA. 164+66.5 - STA. 165+04.0 RT~~

621.80 REMOVAL AND DISPOSAL OF GUARDRAIL

WOODSTOCK:
STA. 160+00.0 - STA. 164+17.0 RT (417.0 LF)
STA. 164+29.0 - STA. 164+65.0 RT (36.0 LF)

LEGEND
RECLAIMED STABILIZED BASE

SIGN LEGEND
R = REMOVE
S = SALVAGE
N = NEW
RET = RETAIN
B-B = BACK TO BACK
EXISTING = - - - - -
NEW = _____

NOT TO SCALE

PROJECT LAYOUT SHEET #17

PROJECT NAME: BRIDGEWATER - WOODSTOCK
PROJECT NUMBER: NH_2611(S)

FILE NAME: p06b160.dgn
PROJECT LEADER: D.E.G.
DESIGNED BY: D.W.E.
IPARM FILE: p06b16017.i

PLOT DATE: 28-MAY-2010
DRAWN BY: C.A.K.
CHECKED BY: D.E.G.
SHEET 28 OF 80

NOTE:
1. PAVING LIMIT ON ALL TOWN HIGHWAYS SHALL BE MEASURED 25 FT BACK FROM U.S. ROUTE 4 EDGE OF SHOULDER UNLESS DENOTED OTHERWISE ON THE PLANS OR AS DIRECTED BY THE RESIDENT ENGINEER.

676.10 DELINEATOR WITH STEEL POST
Ø TYPE 1 WHITE
WOODSTOCK:
STA. 165+04.0 RT

646.402 DURABLE 4 INCH WHITE LINE, THERMOPLASTIC
 (ALL LINES WILL INCLUDE EDGE LINE BREAKS AND RADIUS FOR TOWN HIGHWAYS)
 WOODSTOCK:
 STA. 176+00.00 - STA. 192+00.00 LT & RT

646.412 DURABLE 4 INCH YELLOW LINE, THERMOPLASTIC
 (ALL LINES WILL INCLUDE C/L BREAKS FOR TOWN HIGHWAYS) S=SOLID, D=DASHED
 WOODSTOCK:
 STA. 176+00.00 - STA. 192+00.00 LT C RT
 STA. 178+93.92 DOUBLE SOLID LT, TH-I7 S - S

646.482 DURABLE 24 INCH STOP BAR, THERMOPLASTIC
 WOODSTOCK:
 STA. 178+93.92 LT, TH-I7


646.492 DURABLE LETTER OR SYMBOL, THERMOPLASTIC
 WOODSTOCK:
 STA. 178+93.92 LT, TH-I7 "S,T,O,P" (4 EA)

646.602 TEMPORARY 4 INCH WHITE LINE, PAINT
 (ALL LINES WILL INCLUDE EDGE LINE BREAKS AND RADIUS FOR TOWN HIGHWAYS)
 WOODSTOCK:
 STA. 176+00.00 - STA. 192+00.00 LT & RT

646.612 TEMPORARY 4 INCH YELLOW LINE, PAINT
 (ALL LINES WILL INCLUDE C/L BREAKS FOR TOWN HIGHWAYS) S=SOLID, D=DASHED
 WOODSTOCK:
 STA. 176+00.00 - STA. 192+00.00 LT C RT
 S - S

675.50 REMOVING SIGNS
 AS SHOWN - 8

675.60 ERECTING SALVAGED SIGNS
 AS SHOWN - 2

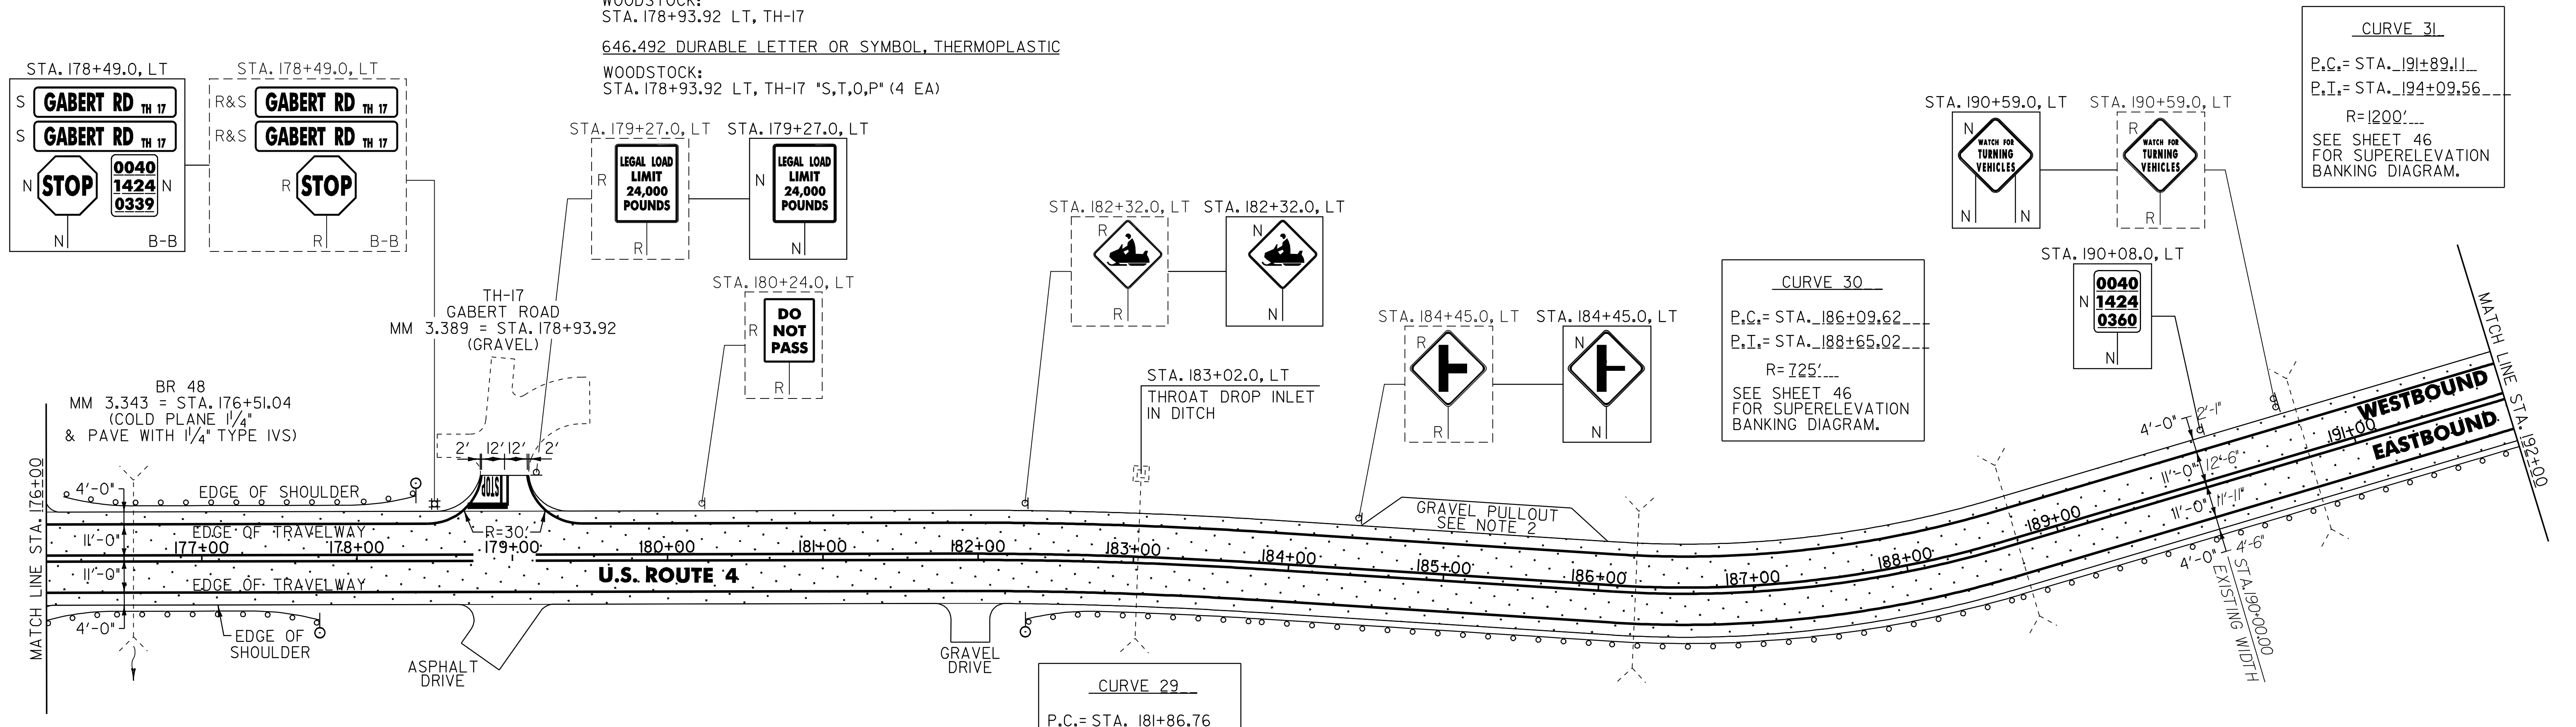

525.10 REMOVAL OF EXISTING RAILING
 WOODSTOCK:
 STA. 176+38.0 - STA. 176+63.0 LT (25.0 LF)
 STA. 176+38.0 - STA. 176+63.0 RT (25.0 LF)

604.412 REHAB. DROP INLETS, CATCH BASINS OR MANHOLE, CLASS I
 BRIDGEWATER:
 STA. 183+02.0 LT

621.20 STEEL BEAM GUARDRAIL, GALVANIZED
 WOODSTOCK:
 STA. 176+00.0 - STA. 176+13.0 RT (12.5 LF)
~~STA. 176+88.0 - STA. 178+00.5 LT (112.5 LF)~~
~~STA. 176+88.0 - STA. 177+38.0 RT (50.0 LF)~~

621.205 STEEL BEAM GUARDRAIL, GALVANIZED W/8 FEET POSTS
 WOODSTOCK:
 STA. 182+68.5 - STA. 192+00.0 RT (931.5 LF)

621.21 HD STEEL BEAM GUARDRAIL, GALVANIZED
 WOODSTOCK:
 STA. 176+11.0 - STA. 176+38.0 LT (32.0 LF)
 STA. 176+13.0 - STA. 176+38.0 RT (32.5 LF)
 STA. 176+63.0 - STA. 176+88.0 LT (32.5 LF)
 STA. 176+63.0 - STA. 176+88.0 RT (32.5 LF)

621.50 MANUFACTURED TERMINAL SECTION, FLARED
 WOODSTOCK: 176+88.0 25.5
~~STA. 177+38.0 - STA. 177+75.5 RT~~
~~STA. 178+00.5 - STA. 178+38.0 LT (177+25.5)~~
 STA. 182+31.0 - STA. 182+68.5 RT

621.60 ANCHOR FOR STEEL BEAM RAIL
 WOODSTOCK:
 STA. 176+08.0 RT
 STA. 176+20.5 LT

621.80 REMOVAL AND DISPOSAL OF GUARDRAIL
 WOODSTOCK:
 STA. 176+10.0 - STA. 176+38.0 LT (28.0 LF)
 STA. 176+10.0 - STA. 176+38.0 RT (28.0 LF)
 STA. 176+63.0 - STA. 176+87.0 LT (24.0 LF)
 STA. 176+63.0 - STA. 176+87.0 RT (24.0 LF)
 STA. 182+31.0 - STA. 192+00.0 RT (969.0 LF)

676.10 DELINEATOR WITH STEEL POST
 ♀ TYPE I WHITE
 WOODSTOCK:
 STA. 177+75.5 RT
 STA. 178+38.0 LT
 STA. 182+31.0 RT

525.60 BRIDGE RAILING REPAIR, TYPE III
 WOODSTOCK:
 STA. 176+38.0 - STA. 176+63.0 LT (25.0 LF)
 STA. 176+38.0 - STA. 176+63.0 RT (25.0 LF)

CURVE 29
 P.C. = STA. 181+86.76
 P.T. = STA. 183+83.51
 R = 3000'
 SEE SHEET 46 FOR SUPERELEVATION BANKING DIAGRAM.

CURVE 30
 P.C. = STA. 186+09.62
 P.T. = STA. 188+65.02
 R = 125'
 SEE SHEET 46 FOR SUPERELEVATION BANKING DIAGRAM.

CURVE 31
 P.C. = STA. 191+89.11
 P.T. = STA. 194+09.56
 R = 1200'
 SEE SHEET 46 FOR SUPERELEVATION BANKING DIAGRAM.

LEGEND
 RECLAIMED STABILIZED BASE

SIGN LEGEND
 R = REMOVE
 S = SALVAGE
 N = NEW
 RET = RETAIN
 B-B = BACK TO BACK
 EXISTING = EXISTING
 NEW = NEW

- NOTES:**
- PAVING LIMIT ON ALL TOWN HIGHWAYS SHALL BE MEASURED 25 FT BACK FROM U.S. ROUTE 4 EDGE OF SHOULDER UNLESS DENOTED OTHERWISE ON THE PLANS OR AS DIRECTED BY THE RESIDENT ENGINEER.
 - PROVIDE A 5 FT WIDE, 1 3/4" TYPE III APRON FOR THE EXISTING GRAVEL PULLOUT. ANY REQUIRED EXCAVATION SHALL BE PERFORMED AS DIRECTED BY THE RESIDENT ENGINEER AND PAID FOR UNDER ITEM 608.25 ALL PURPOSE EXCAVATOR RENTAL, TYPE I.
 - SEE SHEET 78 FOR BRIDGE 48 DETAILS.

PROJECT LAYOUT SHEET #18	NOT TO SCALE	
	PROJECT NAME: BRIDGEWATER - WOODSTOCK	PROJECT NUMBER: NH_2611(S)
FILE NAME: p06b160.dgn	PLOT DATE: 28-MAY-2010	DRAWN BY: C.A.K.
DESIGNED BY: D.W.E.	CHECKED BY: D.E.G.	SHEET 29 OF 80
IPARM FILE: p06b16018.i		


646.402 DURABLE 4 INCH WHITE LINE, THERMOPLASTIC
 (ALL LINES WILL INCLUDE EDGE LINE BREAKS AND
 RADIUS FOR TOWN HIGHWAYS)
 WOODSTOCK:
 STA. 192+00.00 - STA. 208+00.00 LT & RT

646.412 DURABLE 4 INCH YELLOW LINE, THERMOPLASTIC
 (ALL LINES WILL INCLUDE C/L BREAKS FOR
 TOWN HIGHWAYS) S=SOLID, D=DASHED
 WOODSTOCK:
 STA. 192+00.00 - STA. 208+00.00 LT C RT
 S - S

646.602 TEMPORARY 4 INCH WHITE LINE, PAINT
 (ALL LINES WILL INCLUDE EDGE LINE BREAKS AND
 RADIUS FOR TOWN HIGHWAYS)
 WOODSTOCK:
 STA. 192+00.00 - STA. 208+00.00 LT & RT

646.612 TEMPORARY 4 INCH YELLOW LINE, PAINT
 (ALL LINES WILL INCLUDE C/L BREAKS FOR
 TOWN HIGHWAYS) S=SOLID, D=DASHED
 WOODSTOCK:
 STA. 192+00.00 - STA. 208+00.00 LT C RT
 S - S

675.50 REMOVING SIGNS
 AS SHOWN - I

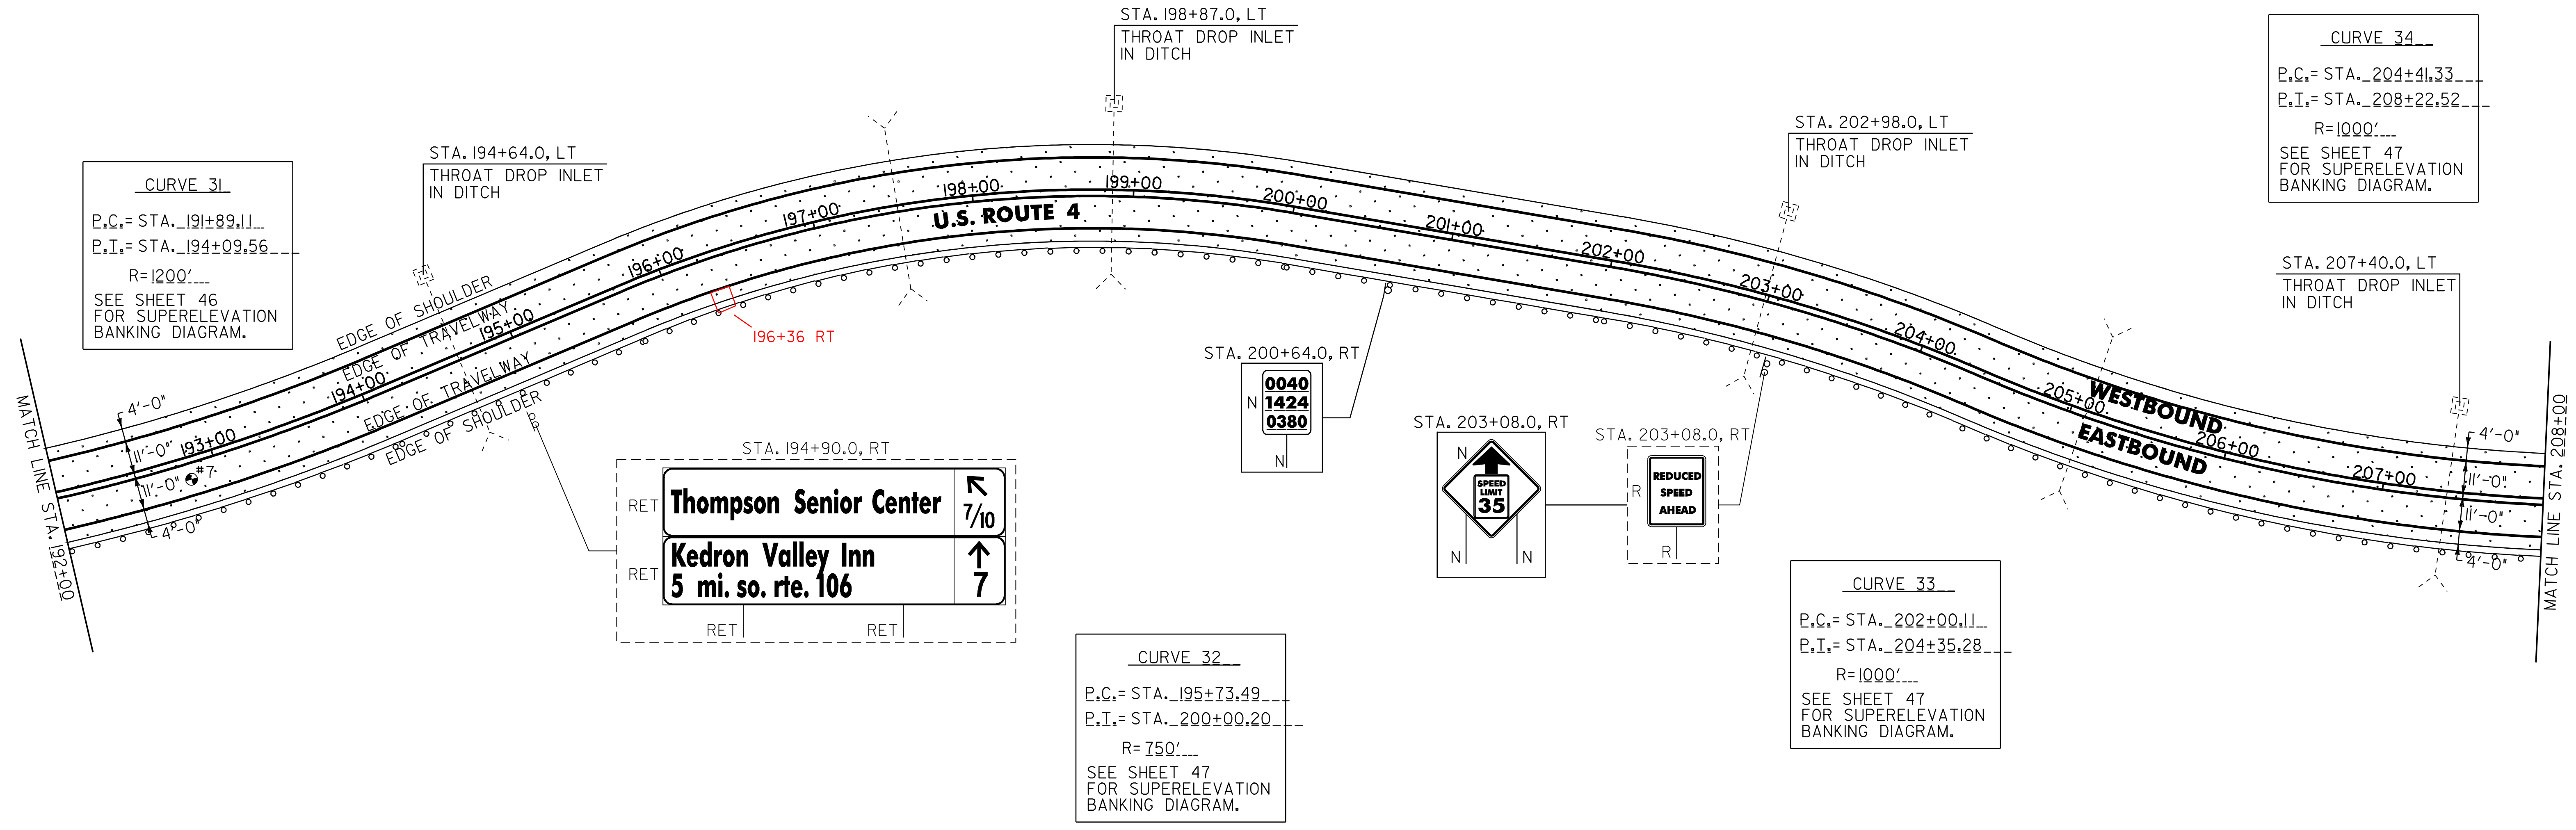

604.412 REHAB. DROP INLETS, CATCH BASINS OR MANHOLE, CLASS I
 WOODSTOCK:
 STA. 194+64.0 LT 196+36 RT
 STA. 198+87.0 LT
 STA. 202+98.0 LT
 STA. 207+40.0 LT

~~621.20 STEEL BEAM GUARDRAIL, GALVANIZED~~
 WOODSTOCK:
~~STA. 195+06.0 - STA. 201+93.5 RT (687.5 LF)~~

621.205 STEEL BEAM GUARDRAIL, GALVANIZED W/8 FEET POST


WOODSTOCK:
 STA. 192+00.0 - STA. 207+93.5 (1593.5)
 STA. 195+06.0 RT (306.0 LF)
~~STA. 201+93.5 - STA. 208+00.0 RT (606.5 LF)~~

621.80 REMOVAL AND DISPOSAL OF GUARDRAIL

WOODSTOCK:
 STA. 192+00.0 - STA. 208+00.0 RT (1600.0 LF)

PAVEMENT CORES =

#	DEPTH (INCH)	PCC	COMMENTS
7	8	NO	

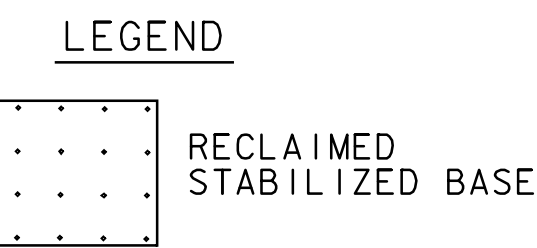

SIGN LEGEND
 R = REMOVE
 S = SALVAGE
 N = NEW
 RET = RETAIN
 B-B = BACK TO BACK
 EXISTING =
 NEW =

NOT TO SCALE

PROJECT LAYOUT SHEET #19

PROJECT NAME: BRIDGEWATER - WOODSTOCK
 PROJECT NUMBER: NH_261(1)S
 FILE NAME: p06b160.dgn
 PROJECT LEADER: D.E.G.
 DESIGNED BY: D.W.E.
 IPARM FILE: p06b160i.dgn
 PLOT DATE: 28-MAY-2010
 DRAWN BY: C.A.K.
 CHECKED BY: D.E.G.
 SHEET 30 OF 80

646.402 DURABLE 4 INCH WHITE LINE, THERMOPLASTIC
 (ALL LINES WILL INCLUDE EDGE LINE BREAKS AND RADIUS FOR TOWN HIGHWAYS)
 WOODSTOCK:
 STA. 208+00.00 - STA. 224+00.00 LT & RT

646.412 DURABLE 4 INCH YELLOW LINE, THERMOPLASTIC
 (ALL LINES WILL INCLUDE C/L BREAKS FOR TOWN HIGHWAYS) S=SOLID, D=DASHED
 WOODSTOCK:
 STA. 208+00.00 - STA. 224+00.00 LT ☉ RT
 S - S

646.482 DURABLE 24 INCH STOP BAR, THERMOPLASTIC
 WOODSTOCK:
 STA. 215+31.84 LT, TH-29


646.492 DURABLE LETTER OR SYMBOL, THERMOPLASTIC
 WOODSTOCK:
 STA. 215+31.84 LT, TH-29 "S,T,O,P" (4 EA)

646.602 TEMPORARY 4 INCH WHITE LINE, PAINT
 (ALL LINES WILL INCLUDE EDGE LINE BREAKS AND RADIUS FOR TOWN HIGHWAYS)
 WOODSTOCK:
 STA. 208+00.00 - STA. 224+00.00 LT & RT

646.612 TEMPORARY 4 INCH YELLOW LINE, PAINT
 (ALL LINES WILL INCLUDE C/L BREAKS FOR TOWN HIGHWAYS) S=SOLID, D=DASHED
 WOODSTOCK:
 STA. 208+00.00 - STA. 224+00.00 LT ☉ RT
 S - S

675.50 REMOVING SIGNS
 AS SHOWN - 10

675.60 ERECTING SALVAGED SIGNS
 AS SHOWN - 2

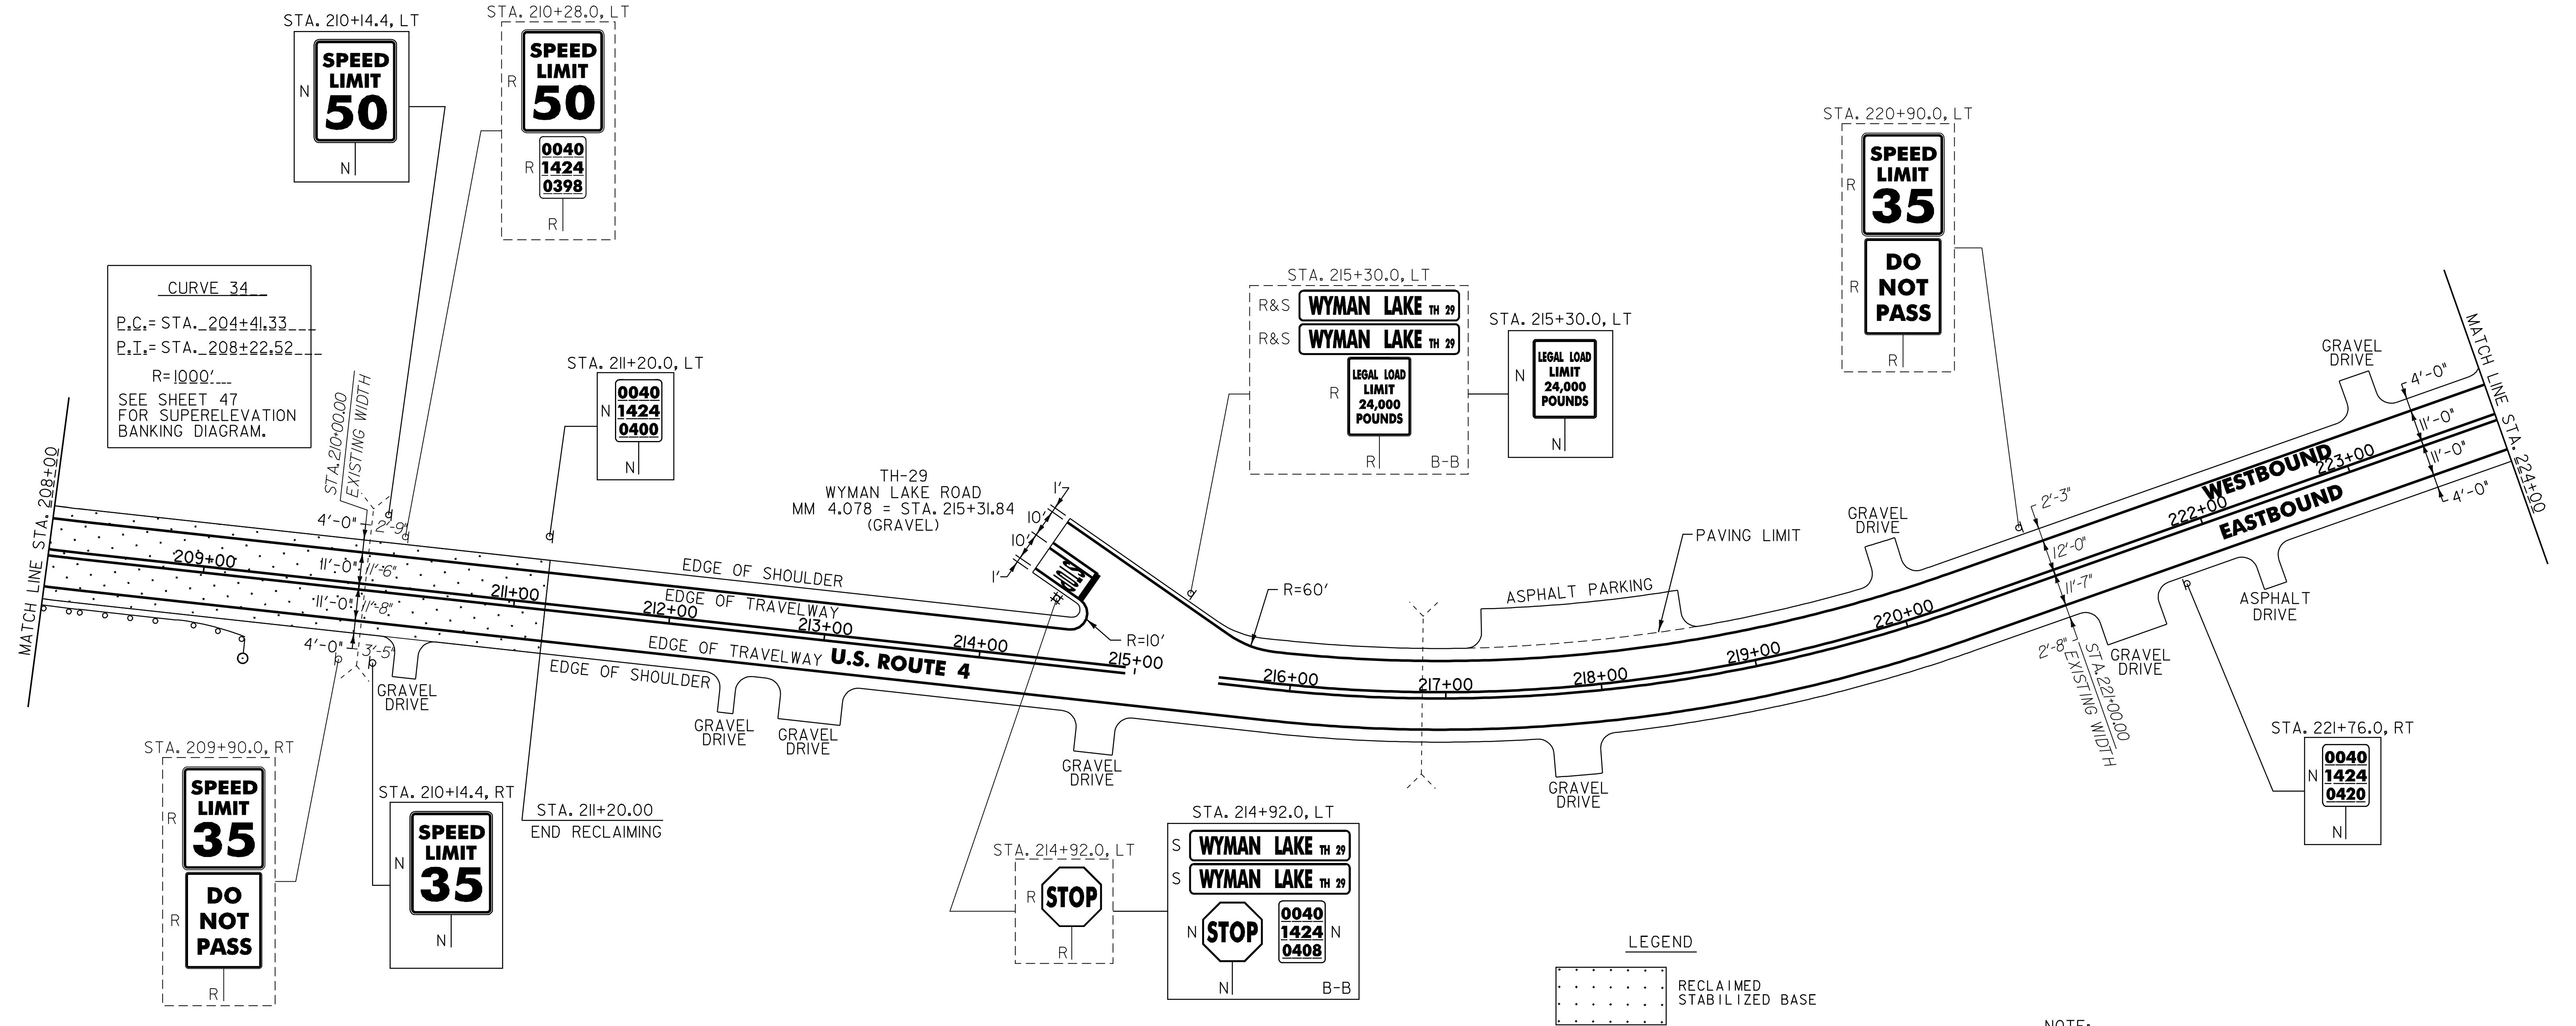

CURVE 34
 P.C.= STA. 204+41.33
 P.T.= STA. 208+22.52
 R=1000'
 SEE SHEET 47 FOR SUPERELEVATION BANKING DIAGRAM.

LEGEND
 [Dotted Box] RECLAIMED STABILIZED BASE

NOTE:
 1. PAVING LIMIT ON ALL TOWN HIGHWAYS SHALL BE MEASURED 25 FT BACK FROM U.S. ROUTE 4 EDGE OF SHOULDER UNLESS DENOTED OTHERWISE ON THE PLANS OR AS DIRECTED BY THE RESIDENT ENGINEER.

~~621.205 STEEL BEAM GUARDRAIL, GALVANIZED W/8 FEET POSTS~~
~~WOODSTOCK:~~
~~STA. 208+00.0 - STA. 208+93.5 RT (93.5 LF)~~
 621.50 MANUFACTURED TERMINAL SECTION, FLARED
 WOODSTOCK:
 STA. 208+93.5 - STA. 209+31.0 RT
 207 208

621.80 REMOVAL AND DISPOSAL OF GUARDRAIL
 WOODSTOCK:
 STA. 208+00.0 - STA. 208+30.0 RT (30.0 LF)
 676.10 DELINEATOR WITH STEEL POST
 ♀ TYPE 1 WHITE
 WOODSTOCK:
 STA. 209+31.0 RT

SIGN LEGEND
 R = REMOVE
 S = SALVAGE
 N = NEW
 RET = RETAIN
 B-B = BACK TO BACK
 EXISTING = _____
 NEW = _____

NOT TO SCALE

PROJECT LAYOUT SHEET #20

PROJECT NAME: BRIDGEWATER - WOODSTOCK
 PROJECT NUMBER: NH_2611(S)
 FILE NAME: p06b160.dgn
 PROJECT LEADER: D.E.G.
 DESIGNED BY: D.W.E.
 IPARM FILE: p06b160i20.i
 PLOT DATE: 28-MAY-2010
 DRAWN BY: C.A.K.
 CHECKED BY: D.E.G.
 SHEET 31 OF 80

646.402 DURABLE 4 INCH WHITE LINE, THERMOPLASTIC
(ALL LINES WILL INCLUDE EDGE LINE BREAKS AND RADIUS FOR TOWN HIGHWAYS)
WOODSTOCK:
STA. 224+00.00 - STA. 240+00.00 LT & RT

646.412 DURABLE 4 INCH YELLOW LINE, THERMOPLASTIC
(ALL LINES WILL INCLUDE C/L BREAKS FOR TOWN HIGHWAYS) S=SOLID, D=DASHED
WOODSTOCK:
STA. 224+00.00 - STA. 239+50.00 LT ☐ RT
STA. 224+00.00 - STA. 239+50.00 S - S
STA. 239+34.24 DOUBLE SOLID LT, TH-30
STA. 239+50.00 - STA. 240+00.00 DOUBLE SOLID MEDIAN C/L

646.452 DURABLE 8 INCH YELLOW LINE, THERMOPLASTIC
WOODSTOCK:
STA. 239+50.00 - STA. 240+00.00 HATCHED MEDIAN C/L

646.482 DURABLE 24 INCH STOP BAR, THERMOPLASTIC
WOODSTOCK:
STA. 239+34.24 LT, TH-30

646.492 DURABLE LETTER OR SYMBOL, THERMOPLASTIC
WOODSTOCK:
STA. 235+20.00 RT "S,C,H,O,O,L" (6 EA)
STA. 239+34.24 LT, TH-30, "S,T,O,P" (4 EA)

646.602 TEMPORARY 4 INCH WHITE LINE, PAINT
(ALL LINES WILL INCLUDE EDGE LINE BREAKS AND RADIUS FOR TOWN HIGHWAYS)
WOODSTOCK:
STA. 224+00.00 - STA. 240+00.00 LT & RT



646.612 TEMPORARY 4 INCH YELLOW LINE, PAINT
(ALL LINES WILL INCLUDE C/L BREAKS FOR TOWN HIGHWAYS) S=SOLID, D=DASHED
WOODSTOCK:
STA. 224+00.00 - STA. 239+50.00 LT ☐ RT
STA. 224+00.00 - STA. 239+50.00 S - S
STA. 239+34.24 DOUBLE SOLID LT, TH-30
STA. 239+50.00 - STA. 240+00.00 DOUBLE SOLID MEDIAN C/L

646.682 TEMPORARY 24 INCH STOP BAR, PAINT
WOODSTOCK:
STA. 239+34.24 LT, TH-30

646.692 TEMPORARY LETTER OR SYMBOL, PAINT
WOODSTOCK:
STA. 235+20.00 RT "S,C,H,O,O,L" (12 EA)
STA. 239+34.24 LT, TH-30, "S,T,O,P" (8 EA)

675.50 REMOVING SIGNS
AS SHOWN - 17

675.60 ERECTING SALVAGED SIGNS
AS SHOWN - 5

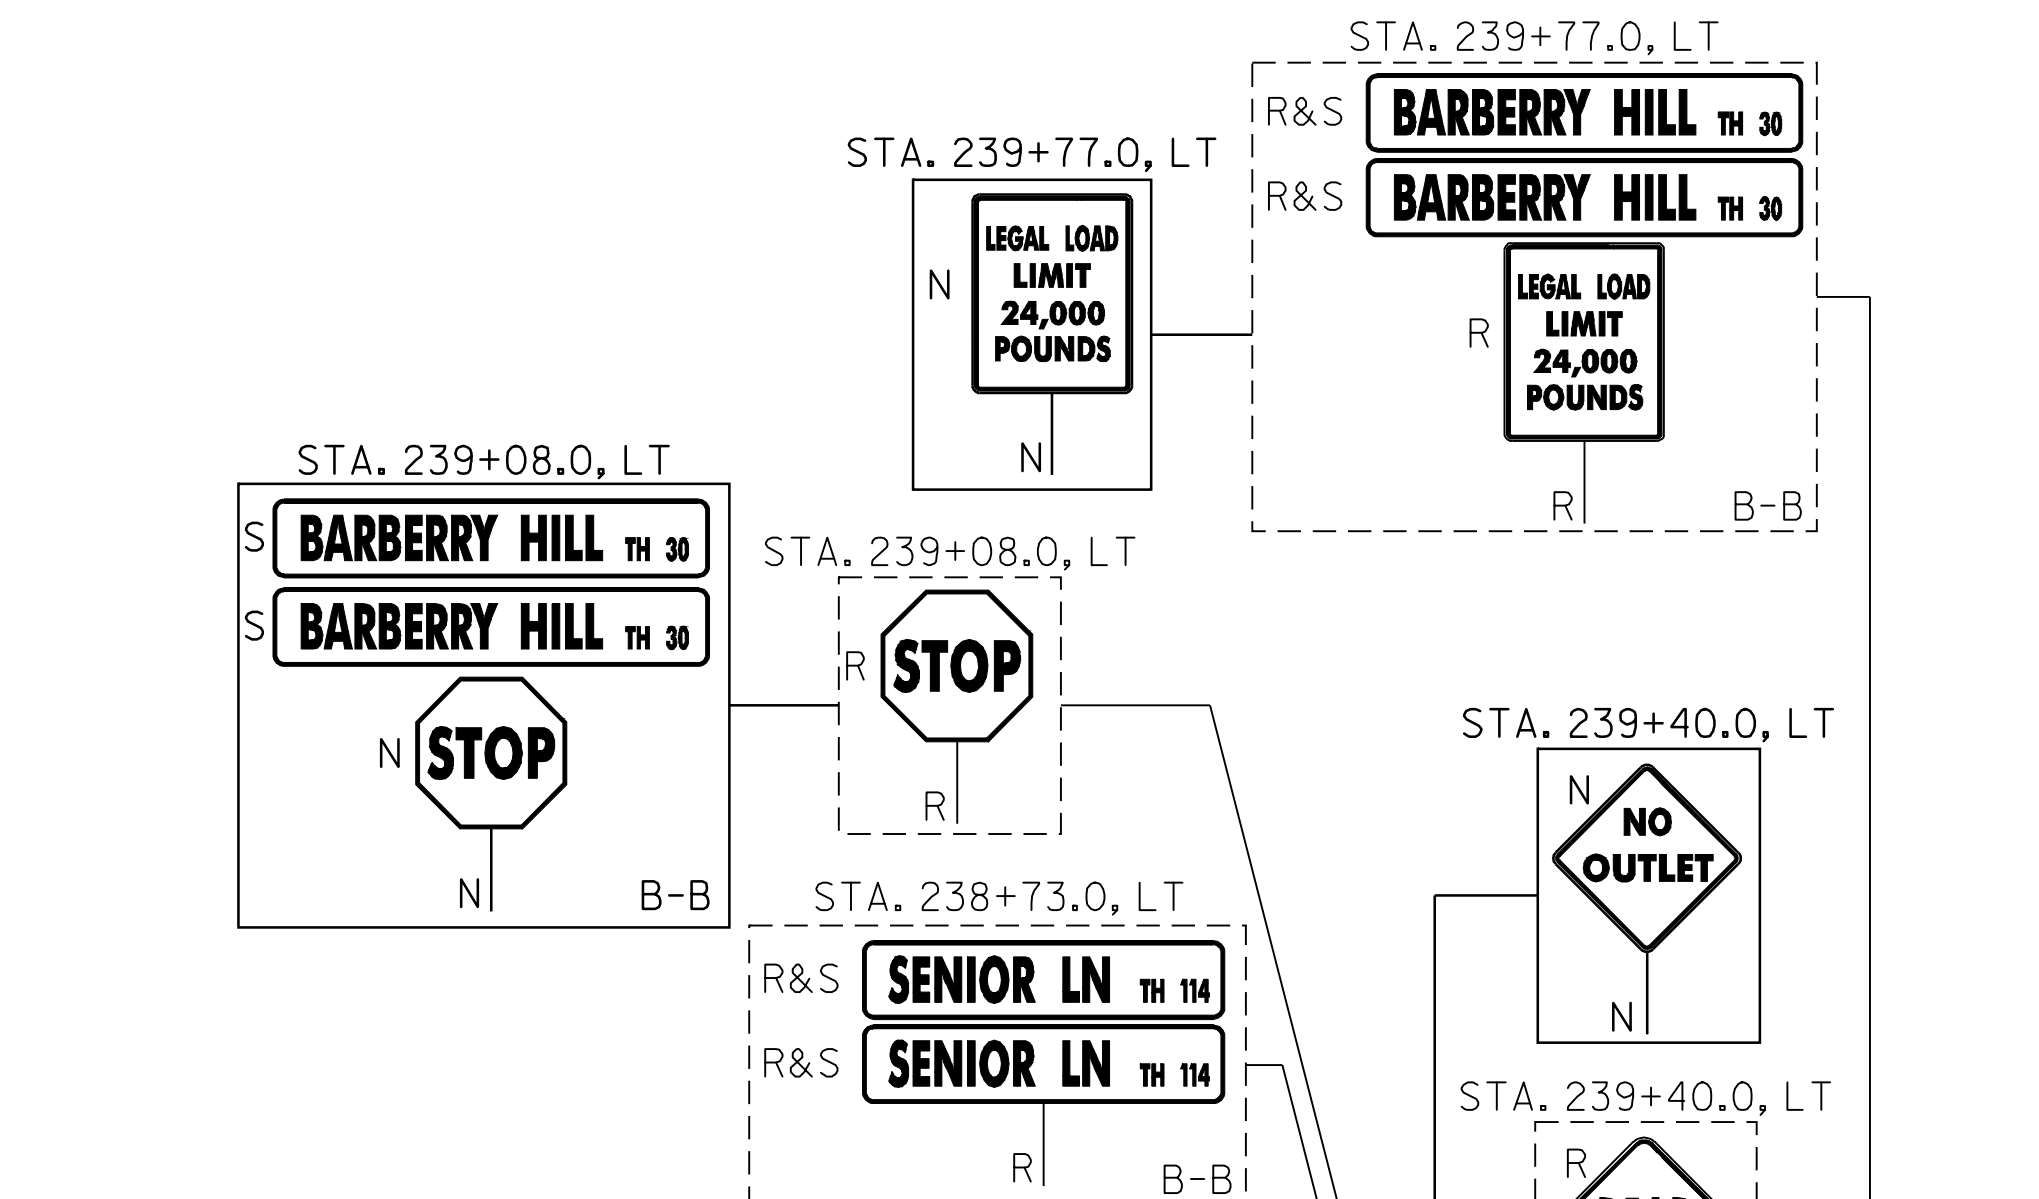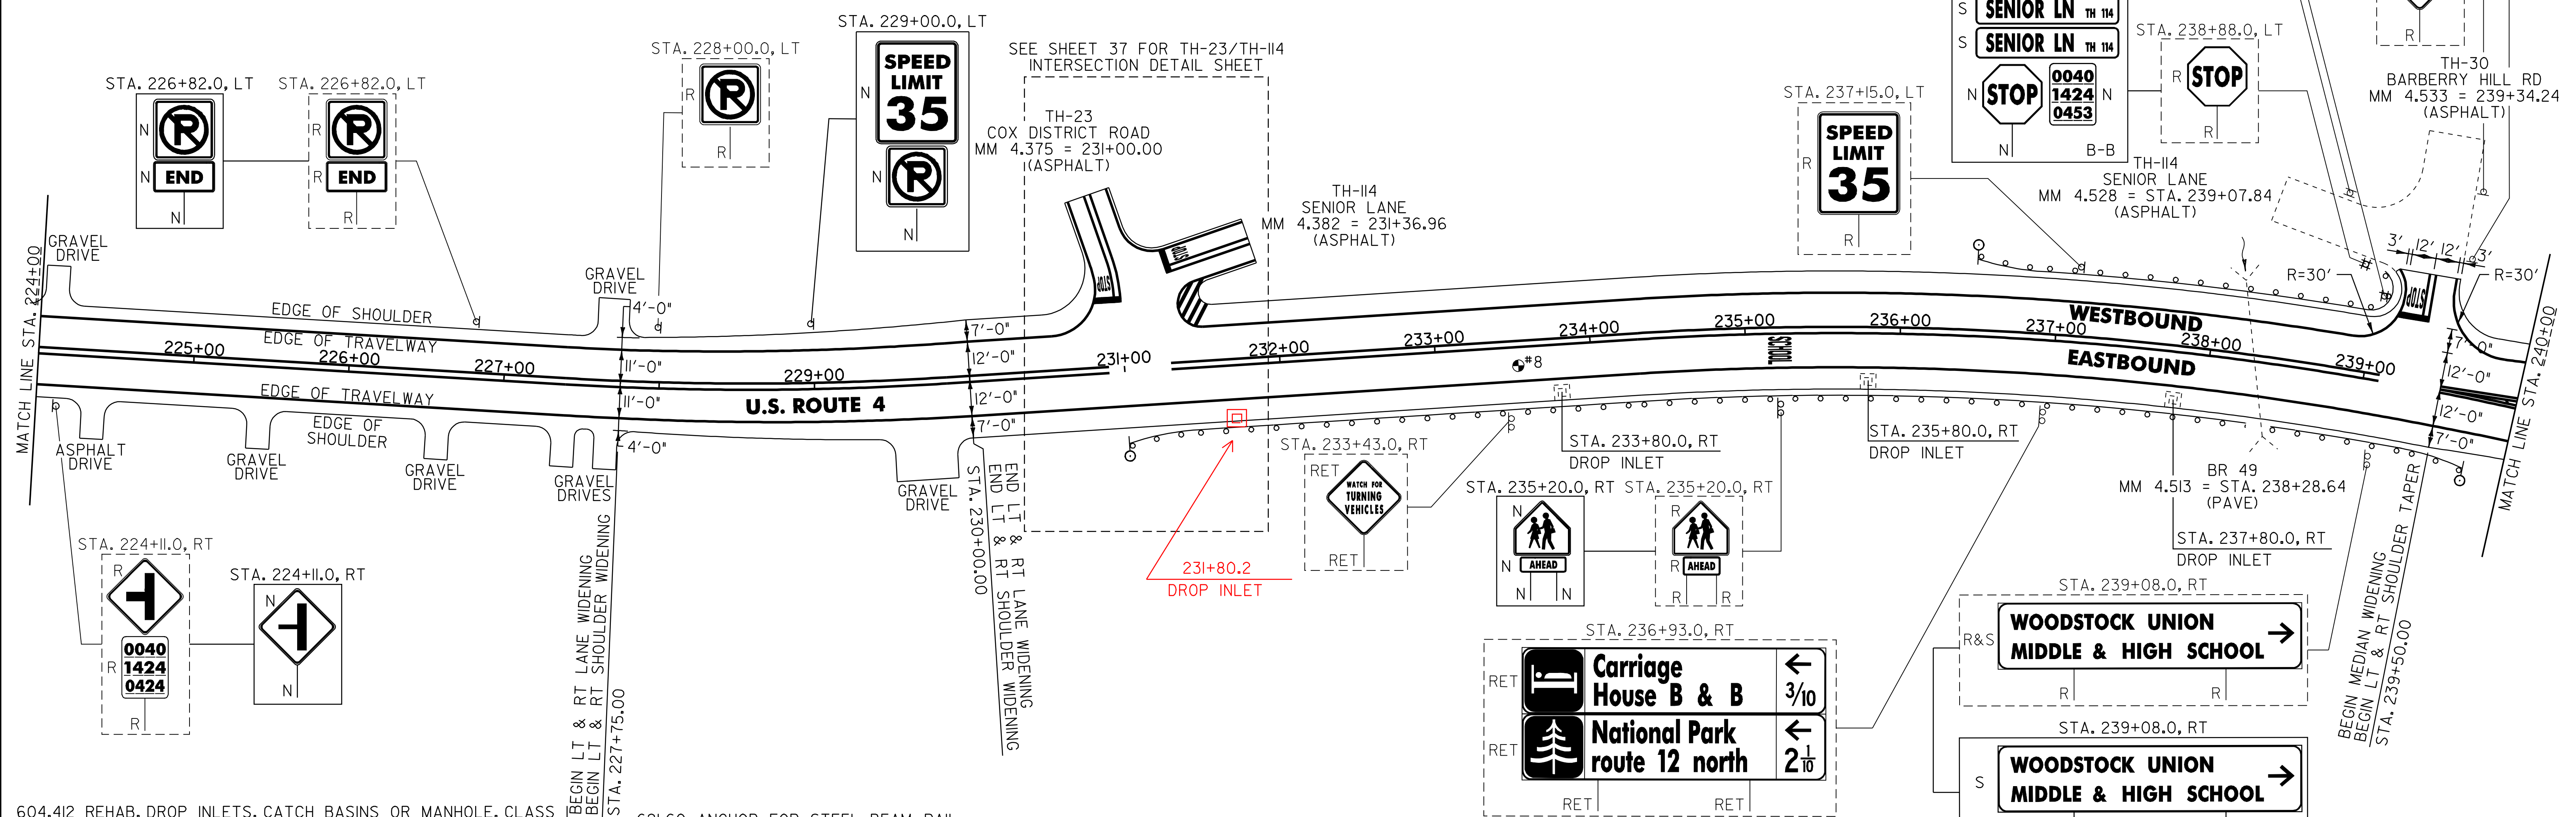

604.412 REHAB. DROP INLETS, CATCH BASINS OR MANHOLE, CLASS I
WOODSTOCK:
STA. 233+80.0 RT } COVERED W/ PLATE
STA. 235+80.0 RT } AND FILLED W/
STA. 237+80.0 RT } FLOWABLE FILL

621.20 STEEL BEAM GUARDRAIL, GALVANIZED
WOODSTOCK:
STA. 231+37.5 - STA. 239+37.5 RT (800.0 LF)
STA. 236+85.0 - STA. 239+10.0 LT (264.5 LF)

621.50 MANUFACTURED TERMINAL SECTION, FLARED
WOODSTOCK:
STA. 231+00.0 - STA. 231+37.5 RT
STA. 236+47.5 - STA. 236+85.0 LT
STA. 239+37.5 - STA. 239+75.0 RT
238+75 239+12.5

621.60 ANCHOR FOR STEEL BEAM RAIL
WOODSTOCK:
STA. 239+10.0 LT (2)

621.80 REMOVAL AND DISPOSAL OF GUARDRAIL
WOODSTOCK:
STA. 231+33.0 - STA. 239+63.0 RT (830.0 LF)
STA. 236+58.0 - STA. 239+10.0 LT (264.5 LF)

676.10 DELINEATOR WITH STEEL POST
♀ TYPE I WHITE

WOODSTOCK:
STA. 231+00.0 RT
STA. 236+47.5 LT
STA. 239+75.0 RT

NOTE:
1. PAVING LIMIT ON ALL TOWN HIGHWAYS SHALL BE MEASURED 25 FT BACK FROM U.S. ROUTE 4 EDGE OF SHOULDER UNLESS DENOTED OTHERWISE ON THE PLANS OR AS DIRECTED BY THE RESIDENT ENGINEER.

SIGN LEGEND
R = REMOVE
S = SALVAGE
N = NEW
RET = RETAIN
B-B = BACK TO BACK
EXISTING = - - - - -
NEW = _____

PAVEMENT CORES = ●
TOTAL DEPTH PCC COMMENTS (INCH)
8 5 3/4 NO

NOT TO SCALE

PROJECT LAYOUT SHEET #21

PROJECT NAME: BRIDGEWATER - WOODSTOCK
PROJECT NUMBER: NH_2611(S)

FILE NAME: p06b160.dgn
PROJECT LEADER: D.E.G.
DESIGNED BY: D.W.E.
IPARM FILE: p06b160i21.i

PLOT DATE: 28-MAY-2010
DRAWN BY: C.A.K.
CHECKED BY: D.E.G.
SHEET 32 OF 80

646.402 DURABLE 4 INCH WHITE LINE, THERMOPLASTIC
 (ALL LINES WILL INCLUDE EDGE LINE BREAKS AND RADIUS FOR TOWN HIGHWAYS)
 WOODSTOCK:
 STA. 240+00.00 - STA. 256+00.00 LT & RT
 STA. 242+00.00 - STA. 243+95.00 SOLID LINE LT
 STA. 243+95.00 - STA. 244+95.00 DOTTED LINE LT

646.412 DURABLE 4 INCH YELLOW LINE, THERMOPLASTIC
 (ALL LINES WILL INCLUDE C/L BREAKS FOR TOWN HIGHWAYS)
 WOODSTOCK:
 STA. 240+00.00 - STA. 241+80.00 DOUBLE SOLID MEDIAN LT/RT
 STA. 241+98.24 DOUBLE SOLID RT, SCHOOL DRIVEWAY
 STA. 242+20.00 - STA. 243+95.00 DOUBLE SOLID C/L
 STA. 243+95.00 - STA. 247+00.00 DOUBLE SOLID MEDIAN LT/RT
 STA. 247+00.00 - STA. 256+00.00 DOUBLE SOLID C/L
 STA. 251+27.52 DOUBLE SOLID RT, TH-50

646.452 DURABLE 8 INCH YELLOW LINE, THERMOPLASTIC
 WOODSTOCK:
 STA. 240+00.00 - STA. 241+80.00 HATCHED MEDIAN C/L
 STA. 243+95.00 - STA. 247+00.00 HATCHED MEDIAN C/L

646.482 DURABLE 24 INCH STOP BAR, THERMOPLASTIC

WOODSTOCK:
 STA. 241+98.24 RT, SCHOOL DRIVEWAY
 STA. 251+27.52 RT, TH-50

646.492 DURABLE LETTER OR SYMBOL, THERMOPLASTIC

WOODSTOCK:
 STA. 241+98.24 RT, SCHOOL DRIVEWAY, "S,T,O,P" (4 EA)
 STA. 242+29.3 LT ARROW (1 EA)
 STA. 242+69.3 LT "O,N,L,Y" (4 EA)
 STA. 243+54.8 LT ARROW (1 EA)
 STA. 243+91.0 LT "O,N,L,Y" (4 EA)
 STA. 250+14.0 LT "S,C,H,O,O,L" (6 EA)
 STA. 251+27.52 RT, TH-50, "S,T,O,P" (4 EA)

646.501 DURABLE CROSSWALK MARKING, TYPE I TAPE

WOODSTOCK:
 STA. 247+82.00 LT/RT

646.602 TEMPORARY 4 INCH WHITE LINE, PAINT
 (ALL LINES WILL INCLUDE EDGE LINE BREAKS AND RADIUS FOR TOWN HIGHWAYS)

WOODSTOCK:
 STA. 240+00.00 - STA. 256+00.00 LT & RT
 STA. 242+00.00 - STA. 243+95.00 SOLID LINE LT
 STA. 243+95.00 - STA. 244+95.00 DOTTED LINE LT

646.612 TEMPORARY 4 INCH YELLOW LINE, PAINT
 (ALL LINES WILL INCLUDE C/L BREAKS FOR TOWN HIGHWAYS) S=SOLID, D=DASHED

WOODSTOCK:
 STA. 240+00.00 - STA. 241+80.00 DOUBLE SOLID MEDIAN LT/RT
 STA. 241+98.24 DOUBLE SOLID RT, SCHOOL DRIVEWAY
 STA. 242+20.00 - STA. 243+95.00 DOUBLE SOLID C/L
 STA. 243+95.00 - STA. 247+00.00 DOUBLE SOLID MEDIAN LT/RT
 STA. 247+00.00 - STA. 256+00.00 DOUBLE SOLID C/L
 STA. 251+27.52 DOUBLE SOLID RT, TH-50

646.682 TEMPORARY 24 INCH STOP BAR, PAINT

WOODSTOCK:
 STA. 241+98.24 RT, SCHOOL DRIVEWAY
 STA. 251+27.52 RT, TH-50

646.692 TEMPORARY LETTER OR SYMBOL, PAINT

WOODSTOCK:
 STA. 241+98.24 RT, SCHOOL DRIVEWAY, "S,T,O,P" (8 EA)
 STA. 242+29.3 LT ARROW (2 EA)
 STA. 243+54.8 LT ARROW (2 EA)
 STA. 250+14.0 LT "S,C,H,O,O,L" (12 EA)
 STA. 251+27.52 RT, TH-50, "S,T,O,P" (8 EA)

646.702 TEMPORARY CROSSWALK MARKING, PAINT


WOODSTOCK:
 STA. 247+82.00 LT/RT

675.50 REMOVING SIGNS

AS SHOWN - 20

675.60 ERECTING SALVAGED SIGNS

AS SHOWN - 5

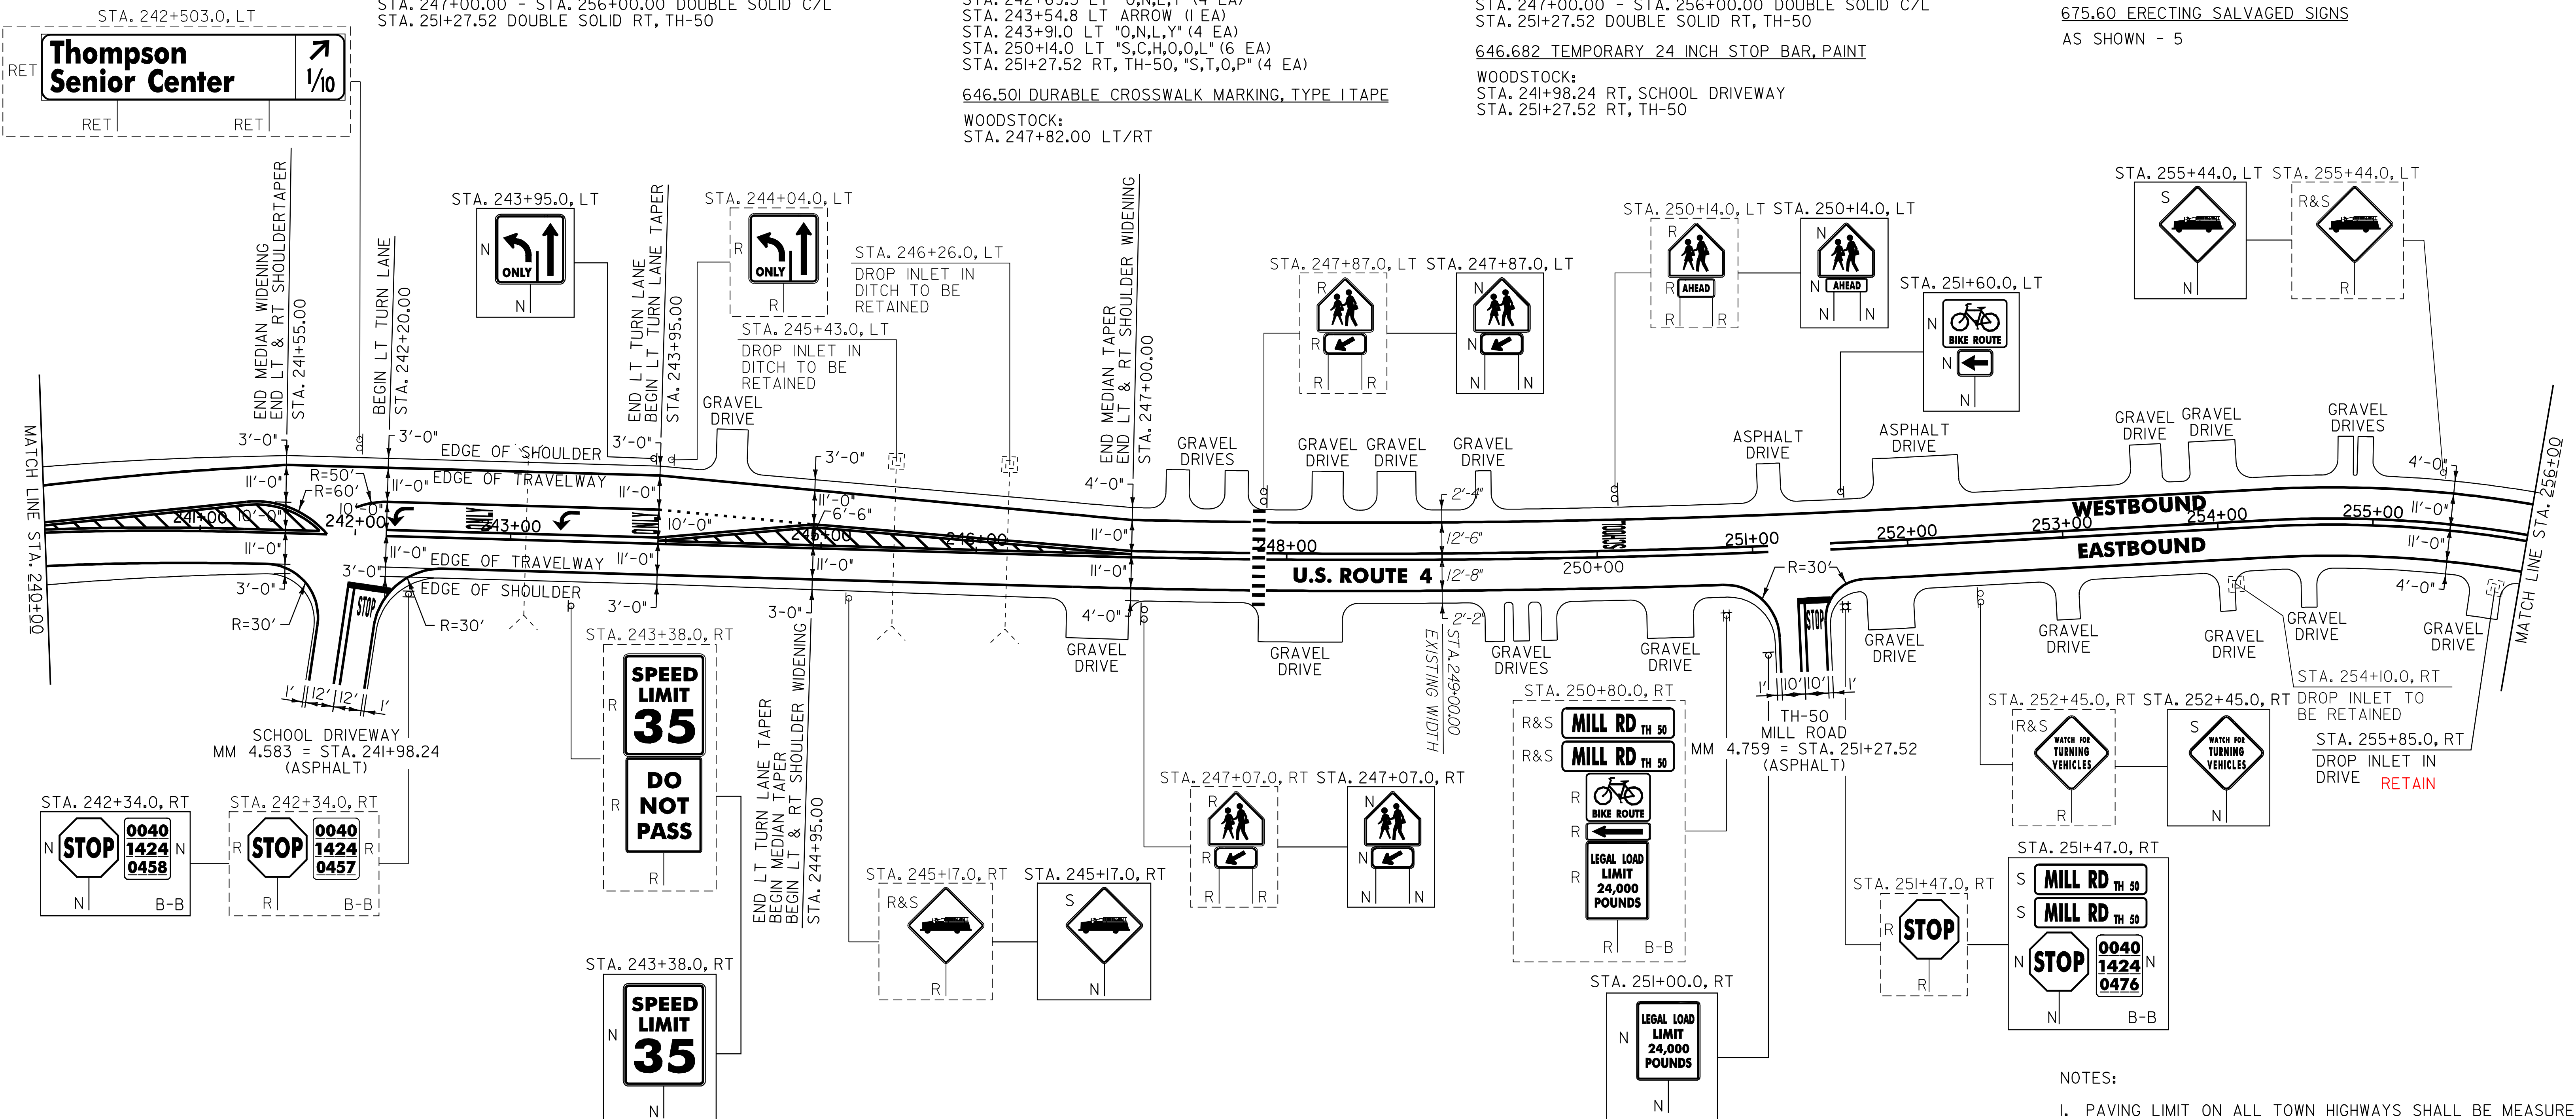

604.412 REHAB. DROP INLETS, CATCH BASINS OR MANHOLE, CLASS 1
 WOODSTOCK:
 STA. 255+85.0 RT

SIGN LEGEND
 R = REMOVE
 S = SALVAGE
 N = NEW
 RET = RETAIN
 B-B = BACK TO BACK
 EXISTING =
 NEW =

NOT TO SCALE
PROJECT LAYOUT SHEET #22

PROJECT NAME: BRIDGEWATER - WOODSTOCK
 PROJECT NUMBER: NH_2611(S)
 FILE NAME: p06b160.dgn
 PROJECT LEADER: D.E.G.
 DESIGNED BY: D.W.E.
 IPARM FILE: p06b160i22.i
 PLOT DATE: 28-MAY-2010
 DRAWN BY: C.A.K.
 CHECKED BY: D.E.G.
 SHEET 33 OF 80

NOTES:
 1. PAVING LIMIT ON ALL TOWN HIGHWAYS SHALL BE MEASURED 25 FT BACK FROM U.S. ROUTE 4 EDGE OF SHOULDER UNLESS DENOTED OTHERWISE ON THE PLANS OR AS DIRECTED BY THE RESIDENT ENGINEER.
 2. SEE SHEET 79 FOR DETAIL OF CROSSWALK MARKINGS.


646.402 DURABLE 4 INCH WHITE LINE, THERMOPLASTIC
 (ALL LINES WILL INCLUDE EDGE LINE BREAKS AND RADIUS FOR TOWN HIGHWAYS)
 WOODSTOCK:
 STA. 256+00.00 - STA. 272+00.00 LT & RT

646.412 DURABLE 4 INCH YELLOW LINE, THERMOPLASTIC
 (ALL LINES WILL INCLUDE C/L BREAKS FOR TOWN HIGHWAYS) S=SOLID, D=DASHED
 WOODSTOCK:
 STA. 256+00.00 - STA. 272+00.00 LT @ RT
 S - S

646.602 TEMPORARY 4 INCH WHITE LINE, PAINT
 (ALL LINES WILL INCLUDE EDGE LINE BREAKS AND RADIUS FOR TOWN HIGHWAYS)
 WOODSTOCK:
 STA. 256+00.00 - STA. 272+00.00 LT & RT

646.612 TEMPORARY 4 INCH YELLOW LINE, PAINT
 (ALL LINES WILL INCLUDE C/L BREAKS FOR TOWN HIGHWAYS) S=SOLID, D=DASHED
 WOODSTOCK:
 STA. 256+00.00 - STA. 272+00.00 LT @ RT
 S - S

675.50 REMOVING SIGNS
 AS SHOWN - 7

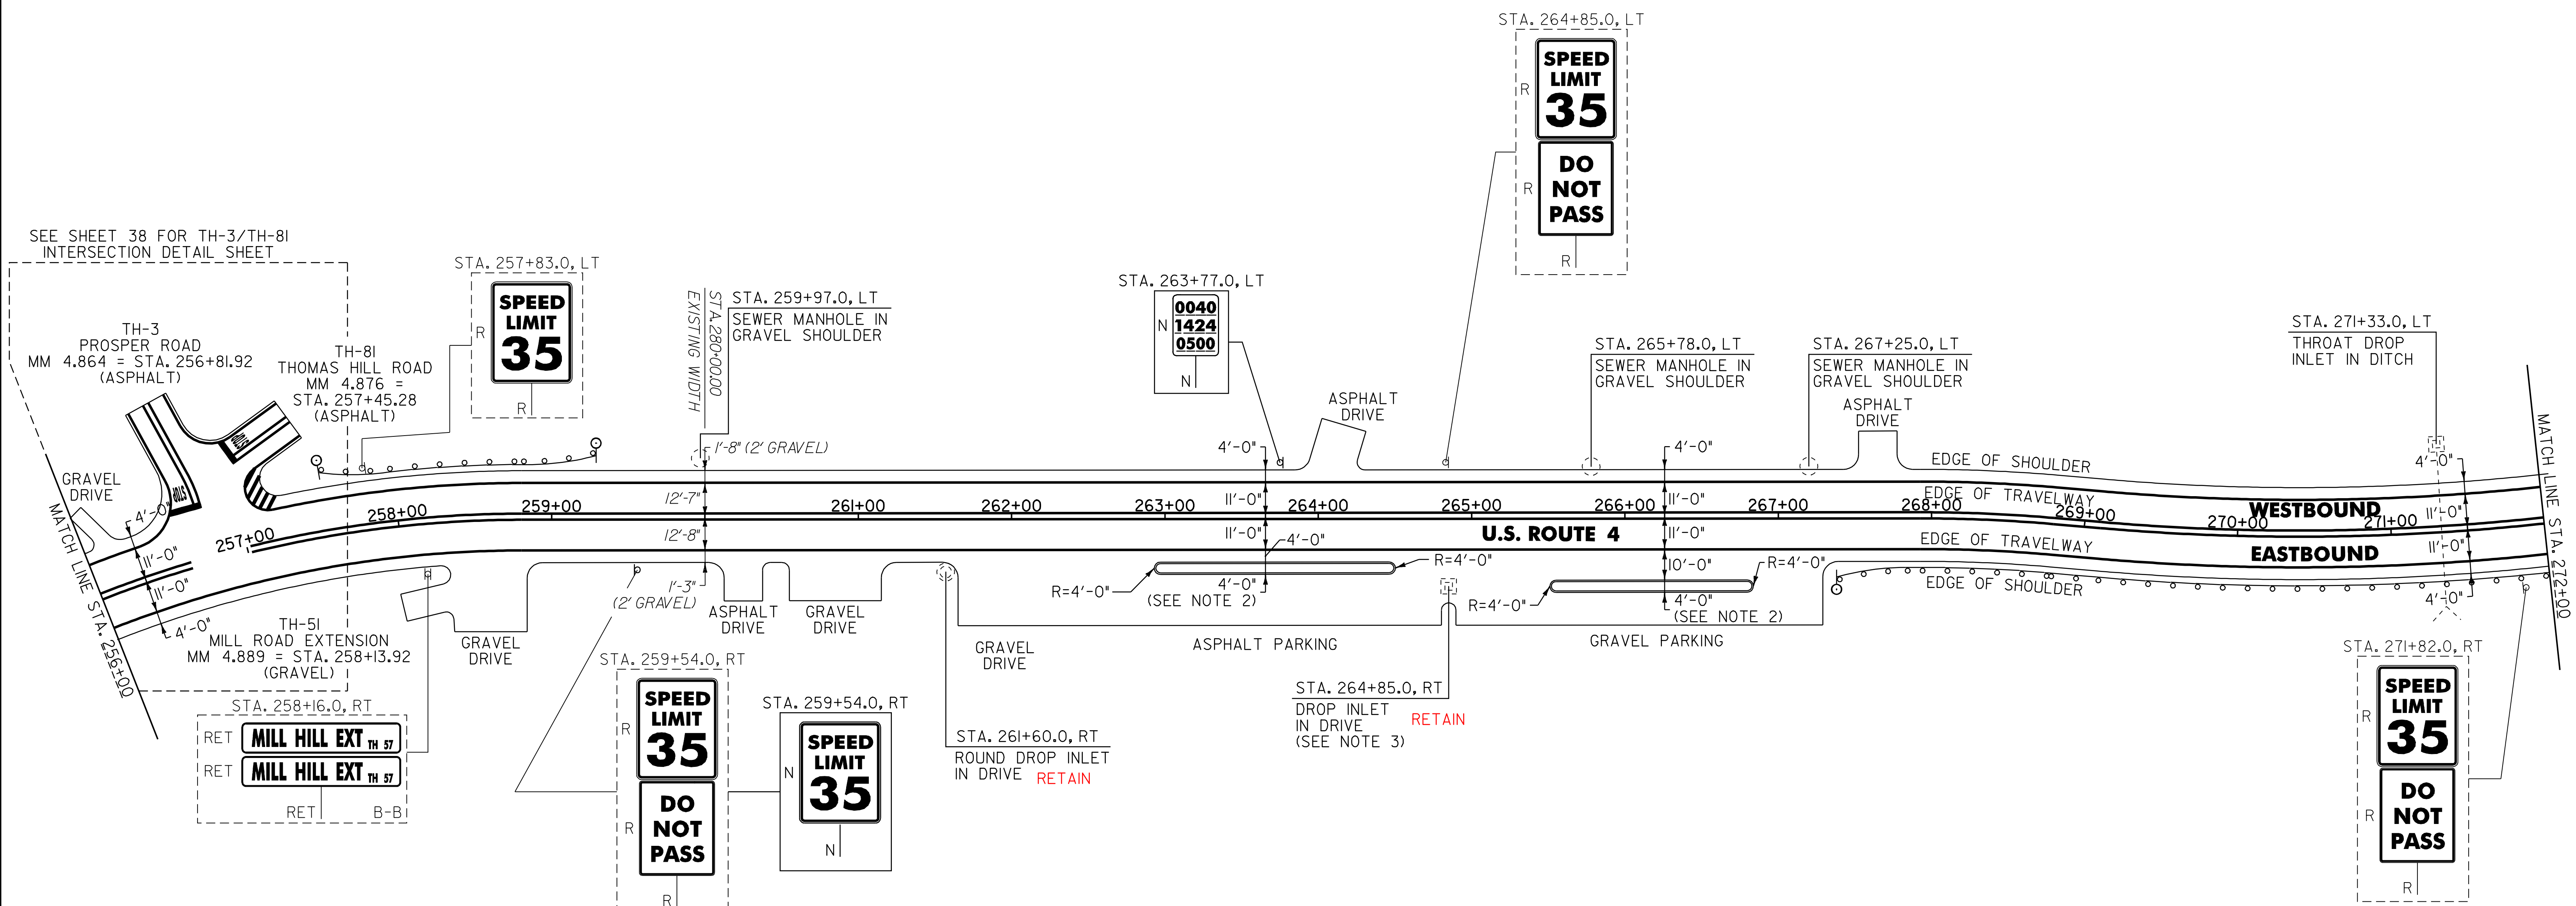

604.412 REHAB. DROP INLETS, CATCH BASINS OR MANHOLE, CLASS 1

WOODSTOCK:
~~STA. 261+60.0 RT~~
~~STA. 264+85.0 RT~~
 STA. 271+33.0 LT

604.42 CHANGING ELEVATION OF SEWER MANHOLES

WOODSTOCK:
 STA. 259+97.0 LT
 STA. 265+78.0 LT
 STA. 267+25.0 LT

~~616.28 CAST IN-PLACE CONCRETE CURB, TYPE B~~

WOODSTOCK:
~~STA. 262+93.0 STA. 264+94.0 RT (410.0 LF)~~
~~STA. 265+51.0 STA. 266+79.0 RT (264.0 LF)~~

616.47 BITUMINOUS CONCRETE GUTTERS AND TRAFFIC ISLANDS

WOODSTOCK:
 STA. 262+93.5 - STA. 264+93.5 RT (3.0 TON)
 STA. 265+51.5 - STA. 266+78.5 RT (2.0 TON)

621.20 STEEL BEAM GUARDRAIL, GALVANIZED

WOODSTOCK:
 STA. 257+91.5 - STA. 258+91.5 LT (100.0 LF)
 STA. 258+54.0 - STA. 259+41.5 LT

621.205 STEEL BEAM GUARDRAIL, GALVANIZED W/8 FEET POSTS

WOODSTOCK:
 STA. 267+76.0 - STA. 272+00.0 RT (424.0 LF)

621.50 MANUFACTURED TERMINAL SECTION, FLARED

WOODSTOCK:
~~STA. 257+54.0 STA. 257+91.5 LT~~
~~STA. 258+91.5 STA. 259+29.0 LT~~
 STA. 267+38.5 - STA. 267+76.0 RT
 STA. 271+77.5 - STA. 272+15

621.80 REMOVAL AND DISPOSAL OF GUARDRAIL

WOODSTOCK:
 STA. 257+54.0 - STA. 258+30.0 LT (76.0 LF)
 STA. 267+40.0 - STA. 271+50.0 RT (410.0 LF)

621.51 MANUFACTURED TERMINAL SECTION, TANGENT
 258+41.5 - 258+91.5 RT

ANCHOR FOR STEEL BEAM GUARDRAIL
 257+54 LT

676.10 DELINEATOR WITH STEEL POST

♀ TYPE 1 WHITE
 WOODSTOCK:
 STA. 257+54.0 LT
 STA. 259+29.0 LT
 STA. 267+38.5 RT

SIGN LEGEND
 R = REMOVE
 S = SALVAGE
 N = NEW
 RET = RETAIN
 B-B = BACK TO BACK
 EXISTING = -----
 NEW = _____

- NOTES:
- PAVING LIMIT ON ALL TOWN HIGHWAYS SHALL BE MEASURED 25 FT BACK FROM U.S. ROUTE 4 EDGE OF SHOULDER UNLESS DENOTED OTHERWISE ON THE PLANS OR AS DIRECTED BY THE RESIDENT ENGINEER.
 - SEE SHEET 79 FOR BITUMINOUS CONCRETE TRAFFIC ISLAND DETAIL.
 - THE CONTRACTOR SHALL GRADE TO DRAIN THE EXISTING DRIVES AND PROVIDE PAVED APRONS FOR THE DRIVES AS DIRECTED BY THE RESIDENT ENGINEER.

PROJECT LAYOUT SHEET #23	NOT TO SCALE	
	PROJECT NAME: BRIDGEWATER - WOODSTOCK	PROJECT NUMBER: NH_2611(S)
FILE NAME: p06b160.dgn	PLOT DATE: 28-MAY-2010	PROJECT LEADER: D.E.G.
DESIGNED BY: D.W.E.	CHECKED BY: D.E.G.	
IPARM FILE: p06b160i23.i	SHEET 34 OF 80	


646.402 DURABLE 4 INCH WHITE LINE, THERMOPLASTIC
 (ALL LINES WILL INCLUDE EDGE LINE BREAKS AND RADIUS FOR TOWN HIGHWAYS)
 WOODSTOCK:
 STA. 272+00.00 - STA. 288+00.00 LT & RT

646.412 DURABLE 4 INCH YELLOW LINE, THERMOPLASTIC
 (ALL LINES WILL INCLUDE C/L BREAKS FOR TOWN HIGHWAYS) S=SOLID, D=DASHED
 WOODSTOCK:
 STA. 272+00.00 - STA. 288+00.00 LT C RT
 S - S

646.602 TEMPORARY 4 INCH WHITE LINE, PAINT
 (ALL LINES WILL INCLUDE EDGE LINE BREAKS AND RADIUS FOR TOWN HIGHWAYS)
 WOODSTOCK:
 STA. 272+00.00 - STA. 288+00.00 LT & RT

646.612 TEMPORARY 4 INCH YELLOW LINE, PAINT
 (ALL LINES WILL INCLUDE C/L BREAKS FOR TOWN HIGHWAYS) S=SOLID, D=DASHED
 WOODSTOCK:
 STA. 272+00.00 - STA. 288+00.00 LT C RT
 S - S

675.50 REMOVING SIGNS
 AS SHOWN - 2

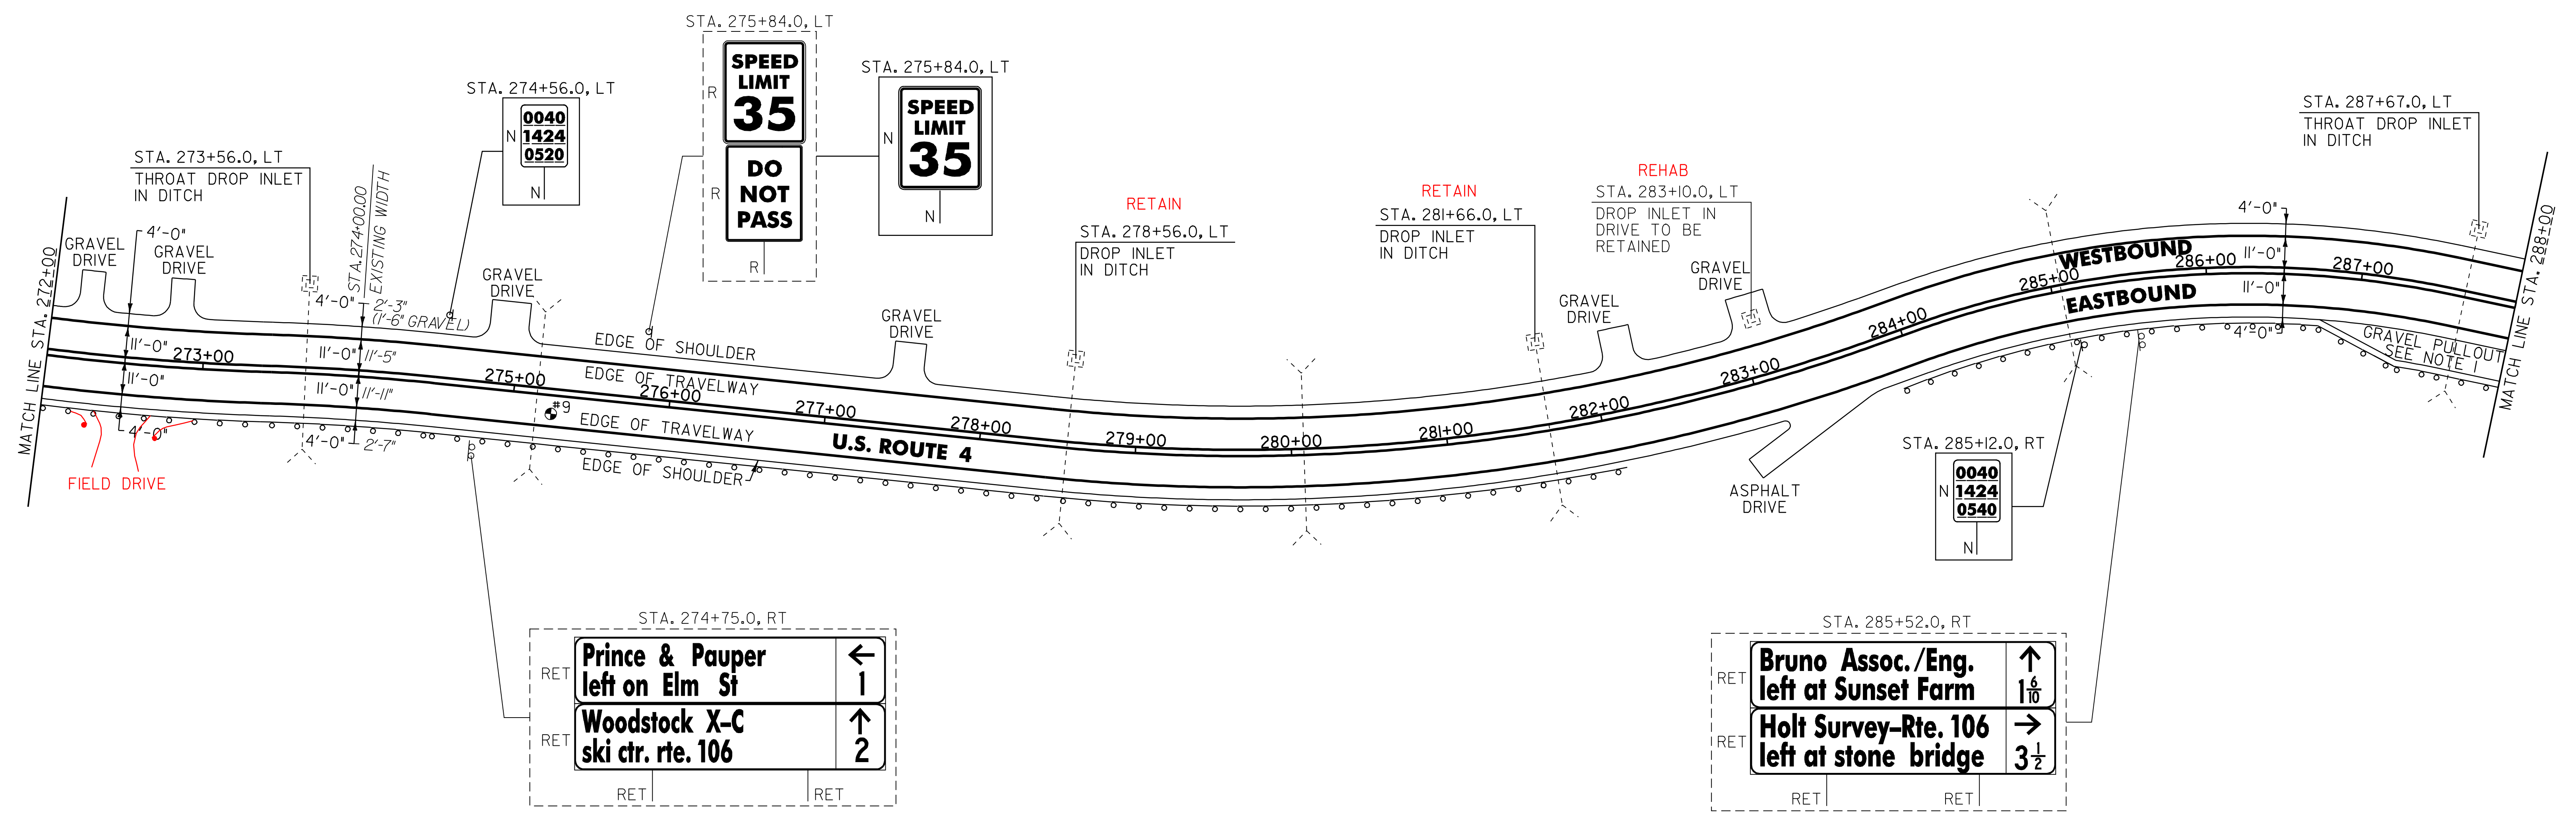

604.412 REHAB. DROP INLETS, CATCH BASINS OR MANHOLE, CLASS I
 WOODSTOCK:
 STA. 273+56.0 LT 283+10 LT
~~STA. 278+56.0 LT~~
~~STA. 281+66.0 LT~~
 STA. 287+67.0 LT

621.51 MANUFACTURED TERMINAL SECTION, TANGENT
 WOODSTOCK:
 STA. 281+51.0 - STA. 282+01.0 RT
 STA. 283+93.0 - STA. 284+43.0 RT

621.50 MANUFACTURED TERMINAL SECTION, FLARED
 271+77.5 - 272+15 RT
 272+88 - 273+25.5 RT

621.80 REMOVAL AND DISPOSAL OF GUARDRAIL
 WOODSTOCK:
 STA. 272+91.0 - STA. 282+01.0 RT (910.0 LF)
 STA. 283+93.0 - STA. 288+00.0 RT (407.0 LF)

621.205 STEEL BEAM GUARDRAIL, GALVANIZED W/8 FEET POSTS
 WOODSTOCK: 273+25.5 825
 STA. ~~272+00.0~~ - STA. 281+51.0 RT (951.0 LF)
 STA. 284+43.0 - STA. 288+00.0 RT (357.0 LF)

PAVEMENT CORES =

#	TOTAL DEPTH (INCH)	PCC	COMMENTS
9	11	NO	

SIGN LEGEND
 R = REMOVE
 S = SALVAGE
 N = NEW
 RET = RETAIN
 B-B = BACK TO BACK
 EXISTING =
 NEW =

NOTE:
 I. PROVIDE A 5 FT WIDE, 1 3/4" TYPE III APRON FOR THE EXISTING GRAVEL PULLOUT. ANY REQUIRED EXCAVATION SHALL BE PERFORMED AS DIRECTED BY THE RESIDENT ENGINEER AND PAID FOR UNDER ITEM 608.25 ALL PURPOSE EXCAVATOR RENTAL, TYPE I.

NOT TO SCALE

PROJECT LAYOUT SHEET #24

PROJECT NAME: BRIDGEWATER - WOODSTOCK
 PROJECT NUMBER: NH_2611(S)

FILE NAME: p06b160.dgn PLOT DATE: 28-MAY-2010
 PROJECT LEADER: D.E.G. DRAWN BY: C.A.K.
 DESIGNED BY: D.W.E. CHECKED BY: D.E.G.
 IPARM FILE: p06b160124.i SHEET 35 OF 80


646.402 DURABLE 4 INCH WHITE LINE, THERMOPLASTIC
 (ALL LINES WILL INCLUDE EDGE LINE BREAKS AND
 RADIUS FOR TOWN HIGHWAYS)
 WOODSTOCK:
 STA. 288+00.00 - STA. 298+32.00 LT & RT

646.412 DURABLE 4 INCH YELLOW LINE, THERMOPLASTIC
 (ALL LINES WILL INCLUDE C/L BREAKS FOR
 TOWN HIGHWAYS) S=SOLID, D=DASHED
 WOODSTOCK:
 STA. 288+00.00 - STA. 298+32.00 LT C RT
 S - S

646.602 TEMPORARY 4 INCH WHITE LINE, PAINT
 (ALL LINES WILL INCLUDE EDGE LINE BREAKS AND
 RADIUS FOR TOWN HIGHWAYS)
 WOODSTOCK:
 STA. 288+00.00 - STA. 298+32.00 LT & RT

646.612 TEMPORARY 4 INCH YELLOW LINE, PAINT
 (ALL LINES WILL INCLUDE C/L BREAKS FOR
 TOWN HIGHWAYS) S=SOLID, D=DASHED
 WOODSTOCK:
 STA. 288+00.00 - STA. 298+32.00 LT C RT
 S - S

675.50 REMOVING SIGNS
 AS SHOWN - 1

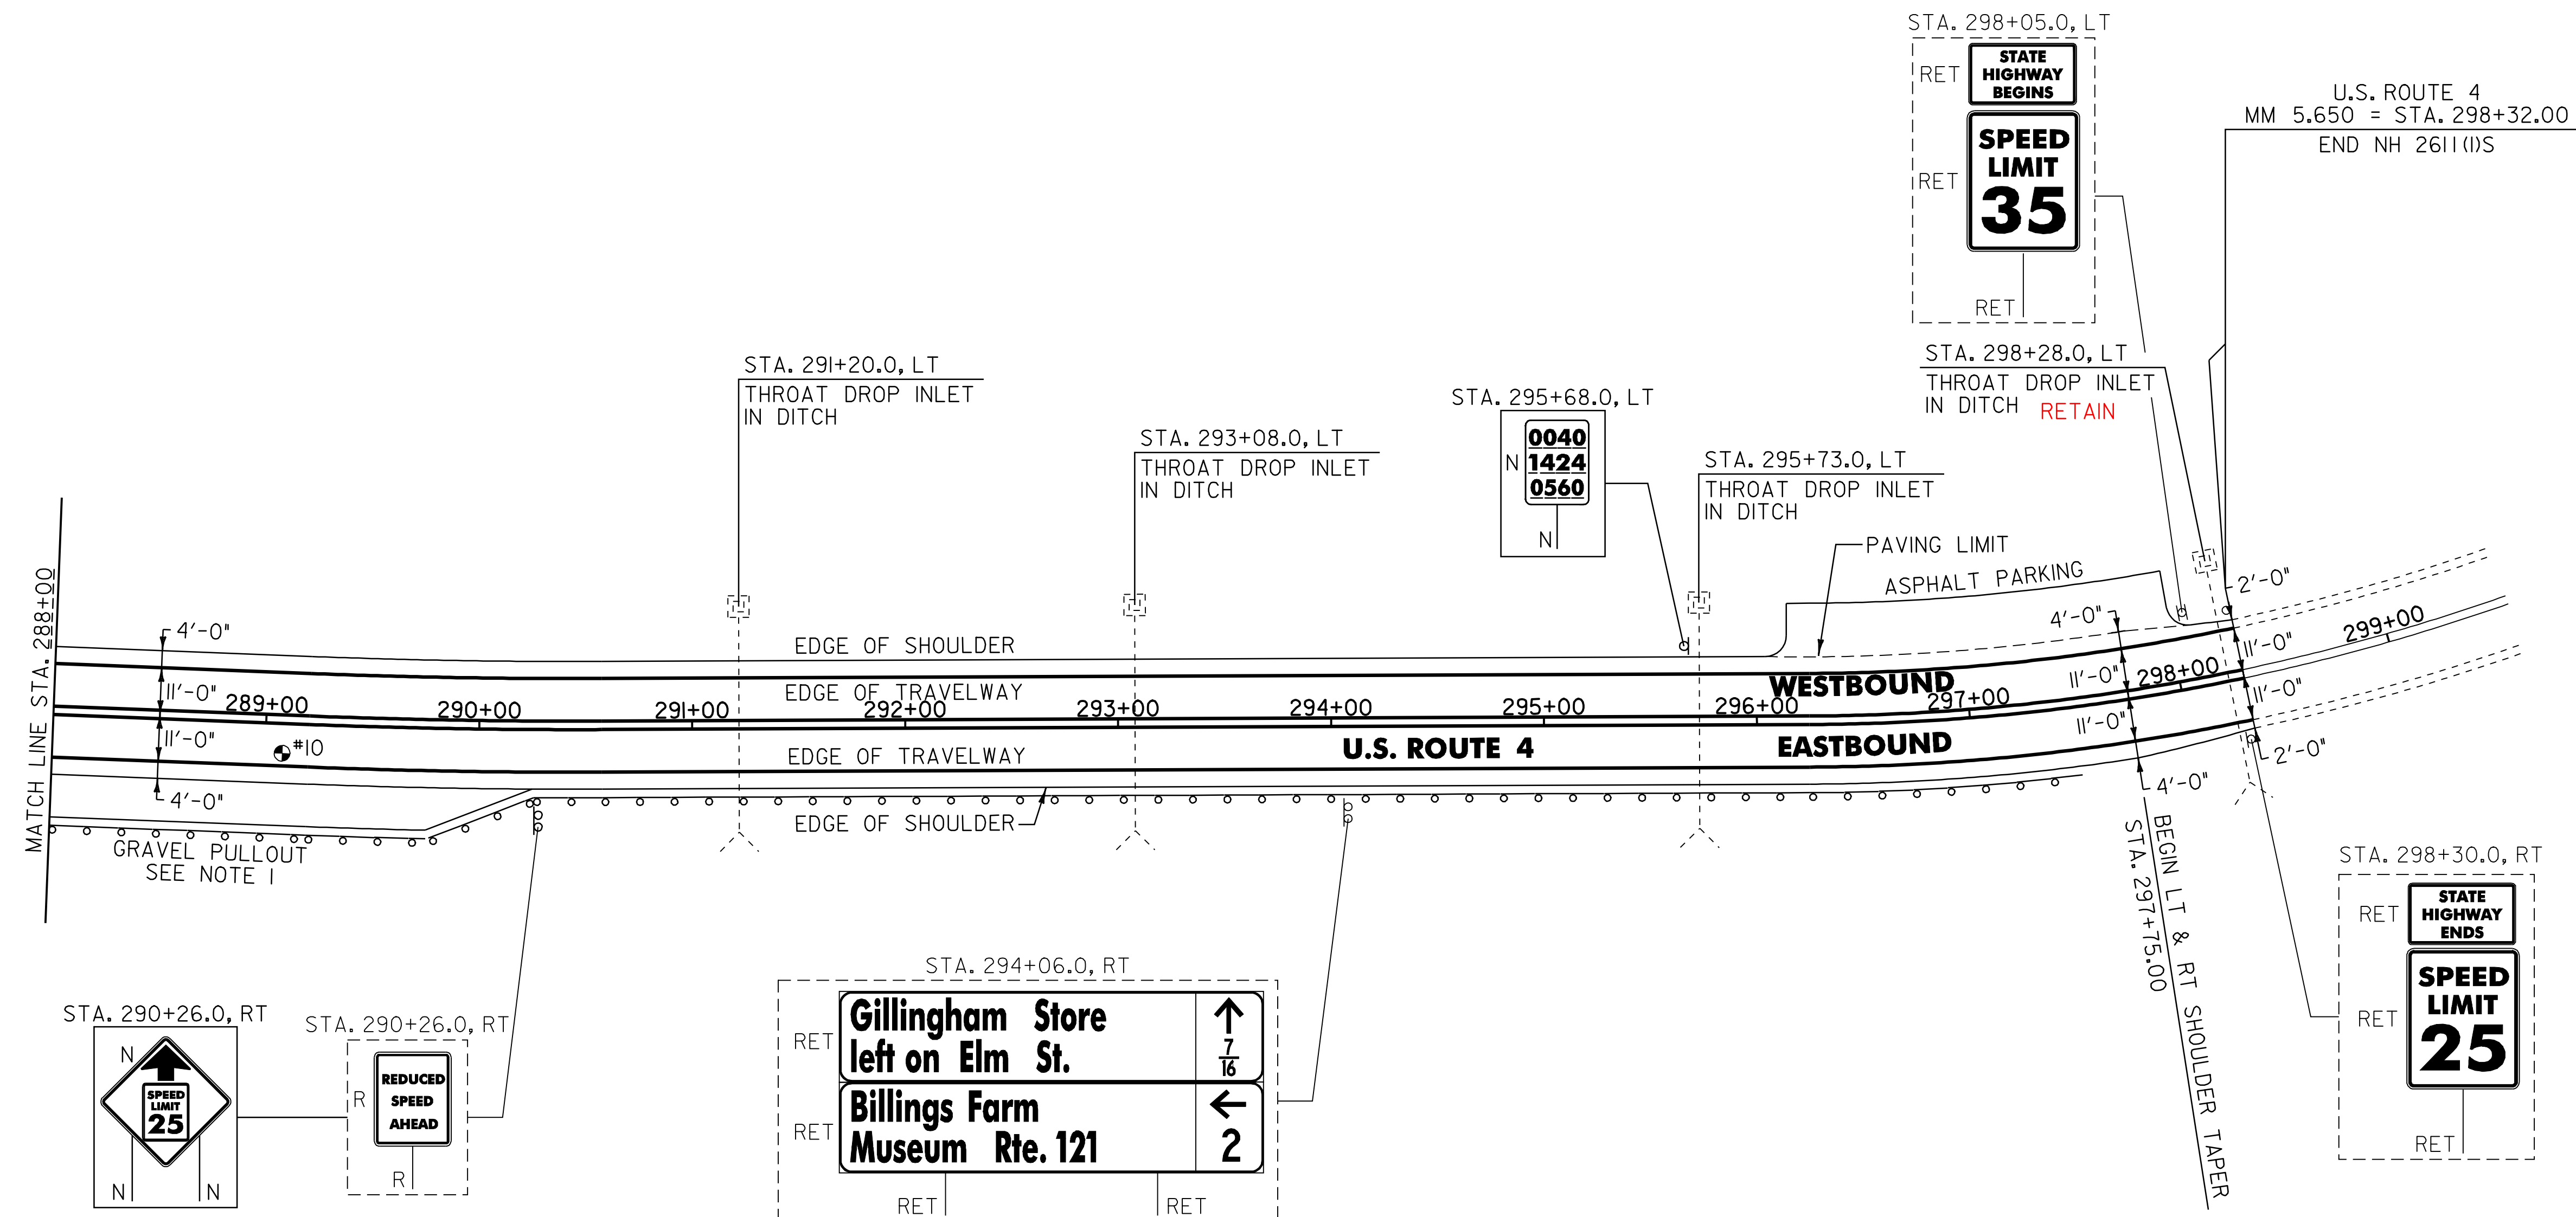

604.412 REHAB. DROP INLETS, CATCH BASINS OR MANHOLE, CLASS I

WOODSTOCK:
 STA. 291+20.0 LT
 STA. 293+08.0 LT
 STA. 295+73.0 LT
~~STA. 298+28.0 LT~~

621.205 STEEL BEAM GUARDRAIL, GALVANIZED W/8 FEET POSTS

WOODSTOCK: 68.5 968
 STA. 288+00.0 - STA. 297+05.5 RT (905.5 LF)

~~621.51 MANUFACTURED TERMINAL SECTION, TANGENT~~

~~WOODSTOCK:
 STA. 297+05.5 - STA. 297+55.5 RT~~

621.80 REMOVAL AND DISPOSAL OF GUARDRAIL

WOODSTOCK:
 STA. 288+00.0 - STA. 297+54.0 RT (954.0 LF)

621.60 ANCHOR FOR STEEL BEAM GUARDRAIL
 297+68 RT

PAVEMENT CORES = ●

#	TOTAL DEPTH (INCH)	PCC	COMMENTS
10	9	NO	

SIGN LEGEND
 R = REMOVE
 S = SALVAGE
 N = NEW
 RET = RETAIN
 B-B = BACK TO BACK
 EXISTING = -----
 NEW = _____

NOTE:

I. PROVIDE A 5 FT WIDE, 1 3/4" TYPE III APRON FOR THE EXISTING GRAVEL PULLOUT. ANY REQUIRED EXCAVATION OR GRADING SHALL BE PERFORMED AS DIRECTED BY THE RESIDENT ENGINEER AND PAID FOR UNDER THE APPLICABLE RENTAL ITEM(S).

NOT TO SCALE

PROJECT LAYOUT SHEET #25	PROJECT NAME: BRIDGEWATER - WOODSTOCK	PLOT DATE: 28-MAY-2010
	PROJECT NUMBER: NH_2611(S)	DRAWN BY: C.A.K.
	FILE NAME: p06b160.dgn	CHECKED BY: D.E.G.
	DESIGNED BY: D.W.E.	SHEET 36 OF 80
	IPARM FILE: p06b160i25.i	

646.412 DURABLE 4 INCH YELLOW LINE, THERMOPLASTIC
 (ALL LINES WILL INCLUDE C/L BREAKS FOR TOWN HIGHWAYS) S=SOLID, D=DASHED

WOODSTOCK:
 STA. 231+00.00 DOUBLE SOLID LT, TH-23
 STA. 231+36.96 DOUBLE SOLID LT, TH-II4

646.482 DURABLE 24" STOP BAR, THERMOPLASTIC

WOODSTOCK:
 STA. 231+00.00 LT, TH-23
 STA. 231+36.96 LT, TH-II4

646.492 DURABLE LETTER OR SYMBOL, THERMOPLASTIC

WOODSTOCK:
 STA. 231+00.00 LT, TH-23 "S,T,O,P" (4 EA)
 STA. 231+36.96 LT, TH-II4 "S,T,O,P" (4 EA)

646.612 TEMPORARY 4 INCH YELLOW LINE, PAINT
 (ALL LINES WILL INCLUDE C/L BREAKS FOR TOWN HIGHWAYS) S=SOLID, D=DASHED

WOODSTOCK:
 STA. 231+00.00 DOUBLE SOLID LT, TH-23
 STA. 231+36.96 DOUBLE SOLID LT, TH-II4

646.682 TEMPORARY 24" STOP BAR, PAINT

WOODSTOCK:
 STA. 231+00.00 LT, TH-23
 STA. 231+36.96 LT, TH-II4

646.692 TEMPORARY LETTER OR SYMBOL, PAINT

WOODSTOCK:
 STA. 231+00.00 LT, TH-23 "S,T,O,P" (8 EA)
 STA. 231+36.96 LT, TH-II4 "S,T,O,P" (8 EA)

646.442 DURABLE 8 INCH WHITE LINE, THERMOPLASTIC
 (ALL LINES WILL INCLUDE C/L BREAKS FOR TOWN HIGHWAYS) S=SOLID, D=DASHED


WOODSTOCK:
 STA. 231+36.96 - STA. 231+75.00 SHOULDER HATCHING LT, TH-II4

675.50 REMOVING SIGNS

AS SHOWN - II

675.60 ERECTING SALVAGED SIGNS

AS SHOWN - 4

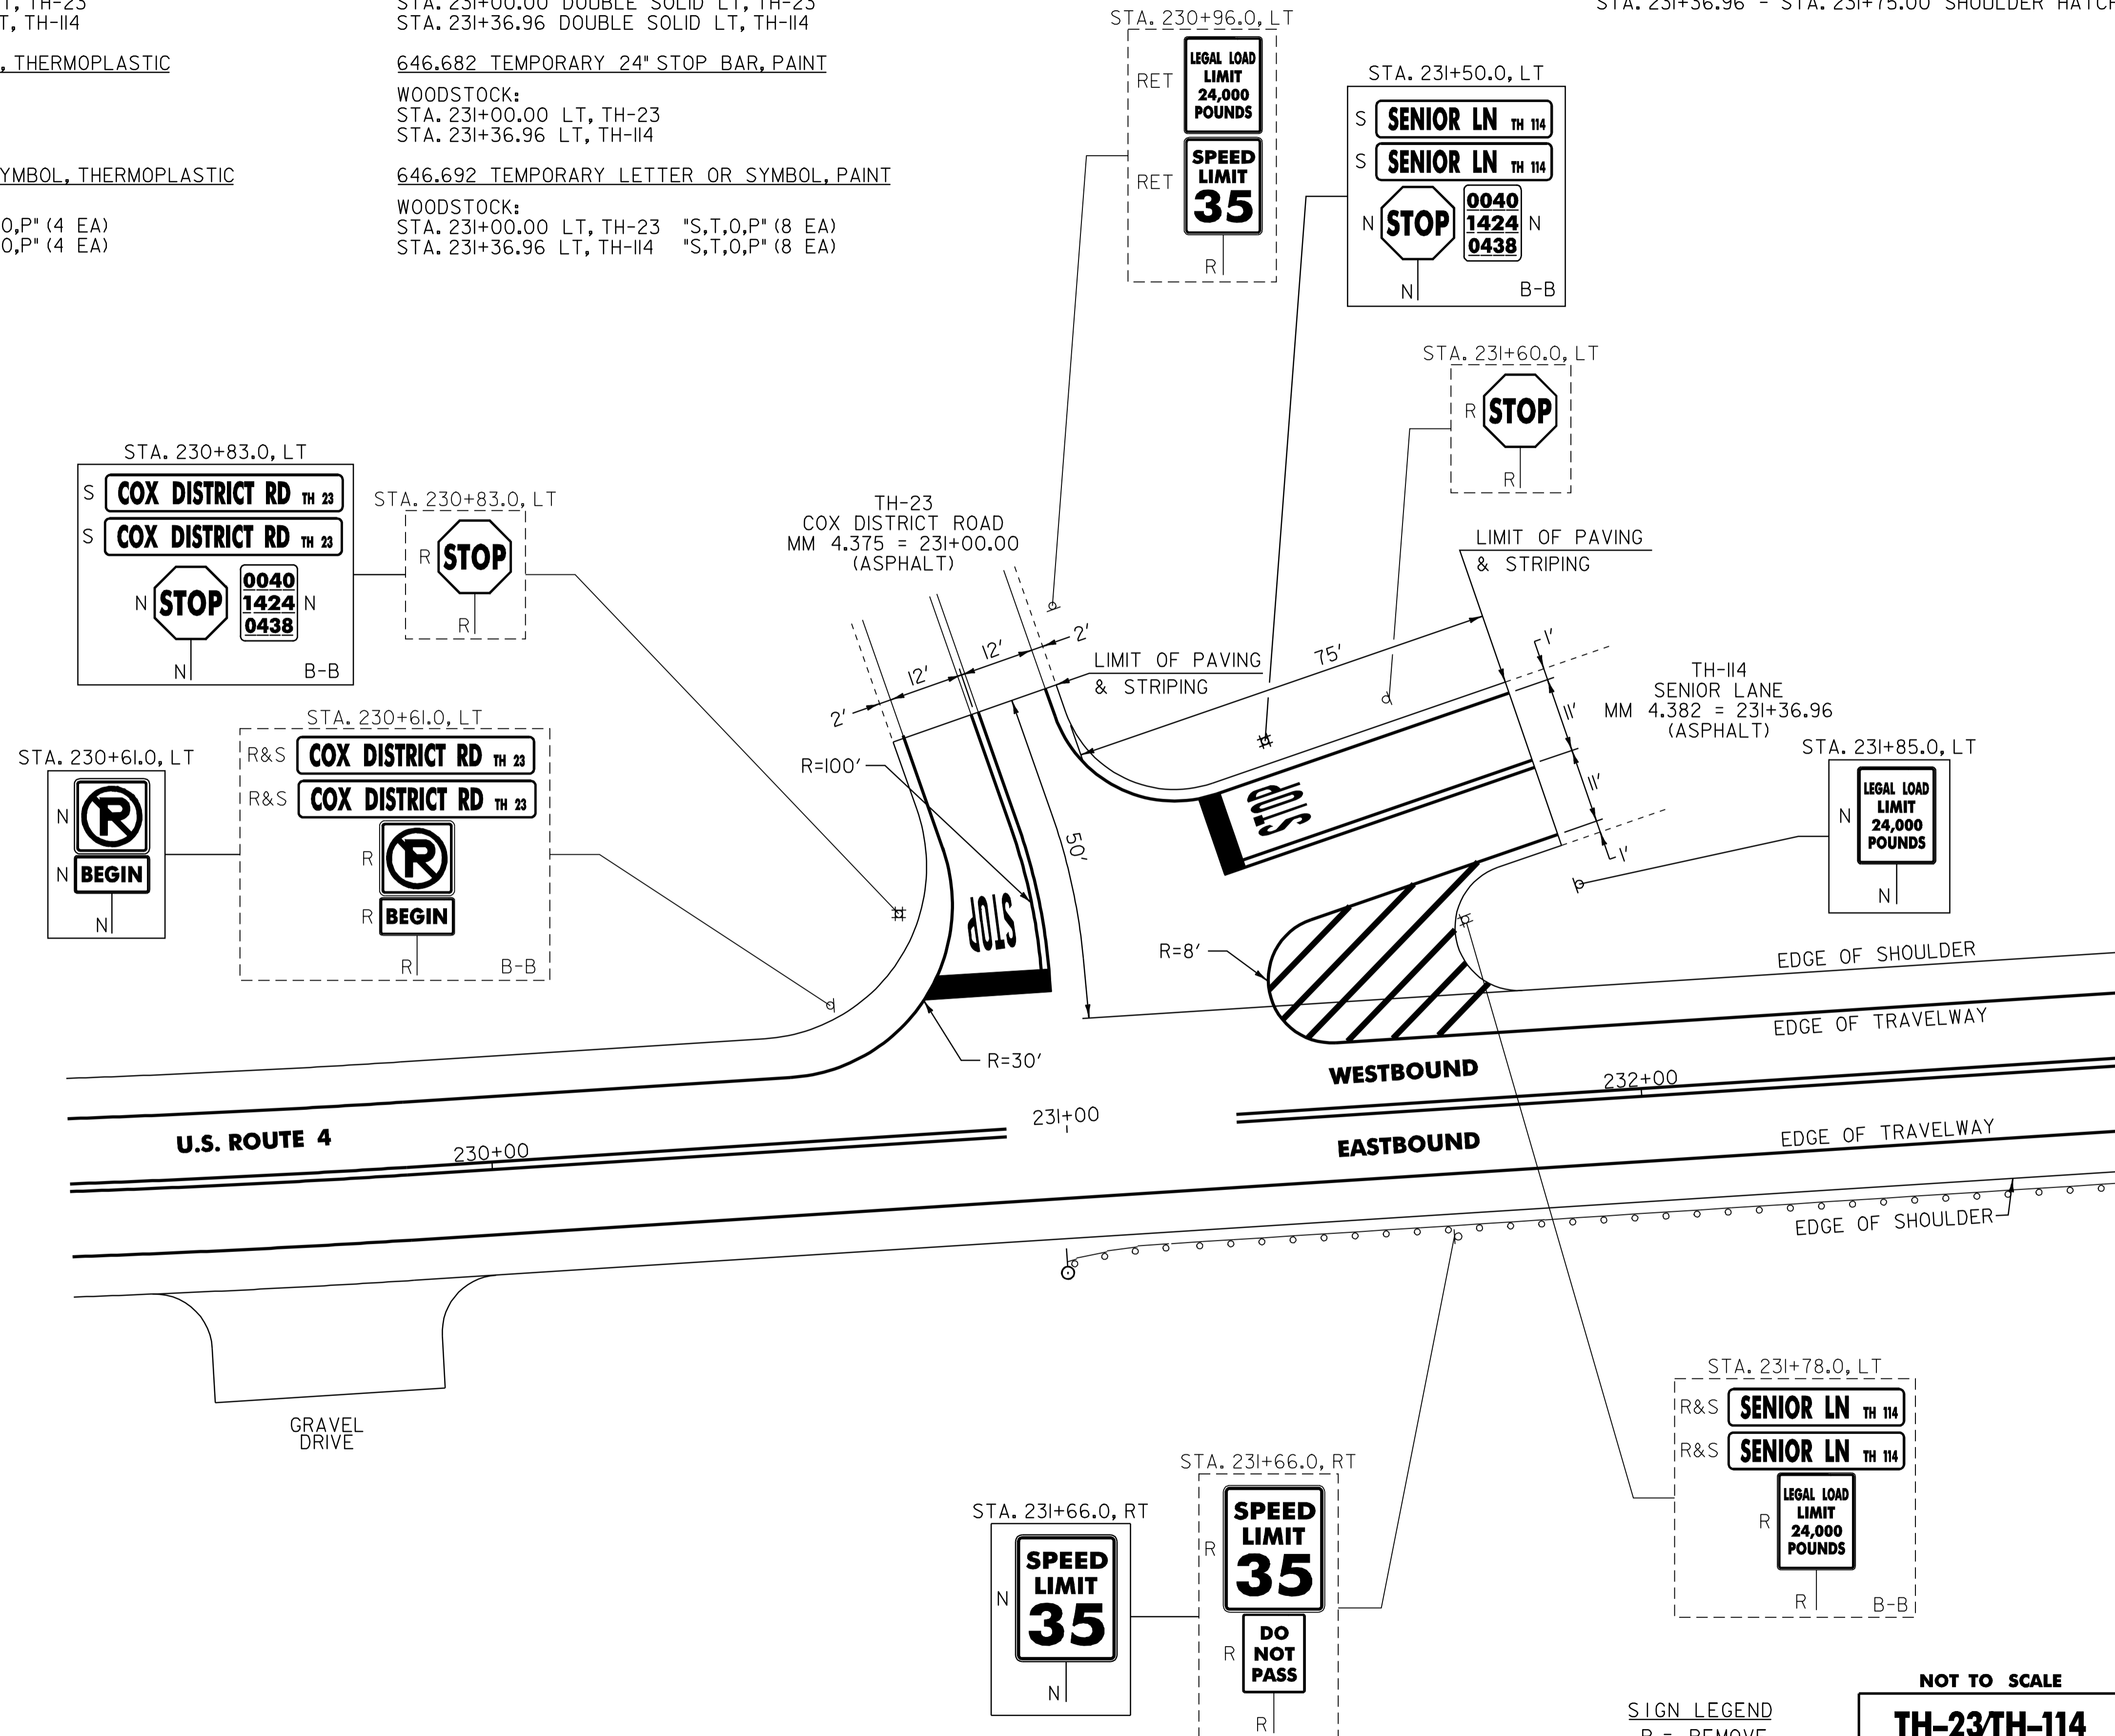

NOTE:
 I. PAVING LIMIT ON ALL TOWN HIGHWAYS SHALL BE MEASURED 25 FT BACK FROM U.S. ROUTE 4 EDGE OF SHOULDER UNLESS DENOTED OTHERWISE ON THE PLANS OR AS DIRECTED BY THE RESIDENT ENGINEER.

SIGN LEGEND
 R = REMOVE
 S = SALVAGE
 N = NEW
 RET = RETAIN
 B-B = BACK TO BACK
 EXISTING = _____
 NEW = _____

TH-23/TH-114 INTERSECTION DETAIL SHEET	NOT TO SCALE	
	PROJECT NAME: BRIDGEWATER - WOODSTOCK PROJECT NUMBER: NH_2611(S)	FILE NAME: p06b160.dgn PROJECT LEADER: D.E.G. DESIGNED BY: D.W.E. IPARM FILE: p05b036int01.i
	PLOT DATE: 28-MAY-2010 DRAWN BY: C.A.K. CHECKED BY: D.E.G. SHEET 37 OF 80	

646.412 DURABLE 4 INCH YELLOW LINE, THERMOPLASTIC
 (ALL LINES WILL INCLUDE C/L BREAKS FOR TOWN HIGHWAYS) S=SOLID, D=DASHED

WOODSTOCK:
 STA. 256+81.92 DOUBLE SOLID LT, TH-3
 STA. 257+45.28 DOUBLE SOLID LT, TH-81

646.442 DURABLE 8 INCH WHITE LINE, THERMOPLASTIC

WOODSTOCK:
 STA. 257+10.00 - STA. 257+45.28 SHOULDER HATCHING LT, TH-81

646.482 DURABLE 24 INCH STOP BAR, THERMOPLASTIC

WOODSTOCK:
 STA. 256+81.92 LT, TH-3
 STA. 257+45.28 LT, TH-81

646.492 DURABLE LETTER OR SYMBOL, THERMOPLASTIC

WOODSTOCK:
 STA. 256+81.92 LT, TH-3 "S,T,O,P" (4 EA)
 STA. 257+45.28 LT, TH-81 "S,T,O,P" (4 EA)

646.612 TEMPORARY 4 INCH YELLOW LINE, PAINT
 (ALL LINES WILL INCLUDE C/L BREAKS FOR TOWN HIGHWAYS) S=SOLID, D=DASHED

WOODSTOCK:
 STA. 256+81.92 DOUBLE SOLID LT, TH-3
 STA. 257+45.28 DOUBLE SOLID LT, TH-81

646.682 TEMPORARY 24 INCH STOP BAR, PAINT

WOODSTOCK:
 STA. 256+81.92 LT, TH-3
 STA. 257+45.28 LT, TH-81

646.692 TEMPORARY LETTER OR SYMBOL, PAINT


WOODSTOCK:
 STA. 256+81.92 LT, TH-3 "S,T,O,P" (8 EA)
 STA. 257+45.28 LT, TH-81 "S,T,O,P" (8 EA)

675.50 REMOVING SIGNS

AS SHOWN - 9

675.60 ERECTING SALVAGED SIGNS

AS SHOWN - 4

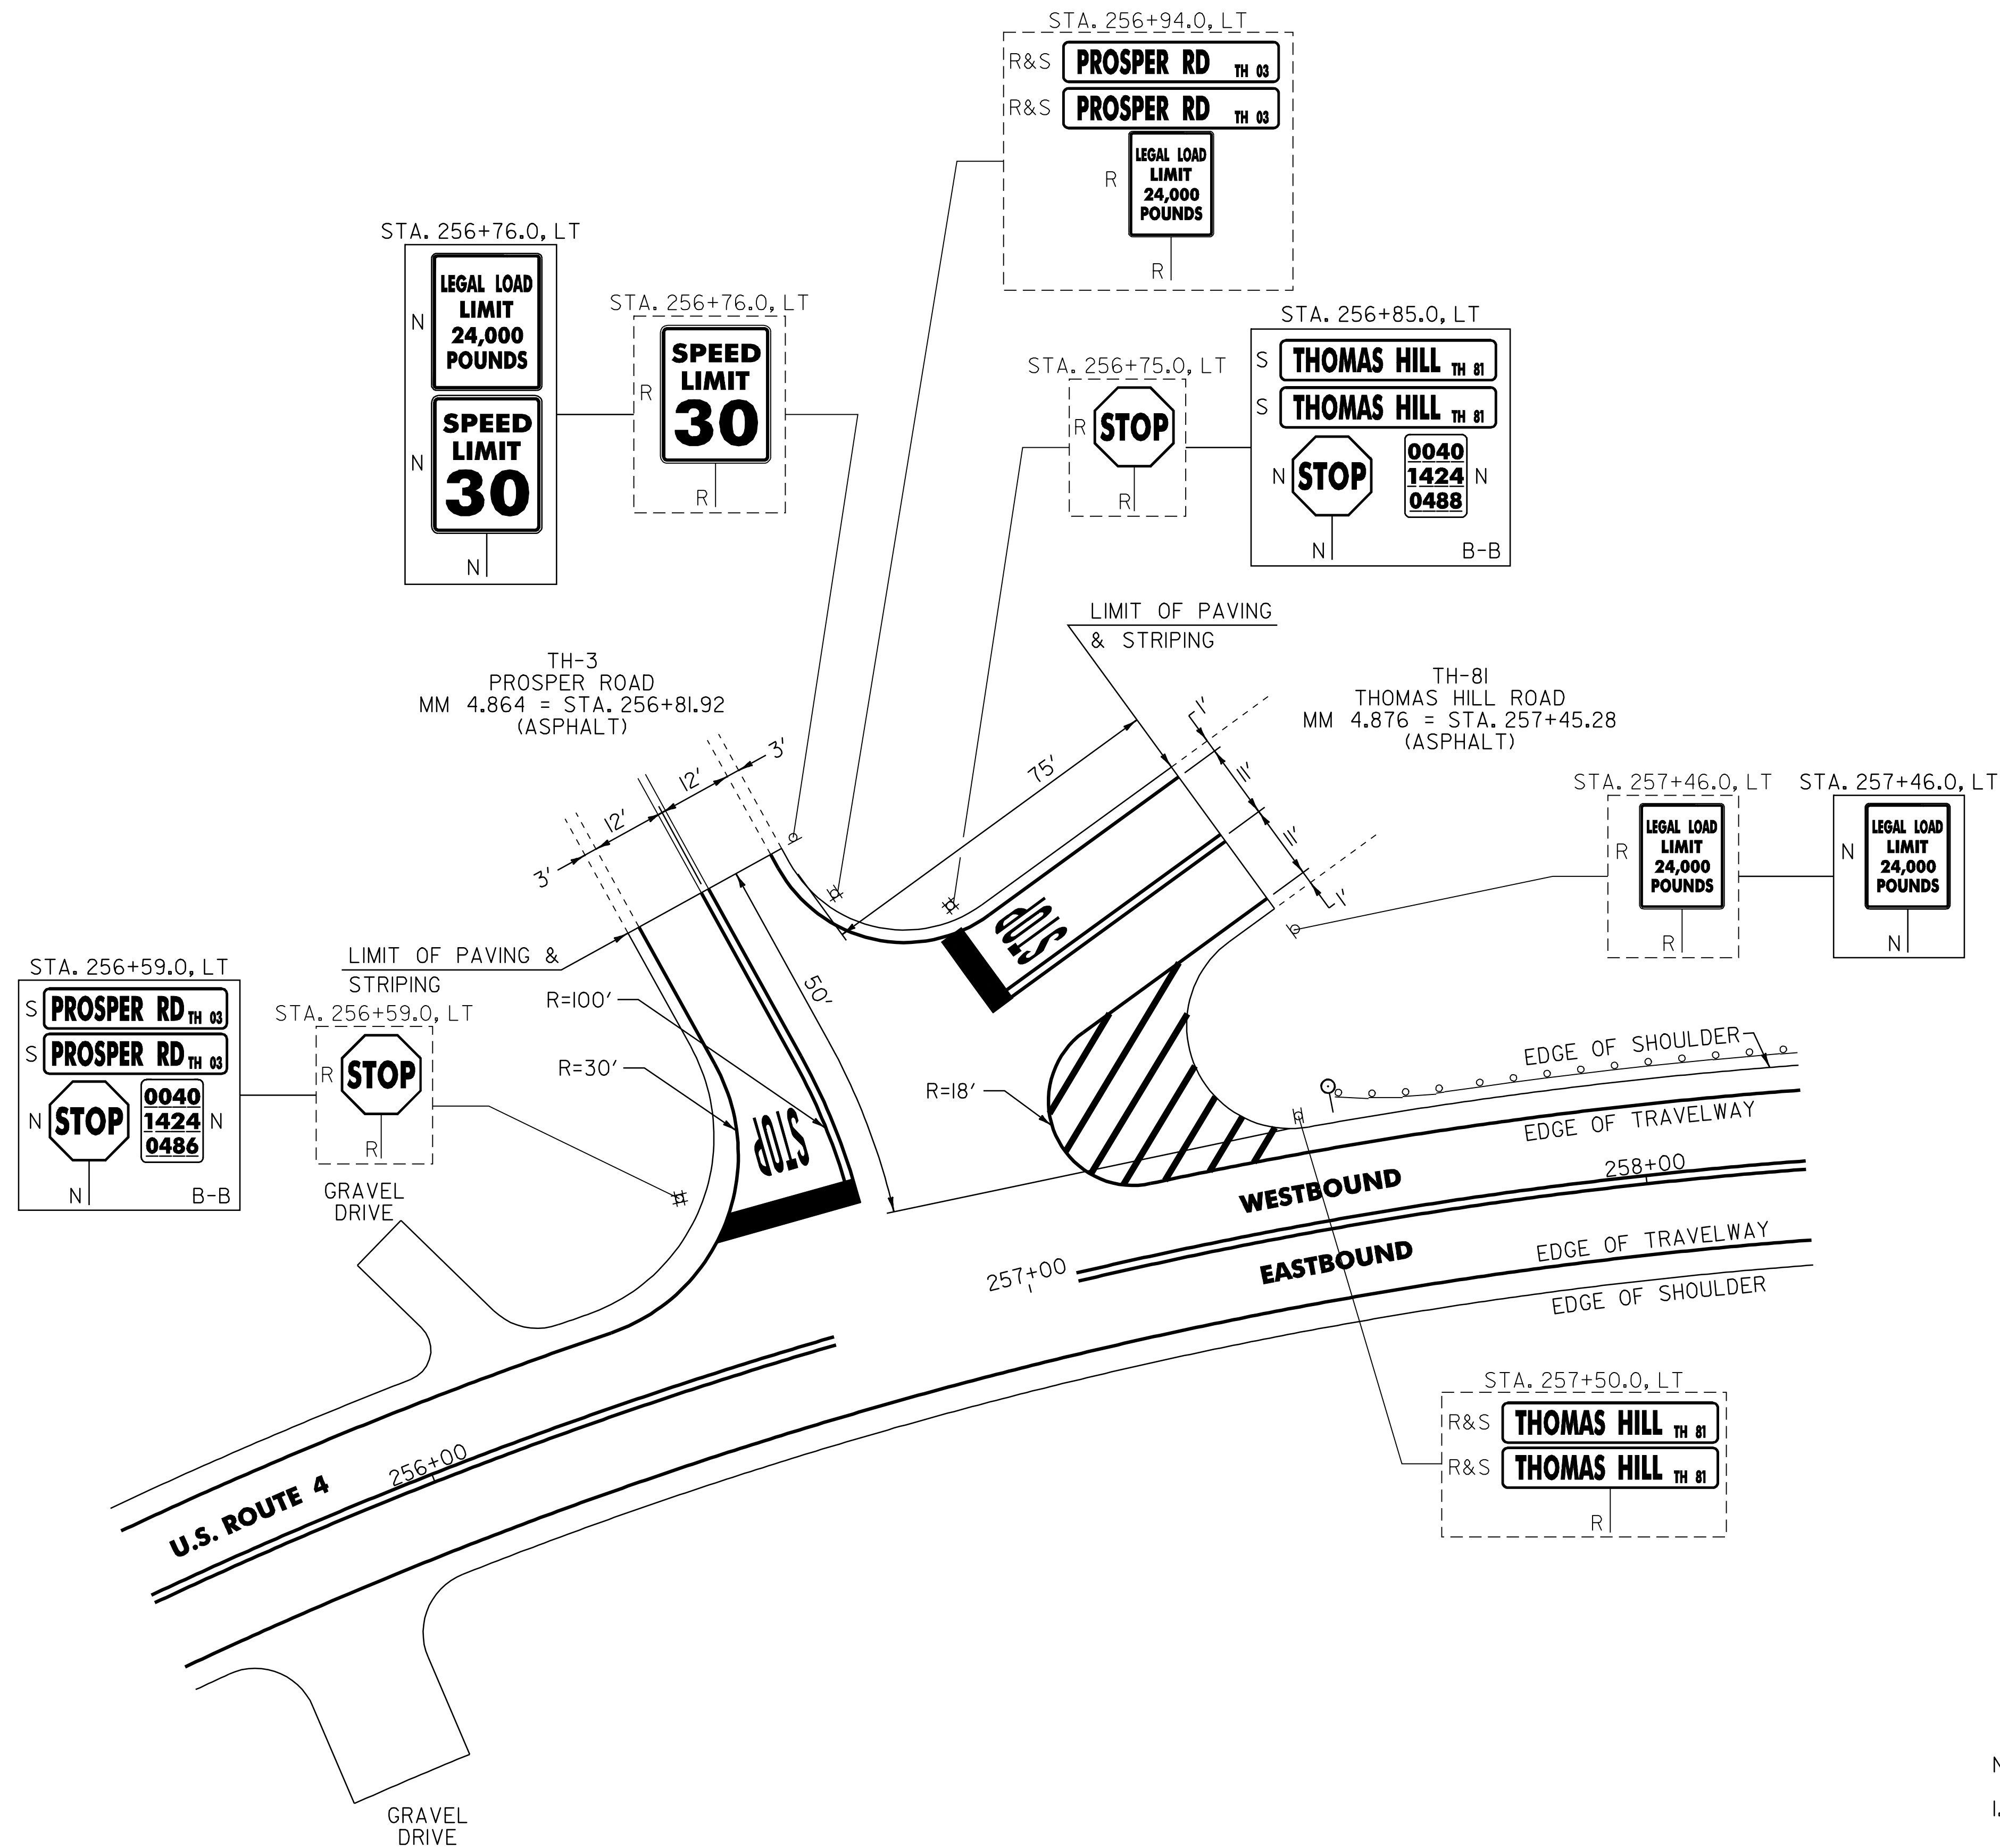


NOTE:
 1. PAVING LIMIT ON ALL TOWN HIGHWAYS SHALL BE MEASURED 25 FT BACK FROM U.S. ROUTE 4 EDGE OF SHOULDER UNLESS DENOTED OTHERWISE ON THE PLANS OR AS DIRECTED BY THE RESIDENT ENGINEER.

SIGN LEGEND
 R = REMOVE
 S = SALVAGE
 N = NEW
 RET = RETAIN
 B-B = BACK TO BACK
 EXISTING = - - - - -
 NEW = _____


NOT TO SCALE
TH-3/TH-81 INTERSECTION DETAIL SHEET

PROJECT NAME: BRIDGEWATER - WOODSTOCK
 PROJECT NUMBER: NH_2611(S)
 FILE NAME: p06b160.dgn
 PROJECT LEADER: D.E.G.
 DESIGNED BY: D.W.E.
 IPARM FILE: p06b160n102.i...
 PLOT DATE: 28-MAY-2010
 DRAWN BY: C.A.K.
 CHECKED BY: D.E.G.
 SHEET 38 OF 80

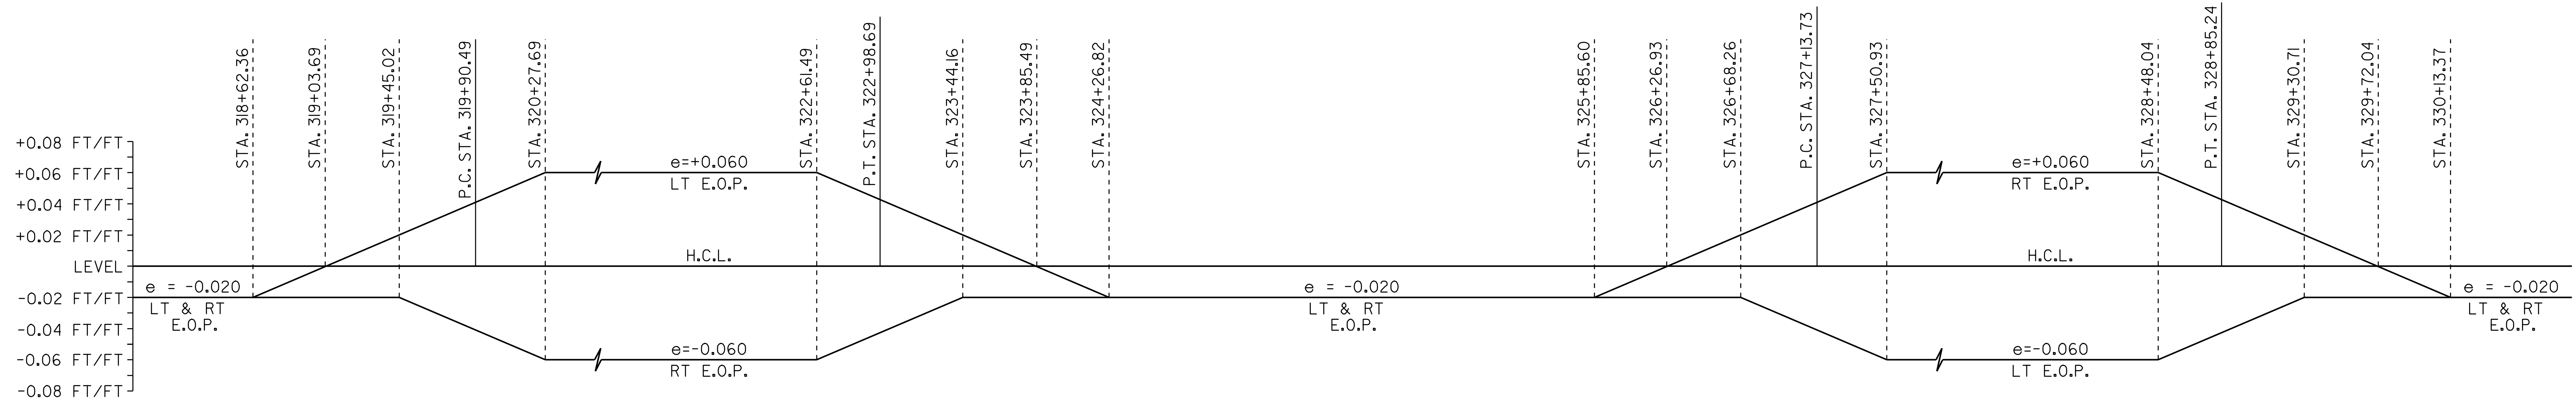

CURVE 1 & CURVE 2 BANKING DIAGRAMS

CURVE 1 RADIUS = 1000'
 CURVE 2 RADIUS = 1000'

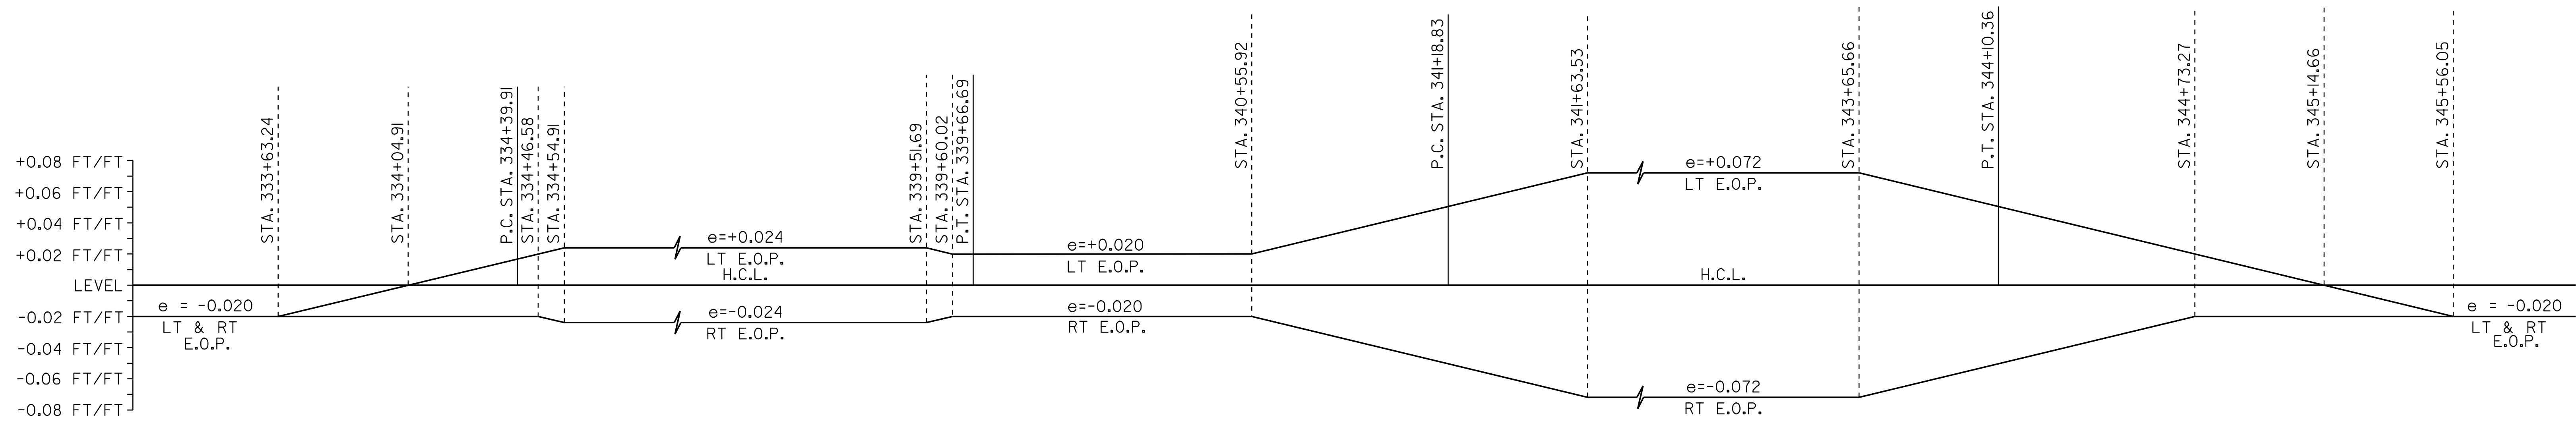

CURVE 3 & CURVE 4 BANKING DIAGRAMS


CURVE 3 RADIUS = 3500'
 CURVE 4 RADIUS = 700'

SUPERELEVATION BANKING NOTES:

1. THE CONTRACTOR IS RESPONSIBLE FOR ESTABLISHING AND MAINTAINING THE HORIZONTAL AND VERTICAL GEOMETRY OF THE EXISTING ROADWAY.
2. THE MAXIMUM ROLL-OVER BETWEEN LANE AND SHOULDER CROSS SLOPES ON THE OUTSIDE (HIGH SIDE) OF A SUPERELEVATED CURVE SHALL BE SEVEN PERCENT. SHOULDER CROSS SLOPE ON THE INSIDE (LOW SIDE) OF A SUPERELEVATED CURVE SHALL BE A MINIMUM OF SIX PERCENT AND MATCH THE ADJACENT LANE CROSS SLOPE WHEN THE LANE CROSS SLOPE EXCEEDS SIX PERCENT.
3. SUPERELEVATION RATES AND RUNOFF LENGTHS WERE DETERMINED USING A DESIGN SPEED EQUAL TO THE POSTED SPEED AND A MAXIMUM SUPERELEVATION RATE OF 0.08.


NOT TO SCALE
SUPERELEVATION BANKING DIAGRAMS SHEET #1

PROJECT NAME: BRIDGEWATER_-_WOODSTOCK	PLOT DATE: 28-MAY-2010
PROJECT NUMBER: NH_2611(1)S	DRAWN BY: C.A.K.
FILE NAME: p06b160.dgn	CHECKED BY: D.E.G.
DESIGNED BY: D.W.E.	SHEET 39 OF 80
IPARM FILE: p06b160sbd1.i	

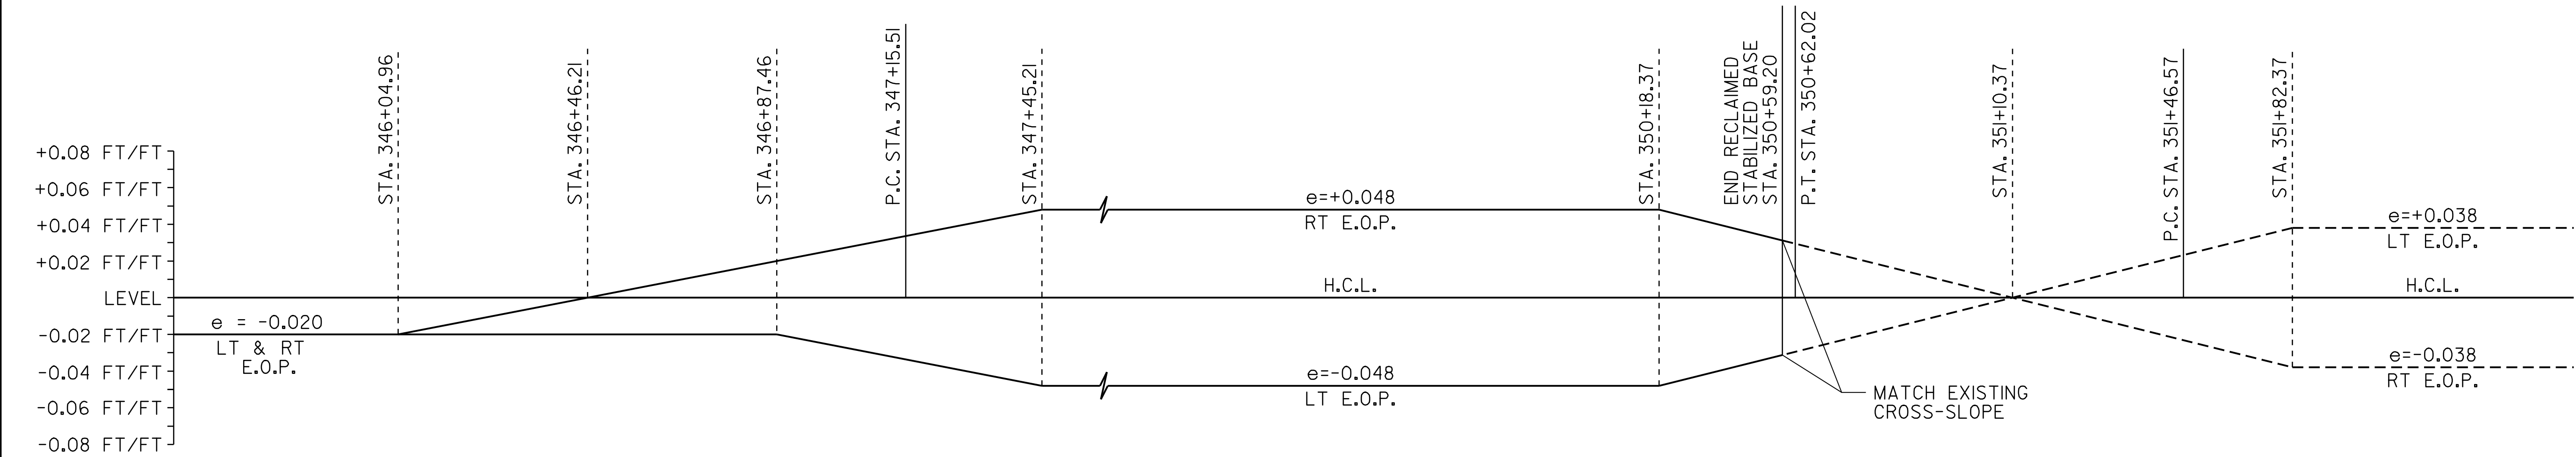


CURVE 5 & CURVE 6 BANKING DIAGRAMS

CURVE 5 RADIUS = 1400'
 CURVE 6 RADIUS = 2000'

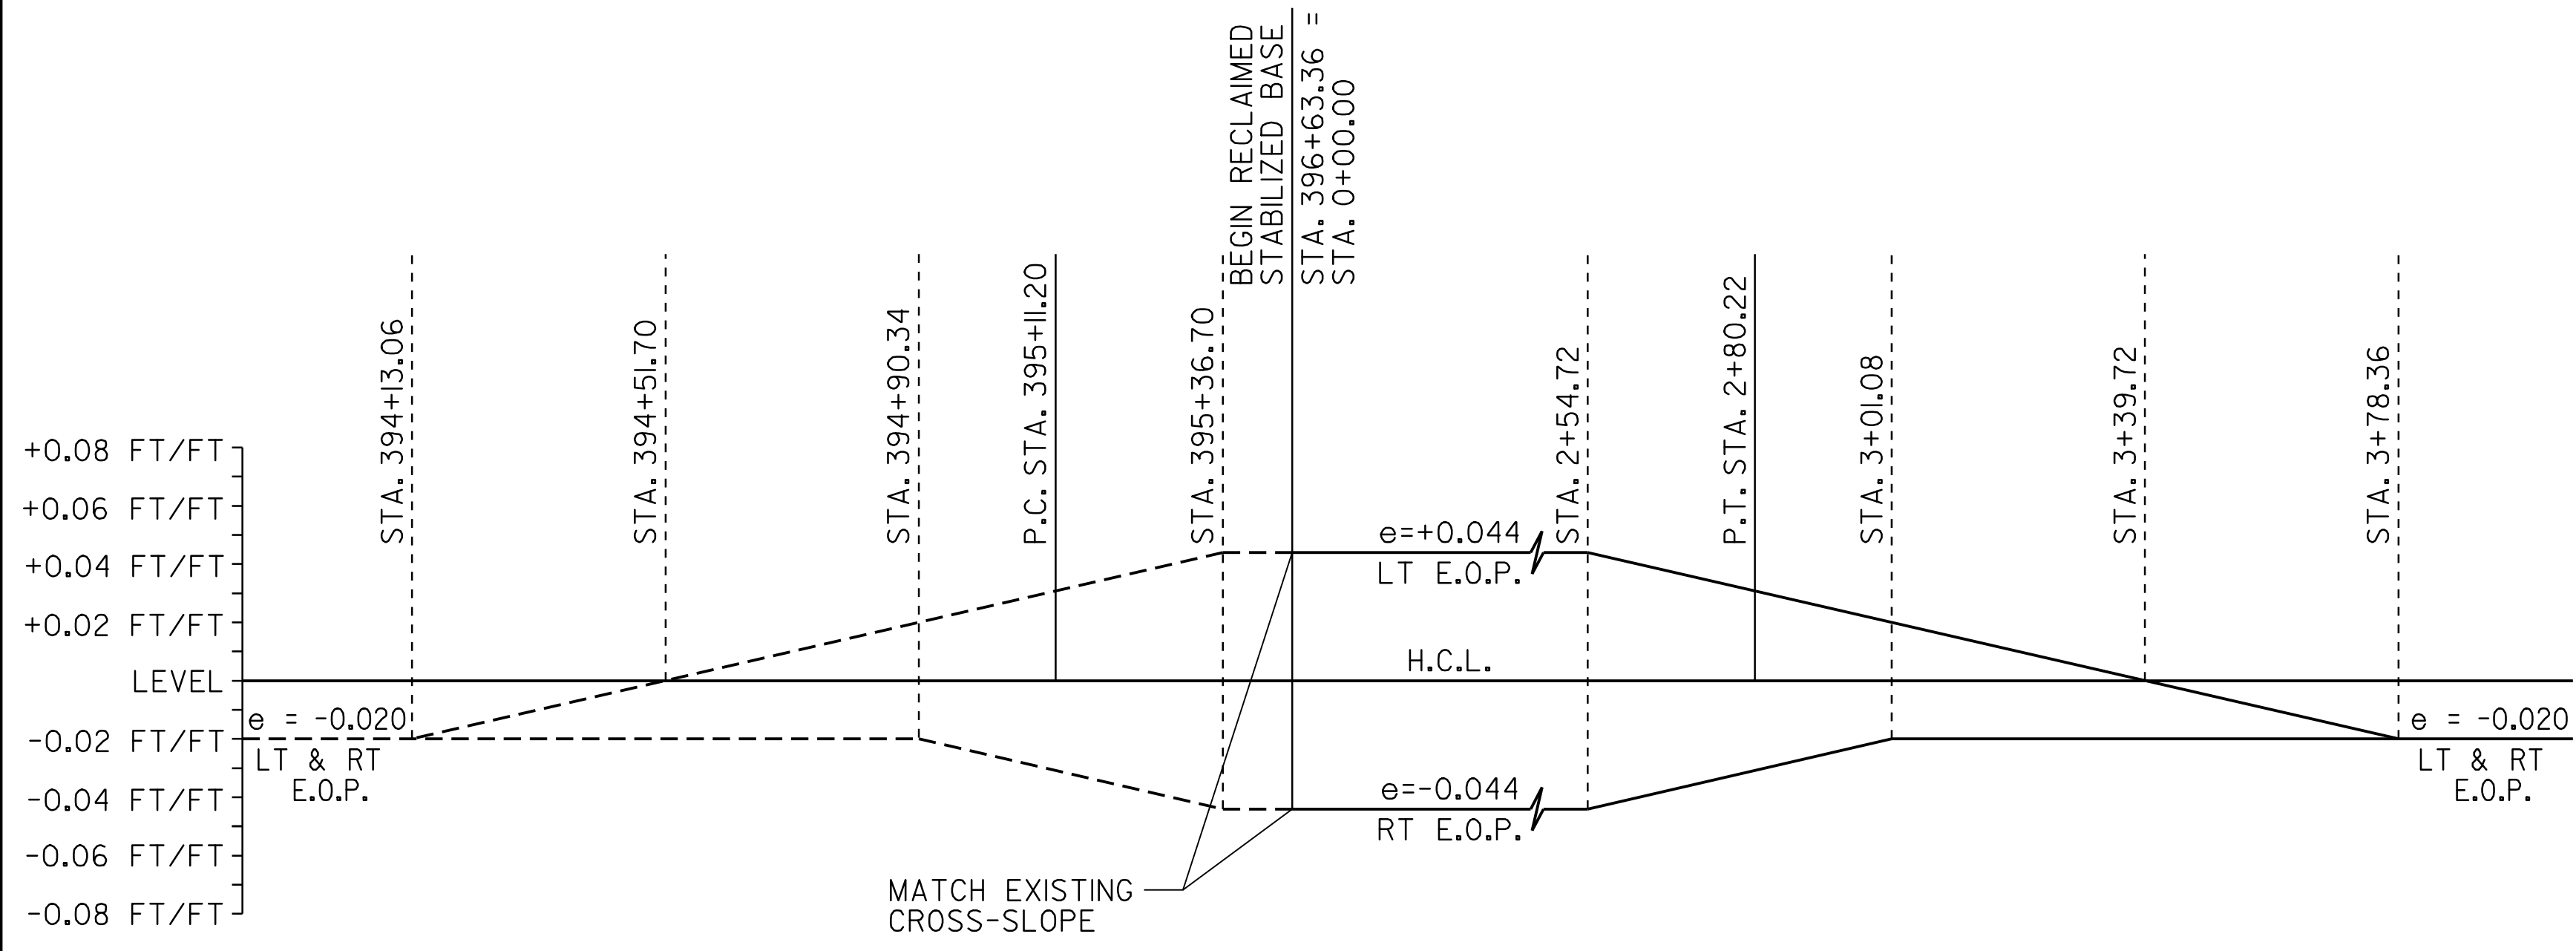

CURVE 7 BANKING DIAGRAM

CURVE 7 RADIUS = 1200'

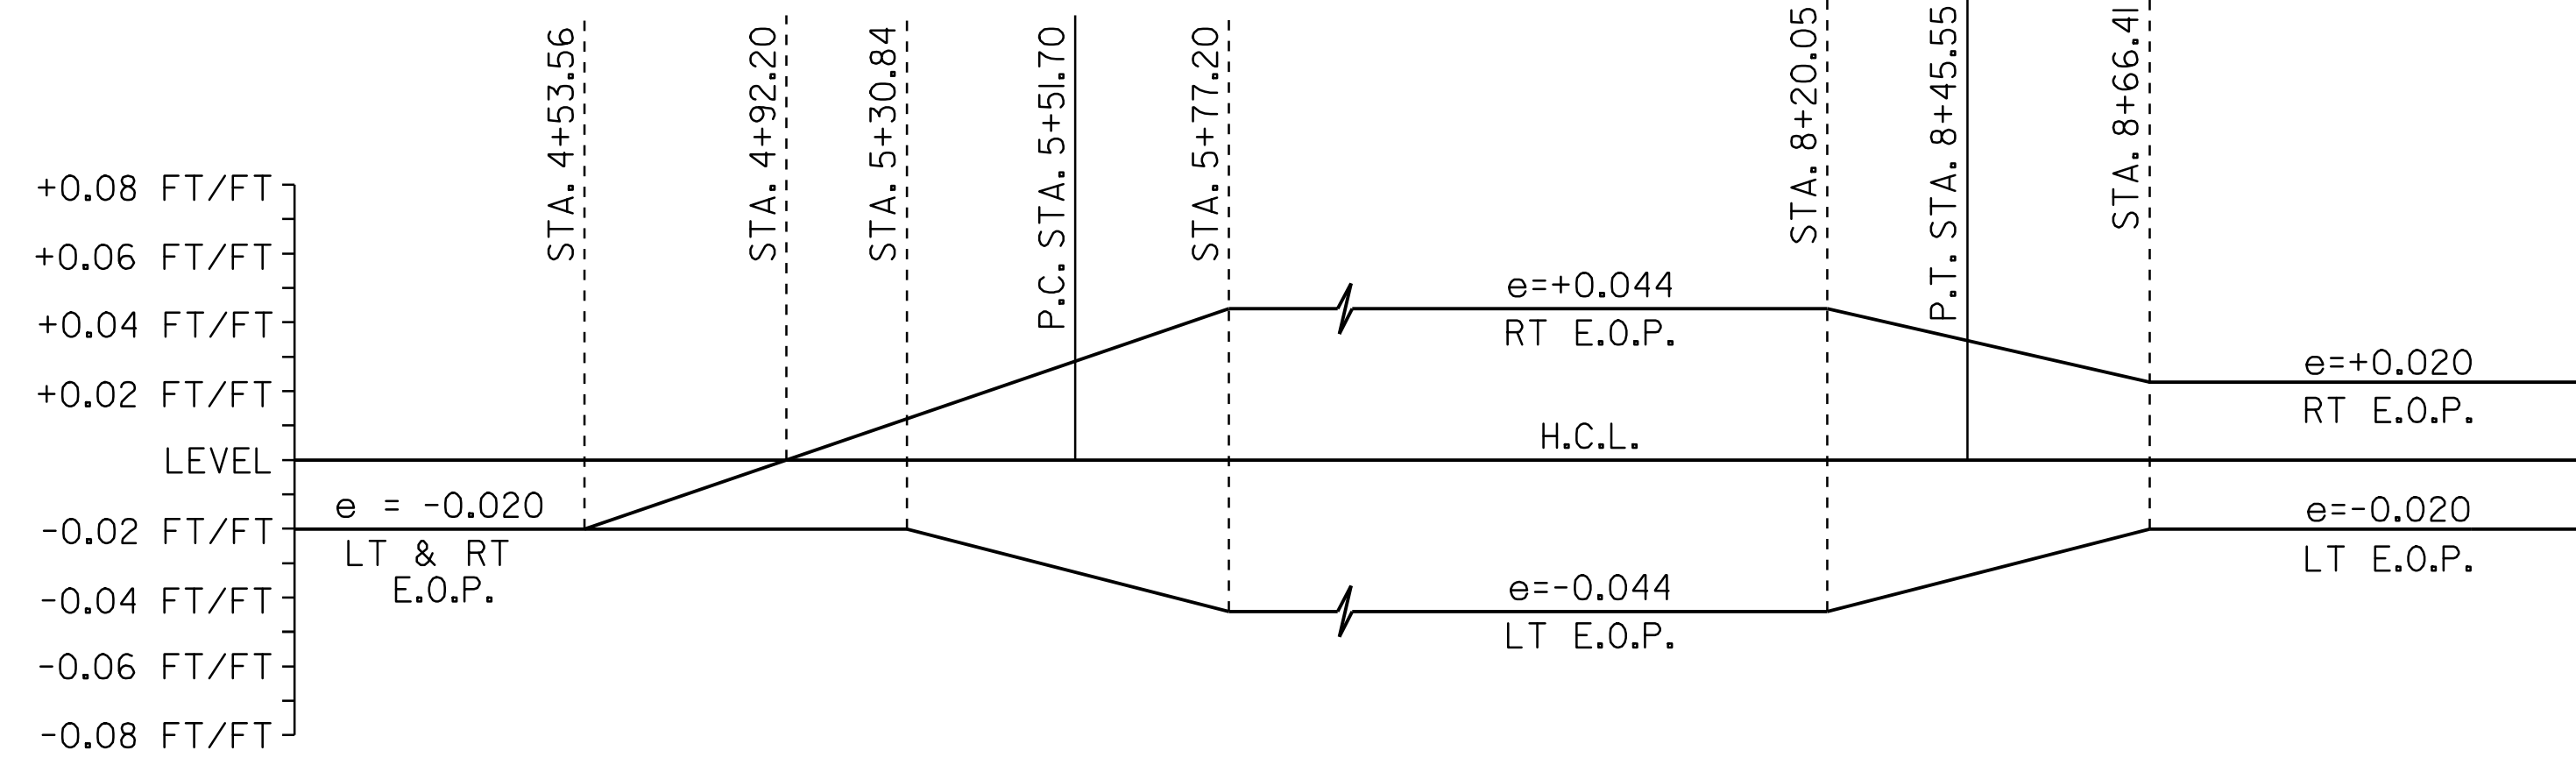

CURVE 8 BANKING DIAGRAM

CURVE 8 RADIUS = 1200'

SUPERELEVATION BANKING NOTES:


1. THE CONTRACTOR IS RESPONSIBLE FOR ESTABLISHING AND MAINTAINING THE HORIZONTAL AND VERTICAL GEOMETRY OF THE EXISTING ROADWAY.
2. THE MAXIMUM ROLL-OVER BETWEEN LANE AND SHOULDER CROSS SLOPES ON THE OUTSIDE (HIGH SIDE) OF A SUPERELEVATED CURVE SHALL BE SEVEN PERCENT. SHOULDER CROSS SLOPE ON THE INSIDE (LOW SIDE) OF A SUPERELEVATED CURVE SHALL BE A MINIMUM OF SIX PERCENT AND MATCH THE ADJACENT LANE CROSS SLOPE WHEN THE LANE CROSS SLOPE EXCEEDS SIX PERCENT.
3. SUPERELEVATION RATES AND RUNOFF LENGTHS WERE DETERMINED USING A DESIGN SPEED EQUAL TO THE POSTED SPEED AND A MAXIMUM SUPERELEVATION RATE OF 0.08.

NOT TO SCALE
SUPERELEVATION BANKING DIAGRAMS SHEET #2


PROJECT NAME: BRIDGEWATER_-_WOODSTOCK
 PROJECT NUMBER: NH_2611(1)S

FILE NAME: p06b160.dgn -- PLOT DATE: 28-MAY-2010
 PROJECT LEADER: D.E.G. DRAWN BY: C.A.K.
 DESIGNED BY: D.W.E. CHECKED BY: D.E.G.
 IPARM FILE: p06b160sbd2.i SHEET 40 OF 80


MATCH LINE STA. 9+20.00
 (SEE CURVE 9 BANKING DIAGRAM)

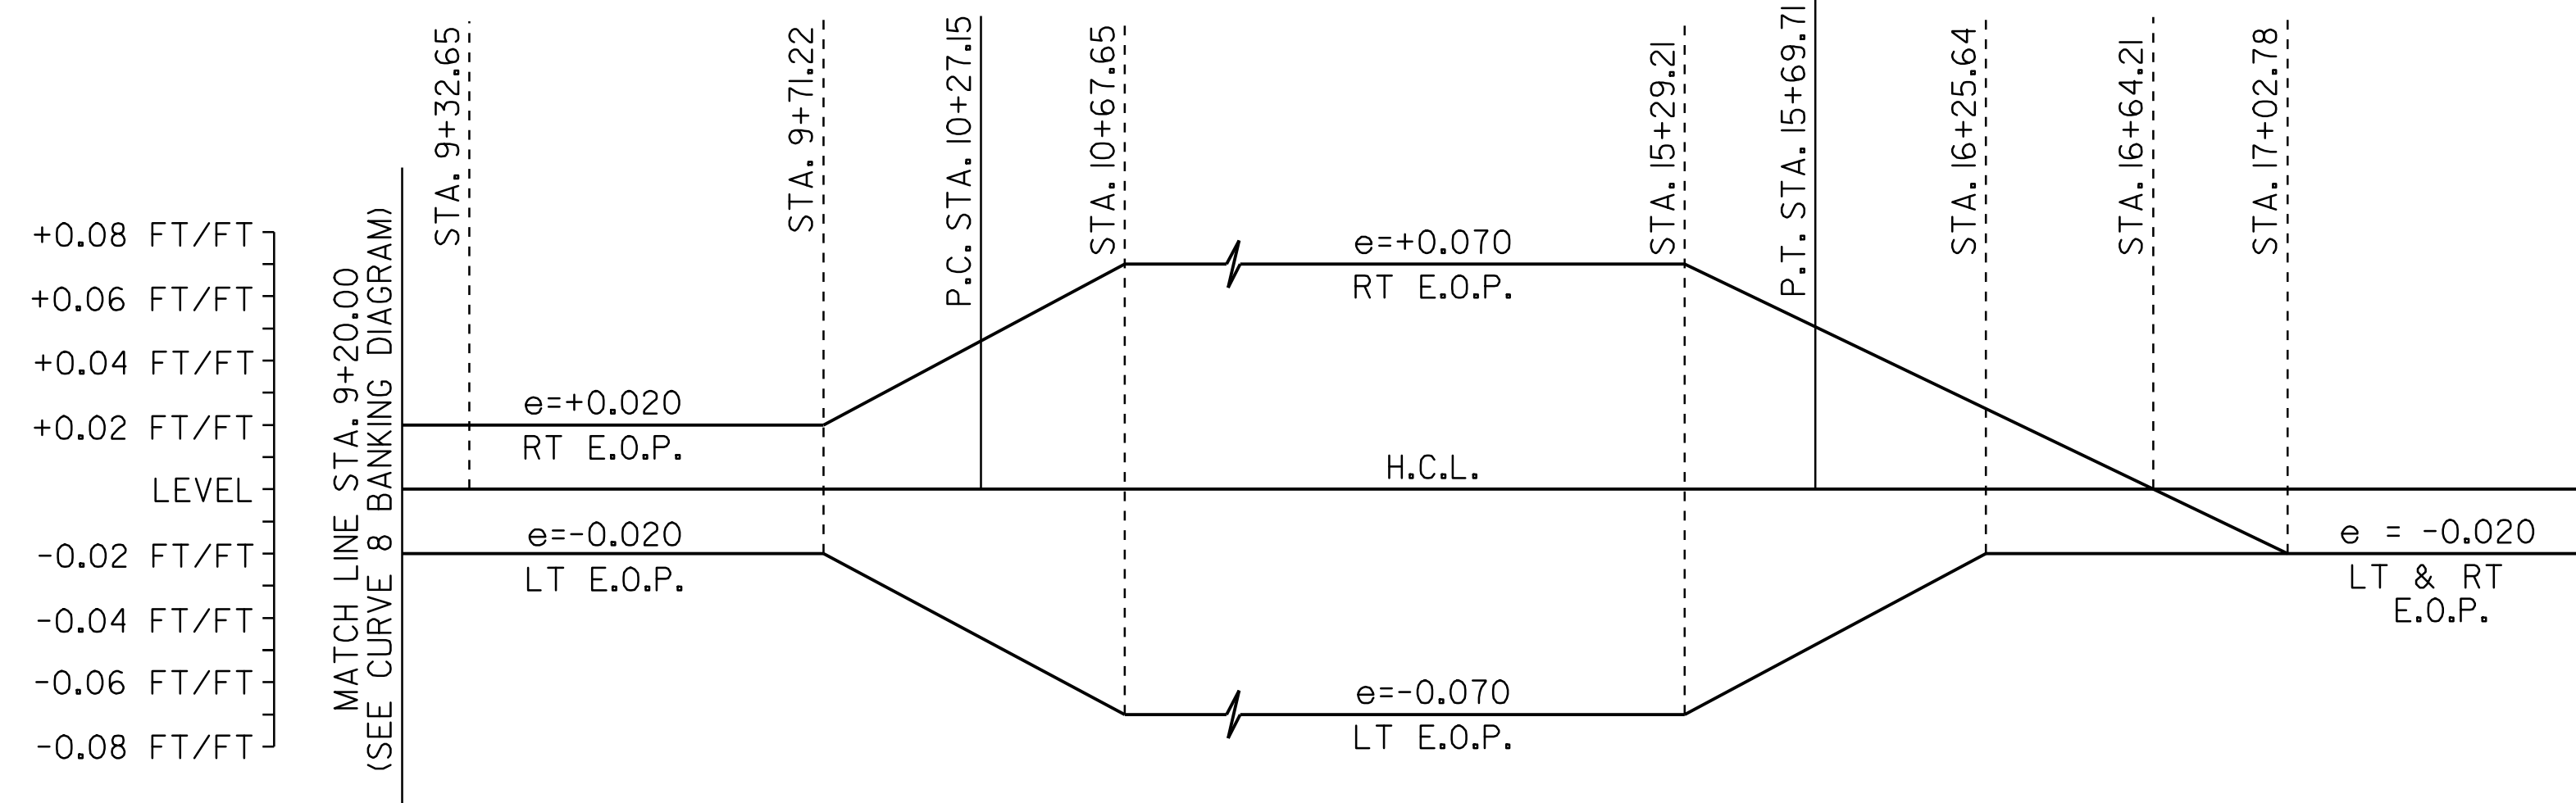


CURVE 9 BANKING DIAGRAM
CURVE 9 RADIUS = 525'

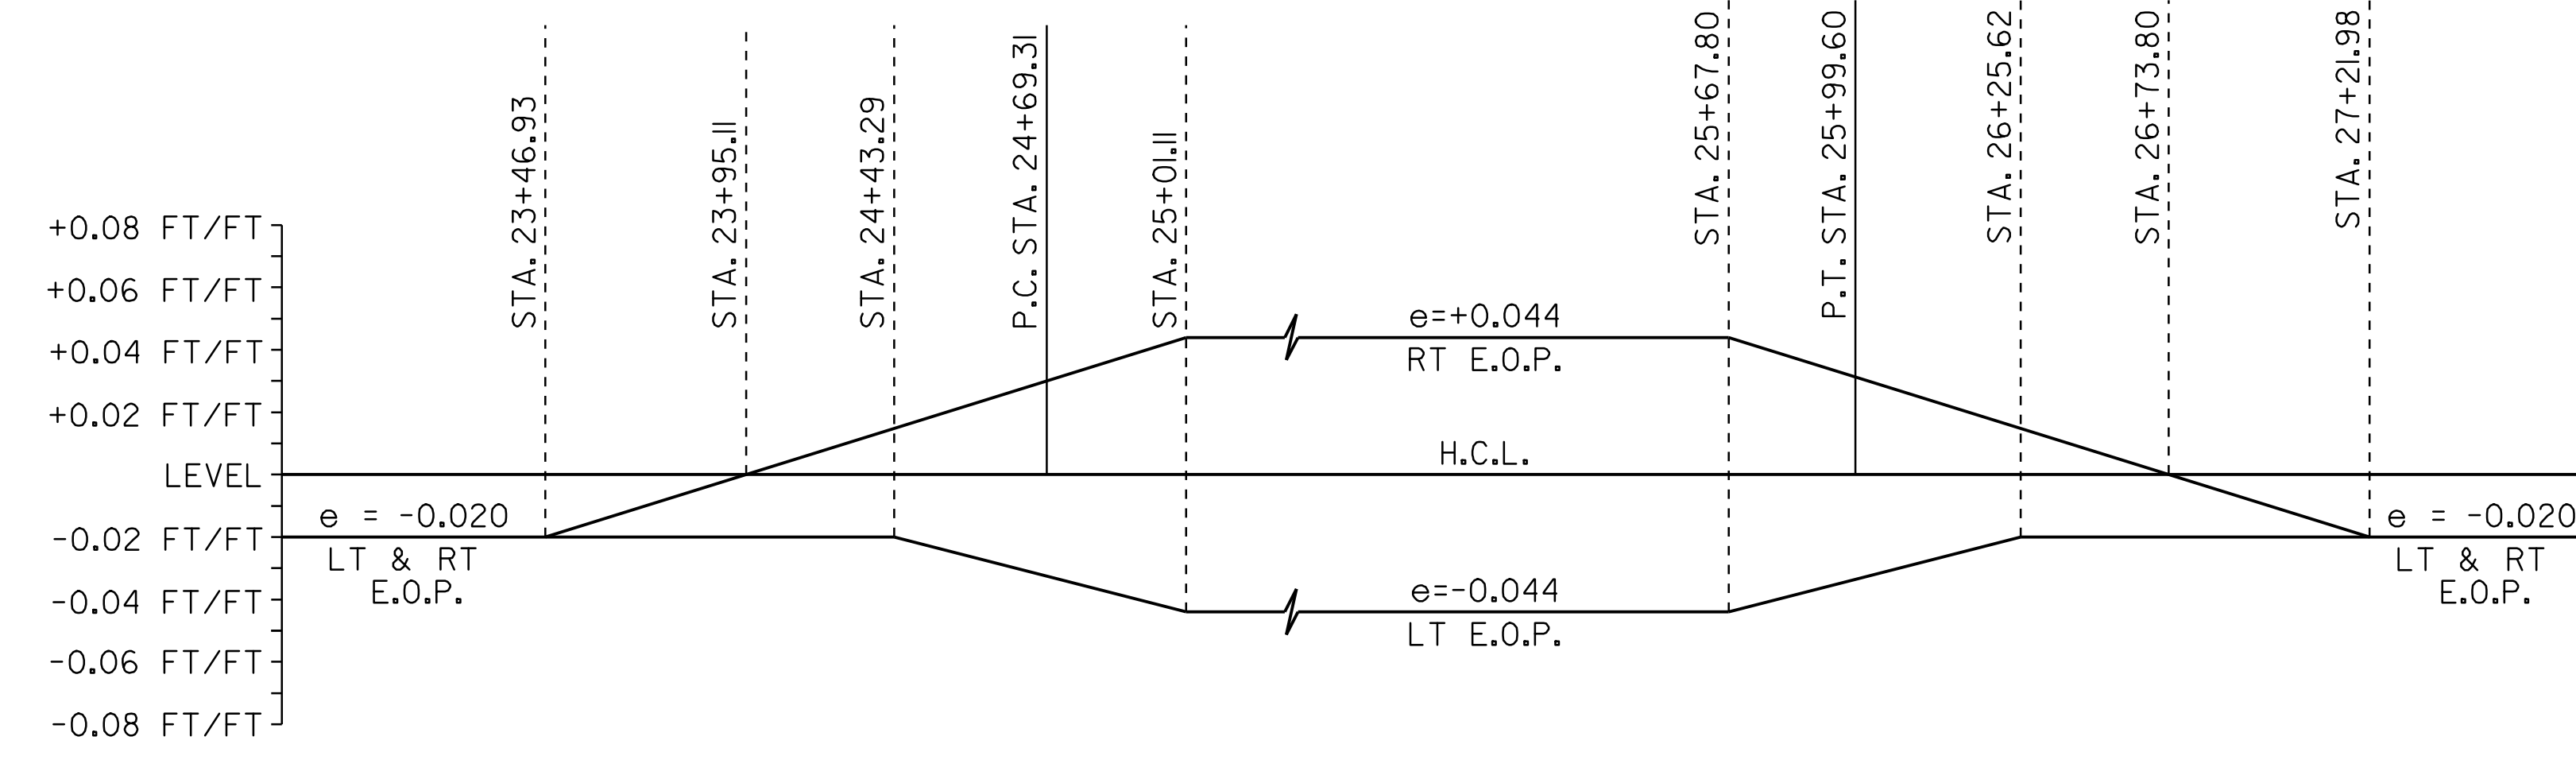

CURVE 10 BANKING DIAGRAM
CURVE 10 RADIUS = 2500'

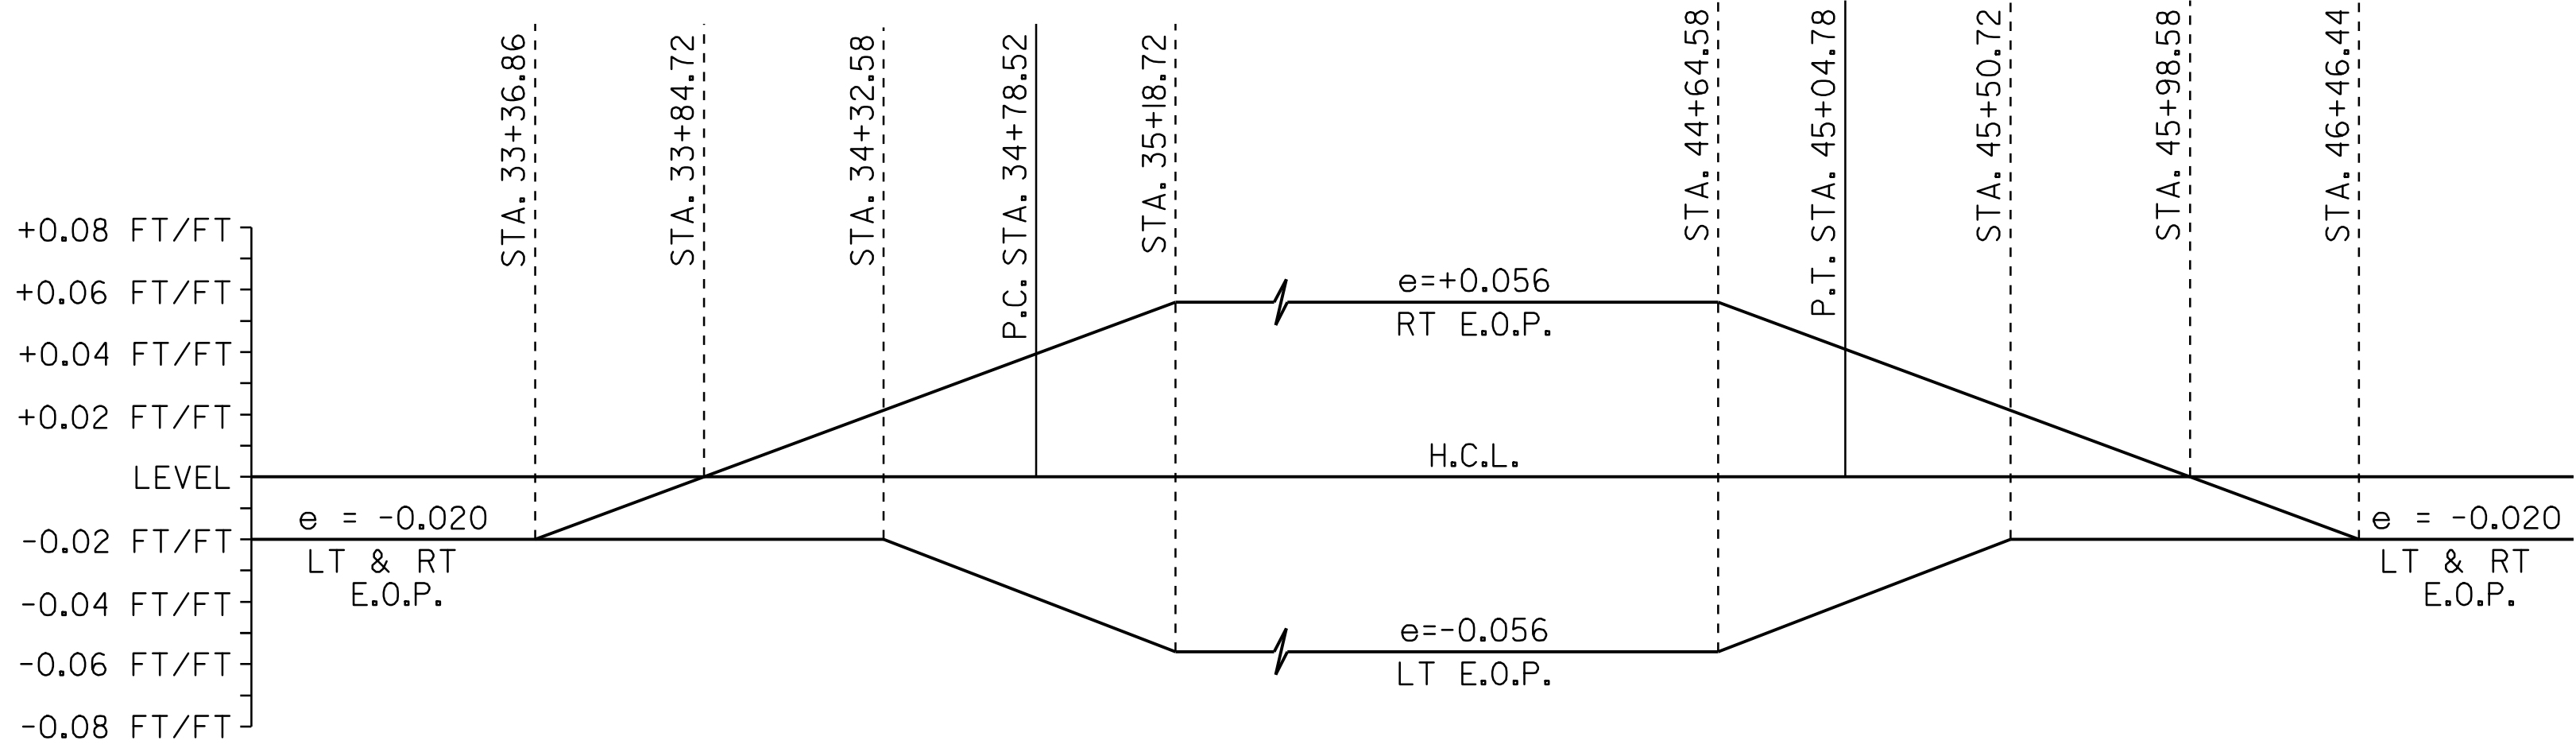

CURVE 11 BANKING DIAGRAM
CURVE 11 RADIUS = 1750'

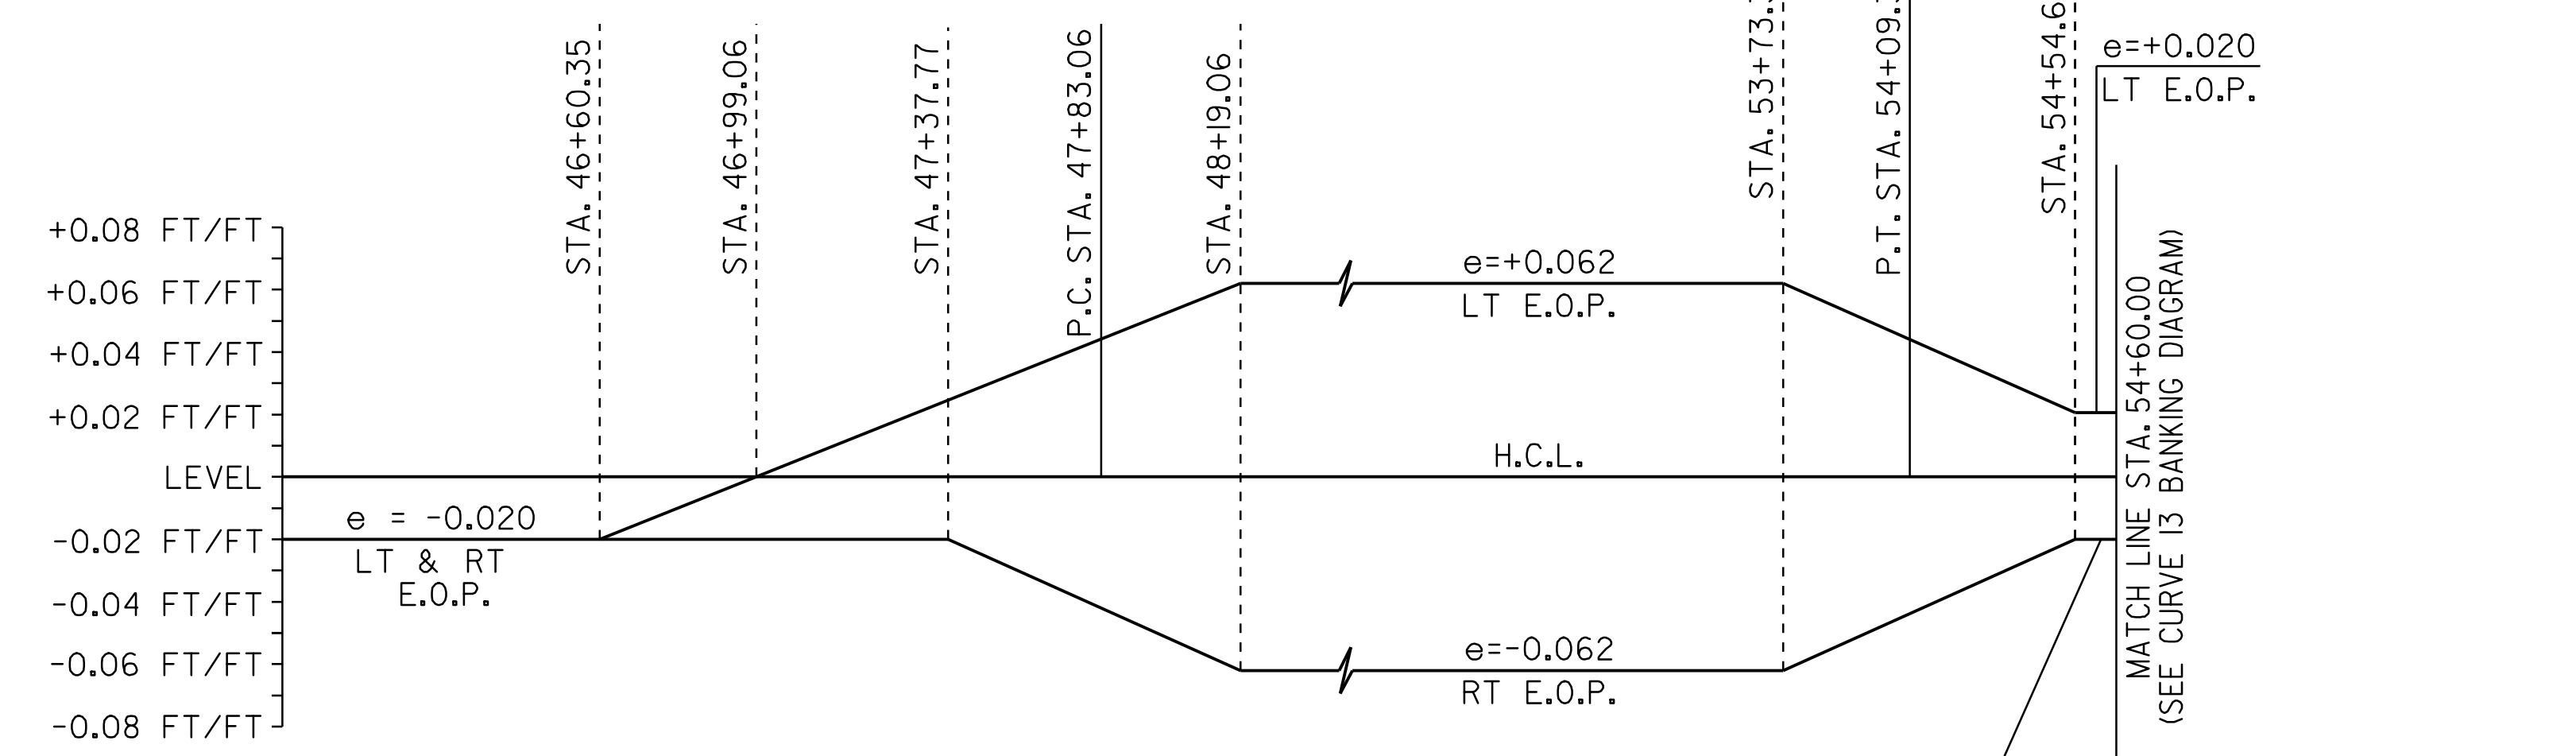


CURVE 12 BANKING DIAGRAM
CURVE 12 RADIUS = 700'

SUPERELEVATION BANKING NOTES:

1. THE CONTRACTOR IS RESPONSIBLE FOR ESTABLISHING AND MAINTAINING THE HORIZONTAL AND VERTICAL GEOMETRY OF THE EXISTING ROADWAY.
2. THE MAXIMUM ROLL-OVER BETWEEN LANE AND SHOULDER CROSS SLOPES ON THE OUTSIDE (HIGH SIDE) OF A SUPERELEVATED CURVE SHALL BE SEVEN PERCENT. SHOULDER CROSS SLOPE ON THE INSIDE (LOW SIDE) OF A SUPERELEVATED CURVE SHALL BE A MINIMUM OF SIX PERCENT AND MATCH THE ADJACENT LANE CROSS SLOPE WHEN THE LANE CROSS SLOPE EXCEEDS SIX PERCENT.
3. SUPERELEVATION RATES AND RUNOFF LENGTHS WERE DETERMINED USING A DESIGN SPEED EQUAL TO THE POSTED SPEED AND A MAXIMUM SUPERELEVATION RATE OF 0.08.


NOT TO SCALE
SUPERELEVATION BANKING DIAGRAMS SHEET #3

PROJECT NAME: BRIDGEWATER - WOODSTOCK	PLOT DATE: 28-MAY-2010
PROJECT NUMBER: NH_2611(S)	DRAWN BY: C.A.K.
FILE NAME: p06b160.dgn	CHECKED BY: D.E.G.
DESIGNED BY: D.W.E.	SHEET 41 OF 80
IPARM FILE: p06b160sbd3.i	

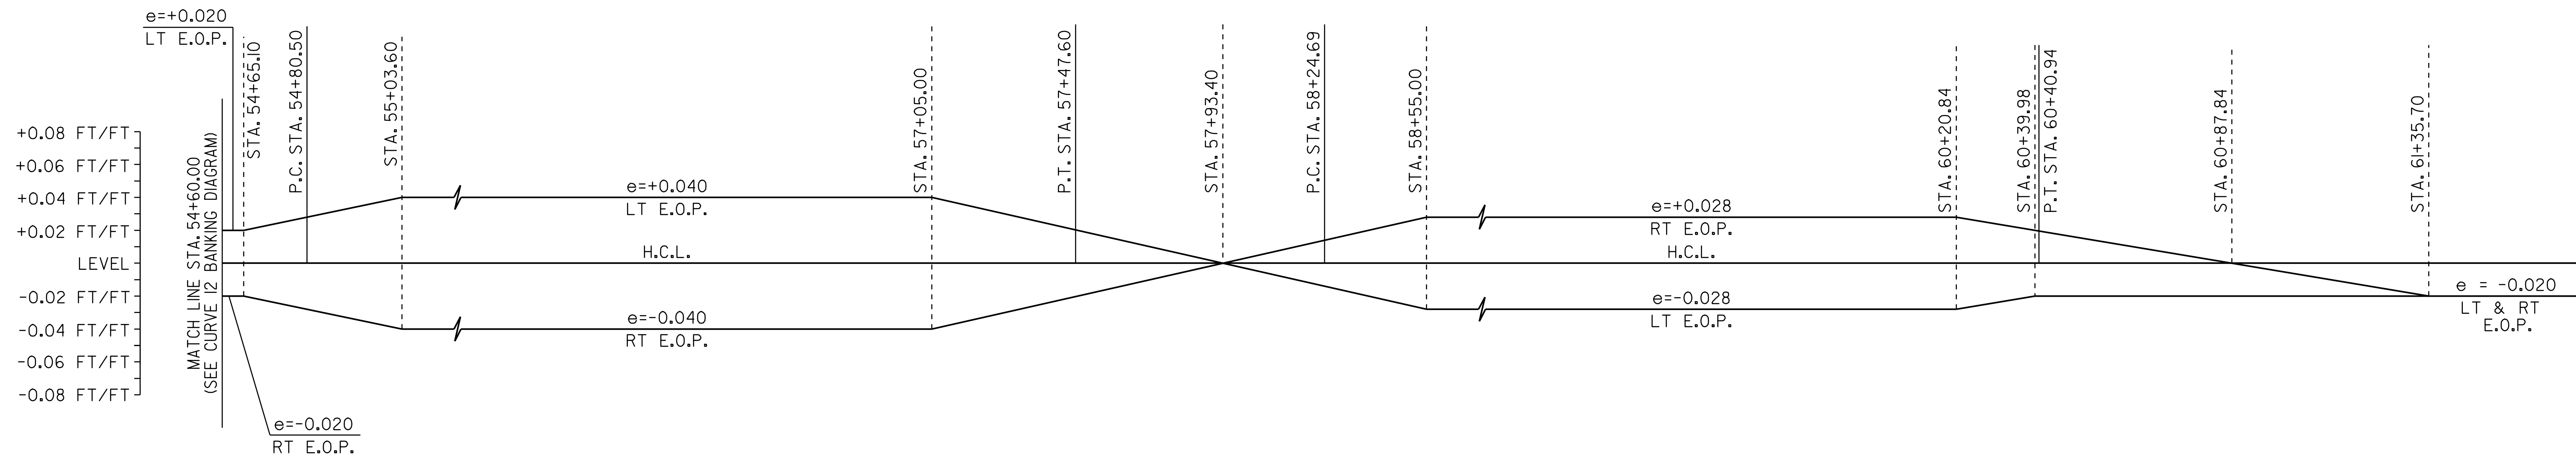

CURVE 13 & CURVE 14 BANKING DIAGRAMS

CURVE 13 RADIUS = 1400'
 CURVE 14 RADIUS = 4200'

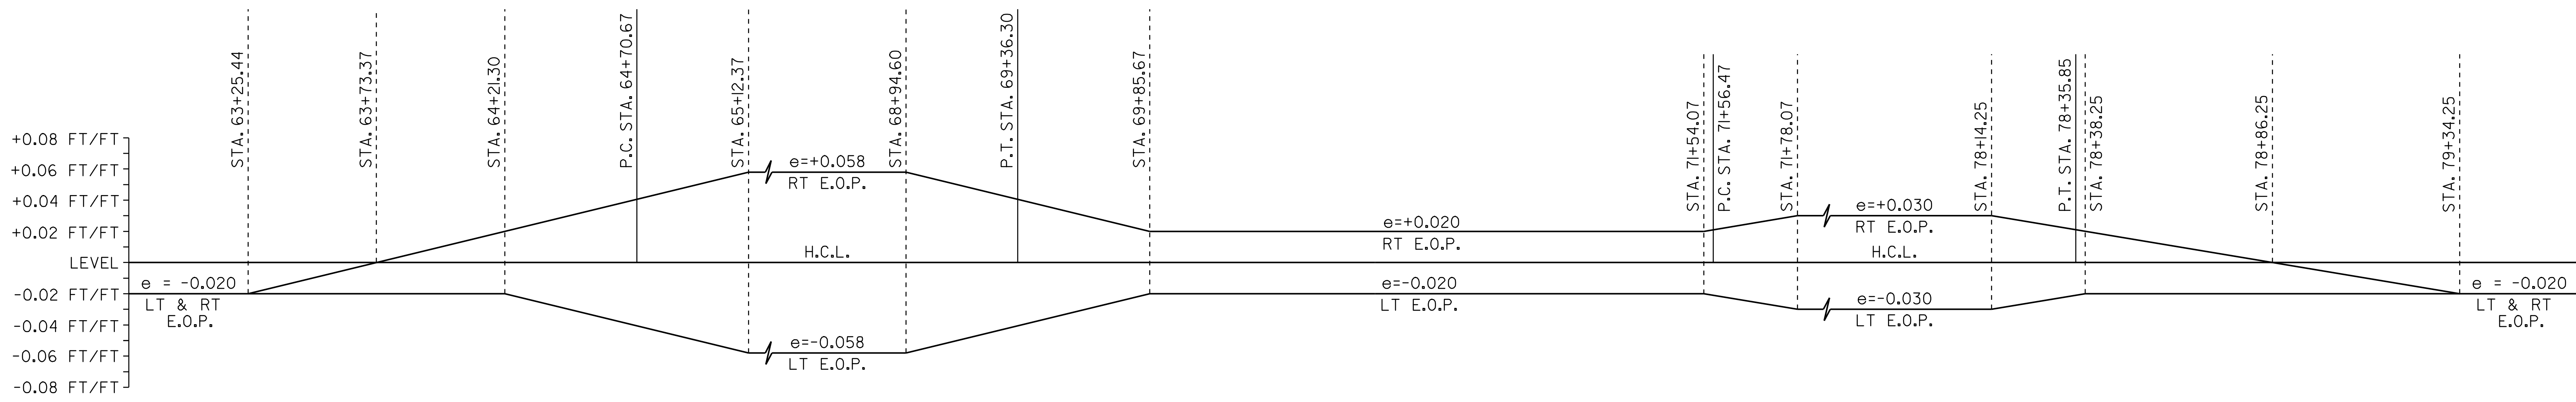

CURVE 15 & CURVE 16 BANKING DIAGRAMS


CURVE 15 RADIUS = 1700'
 CURVE 16 RADIUS = 4000'

SUPERELEVATION BANKING NOTES:


1. THE CONTRACTOR IS RESPONSIBLE FOR ESTABLISHING AND MAINTAINING THE HORIZONTAL AND VERTICAL GEOMETRY OF THE EXISTING ROADWAY.
2. THE MAXIMUM ROLL-OVER BETWEEN LANE AND SHOULDER CROSS SLOPES ON THE OUTSIDE (HIGH SIDE) OF A SUPERELEVATED CURVE SHALL BE SEVEN PERCENT. SHOULDER CROSS SLOPE ON THE INSIDE (LOW SIDE) OF A SUPERELEVATED CURVE SHALL BE A MINIMUM OF SIX PERCENT AND MATCH THE ADJACENT LANE CROSS SLOPE WHEN THE LANE CROSS SLOPE EXCEEDS SIX PERCENT.
3. SUPERELEVATION RATES AND RUNOFF LENGTHS WERE DETERMINED USING A DESIGN SPEED EQUAL TO THE POSTED SPEED AND A MAXIMUM SUPERELEVATION RATE OF 0.08.

NOT TO SCALE
SUPERELEVATION BANKING DIAGRAMS SHEET #4

PROJECT NAME: BRIDGEWATER_-_WOODSTOCK
 PROJECT NUMBER: NH_2611(1)S
 FILE NAME: p06b160.dgn
 PROJECT LEADER: D.E.G.
 DESIGNED BY: D.W.E.
 IPARM FILE: p06b160sbd4.i
 PLOT DATE: 28-MAY-2010
 DRAWN BY: C.A.K.
 CHECKED BY: D.E.G.
 SHEET 42 OF 80

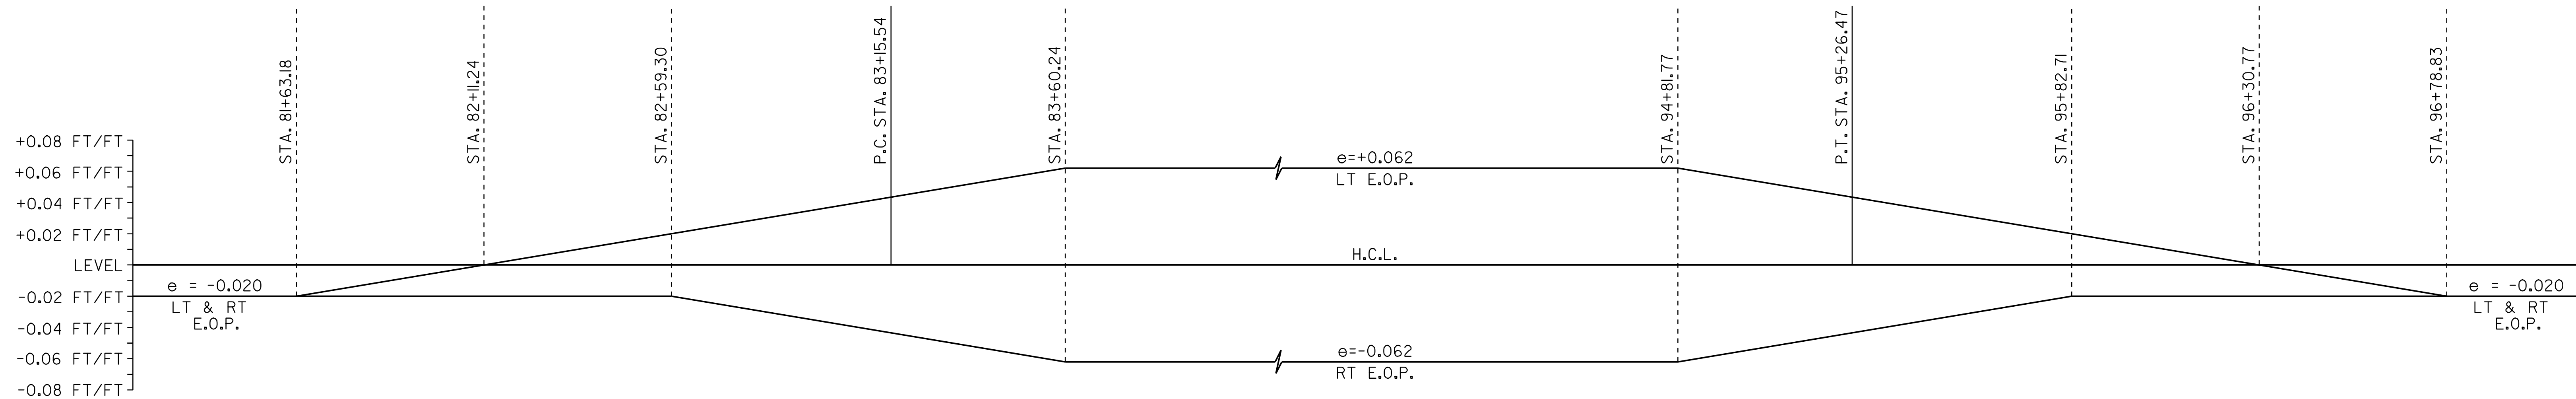

CURVE 17 BANKING DIAGRAM
 CURVE 17 RADIUS = 1500'

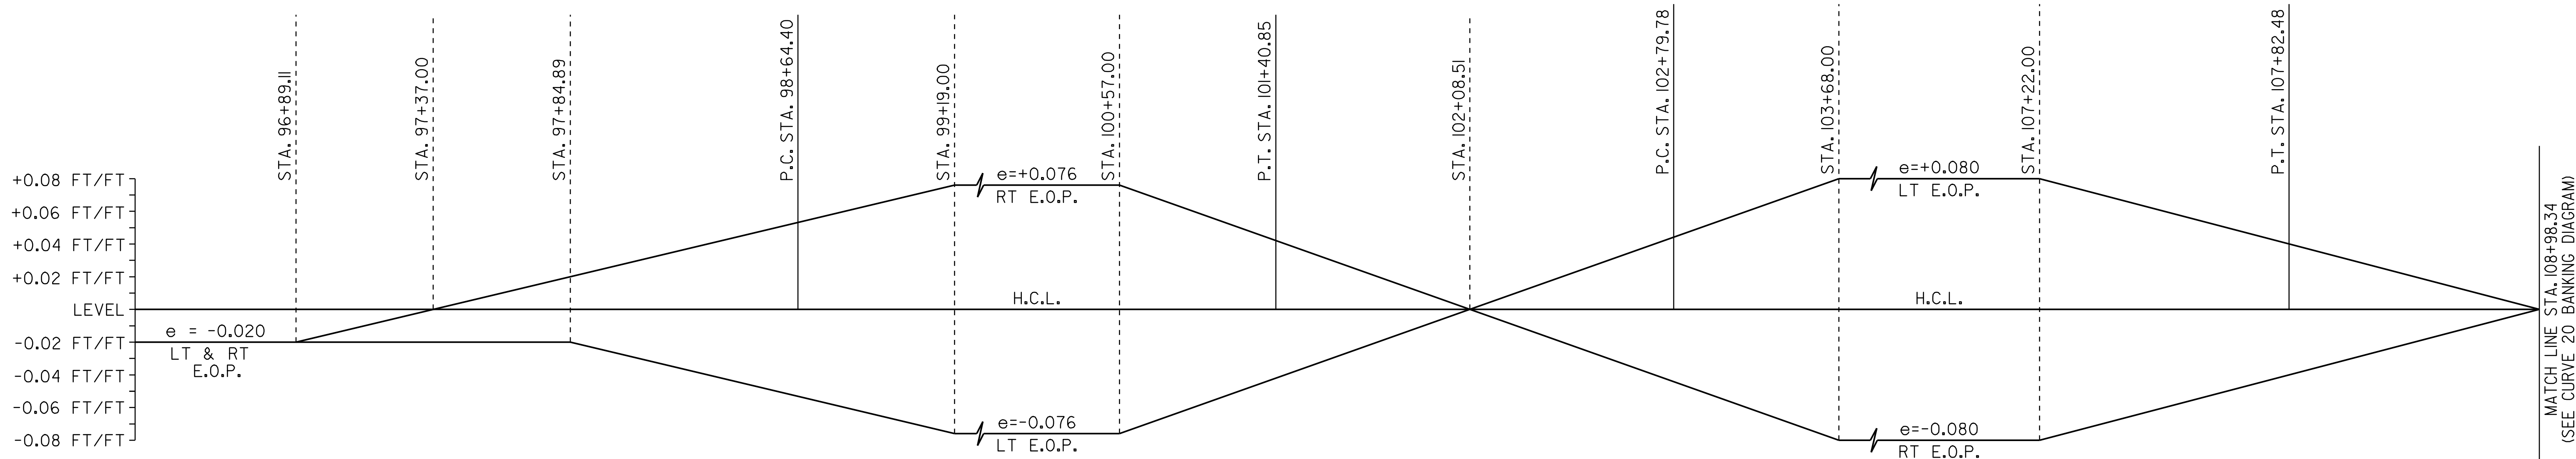

CURVE 18 & CURVE 19 BANKING DIAGRAMS
 CURVE 18 RADIUS = 1000'
 CURVE 19 RADIUS = 800'

SUPERELEVATION BANKING NOTES:


1. THE CONTRACTOR IS RESPONSIBLE FOR ESTABLISHING AND MAINTAINING THE HORIZONTAL AND VERTICAL GEOMETRY OF THE EXISTING ROADWAY.
2. THE MAXIMUM ROLL-OVER BETWEEN LANE AND SHOULDER CROSS SLOPES ON THE OUTSIDE (HIGH SIDE) OF A SUPERELEVATED CURVE SHALL BE SEVEN PERCENT. SHOULDER CROSS SLOPE ON THE INSIDE (LOW SIDE) OF A SUPERELEVATED CURVE SHALL BE A MINIMUM OF SIX PERCENT AND MATCH THE ADJACENT LANE CROSS SLOPE WHEN THE LANE CROSS SLOPE EXCEEDS SIX PERCENT.
3. SUPERELEVATION RATES AND RUNOFF LENGTHS WERE DETERMINED USING A DESIGN SPEED EQUAL TO THE POSTED SPEED AND A MAXIMUM SUPERELEVATION RATE OF 0.08.

NOT TO SCALE

**SUPERELEVATION
 BANKING
 DIAGRAMS
 SHEET #5**


PROJECT NAME: BRIDGEWATER_-_WOODSTOCK
 PROJECT NUMBER: NH_2611(S)_____

FILE NAME: p06b160.dgn_-- PLOT DATE: 28-MAY-2010
 PROJECT LEADER: D.E.G. DRAWN BY: C.A.K.
 DESIGNED BY: D.W.E. CHECKED BY: D.E.G.
 IPARM FILE: p06b160sbd5.i SHEET 43 OF 80

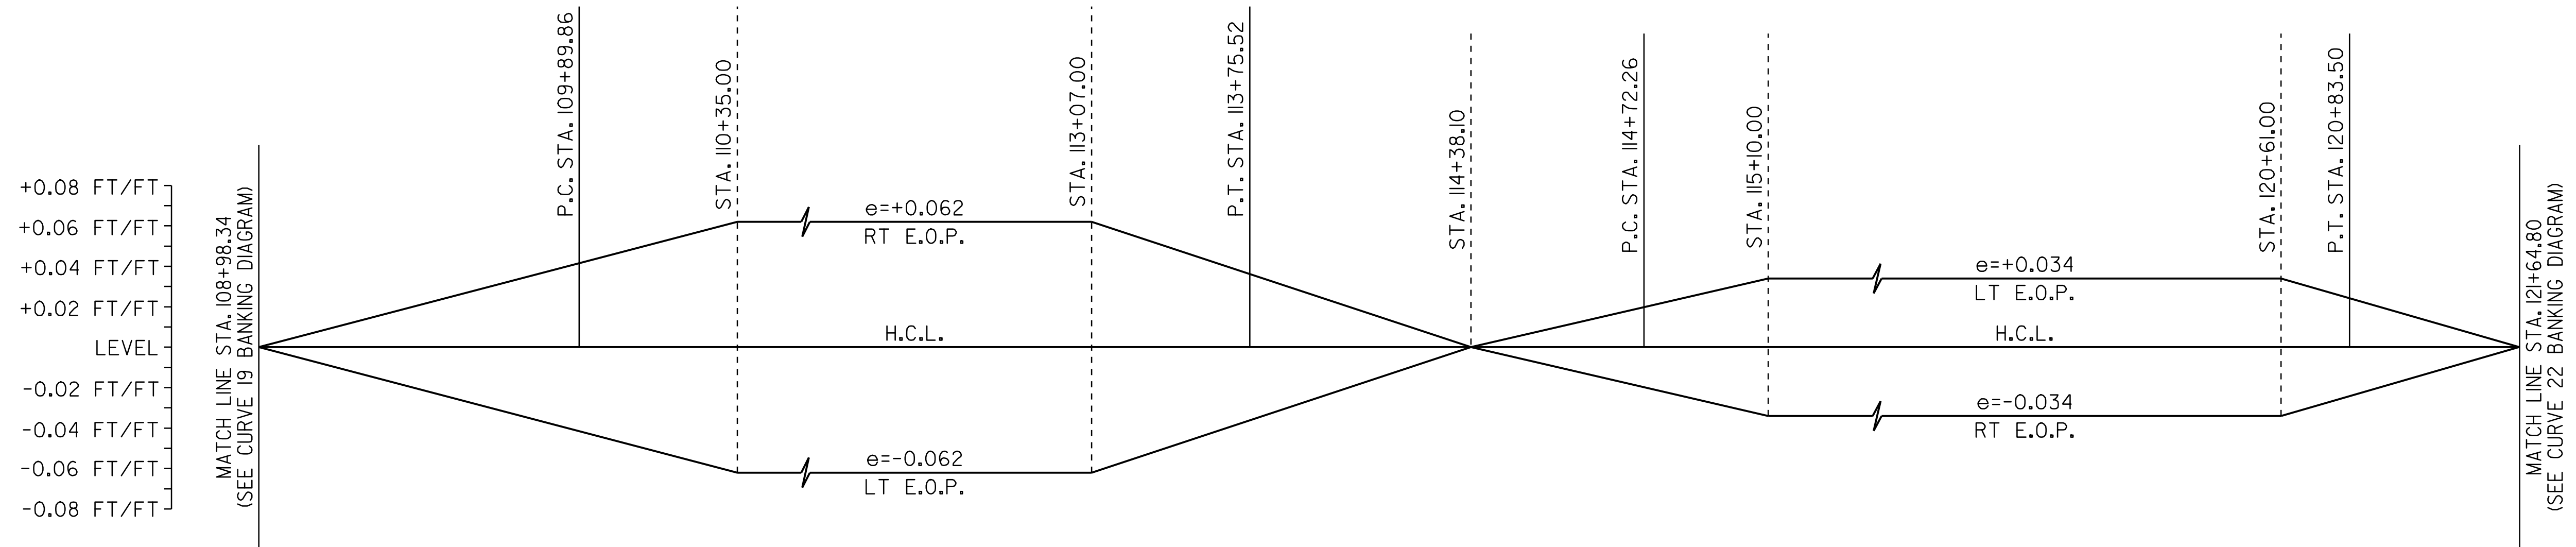


CURVE 20 & CURVE 21 BANKING DIAGRAMS

CURVE 20 RADIUS = 1500'
 CURVE 21 RADIUS = 3500'

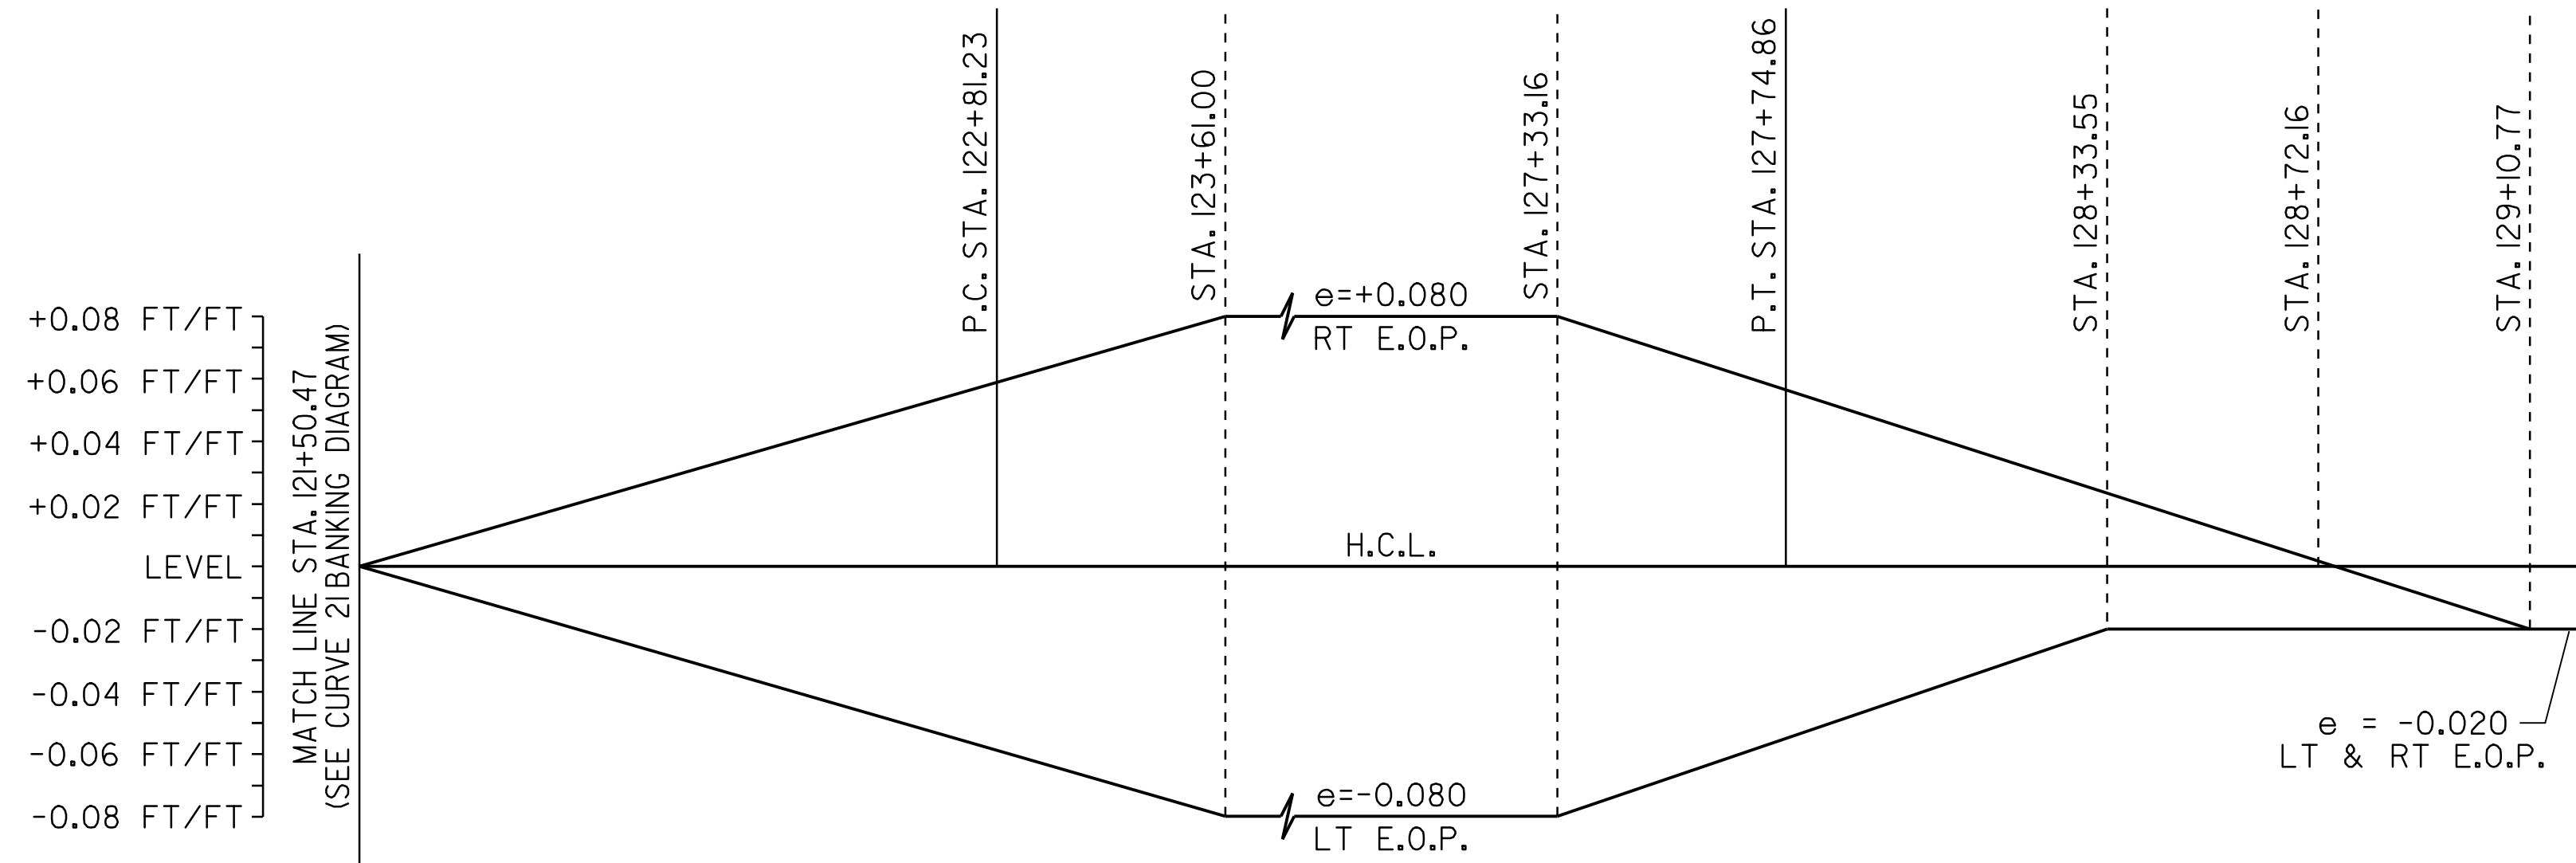

CURVE 22 BANKING DIAGRAM

CURVE 22 RADIUS = 500'

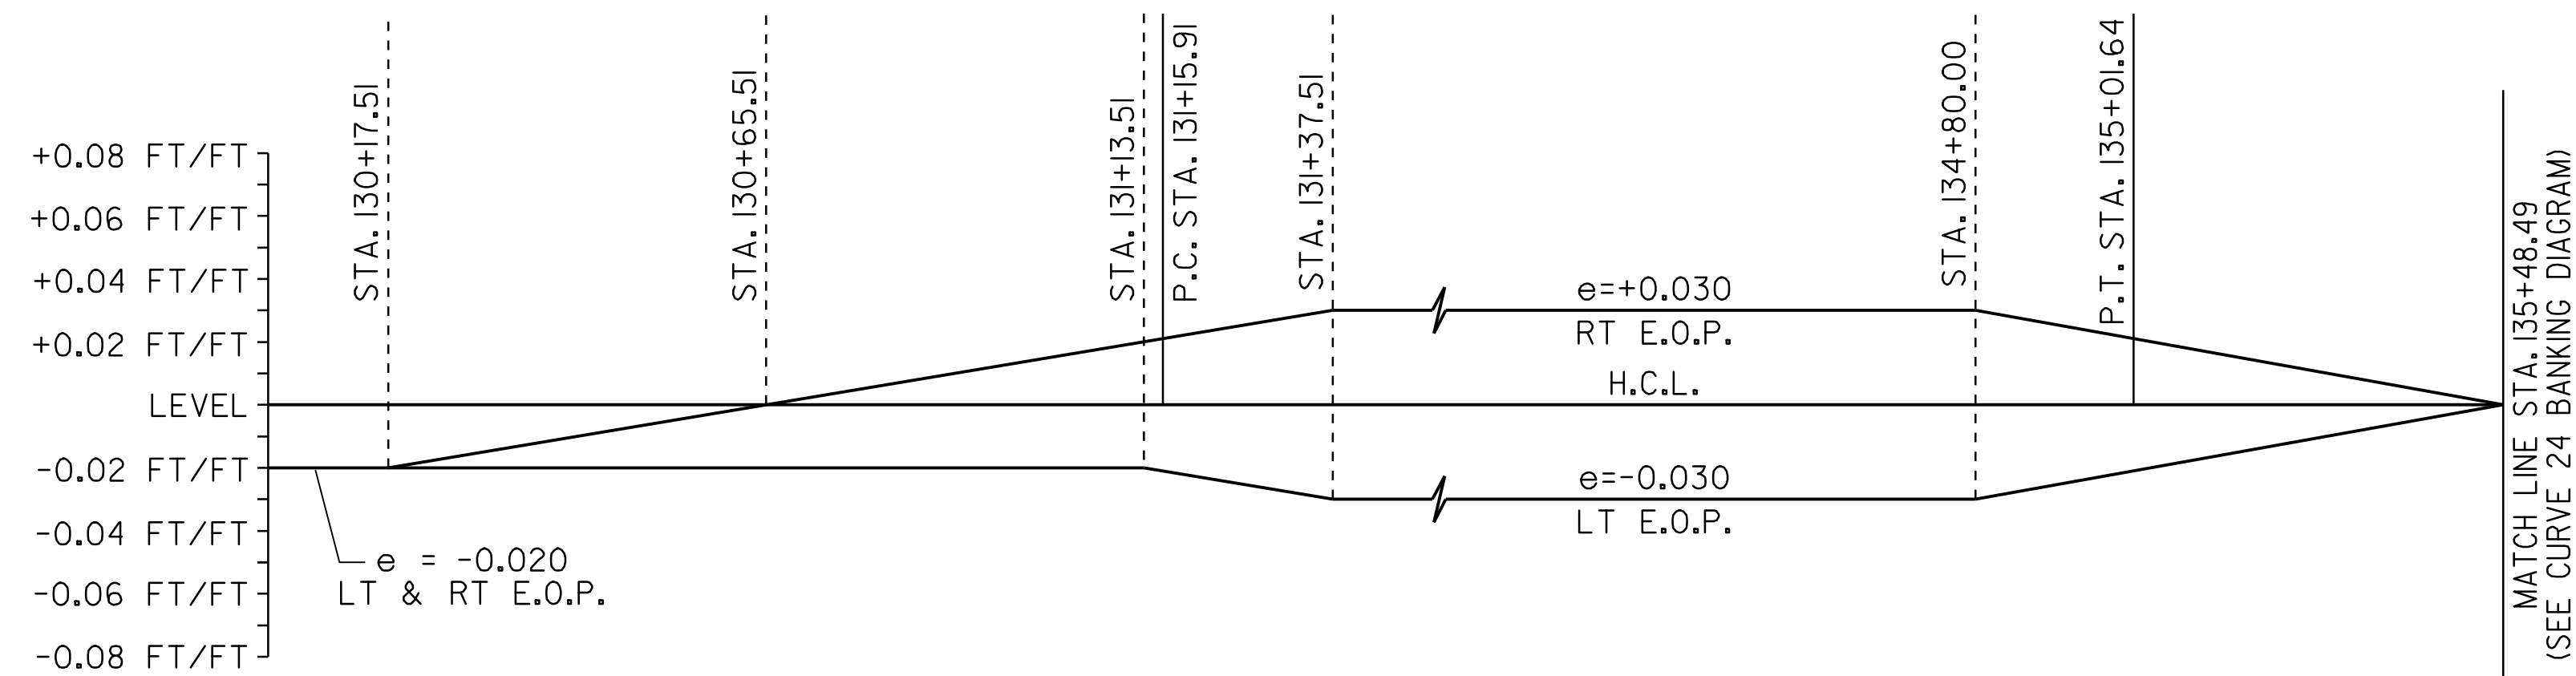

CURVE 23 BANKING DIAGRAM

CURVE 23 RADIUS = 4000'

SUPERELEVATION BANKING NOTES:


1. THE CONTRACTOR IS RESPONSIBLE FOR ESTABLISHING AND MAINTAINING THE HORIZONTAL AND VERTICAL GEOMETRY OF THE EXISTING ROADWAY.
2. THE MAXIMUM ROLL-OVER BETWEEN LANE AND SHOULDER CROSS SLOPES ON THE OUTSIDE (HIGH SIDE) OF A SUPERELEVATED CURVE SHALL BE SEVEN PERCENT. SHOULDER CROSS SLOPE ON THE INSIDE (LOW SIDE) OF A SUPERELEVATED CURVE SHALL BE A MINIMUM OF SIX PERCENT AND MATCH THE ADJACENT LANE CROSS SLOPE WHEN THE LANE CROSS SLOPE EXCEEDS SIX PERCENT.
3. SUPERELEVATION RATES AND RUNOFF LENGTHS WERE DETERMINED USING A DESIGN SPEED EQUAL TO THE POSTED SPEED AND A MAXIMUM SUPERELEVATION RATE OF 0.08.

NOT TO SCALE

**SUPERELEVATION
 BANKING
 DIAGRAMS
 SHEET #6**


PROJECT NAME: BRIDGEWATER_-_WOODSTOCK
 PROJECT NUMBER: NH_2611(1)S

FILE NAME: p06b160.dgn_ PLOT DATE: 28-MAY-2010
 PROJECT LEADER: D.E.G. DRAWN BY: C.A.K.
 DESIGNED BY: D.W.E. CHECKED BY: D.E.G.
 IPARM FILE: p06b160sbd6.i SHEET 44 OF 80

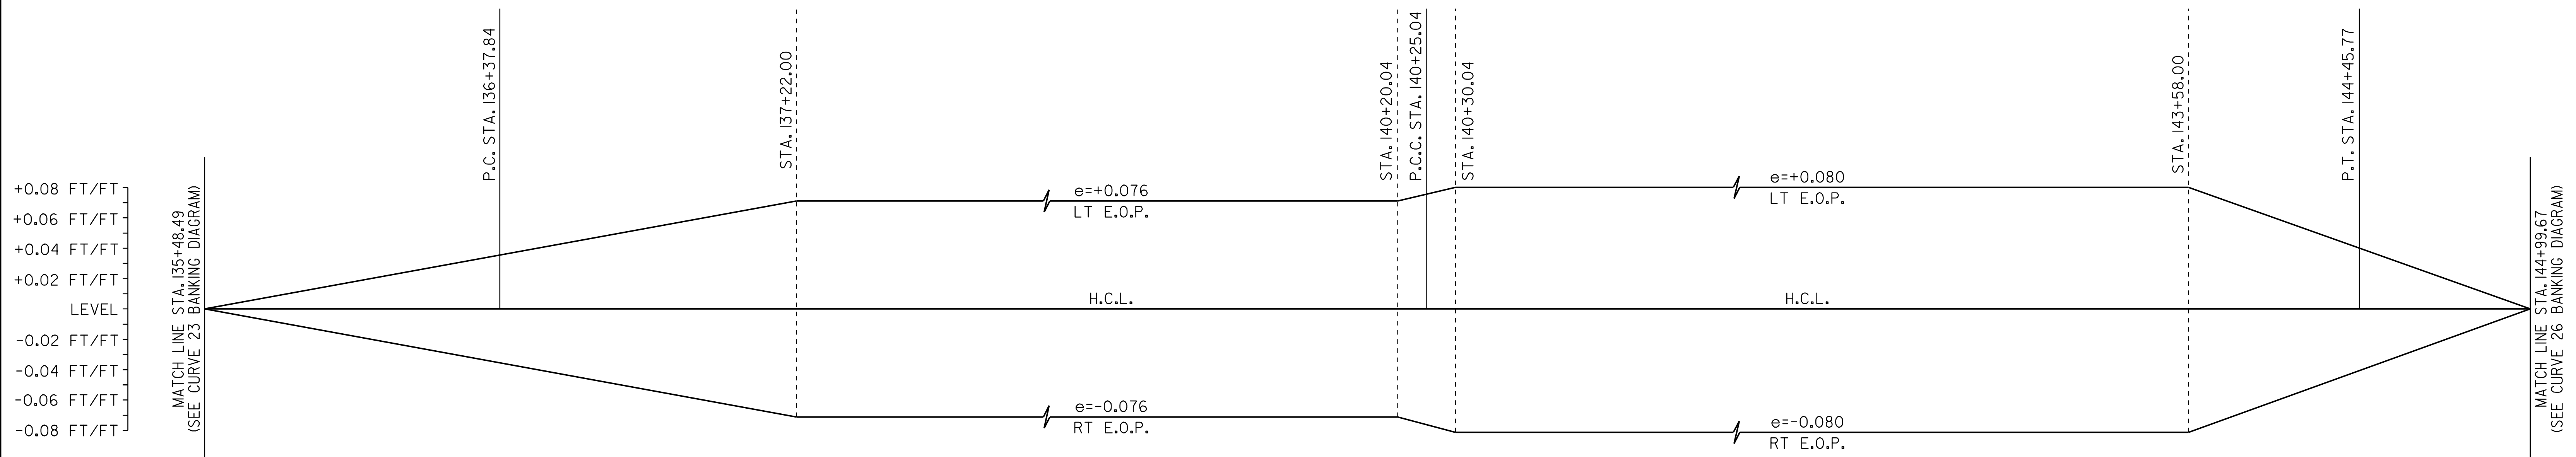


CURVE 24 & CURVE 25 BANKING DIAGRAMS

CURVE 24 RADIUS = 1000'
 CURVE 25 RADIUS = 500'

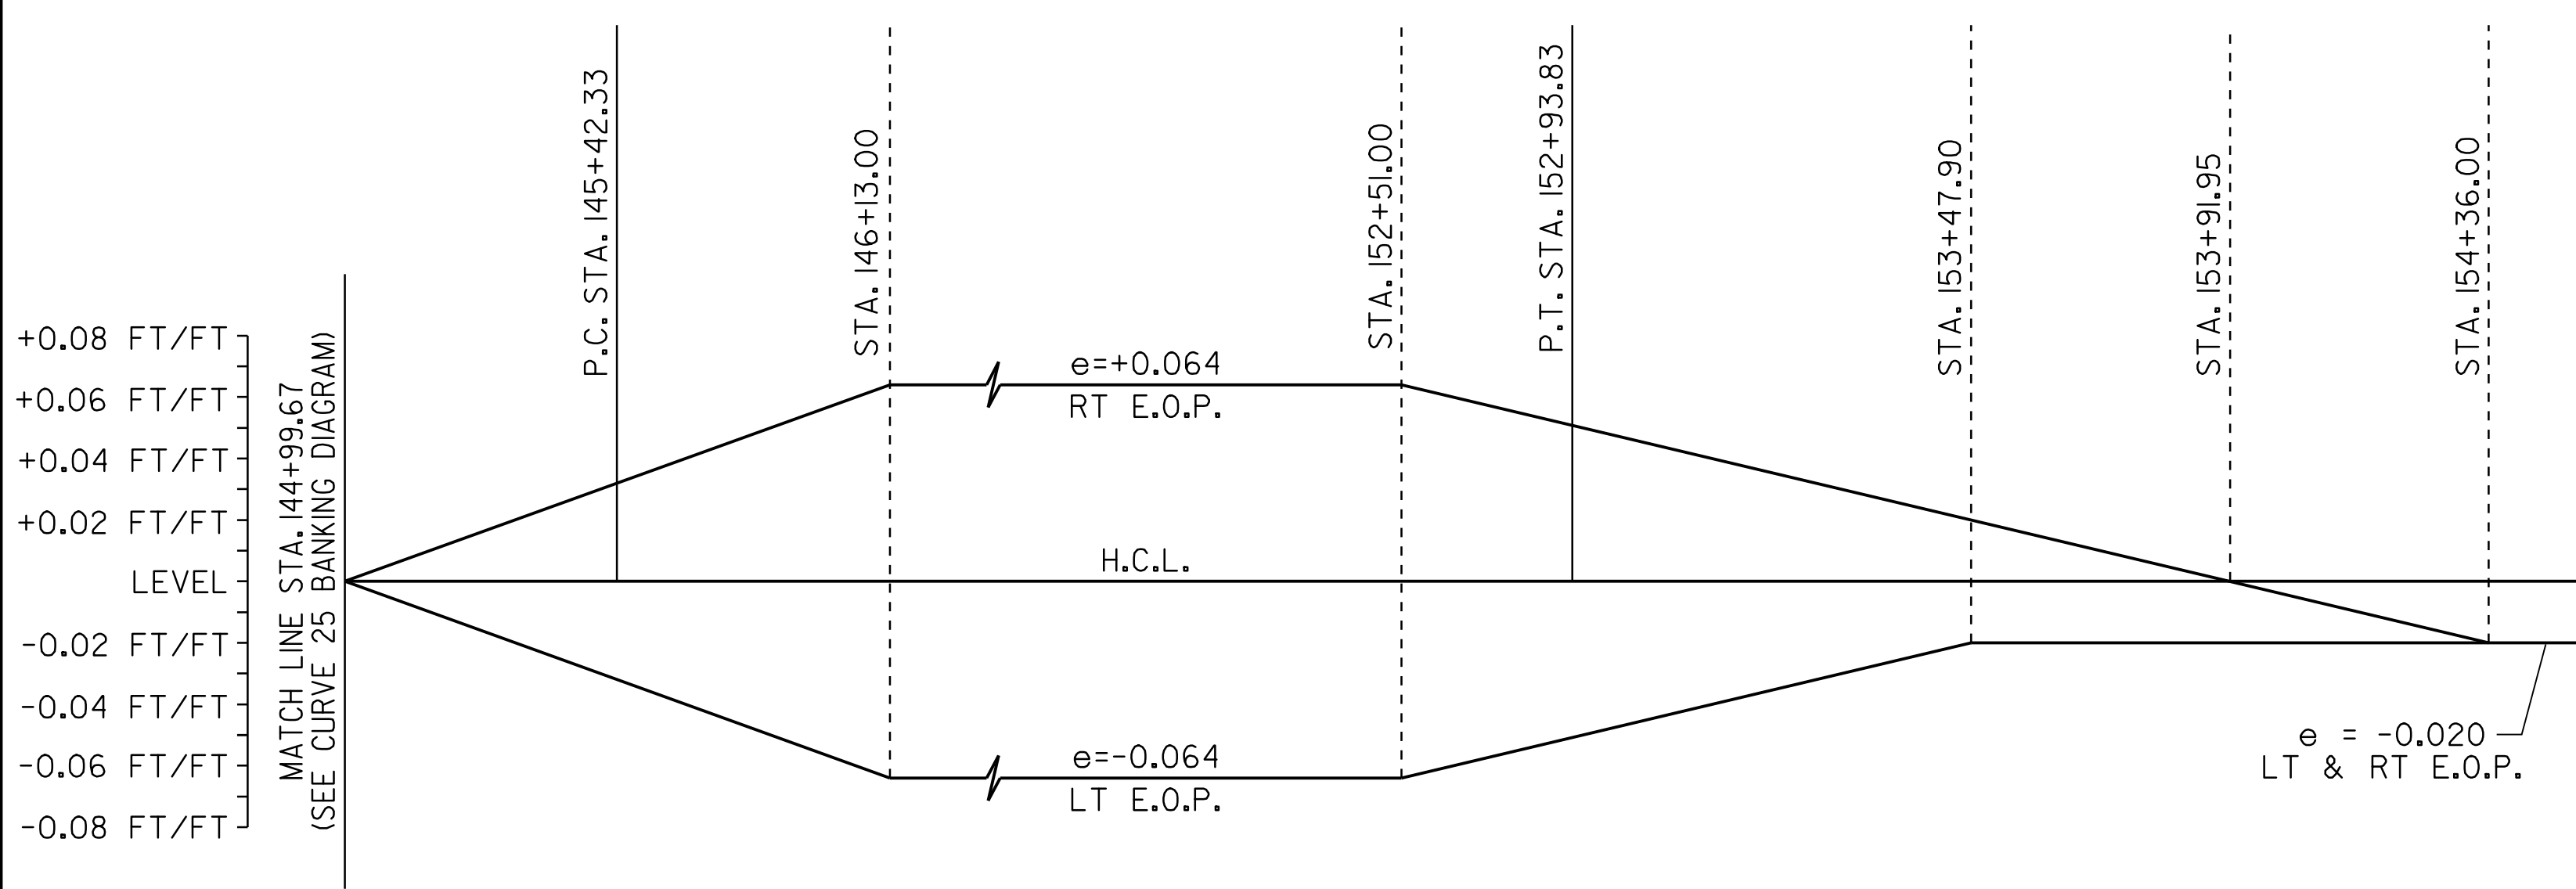

CURVE 26 BANKING DIAGRAM

CURVE 26 RADIUS = 1400'

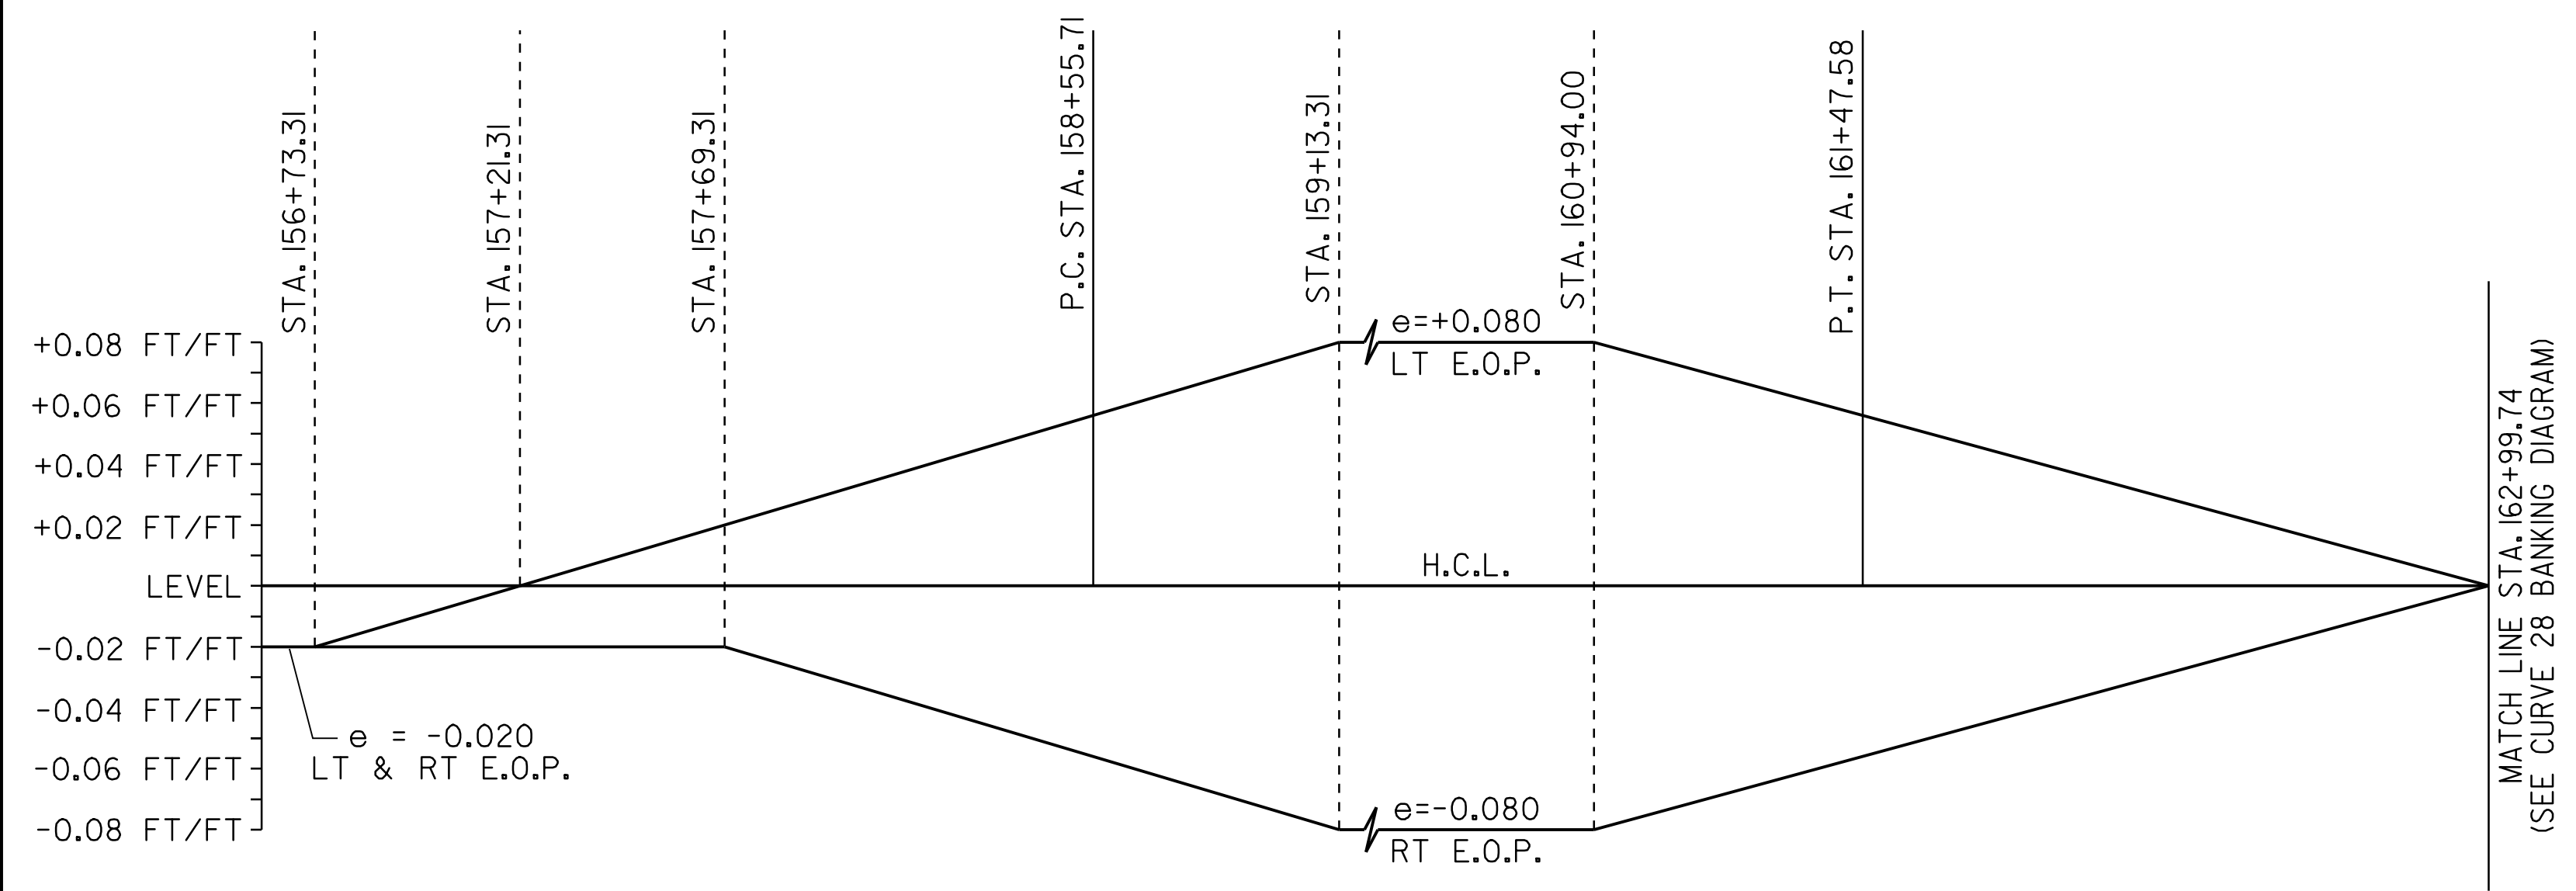

CURVE 27 BANKING DIAGRAM

CURVE 27 RADIUS = 600'

SUPERELEVATION BANKING NOTES:


1. THE CONTRACTOR IS RESPONSIBLE FOR ESTABLISHING AND MAINTAINING THE HORIZONTAL AND VERTICAL GEOMETRY OF THE EXISTING ROADWAY.
2. THE MAXIMUM ROLL-OVER BETWEEN LANE AND SHOULDER CROSS SLOPES ON THE OUTSIDE (HIGH SIDE) OF A SUPERELEVATED CURVE SHALL BE SEVEN PERCENT. SHOULDER CROSS SLOPE ON THE INSIDE (LOW SIDE) OF A SUPERELEVATED CURVE SHALL BE A MINIMUM OF SIX PERCENT AND MATCH THE ADJACENT LANE CROSS SLOPE WHEN THE LANE CROSS SLOPE EXCEEDS SIX PERCENT.
3. SUPERELEVATION RATES AND RUNOFF LENGTHS WERE DETERMINED USING A DESIGN SPEED EQUAL TO THE POSTED SPEED AND A MAXIMUM SUPERELEVATION RATE OF 0.08.

NOT TO SCALE


**SUPERELEVATION
 BANKING
 DIAGRAMS
 SHEET #7**

PROJECT NAME: BRIDGEWATER - WOODSTOCK
 PROJECT NUMBER: NH_26!!(1)S


FILE NAME: p06b160.dgn -- PLOT DATE: 28-MAY-2010
 PROJECT LEADER: D.E.G. DRAWN BY: C.A.K.
 DESIGNED BY: D.W.E. CHECKED BY: D.E.G.
 IPARM FILE: p06b160sbd7.i SHEET 45 OF 80

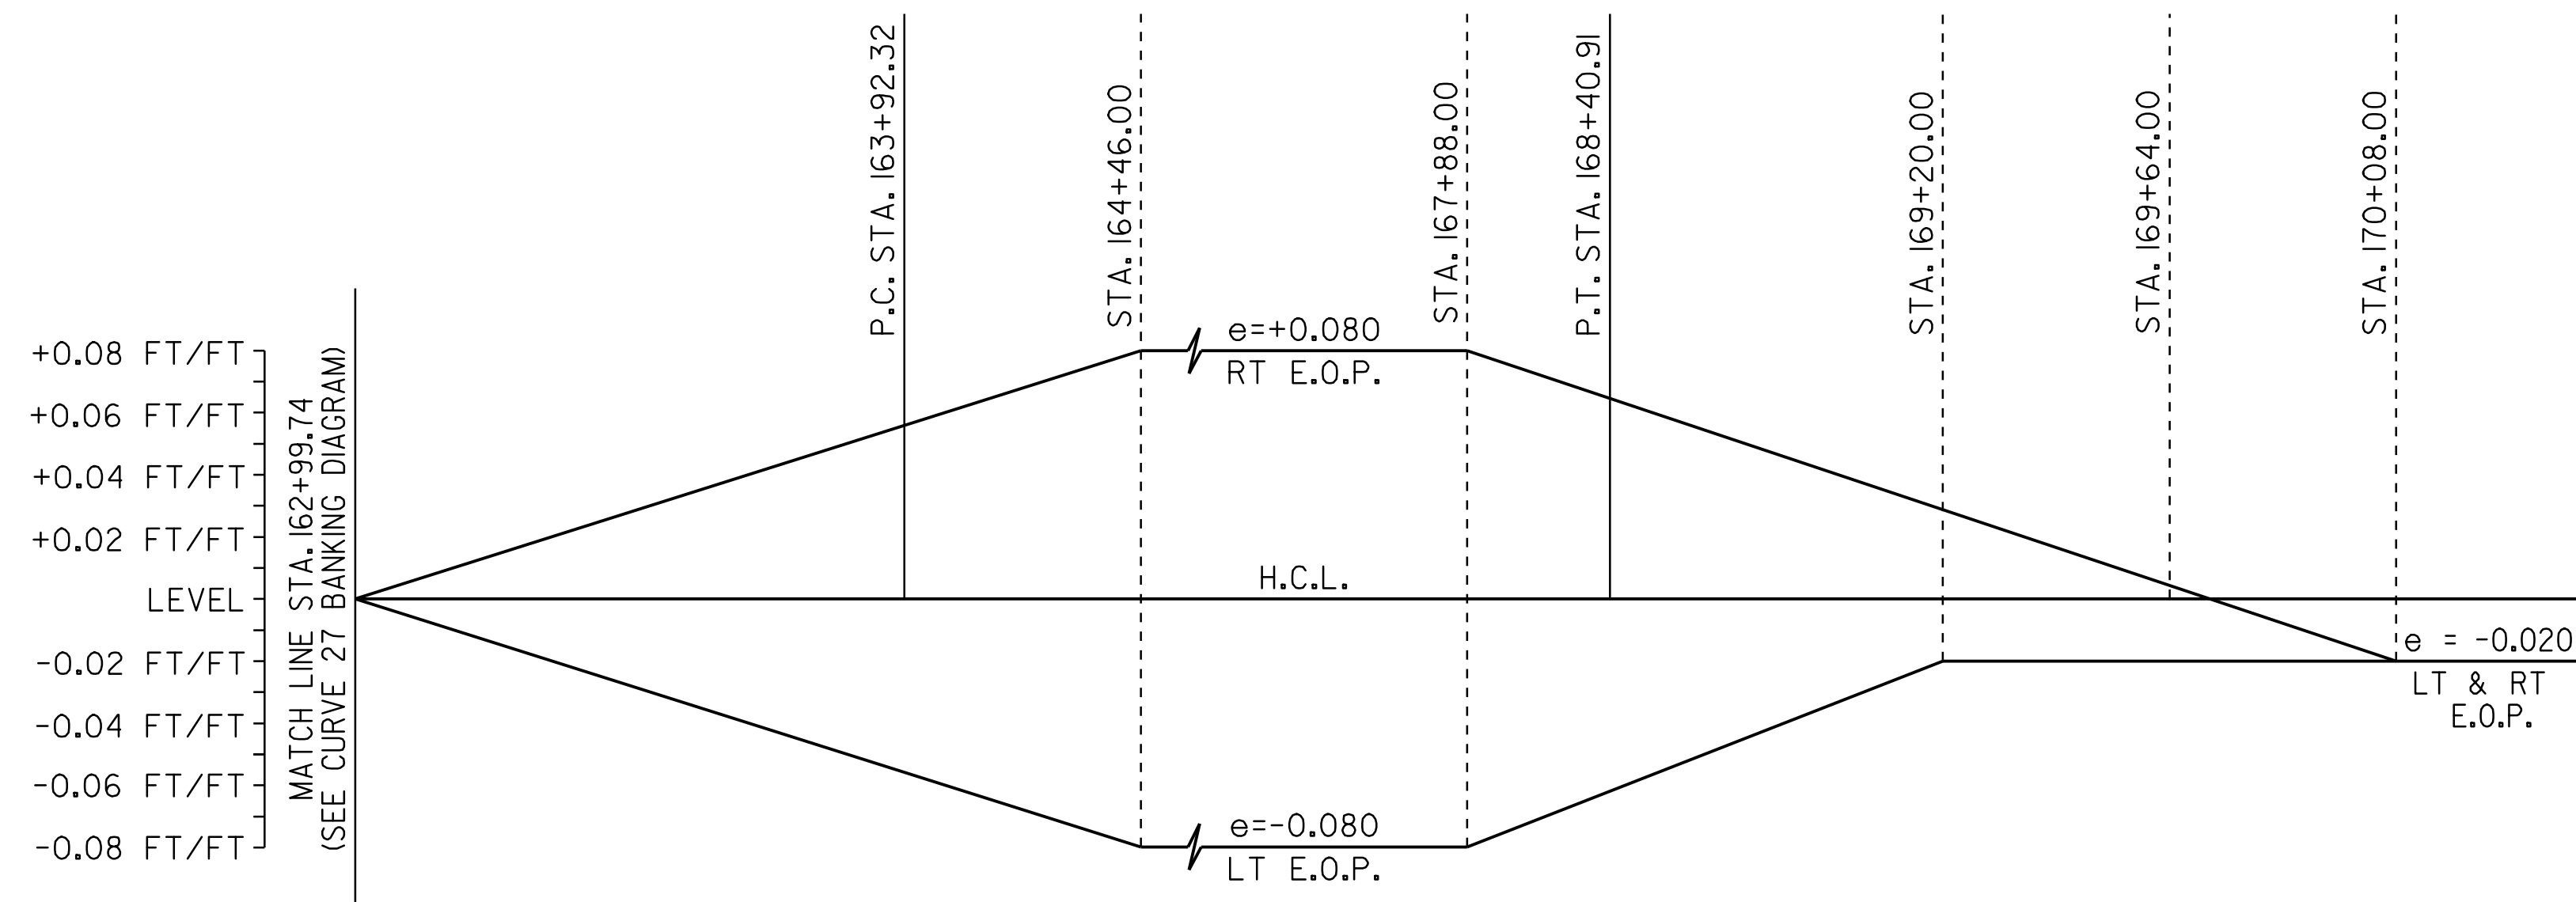

CURVE 28 BANKING DIAGRAM
CURVE 28 RADIUS = 500'

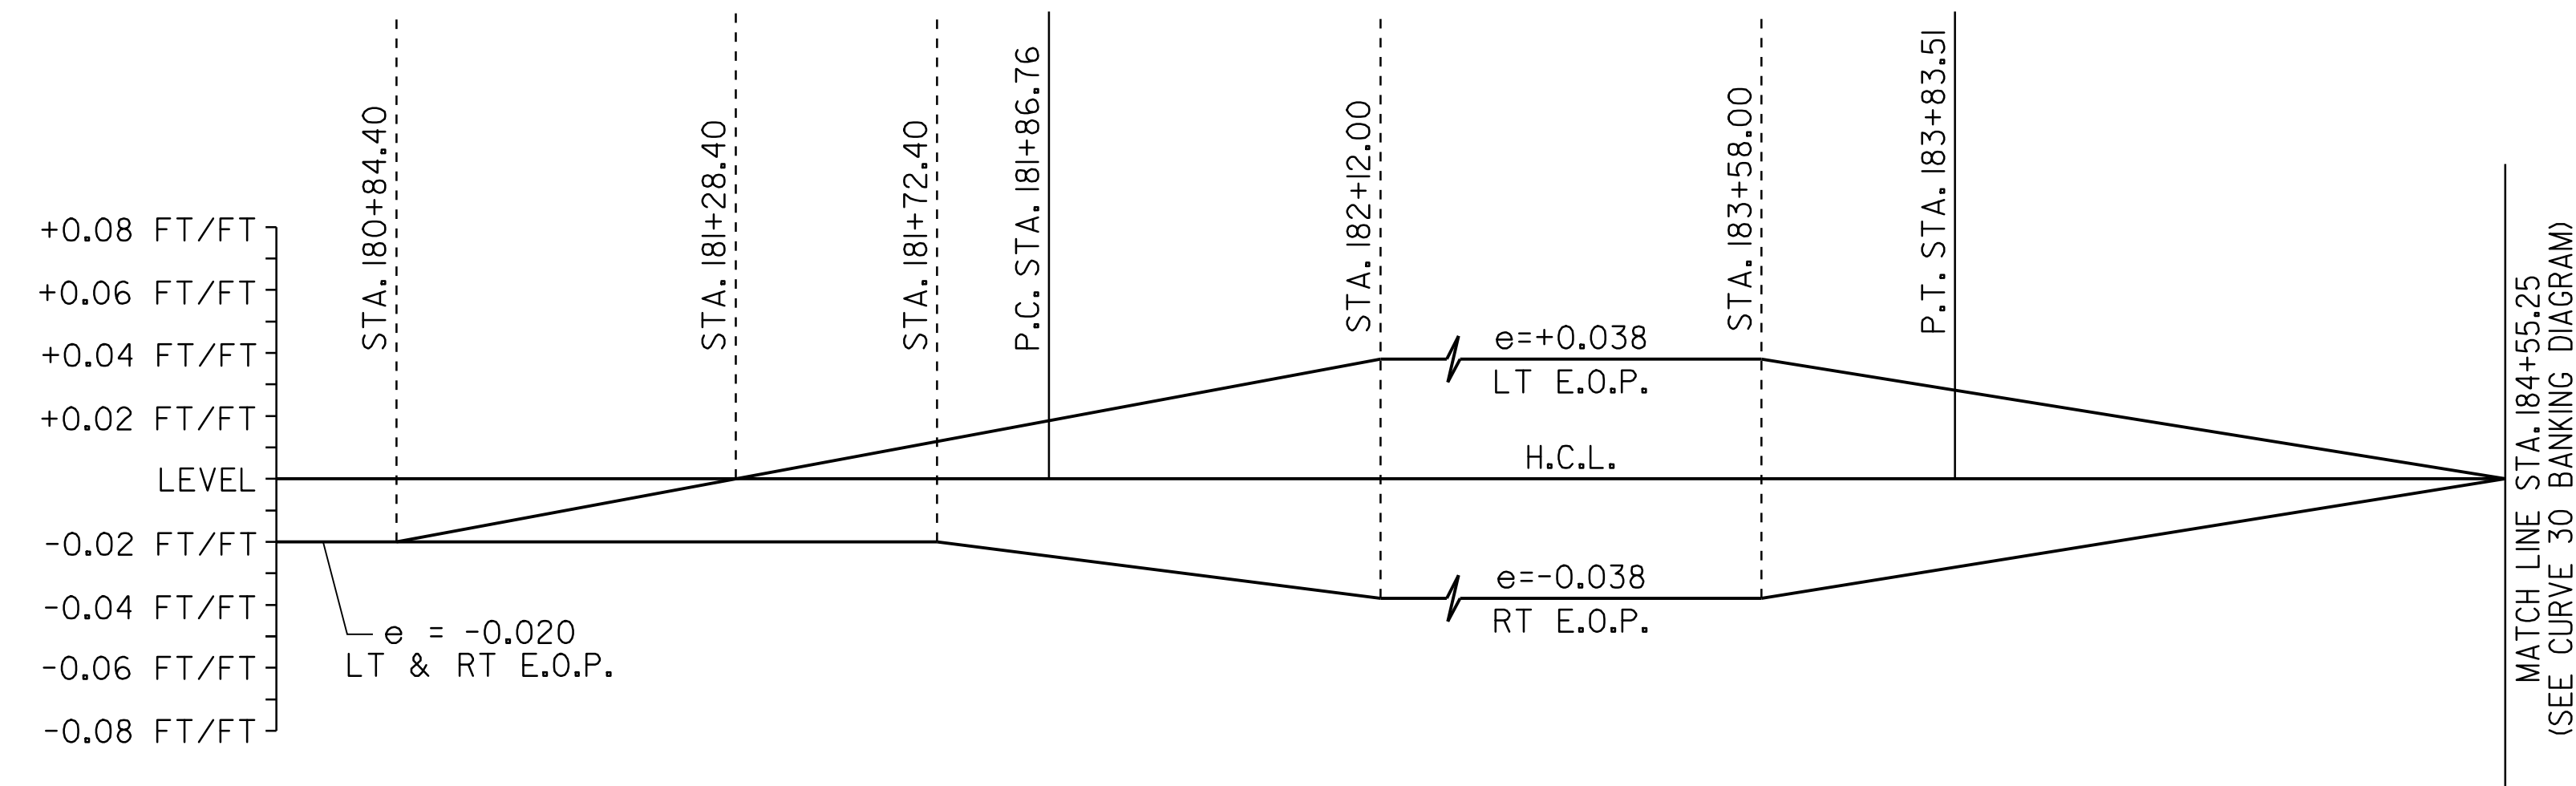

CURVE 29 BANKING DIAGRAM
CURVE 29 RADIUS = 3000'

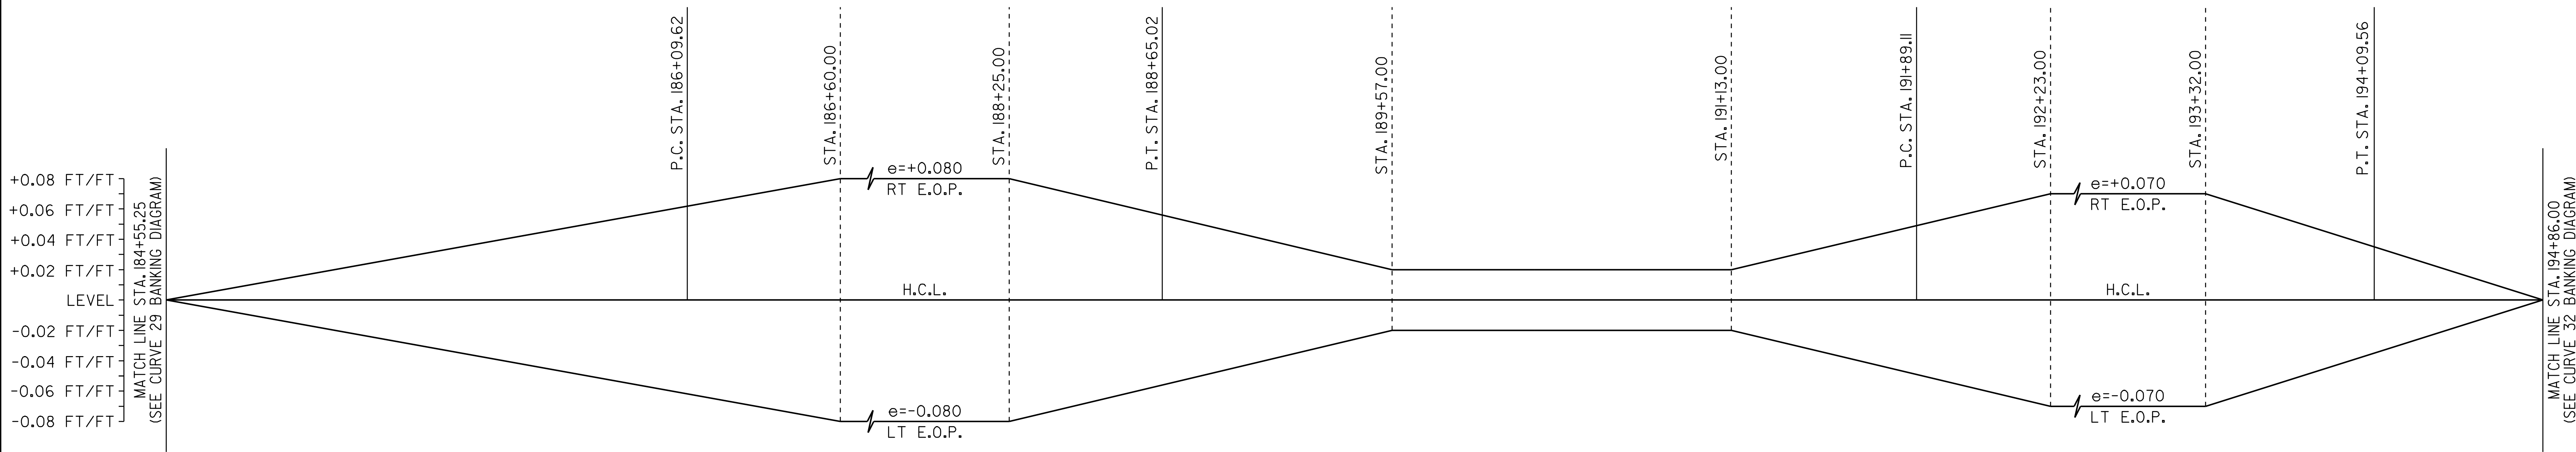

CURVE 30 & CURVE 31 BANKING DIAGRAMS
CURVE 30 RADIUS = 725'
CURVE 31 RADIUS = 1200'


SUPERELEVATION BANKING NOTES:

1. THE CONTRACTOR IS RESPONSIBLE FOR ESTABLISHING AND MAINTAINING THE HORIZONTAL AND VERTICAL GEOMETRY OF THE EXISTING ROADWAY.
2. THE MAXIMUM ROLL-OVER BETWEEN LANE AND SHOULDER CROSS SLOPES ON THE OUTSIDE (HIGH SIDE) OF A SUPERELEVATED CURVE SHALL BE SEVEN PERCENT. SHOULDER CROSS SLOPE ON THE INSIDE (LOW SIDE) OF A SUPERELEVATED CURVE SHALL BE A MINIMUM OF SIX PERCENT AND MATCH THE ADJACENT LANE CROSS SLOPE WHEN THE LANE CROSS SLOPE EXCEEDS SIX PERCENT.
3. SUPERELEVATION RATES AND RUNOFF LENGTHS WERE DETERMINED USING A DESIGN SPEED EQUAL TO THE POSTED SPEED AND A MAXIMUM SUPERELEVATION RATE OF 0.08.


NOT TO SCALE

SUPERELEVATION BANKING DIAGRAMS SHEET #8

PROJECT NAME: BRIDGEWATER_-_WOODSTOCK
PROJECT NUMBER: NH_26!!(!!)S
FILE NAME: p06b160.dgn_--
DESIGNED BY: D.W.E.
IPARM FILE: p06b160sbd8.i
PLOT DATE: 28-MAY-2010
DRAWN BY: C.A.K.
CHECKED BY: D.E.G.
SHEET 46 OF 80

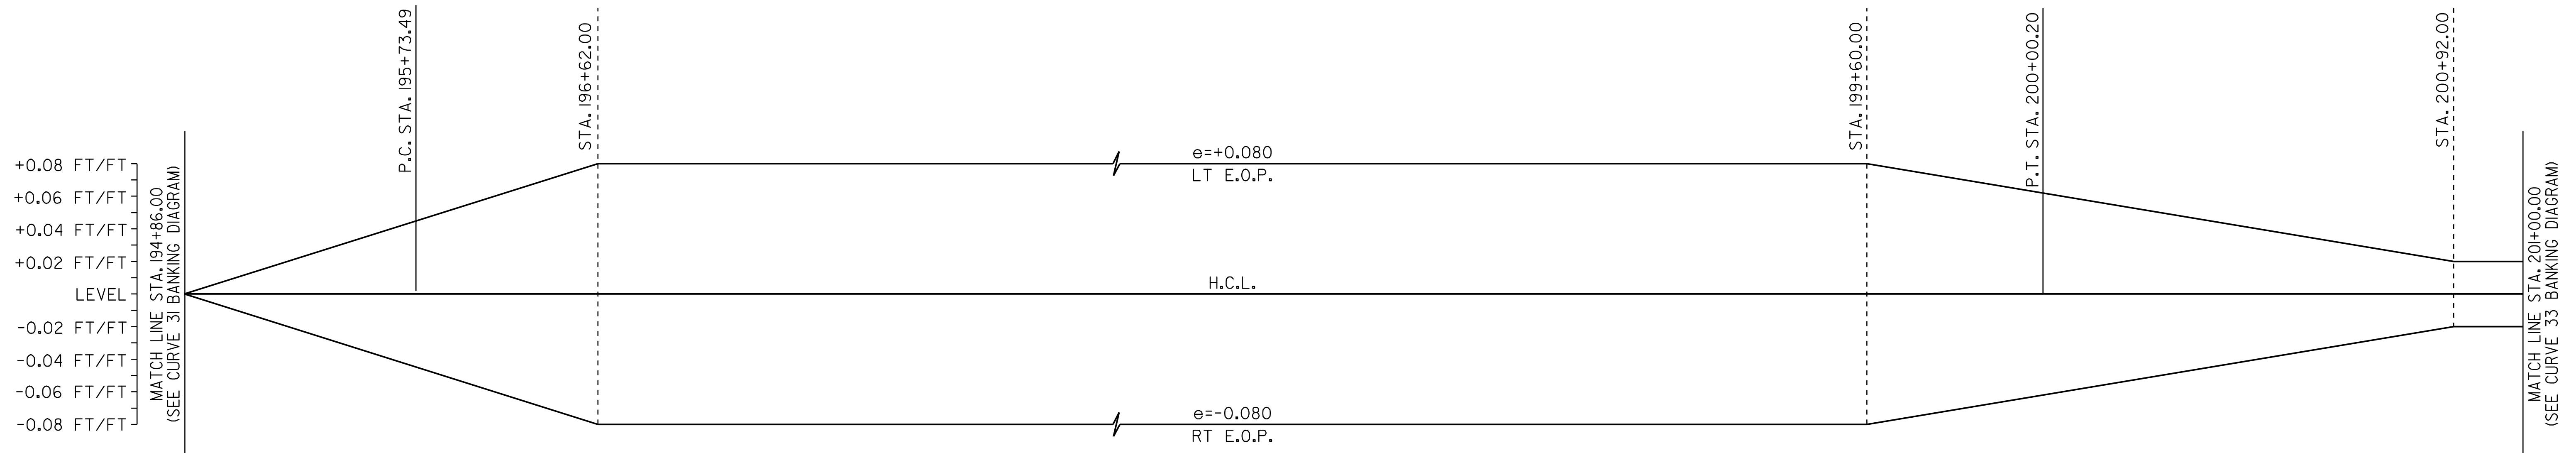

CURVE 32 BANKING DIAGRAM
 CURVE 32 RADIUS = 750'

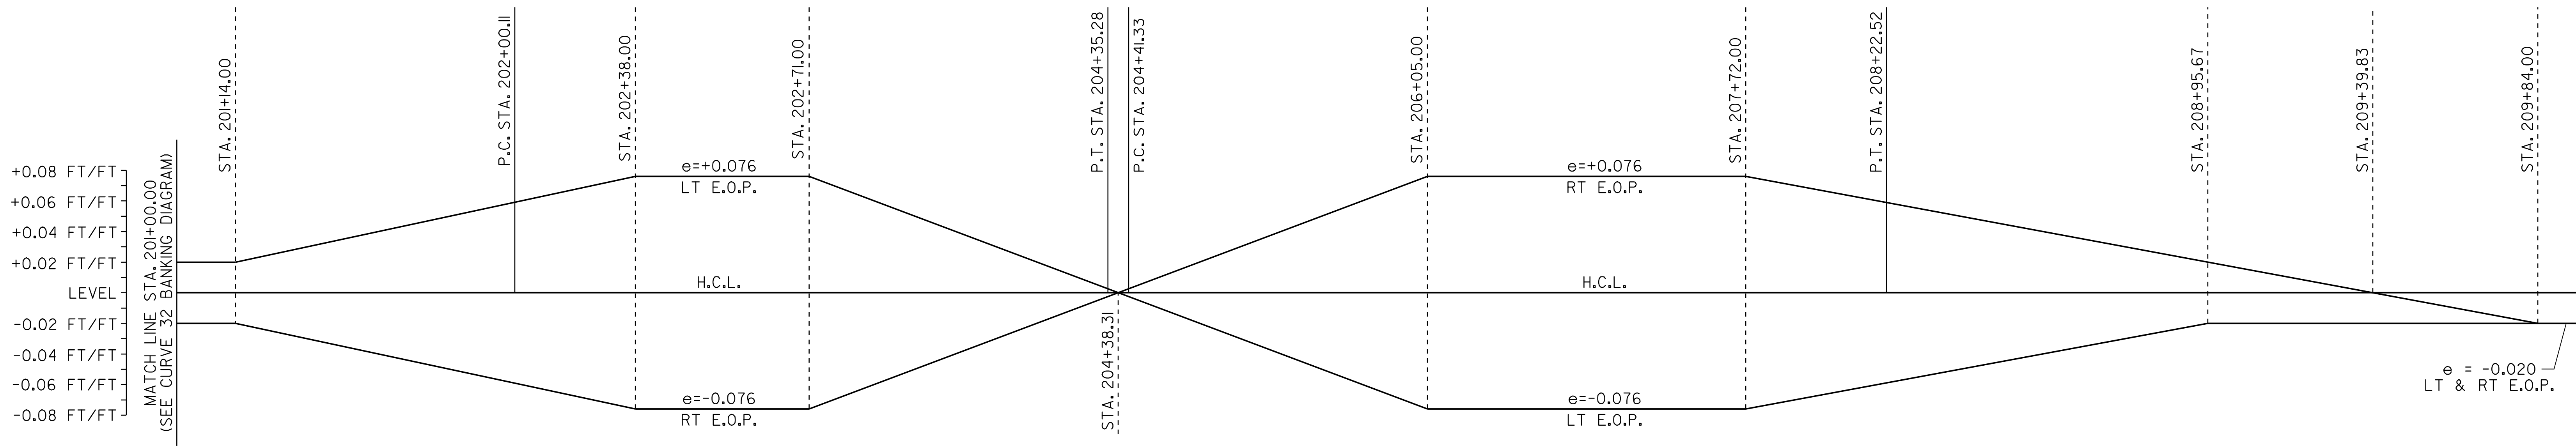

CURVE 33 & CURVE 34 BANKING DIAGRAMS
 CURVE 33 RADIUS = 1000'
 CURVE 34 RADIUS = 1000'

SUPERELEVATION BANKING NOTES:

1. THE CONTRACTOR IS RESPONSIBLE FOR ESTABLISHING AND MAINTAINING THE HORIZONTAL AND VERTICAL GEOMETRY OF THE EXISTING ROADWAY.
2. THE MAXIMUM ROLL-OVER BETWEEN LANE AND SHOULDER CROSS SLOPES ON THE OUTSIDE (HIGH SIDE) OF A SUPERELEVATED CURVE SHALL BE SEVEN PERCENT. SHOULDER CROSS SLOPE ON THE INSIDE (LOW SIDE) OF A SUPERELEVATED CURVE SHALL BE A MINIMUM OF SIX PERCENT AND MATCH THE ADJACENT LANE CROSS SLOPE WHEN THE LANE CROSS SLOPE EXCEEDS SIX PERCENT.
3. SUPERELEVATION RATES AND RUNOFF LENGTHS WERE DETERMINED USING A DESIGN SPEED EQUAL TO THE POSTED SPEED AND A MAXIMUM SUPERELEVATION RATE OF 0.08.

NOT TO SCALE

**SUPERELEVATION
 BANKING
 DIAGRAMS
 SHEET #9**

PROJECT NAME: BRIDGEWATER_-_WOODSTOCK
 PROJECT NUMBER: NH_2611(1)S

FILE NAME: p06b160.dgn_-- PLOT DATE: 28-MAY-2010
 PROJECT LEADER: D.E.G. DRAWN BY: C.A.K.
 DESIGNED BY: D.W.E. CHECKED BY: D.E.G.
 IPARM FILE: p06b160sbd9.i SHEET 47 OF 80

TRAFFIC SIGN SUMMARY SHEET 1

MILEMARKER, STATION, OR SIGN NUMBER	SIGN LEGEND	SIGN DIMENSIONS E A WIDTH (In) HEIGHT (In)		NEW & SALVAGED SIGNS				EXIST POST		NEW SIGN POSTS																REMARKS	SIGN DETAIL			
				"A"	"B"	SALV SIGN	SALV TIS	RETA IN	SALV AGE	NO. OF POSTS	FLANGED CHANNEL			SQUARE STEEL (In)			TUBULAR ALUMINUM Ø (In)			TUBULAR STEEL Ø (In)				W-SHAPE STEEL			REQUI RE D	DETAIL ON DWG. NUMBER	STD. SHEET NUMBER	
											lb/ft			1.75	2.0	2.5	3.0	4.0	4.0 MOD	FOUND- ATION	3.0	3.5	4.0	5.0	FTG. SIZE					WEIGHT
				1.12	2.0	3.0	1.88	2.16	3.35	1.3	1.7	1.7	7.6	9.0	10.8	14.6	24"	30"												

OPTION ITEMS																																	
BRIDGEWATER: 318+91.0, RT		I	24	30	5.00					I			X		X		X														SIGN ID CODE R2-1	E-142	
318+91 LT			24	30	5.00					I			X																				
322+44.0, LT		I	48	24	8.00					2			X																		SIGN SHALL BE MOUNTED ON TWO FLANGED CHANNEL POSTS. SIGN ID CODE WI-6R	E-152	
322+49.0, LT		I	48	24	8.00					2			X																		SIGN SHALL BE MOUNTED ON TWO FLANGED CHANNEL POSTS. SIGN ID CODE WI-6L	E-152	
327+36.0, LT		I	6	10	0.42					I	X			X			X														SIGN ID CODE VD-700	E-138	
332+22.0, LT		I	24	30	5.00					I			X		X		X														SIGN ID CODE R2-1	E-142	
332+22 RT		I	24	30	5.00					I			X																				
337+92.0, RT		I	6	10	0.42					I	X			X			X															SIGN ID CODE VD-700	E-138
338+20.0, RT		I	6	8	0.33					I	X			X			X															SIGN ID CODE VD-701	E-134

FINAL POST LENGTHS ARE TO BE DETERMINED IN THE FIELD. POST SIZES ARE COMPUTED BASED ON INFORMATION FURNISHED ON THE STANDARD SHEETS AND THE ROADWAY, TRAFFIC AND SAFETY SECTION'S "SIGN POST DESIGN GUIDELINE."

TOTALS

SF	SF	EA.	SF		LF	LF	LF	EA.	LB	LB	LB	EA.	LB	EA.	EA.	LB
27.17					70.0 (56.0)											

TRAFFIC SIGN SUMMARY SHEET #1

PROJECT NAME: BRIDGEWATER_-_WOODSTOCK
 PROJECT NUMBER: NH_2611(1)S
 FILE NAME: p06b160.dgn_ PLOT DATE: 28-MAY-2010
 PROJECT LEADER: D.E.G. DRAWN BY: C.A.K.
 DESIGNED BY: D.W.E. CHECKED BY: D.E.G.
 IPARM FILE: p06b160tss01.i SHEET 48 OF 80

TRAFFIC SIGN SUMMARY SHEET 4

MILEMARKER, STATION, OR SIGN NUMBER	SIGN LEGEND	SIGN DIMENSIONS		NEW & SALVAGED SIGNS				EXIST POST		NEW SIGN POSTS																REMARKS	SIGN DETAIL					
		E A	WIDTH (In)	HEIGHT (In)	"A"	"B"	SALV SIGN	SALV TIS	RETAIN	SALVAGE	NO. OF POSTS	FLANGED CHANNEL			SQUARE STEEL (In)				TUBULAR ALUMINUM Ø (In)			TUBULAR STEEL Ø (In)					W-SHAPE STEEL			REQ'D	DETAIL ON DWG. NUMBER	STD. SHEET NUMBER
												1.12	2.0	3.0	1.75	2.0	2.5	3.0	4.0	4.0 MOD	3.0	3.5	4.0	5.0	24"		30"	WEIGHT	POST SIZE			

										OPTION ITEMS																					
BRIDGEWATER: 372+24.0, RT		I	24	24	4.00					1			X		X		X													SIGN ID CODE R8-3A	E-143
374+89.0, RT		I	36	36	9.00					2			X																SIGN SHALL BE MOUNTED ON TWO FLANGED CHANNEL POSTS. SIGN ID CODE W3-5	74	
379+51.0, RT		I	24	30	5.00					1			X		X		X												SIGN ID CODE R2-1	E-142	
379+51.0, LT		I	24	30	5.00					1			X		X		X												SIGN ID CODE R2-1	E-142	
380+16.0, LT		I	6	10	0.42					1	X			X			X												SIGN ID CODE VD-700	E-138	
381+30.0, RT		I	36	36	9.00					2			X																SIGNS SHALL BE MOUNTED ON TWO FLANGED CHANNEL POSTS WITH A FLUORESCENT YELLOW-GREEN BACKGROUND SIGN ID CODE SI-1	E-153	
		I	30	18	3.75																								SIGN SHALL HAVE A FLUORESCENT YELLOW-GREEN BACKGROUND. SIGN ID CODE W16-9P	74	
383+19.0, LT										2			X		X		X												SALVAGED SIGN SHALL BE MOUNTED ON TWO NEW POSTS.	-	
383+28.0, LT		I	30	30	6.25																								BACK-TO-BACK SIGN ID CODE RI-1	E-143	
		I	6	10	0.42																								SIGN ID CODE VD-700	E-138	

FINAL POST LENGTHS ARE TO BE DETERMINED IN THE FIELD. POST SIZES ARE COMPUTED BASED ON INFORMATION FURNISHED ON THE STANDARD SHEETS AND THE ROADWAY, TRAFFIC AND SAFETY SECTION'S "SIGN POST DESIGN GUIDELINE."

	LF	LF	LF	LF	LF	LF	EA.	LB	LB	LB	LB	LB	LB	EA.	EA.	LB
	14.0	70.0 (56.0)	14.0	70.0												
TOTALS	SF	SF	EA.	SF	LF	LF		LB	EA.	EA.	LB					
	42.84		1		84.0 (56.0)	84.0										

TRAFFIC SIGN SUMMARY SHEET #4

PROJECT NAME: BRIDGEWATER_-_WOODSTOCK
PROJECT NUMBER: NH_2611(1)S
FILE NAME: p06b160.dgn_ PLOT DATE: 28-MAY-2010
PROJECT LEADER: D.E.G. DRAWN BY: C.A.K.
DESIGNED BY: D.W.E. CHECKED BY: D.E.G.
IPARM FILE: p06b160tss04.i SHEET 51 OF 80

TRAFFIC SIGN SUMMARY SHEET 5

MILEMARKER, STATION, OR SIGN NUMBER	SIGN LEGEND	SIGN DIMENSIONS		NEW & SALVAGED SIGNS				EXISTING POSTS		NEW SIGN POSTS														REMARKS	SIGN DETAIL											
		E	WIDTH (In)	HEIGHT (In)	"A"	"B"	SALV SIGN	SALV TIS	RETAIN	SALVAGE	NO. OF POSTS	FLANGED CHANNEL			SQUARE STEEL (In)			TUBULAR ALUMINUM Ø (In)			TUBULAR STEEL Ø (In)				W-SHAPE STEEL			REQUIRE	DETAIL ON DWG. NUMBER	STD. SHEET NUMBER						
												lb/ft	1.12	2.0	3.0	1.75	2.0	2.5	ANCHOR	SLEEVE	3.0	4.0	4.0 MOD		FOUND-ATION	3.0	3.5				4.0	5.0	FTG. SIZE		WEIGHT	POST SIZE
																																	24"	30"		
BRIDGEWATER: 383+60.0, LT		I	24	30	5.00					1			X		X		X													SIGN ID CODE VR-017	E-141					
385+30.0, RT		I	36	36	9.00					2			X																	SIGNS SHALL BE MOUNTED ON TWO FLANGED CHANNEL POSTS WITH A FLUORESCENT YELLOW-GREEN BACKGROUND SIGN ID CODE SI-1	E-153					
		I	24	12	2.00																									SIGN SHALL HAVE A FLUORESCENT YELLOW-GREEN BACKGROUND. SIGN ID CODE W16-7P	E-152					
385+46.0, LT		I	36	36	9.00					2			X																	SIGNS SHALL BE MOUNTED ON TWO FLANGED CHANNEL POSTS WITH A FLUORESCENT YELLOW-GREEN BACKGROUND SIGN ID CODE SI-1	E-153					
		I	24	12	2.00																									SIGN SHALL HAVE A FLUORESCENT YELLOW-GREEN BACKGROUND. SIGN ID CODE W16-7P	E-152					
388+16.0, RT		I	24	30	5.00					1			X		X		X														SIGN ID CODE VR-017	E-141				
388+34.0, RT	0040 1405 0735	I	30	30	6.25					1			X		X		X														BACK TO BACK SIGN ID CODE RI-1 SIGN ID CODE VD-700	E-143 E-138				
388+40.0, LT		I	24	30	5.00					1			X		X		X														SIGN ID CODE R2-1	E-142				
388+70.0, RT		I	24	30	5.00					1			X		X		X														SIGN ID CODE R2-1	E-142				
FINAL POST LENGTHS ARE TO BE DETERMINED IN THE FIELD. POST SIZES ARE COMPUTED BASED ON INFORMATION FURNISHED ON THE STANDARD SHEETS AND THE ROADWAY, TRAFFIC AND SAFETY SECTION'S "SIGN POST DESIGN GUIDELINE."											LF	LF	LF	LF	LF	LF	EA.	LB	LB	LB	LB	LB	LB	EA.	EA.	LB	TRAFFIC SIGN SUMMARY SHEET #5		PROJECT NAME: BRIDGEWATER_-_WOODSTOCK PROJECT NUMBER: NH_2611(1)S		FILE NAME: p06b160.dgn_ PROJECT LEADER: D.E.G. DESIGNED BY: D.W.E. IPARM FILE: p06b160tss05.i		PLOT DATE: 28-MAY-2010 DRAWN BY: C.A.K. CHECKED BY: D.E.G. SHEET 52 OF 80			
TOTALS				SF	SF	EA.	SF		LF	LF	LF	EA.	LB	EA.	EA.	LB																				
				48.67					70.0 (56.0)	70.0																										

TRAFFIC SIGN SUMMARY SHEET 6

MILEMARKER, STATION, OR SIGN NUMBER	SIGN LEGEND	SIGN DIMENSIONS		NEW & SALVAGED SIGNS				EXIST POST RETAIN	SALVAGE	NO. OF POSTS	NEW SIGN POSTS																REMARKS	SIGN DETAIL									
		E	A	WIDTH (In)	HEIGHT (In)	"A"	"B"				SALV SIGN	SALV TIS	FLANGED CHANNEL			SQUARE STEEL (In)			TUBULAR ALUMINUM Ø (In)			TUBULAR STEEL Ø (In)				W-SHAPE STEEL		REQUIRE	SIGN	REQUIRE	DETAIL ON DWG. NUMBER	STD. SHEET NUMBER					
													1.12	2.0	3.0	1.75	2.0	2.5	3.0	4.0	4.0 MOD	FOUND- ATION	3.0	3.5	4.0	5.0							FTG. SIZE	WEIGHT	POST SIZE	24"	30"

OPTION ITEMS																														
BRIDGEWATER: 389+56.0, RT		I	24	24	4.00					1			X		X		X												SIGN ID CODE R8-3A	E-143
390+38.0, LT		I	36	36	9.00					2			X															SIGNS SHALL BE MOUNTED ON TWO FLANGED CHANNEL POSTS WITH A FLUORESCENT YELLOW-GREEN BACKGROUND SIGN ID CODE SI-1	E-153	
		I	30	18	3.75																							SIGN SHALL HAVE A FLUORESCENT YELLOW-GREEN BACKGROUND. SIGN ID CODE WI6-9P	74	
WOODSTOCK: 0+00.0, RT	WOODSTOCK BRIDGEWATER	I	60	7.5	3.13					1			X		X		X													E-124
		I	6	10	0.42																								SIGN ID CODE VD-700	E-138
		I	6	10	0.42																								SIGN ID CODE VD-700	E-138
0+00.0, LT		I	24	30	5.00					1			X		X		X												SIGN ID CODE R2-1	E-142
0+00.0 RT	 	I	24	30	5.00					1			X		X		X											BACK-TO-BACK SIGN ID CODE R2-1 ERECT SALVAGED SIGN ON NEW POST.	-	
4+37.0, RT		I	24	30	5.00					1			X		X		X												SIGN ID CODE VR-017	E-141

FINAL POST LENGTHS ARE TO BE DETERMINED IN THE FIELD. POST SIZES ARE COMPUTED BASED ON INFORMATION FURNISHED ON THE STANDARD SHEETS AND THE ROADWAY, TRAFFIC AND SAFETY SECTION'S "SIGN POST DESIGN GUIDELINE."

TOTALS	SF	SF	EA.	SF		LF	LF	LF	EA.	LB	LB	LB	EA.	LB	EA.	EA.	LB
	35.72		1			70.0 (28.0)	70.0										

TRAFFIC SIGN SUMMARY SHEET #6

PROJECT NAME: BRIDGEWATER_-_WOODSTOCK
PROJECT NUMBER: NH_2611(S)_____

FILE NAME: p06b160.dgn_ PLOT DATE: 28-MAY-2010
PROJECT LEADER: D.E.G. DRAWN BY: C.A.K.
DESIGNED BY: D.W.E. CHECKED BY: D.E.G.
IPARM FILE: p06b160tss06.i SHEET 53 OF 80

TRAFFIC SIGN SUMMARY SHEET 8

MILEMARKER, STATION, OR SIGN NUMBER	SIGN LEGEND	SIGN DIMENSIONS		NEW & SALVAGED SIGNS				EXIST POST	NO. OF POSTS	NEW SIGN POSTS																REMARKS	SIGN DETAIL	
				"A"	"B"	SALV SIGN	SALV TIS			FLANGED CHANNEL				SQUARE STEEL (in)			TUBULAR ALUMINUM Ø (in)			TUBULAR STEEL Ø (in)				W-SHAPE STEEL			DETAIL ON DWG. NUMBER	STD. SHEET NUMBER
		lb/ft								1.75	2.0	2.5	3.0	4.0	4.0 MOD	FOUND-ATION	3.0	3.5	4.0	5.0	FTG. SIZE		WEIGHT	POST SIZE				
		1.12	2.0	3.0	1.88	2.16	3.35			1.3	1.7	1.7	7.6	9.0	10.8		14.6	24"	30"									

OPTION ITEMS																														
WOODSTOCK: 16+89.6, RT		I	24	30	5.00					I			X		X		X											SIGN ID CODE R2-1		E-142
		I	30	30	6.25																							SIGN ID CODE VR-417		E-141
16+89.6, LT		I	24	30	5.00					I			X		X		X											SIGN ID CODE R2-1		E-142
21+12.0, RT		I	6	10	0.42					I	X			X			X											SIGN ID CODE VD-700		E-138
22+44.0, LT		I	24	30	5.00					I			X		X		X											SIGN ID CODE R4-1		E-141
22+44.0, RT		I	48	36	5.56					2			X															SIGN SHALL BE MOUNTED ON TWO FLANGED CHANNEL POSTS. SIGN ID CODE W14-3		E-152
24+49.0, LT		I	36	36	9.00					2			X															SIGN SHALL BE MOUNTED ON TWO FLANGED CHANNEL POSTS. SIGN ID CODE W3-5	74	
29+83.2, RT		I	24	30	5.00					I			X		X		X											SIGN ID CODE R4-1		E-141

FINAL POST LENGTHS ARE TO BE DETERMINED IN THE FIELD. POST SIZES ARE COMPUTED BASED ON INFORMATION FURNISHED ON THE STANDARD SHEETS AND THE ROADWAY, TRAFFIC AND SAFETY SECTION'S "SIGN POST DESIGN GUIDELINE."









TOTALS	SF	SF	EA.	SF		LF	LF	LF	EA.	LB	LB	LB	EA.	LB	EA.	EA.	LB
	41.23					14.0	56.0 (56.0)	14.0	56.0								


TRAFFIC SIGN SUMMARY SHEET #8

PROJECT NAME: BRIDGEWATER_-_WOODSTOCK
 PROJECT NUMBER: NH_2611(1)S
 FILE NAME: p06b160.dgn_ PLOT DATE: 28-MAY-2010
 PROJECT LEADER: D.E.G. DRAWN BY: C.A.K.
 DESIGNED BY: D.W.E. CHECKED BY: D.E.G.
 IPARM FILE: p06b160tss08.i SHEET 55 OF 80

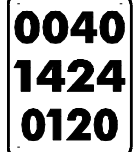TRAFFIC SIGN SUMMARY SHEET 11

MILEMARKER, STATION, OR SIGN NUMBER	SIGN LEGEND	SIGN DIMENSIONS		NEW & SALVAGED SIGNS				EXIST POST RETAIN SALVAGE	NO. OF POSTS	NEW SIGN POSTS																REMARKS	SIGN DETAIL			
		E A	WIDTH (In)	HEIGHT (In)	"A"	"B"	SALV SIGN			SALV TIS	FLANGED CHANNEL				SQUARE STEEL (In)				TUBULAR ALUMINUM Ø (In)			TUBULAR STEEL Ø (In)					W-SHAPE STEEL		DETAIL ON DWG. NUMBER	STD. SHEET NUMBER
											lb/ft		lb/ft		3.0	4.0	4.0 MOD	FOUND- ATION	3.0	3.5	4.0	5.0	FTG. SIZE	WEIGHT	POST SIZE					
											1.12	2.0	3.0	1.88													2.16	3.35		

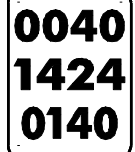OPTION ITEMS																											
WOODSTOCK: 61+35.4, RT	 	I	48	36	5.56					2		X														SIGNS SHALL BE MOUNTED ON TWO FLANGED CHANNEL POSTS, BACK-TO-BACK SIGN ID CODE W14-3 SIGN ID CODE R4-1	E-152 E-141
63+36.0, RT		I	6	10	0.42					I	X		X			X										SIGN ID CODE VD-700	E-138
68+11.2, LT		I	30	30	6.25					I		X		X		X										SIGN ID CODE VR-417	E-141
72+49.0, RT	 	I	24	24	4.00					I		X		X		X										BACK-TO-BACK SIGN ID CODE VR-654 SIGN ID CODE VR-654	E-143 E-143
73+39.2, RT		I	30	30	6.25					I		X		X		X										SIGN ID CODE VR-417	E-141
73+92.0, LT		I	6	10	0.42					I	X		X			X										SIGN ID CODE VD-700	E-138

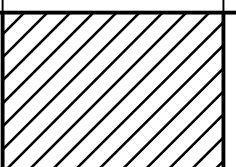FINAL POST LENGTHS ARE TO BE DETERMINED IN THE FIELD. POST SIZES ARE COMPUTED BASED ON INFORMATION FURNISHED ON THE STANDARD SHEETS AND THE ROADWAY, TRAFFIC AND SAFETY SECTION'S "SIGN POST DESIGN GUIDELINE."	TOTALS	SF	SF	EA.	SF		LF 28.0	LF 28.0	LF 42.0 (28.0)	LF 28.0	LF 42.0	LF 42.0	EA.	LB	LB	LB	EA.	LB	LB	LB	EA.	EA.	LB
		31.90					LF 70.0 (28.0)		LF 70.0		LB				LB								

TRAFFIC SIGN SUMMARY SHEET #11

PROJECT NAME: BRIDGEWATER_-_WOODSTOCK
PROJECT NUMBER: NH_2611(1)S
FILE NAME: p06b160.dgn_ PLOT DATE: 28-MAY-2010
PROJECT LEADER: D.E.G. DRAWN BY: C.A.K.
DESIGNED BY: D.W.E. CHECKED BY: D.E.G.
IPARM FILE: p06b160tss11.i SHEET 58 OF 80

TRAFFIC SIGN SUMMARY SHEET 12

MILEMARKER, STATION, OR SIGN NUMBER	SIGN LEGEND	SIGN DIMENSIONS		NEW & SALVAGED SIGNS				EXIST POST RETAIN SALVAGE	NO. OF POSTS	NEW SIGN POSTS																REMARKS	SIGN DETAIL	
				"A"	"B"	SALV SIGN	SALV TIS			FLANGED CHANNEL			SQUARE STEEL (In)			TUBULAR ALUMINUM (In)			TUBULAR STEEL (In)				W-SHAPE STEEL				DETAIL ON DWG. NUMBER	STD. SHEET NUMBER
		lb/ft	1.75							2.0	2.5	3.0	1.75	2.0	2.5	3.0	4.0	4.0 MOD	FOUND-ATION	3.0	3.5	4.0	5.0	FTG. SIZE				
				1.12	2.0	3.0	1.88																	2.16	3.35		1.3	1.7

OPTION ITEMS																											
WOODSTOCK: 81+84.0, RT			48	36	5.56					2		X														SIGN SHALL BE MOUNTED ON TWO FLANGED CHANNEL POSTS, BACK TO BACK SIGN ID CODE W14-3 SIGN ID CODE R4-1	E-152 E-141
81+84.0, LT			48	36	5.56					2		X														SIGN SHALL BE MOUNTED ON TWO FLANGED CHANNEL POSTS, BACK TO BACK SIGN ID CODE W14-3 SIGN ID CODE R4-1	E-152 E-141
84+48.0, RT			6	10	0.42					1	X		X			X										SIGN ID CODE VD-700	E-138
92+40.0, LT			30	30	6.25					1		X	X			X										SIGN ID CODE VR-417	E-141
95+04.0, LT			6	10	0.42					1	X		X			X										SIGN ID CODE VD-700	E-138
105+34.0, RT			24	18	3.00					1		X	X			X										SIGN ID CODE D11-1	E-131B
			12	9	0.75																					SIGN ID CODE M7-1	E-131B
106+25.0, RT			24	30	5.00					1		X	X			X										SIGN ID CODE VR-017	E-141

FINAL POST LENGTHS ARE TO BE DETERMINED IN THE FIELD. POST SIZES ARE COMPUTED BASED ON INFORMATION FURNISHED ON THE STANDARD SHEETS AND THE ROADWAY, TRAFFIC AND SAFETY SECTION'S "SIGN POST DESIGN GUIDELINE."

TOTALS	SF	SF	EA.	SF		LF	LF	LF	EA.	LB	LB	LB	EA.	LB	EA.	EA.	LB
	36.96					28.0	42.0 (56.0)	28.0	42.0								

TRAFFIC SIGN SUMMARY SHEET #12

PROJECT NAME: BRIDGEWATER_-_WOODSTOCK
 PROJECT NUMBER: NH_2611(1)S
 FILE NAME: p06b160.dgn_
 PROJECT LEADER: D.E.G.
 DESIGNED BY: D.W.E.
 IPARM FILE: p06b160tss12.i
 PLOT DATE: 28-MAY-2010
 DRAWN BY: C.A.K.
 CHECKED BY: D.E.G.
 SHEET 59 OF 80

TRAFFIC SIGN SUMMARY SHEET 14

MILEMARKER, STATION, OR SIGN NUMBER	SIGN LEGEND	SIGN DIMENSIONS		NEW & SALVAGED SIGNS				EXIST POST		NEW SIGN POSTS																REMARKS	SIGN DETAIL						
		E A	WIDTH (In)	HEIGHT (In)	"A"	"B"	SALV SIGN	SALV TIS	RE TAIN	SAL VAGE	NO. OF POSTS	FLANGED CHANNEL			SQUARE STEEL (In)				TUBULAR ALUMINUM Ø (In)			TUBULAR STEEL Ø (In)					W-SHAPE STEEL			RE QUIRE D	DETAIL ON DWG. NUMBER	STD. SHEET NUMBER	
												lb/ft			1.75	2.0	2.5	3.0	4.0	4.0 MOD	FOUND- ATION	3.0	3.5	4.0	5.0		FTG. SIZE		WEIGHT				POST SIZE
												1.12	2.0	3.0	1.88	2.16	3.35	1.3	1.7	1.7		lb/ft					24"	30"					

OPTION ITEMS																												
WOODSTOCK: 126+72.0, LT		I	6	10	0.42					I	X		X		X											SIGN ID CODE VD-700	E-138	
131+17.0, LT		I	30	30	6.25					I		X		X	X											SIGN ID CODE WI-2R	E-151	
		I	18	18	2.25																					SIGN ID CODE WI3-I	E-155	
135+00.0, RT		I	30	30	6.25					I		X		X	X											SIGN ID CODE WI-2R	E-151	
		I	18	18	2.25																					SIGN ID CODE WI3-I	E-155	
137+28.0, RT		I	6	10	0.42					I	X		X		X											SIGN ID CODE VD-700	E-138	
141+85.0, LT										I		X		X	X											SALVAGED SIGNS TO BE MOUNTED ON NEW POST. TOP MOUNTING BRACKET REQUIRED TO INSTALL SALVAGED SIGNS ON NEW POST. COSTS ASSOCIATED WITH THIS BRACKET ARE INCIDENTAL TO THE SIGN POST.	-	-
		I	30	30	6.25																					BACK TO BACK SIGN ID CODE RI-1 SIGN ID CODE VD-700	E-143 E-138	
		I	6	10	0.42																							
142+15.0, LT		I	24	30	5.00					I		X		X	X											SIGN ID CODE VR-017	E-141	

<p>FINAL POST LENGTHS ARE TO BE DETERMINED IN THE FIELD. POST SIZES ARE COMPUTED BASED ON INFORMATION FURNISHED ON THE STANDARD SHEETS AND THE ROADWAY, TRAFFIC AND SAFETY SECTION'S "SIGN POST DESIGN GUIDELINE."</p>	LF 28.0		LF 56.0		LF 28.0		LF 56.0		EA.	LB			LB				EA.			EA.			LB			<p>TRAFFIC SIGN SUMMARY SHEET #14</p>	PROJECT NAME: BRIDGEWATER_-_WOODSTOCK		PROJECT NUMBER: NH_2611(S)_____		FILE NAME: p06b160.dgn_		PLOT DATE: 28-MAY-2010	
	TOTALS	SF 29.51	SF	EA. 2	SF	LF 84.0	LF 84.0	EA.	LB			EA.				EA.			LB			DRAWN BY: C.A.K.		CHECKED BY: D.E.G.			SHEET 61 OF 80							

TRAFFIC SIGN SUMMARY SHEET 15

MILEMARKER, STATION, OR SIGN NUMBER	SIGN LEGEND	SIGN DIMENSIONS		NEW & SALVAGED SIGNS				EXIST POST	NO. OF POSTS	NEW SIGN POSTS																REMARKS	SIGN DETAIL											
		E A	WIDTH (In)	HEIGHT (In)	"A"	"B"	SALV SIGN			SALV TIS	RETAIN	SALVAGE	FLANGED CHANNEL			SQUARE STEEL (In)			TUBULAR ALUMINUM Ø (In)			TUBULAR STEEL Ø (In)					W-SHAPE STEEL			REQUIRE	DETAIL ON DWG. NUMBER	STD. SHEET NUMBER						
													lb/ft	1.75	2.0	2.5	3.0	1.88	2.16	3.35	ANCHOR	SLEEVE	3.0	4.0	4.0 MOD		FOUND-ATION	3.0	3.5				4.0	5.0	FTG. SIZE		WEIGHT	POST SIZE
																																			1.12	2.0		

OPTION ITEMS																														
WOODSTOCK: 146+50.0, LT		I	30	30	6.25										I			X		X		X							SIGN ID CODE WI-2L	E-151
		I	18	18	2.25																								SIGN ID CODE WI3-1	E-155
147+84.0, LT		I	6	10	0.42										I	X			X		X								SIGN ID CODE VD-700	E-138
158+40.0, RT		I	6	10	0.42										I	X			X		X								SIGN ID CODE VD-700	E-138
158+82.0, RT		I	30	30	6.25										I			X		X		X							SIGN ID CODE VW-133	E-154
160+07.0, RT		I	30	30	6.25										I			X		X		X							SIGN ID CODE WI-10L	73
		I	18	18	2.25																								SIGN ID CODE WI3-1	E-155
164+10.0, RT		I	30	30	6.25										I			X		X		X							SIGN ID CODE W5-3	73
164+25.0, LT		I	30	30	6.25										I			X		X		X							SIGN ID CODE RI-1	E-143

FINAL POST LENGTHS ARE TO BE DETERMINED IN THE FIELD. POST SIZES ARE COMPUTED BASED ON INFORMATION FURNISHED ON THE STANDARD SHEETS AND THE ROADWAY, TRAFFIC AND SAFETY SECTION'S "SIGN POST DESIGN GUIDELINE."


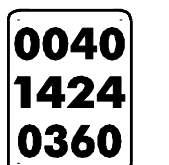






TOTALS	SF	SF	EA.	SF		LF	LF	LF	LF	LF	EA.	LB	LB	LB	EA.	LB	EA.	EA.	LB
	36.59					98.0	70.0	28.0	70.0										

TRAFFIC SIGN SUMMARY SHEET #15

PROJECT NAME: BRIDGEWATER_-_WOODSTOCK
 PROJECT NUMBER: NH_26!!(1)S
 FILE NAME: p06b160.dgn_
 PROJECT LEADER: D.E.G.
 DESIGNED BY: D.W.E.
 IPARM FILE: p06b160tss15.i
 PLOT DATE: 28-MAY-2010
 DRAWN BY: C.A.K.
 CHECKED BY: D.E.G.
 SHEET 62 OF 80

TRAFFIC SIGN SUMMARY SHEET 18

MILEMARKER, STATION, OR SIGN NUMBER	SIGN LEGEND	SIGN DIMENSIONS		NEW & SALVAGED SIGNS				EXIST POST		NEW SIGN POSTS																REMARKS	SIGN DETAIL	
				"A"	"B"	SALV SIGN	SALV TIS	REMAIN	SALVAGE	NO. OF POSTS	FLANGED CHANNEL			SQUARE STEEL (In)			TUBULAR ALUMINUM Ø (In)			TUBULAR STEEL Ø (In)				W-SHAPE STEEL			DETAIL ON DWG. NUMBER	STD. SHEET NUMBER
		lb/ft									1.75	2.0	2.5	3.0	4.0	4.0 MOD	FOUND-ATION	3.0	3.5	4.0	5.0	FTG. SIZE		WEIGHT	POST SIZE			
		1.12	2.0	3.0	1.88	2.16	3.35	1.3	1.7	1.7	7.6	9.0	10.8	14.6	24"	30"												

OPTION ITEMS																																			
WOODSTOCK: 184+45.0, LT		I	30	30	6.25						1			X		X		X																SIGN ID CODE W2-2M	E-155
190+08.0, LT		I	6	10	0.42						1	X			X			X															SIGN ID CODE VD-700	E-138	
190+59.0, LT		I	36	36	9.00						2			X																			SIGN TO BE MOUNTED ON TWO FLANGED CHANNEL POSTS. SIGN ID CODE VW-205	E-154	
200+64.0, RT		I	6	10	0.42						1	X			X			X															SIGN ID CODE VD-700	E-138	
203+08.0, RT		I	36	36	9.00						2			X																			SIGN TO BE MOUNTED ON TWO FLANGED CHANNEL POSTS. SIGN ID CODE W3-5	74	
210+14.4, RT		I	24	30	5.00						1			X		X		X															SIGN ID CODE R2-1	E-142	
210+14.4, LT		I	24	30	5.00						1			X		X		X															SIGN ID CODE R2-1	E-142	
211+20.0, LT		I	6	10	0.42						1	X			X			X															SIGN ID CODE VD-700	E-138	

<p>FINAL POST LENGTHS ARE TO BE DETERMINED IN THE FIELD. POST SIZES ARE COMPUTED BASED ON INFORMATION FURNISHED ON THE STANDARD SHEETS AND THE ROADWAY, TRAFFIC AND SAFETY SECTION'S "SIGN POST DESIGN GUIDELINE."</p>	LF 42.0		LF 42.0 (56.0)		LF 42.0		LF 42.0		EA.	LB LB LB			LB LB LB LB				EA. EA. LB			<p>TRAFFIC SIGN SUMMARY SHEET #18</p>	<p>PROJECT NAME: BRIDGEWATER_-_WOODSTOCK PROJECT NUMBER: NH_2611(S)_____</p>	
	TOTALS	SF 35.51	SF	EA.	SF	LF 84.0 (56.0)	LF 84.0				LB			EA. EA. LB				<p>FILE NAME: p06b160.dgn_ PLOT DATE: 28-MAY-2010 PROJECT LEADER: D.E.G. DRAWN BY: C.A.K. DESIGNED BY: D.W.E. CHECKED BY: D.E.G. IPARM FILE: p06b160tss18.i SHEET 65 OF 80</p>				

TRAFFIC SIGN SUMMARY SHEET 19

MILEMARKER, STATION, OR SIGN NUMBER	SIGN LEGEND	SIGN DIMENSIONS		NEW & SALVAGED SIGNS				EXIST POST RETAIN SALVAGE	NO. OF POSTS	NEW SIGN POSTS																REMARKS	SIGN DETAIL							
		E A	WIDTH (In)	HEIGHT (In)	"A"	"B"	SALV SIGN			SALV TIS	FLANGED CHANNEL			SQUARE STEEL (In)			TUBULAR ALUMINUM Ø (In)			TUBULAR STEEL Ø (In)				W-SHAPE STEEL			REQUIRE SIGNED	DETAIL ON DWG. NUMBER	STD. SHEET NUMBER					
											lb/ft	1.75	2.0	2.5	3.0	1.75	2.0	2.5	3.0	4.0	4.0 MOD	FOUND- ATION	3.0	3.5	4.0					5.0	FTG. SIZE		WEIGHT	POST SIZE
																															1.12	2.0		


OPTION ITEMS																														
WOODSTOCK: 214+92.0, LT							2			I			X		X		X											SALVAGED SIGNS TO BE MOUNTED ON NEW POST. TOP MOUNTING BRACKET REQUIRED TO INSTALL SALVAGED SIGNS ON NEW POST. COSTS ASSOCIATED WITH THIS BRACKET ARE INCIDENTAL TO THE SIGN POST.	-	-
		I	30	30	6.25																							BACK TO BACK SIGN ID CODE RI-1 SIGN ID CODE VD-700		E-143 E-138
215+30.0, LT		I	24	30	5.00					I			X		X		X											SIGN ID CODE VR-017		E-141
221+76.0, RT		I	6	10	0.42					I	X			X			X											SIGN ID CODE VD-700		E-138
224+11.0, RT		I	30	30	6.25					I			X		X		X											SIGN ID CODE W2-2L		E-155
226+82.0, LT		I	24	24	4.00					I			X		X		X											SIGN ID CODE R8-3A		E-143
		I	24	12	2.00																							SIGN ID CODE M4-6		E-140
229+00.0, LT		I	24	30	5.00					I			X		X		X											SIGN ID CODE R2-1		E-142
		I	24	24	4.00																							SIGN ID CODE R8-3A		E-143

FINAL POST LENGTHS ARE TO BE DETERMINED IN THE FIELD. POST SIZES ARE COMPUTED BASED ON INFORMATION FURNISHED ON THE STANDARD SHEETS AND THE ROADWAY, TRAFFIC AND SAFETY SECTION'S "SIGN POST DESIGN GUIDELINE."										LF	LF	LF	LF	LF	LF	EA.	LB	LB	LB	LB	LB	LB	EA.	EA.	LB					
										14.0	70.0	14.0	70.0																	
TOTALS										SF	SF	EA.	SF		LF	LF	LB	EA.	LB	EA.	EA.	LB								
										33.34		2			84.0	84.0														

TRAFFIC SIGN SUMMARY SHEET #19

PROJECT NAME: BRIDGEWATER_-_WOODSTOCK
PROJECT NUMBER: NH_2611(S)_____


FILE NAME: p06b160.dgn_ PLOT DATE: 28-MAY-2010
PROJECT LEADER: D.E.G. DRAWN BY: C.A.K.
DESIGNED BY: D.W.E. CHECKED BY: D.E.G.
IPARM FILE: p06b160tss19.i SHEET 66 OF 80

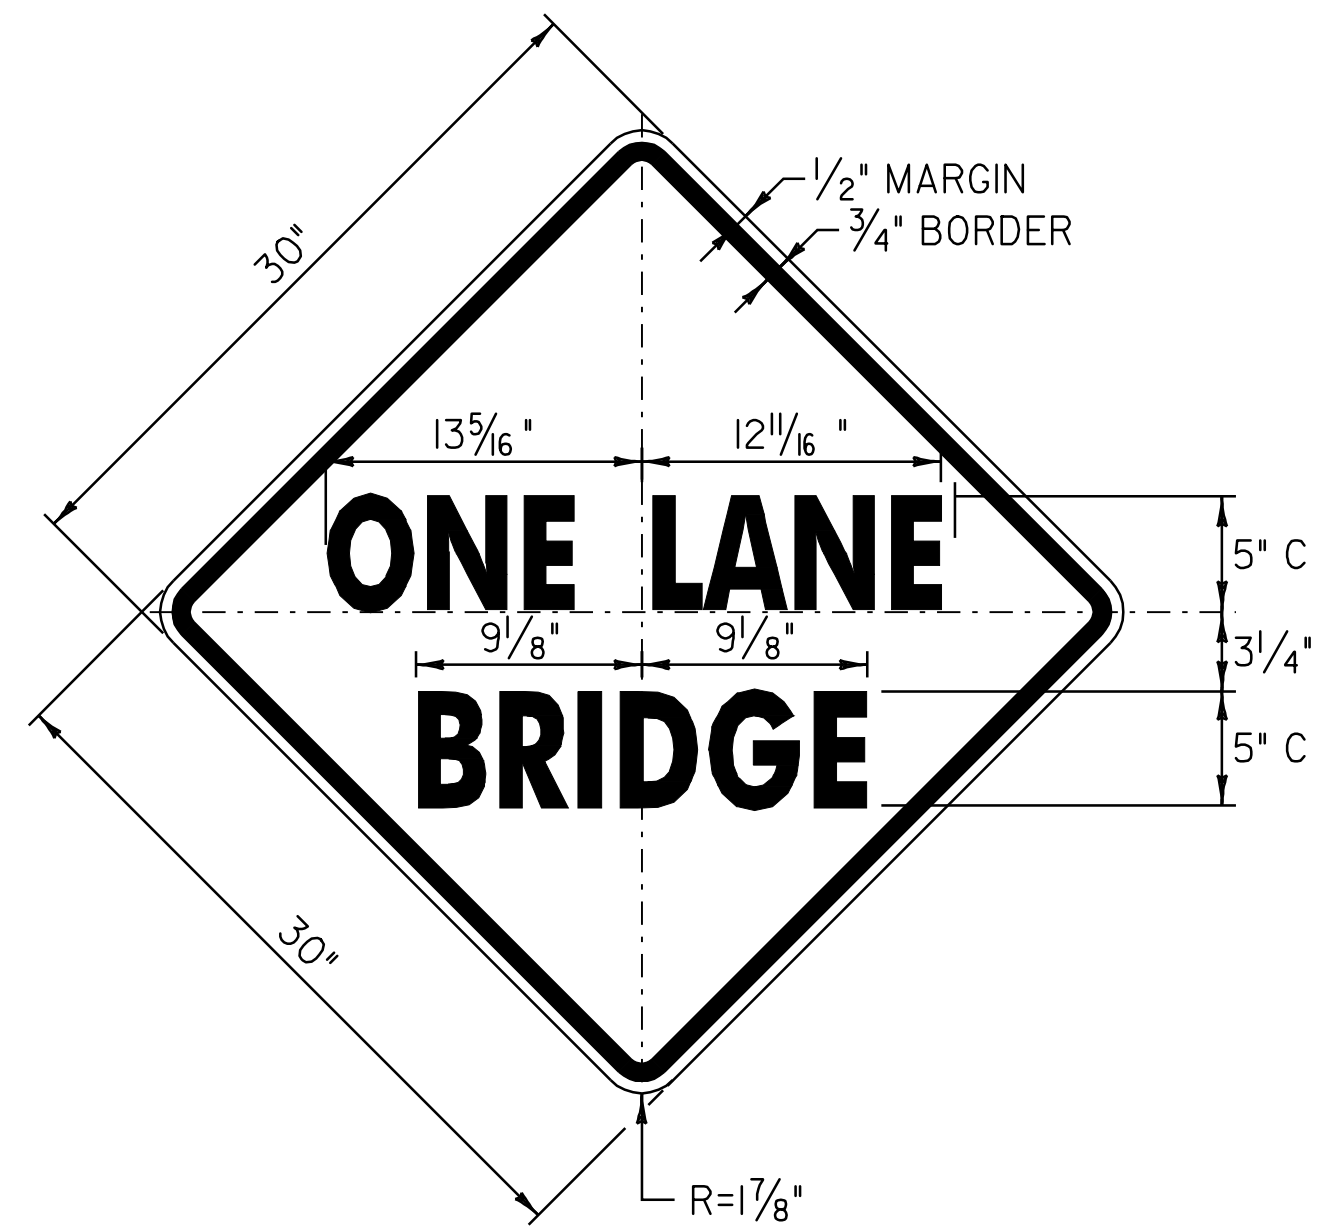

COLOR: BLACK BORDER & TEXT (REFLECTORIZED)
YELLOW BACKGROUND (REFLECTORIZED)

MATERIAL: PER VAOT STANDARD E-151


LOCATION: U.S. ROUTE 4
WOODSTOCK:
STA. 164+10.0, RT

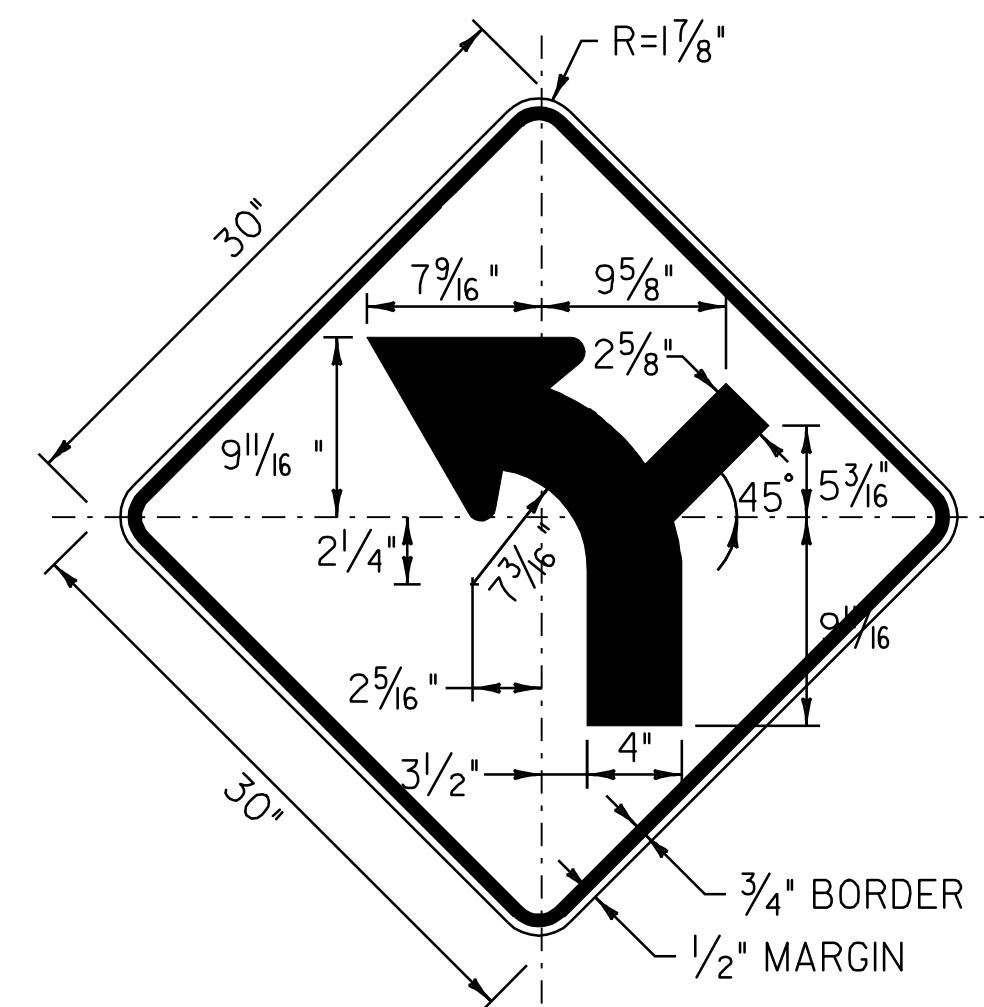

COLOR: BLACK BORDER & LEGEND (REFLECTORIZED)
YELLOW BACKGROUND (REFLECTORIZED)

MATERIAL: PER VAOT STANDARD E-151


LOCATION: U.S. ROUTE 4
WOODSTOCK:
STA. 160+07.0, RT

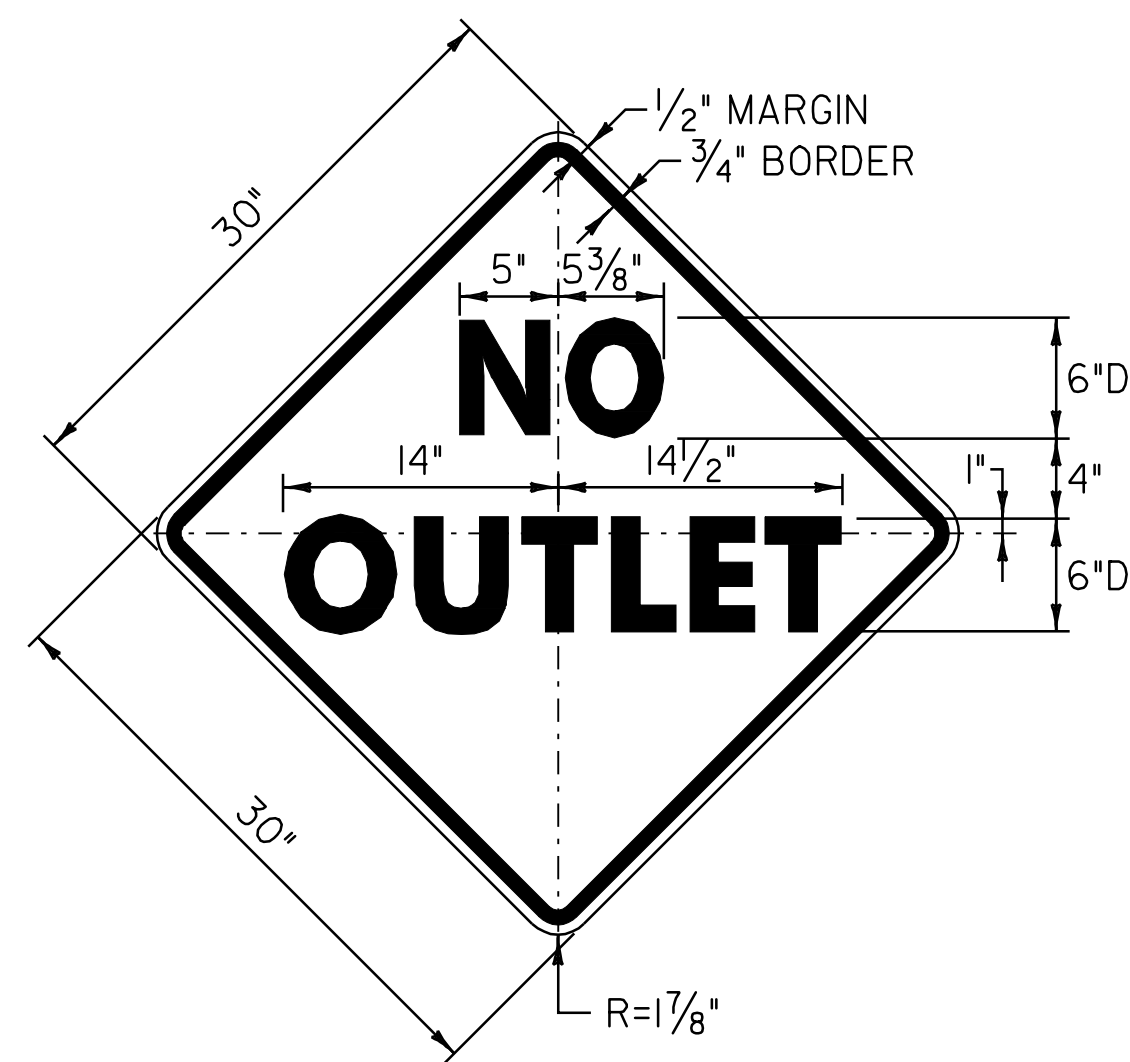

COLOR: BLACK BORDER & TEXT (REFLECTORIZED)
YELLOW BACKGROUND (REFLECTORIZED)

MATERIAL: PER VAOT STANDARD E-151

LOCATION: U.S. ROUTE 4
WOODSTOCK:
STA. 239+40.0, LT

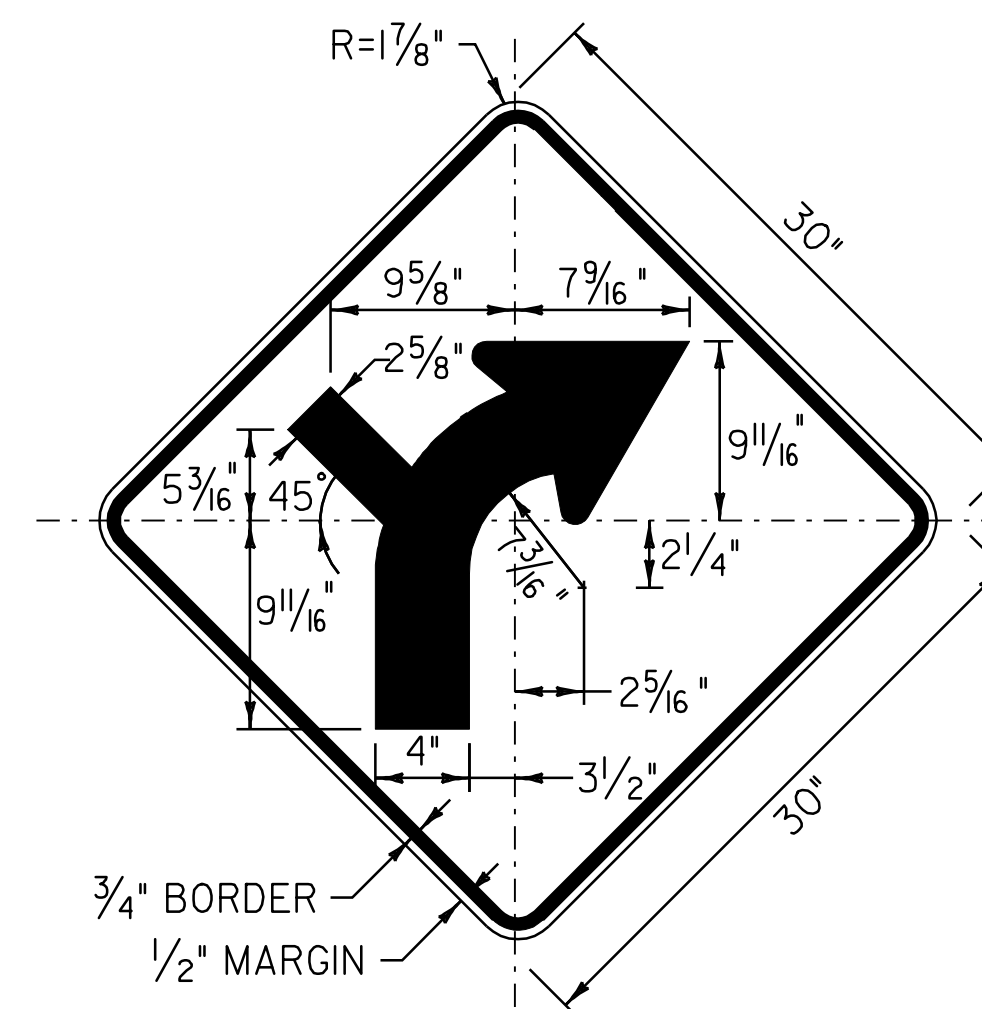

COLOR: BLACK BORDER & LEGEND (REFLECTORIZED)
YELLOW BACKGROUND (REFLECTORIZED)

MATERIAL: PER VAOT STANDARD E-151

LOCATION: U.S. ROUTE 4
WOODSTOCK:
STA. 173+20.0, LT


NOTE:
TEXT LAYOUT DIMENSIONS ARE BASED ON THE STANDARD ALPHABETS SPACING CHARTS FOUND IN THE "STANDARD HIGHWAY SIGNS" BOOK PUBLISHED BY FHWA. MINOR VARIATIONS IN TEXT DIMENSIONS ARE ACCEPTABLE BASED ON INDIVIDUAL MANUFACTURER'S LETTER FABRICATION. SIGNIFICANT CHANGES THAT AFFECT SIGN APPEARANCE SHALL BE BROUGHT TO THE ATTENTION OF THE VAOT'S TRAFFIC OPERATIONS UNIT BEFORE FABRICATION.

NOT TO SCALE

**TRAFFIC SIGN
DETAIL
SHEET #1**

PROJECT NAME: BRIDGEWATER_-_WOODSTOCK
PROJECT NUMBER: NH_2611(1)S_-----


FILE NAME: p06b160.dgn_ PLOT DATE: 28-MAY-2010
PROJECT LEADER: D.E.G. DRAWN BY: C.A.K.
DESIGNED BY: D.W.E. CHECKED BY: D.E.G.
IPARM FILE: p06b160tsd01.i_ SHEET 73 OF 80

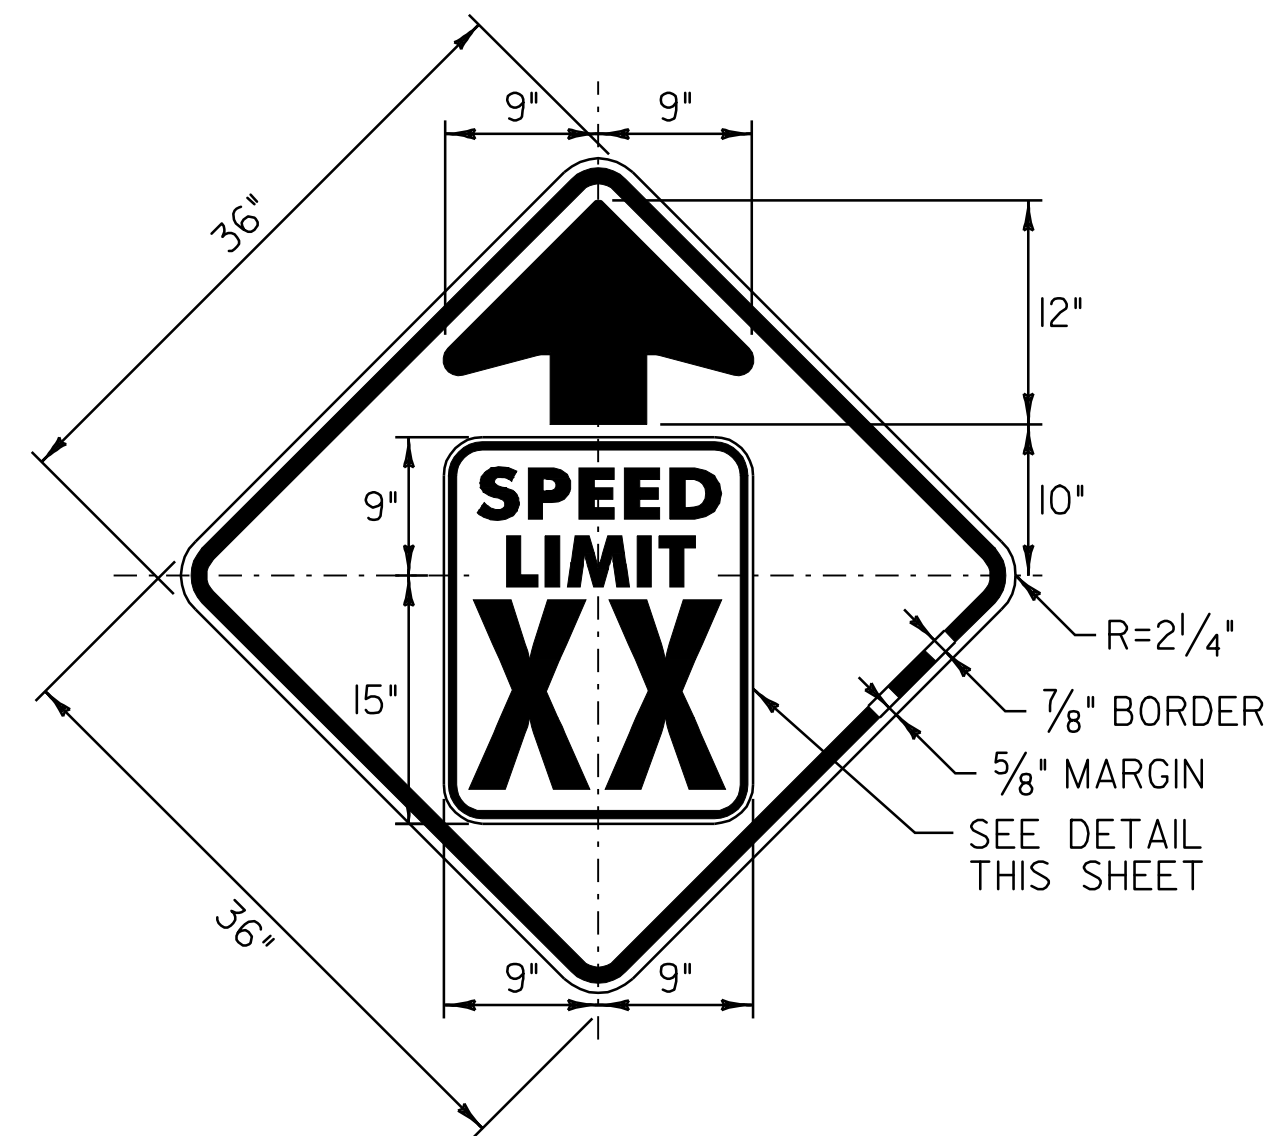


COLOR: BLACK BORDER & LEGEND (REFLECTORIZED)
YELLOW BACKGROUND (REFLECTORIZED)

MATERIAL: PER VAOT STANDARD E-151


LOCATIONS: U.S. ROUTE 4
BRIDGEWATER
STA. 374+89.0, RT
WOODSTOCK
STA. 5+08.0, LT
STA. 24+49.0, LT
STA. 203+08.0, RT
STA. 290+26.0, RT

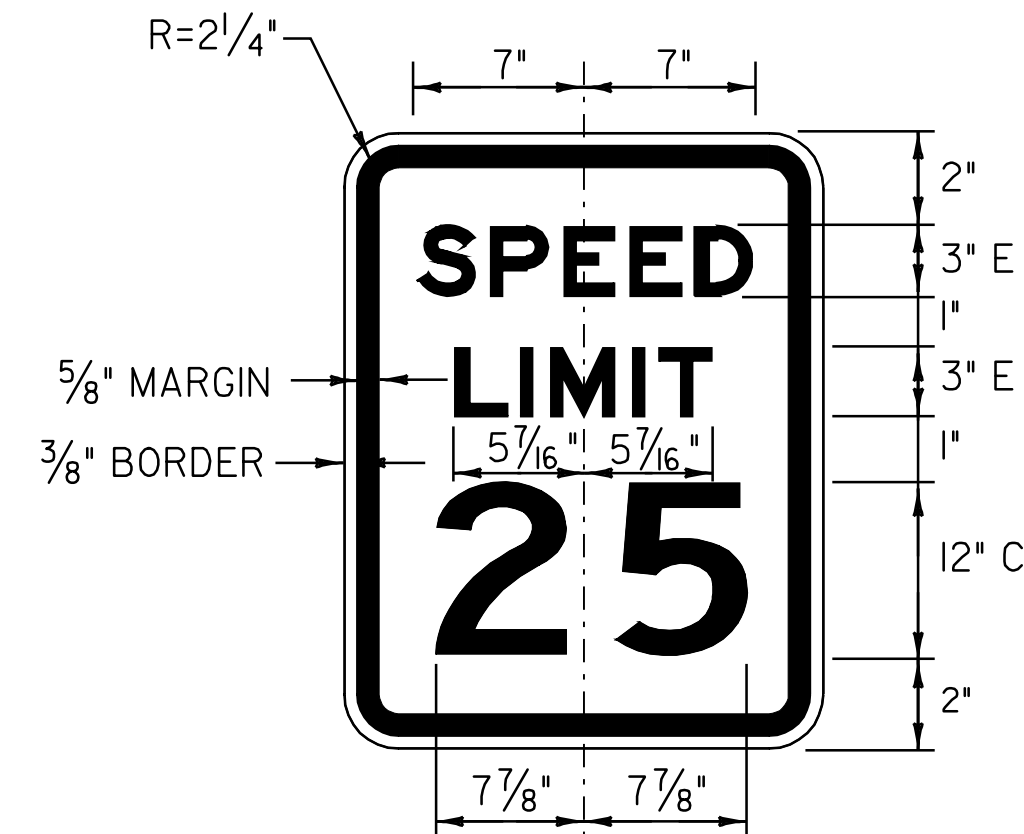

COLOR: BLACK BORDER & TEXT (REFLECTORIZED)
WHITE BACKGROUND (REFLECTORIZED)

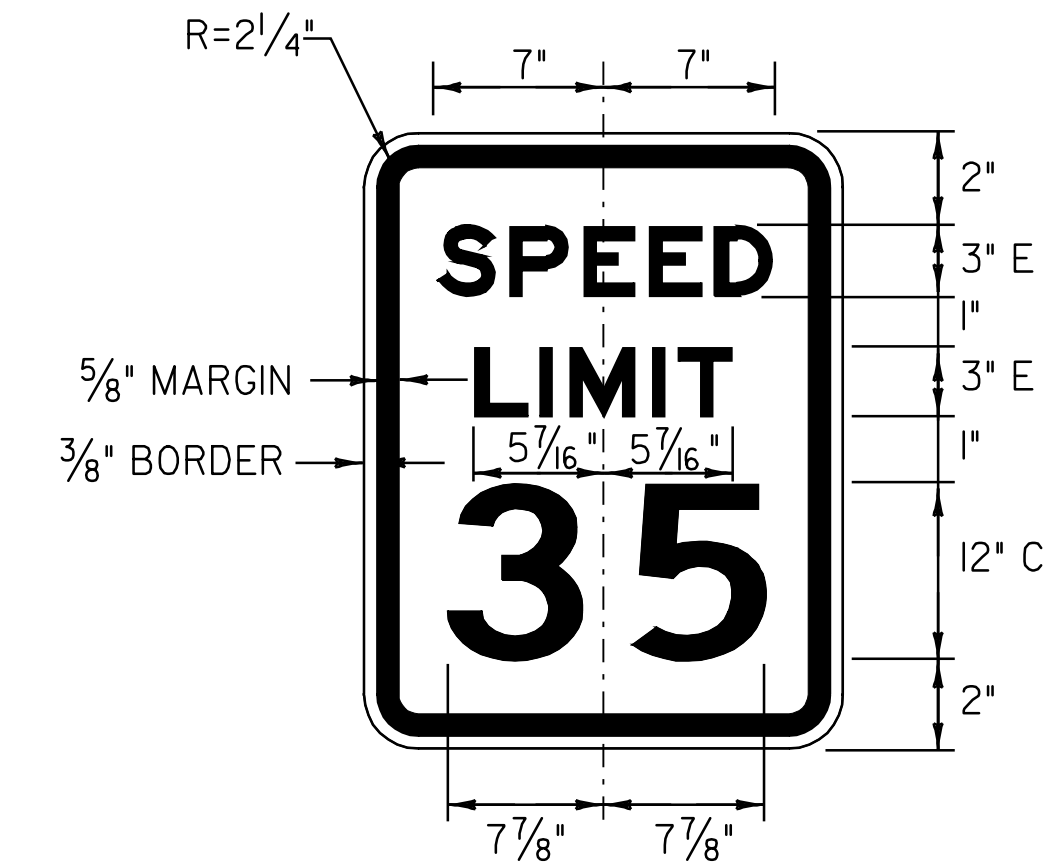

COLOR: BLACK BORDER & TEXT (REFLECTORIZED)
WHITE BACKGROUND (REFLECTORIZED)

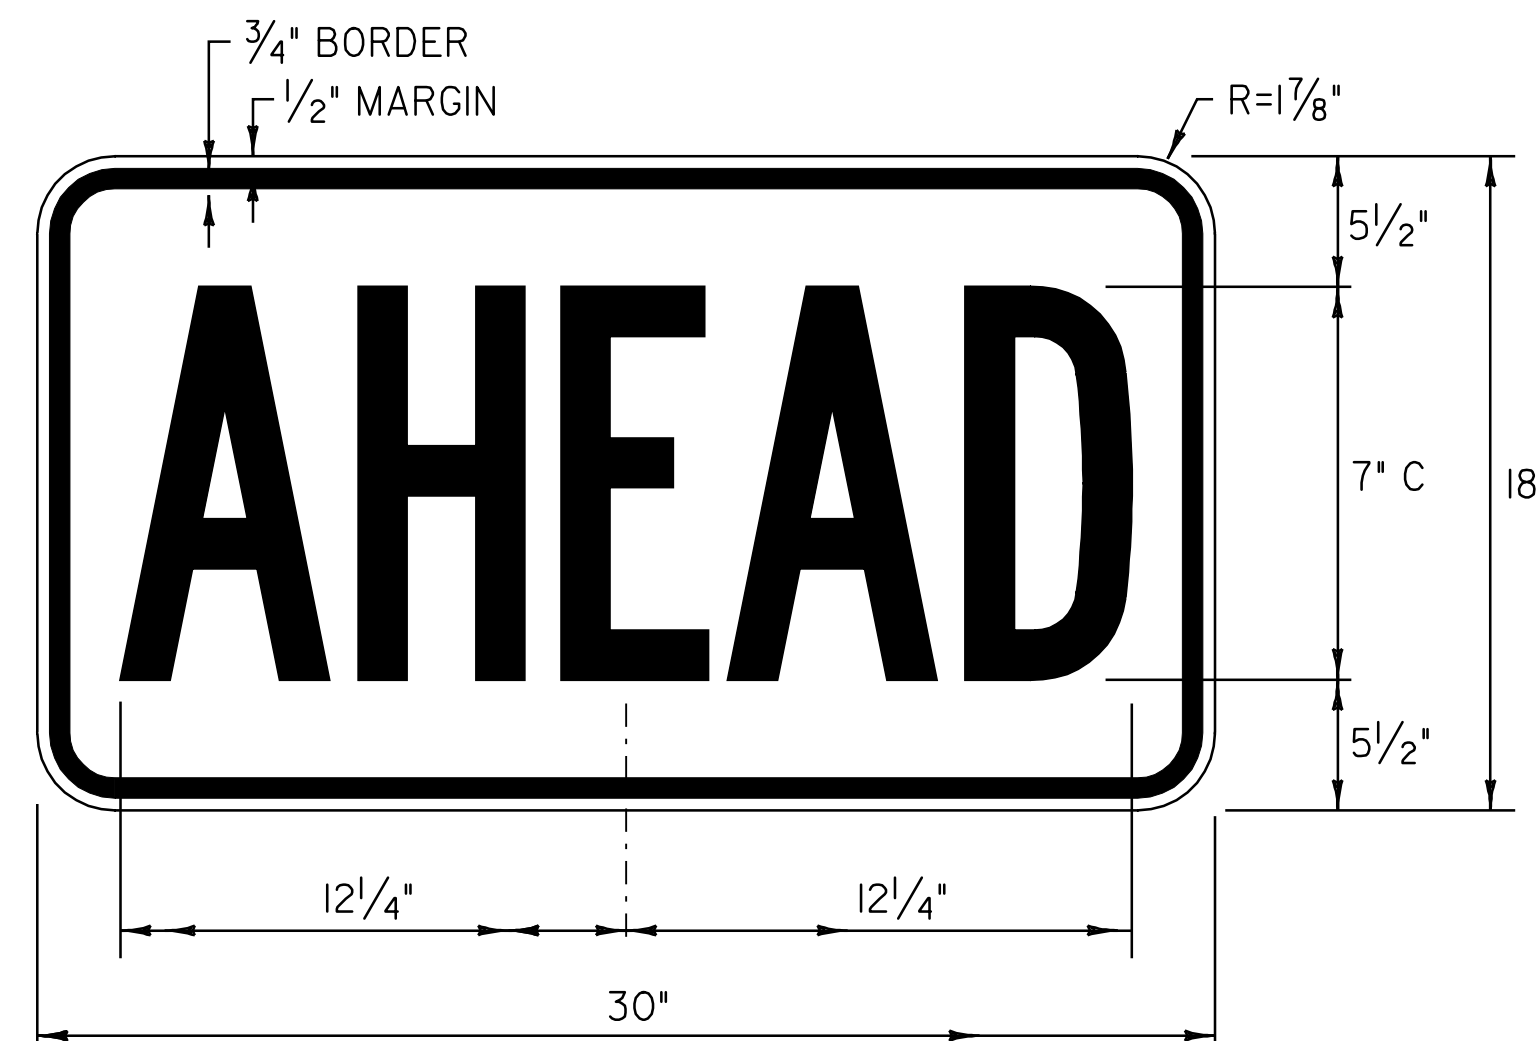

COLOR: BLACK BORDER & TEXT (REFLECTORIZED)
FLUORESCENT YELLOW-GREEN BACKGROUND (REFLECTORIZED)

MATERIAL: PER VAOT STANDARD E-153

LOCATIONS: U.S. ROUTE 4
BRIDGEWATER
STA. 383+30.0, RT
STA. 390+38.0, LT
WOODSTOCK
STA. 235+20.0, RT
STA. 250+14.0, LT

NOTE:
TEXT LAYOUT DIMENSIONS ARE BASED ON THE STANDARD ALPHABETS SPACING CHARTS FOUND IN THE "STANDARD HIGHWAY SIGNS" BOOK PUBLISHED BY FHWA. MINOR VARIATIONS IN TEXT DIMENSIONS ARE ACCEPTABLE BASED ON INDIVIDUAL MANUFACTURER'S LETTER FABRICATION. SIGNIFICANT CHANGES THAT AFFECT SIGN APPEARANCE SHALL BE BROUGHT TO THE ATTENTION OF THE VAOT'S TRAFFIC OPERATIONS UNIT BEFORE FABRICATION.

NOT TO SCALE

**TRAFFIC SIGN
DETAIL
SHEET #2**

PROJECT NAME: BRIDGEWATER_-_WOODSTOCK
PROJECT NUMBER: NH_26!!(1)S


FILE NAME: p06b160.dgn_ PLOT DATE: 28-MAY-2010
PROJECT LEADER: D.E.G. DRAWN BY: C.A.K.
DESIGNED BY: D.W.E. CHECKED BY: D.E.G.
IPARM FILE: p06b160tsd02.i... SHEET 74 OF 80

BRIDGE QUANTITY SHEET

STATION	POS.	BRIDGE NUMBER	OFFSET BLOCK	525.10	525.60	REMARKS
BRIDGEWATER:						
361+95.8 - 362+27.1	RT	46	8"	31.3	31.3	
361+98.8 - 362+30.1	LT	46	8"	31.3	31.3	
WOODSTOCK:						
62+75.8 - 63+00.8	LT	47	8"	25	25	
62+77.8 - 63+02.8	RT	47	8"	25	25	
176+38.0 - 176+63.0	LT	48	8"	25	25	
176+38.0 - 176+63.0	RT	48	8"	25	25	
ROUNDING						
				0.4	0.4	
TOTAL						
				163	163	

GENERAL NOTES

- BRIDGE RAIL SHALL BE HEAVY DUTY STEEL BEAM RAIL.
- BRIDGE APPROACH RAIL HEIGHT SHALL BE TRANSITIONED TO NORMAL ROADWAY RAIL HEIGHT IN 25'.
- APPROACH RAILING SHALL BE HEAVY DUTY STEEL BEAM FOR 25' FROM THE ENDS OF THE BRIDGE UNLESS OTHERWISE NOTED IN THE PLANS OR DIRECTED BY THE RESIDENT ENGINEER.
- FOR BRIDGE RAILING, THE TRANSITION POST SHALL HAVE AN OFFSET BLOCK AND BE LOCATED AS CLOSE AS PRACTICABLE TO THE MIDPOINT BETWEEN THE BRIDGE END POST AND APPROACH RAIL POST 1.
- SPLICES SHALL LAP IN DIRECTION OF TRAFFIC FLOW.
- SEE STANDARD SHEET G-1 FOR DELINEATION DETAILS AND PLACEMENT.
- ERECT DELINEATORS ON EVERY FIFTH POST OR APPROXIMATELY 31'-3" APART. PAYMENT SHALL BE INCIDENTAL TO OTHER ITEMS.
- ALL BRIDGE POSTS, HEAVY DUTY STEEL BEAM BRIDGE RAIL, AND RELATED HARDWARE SHALL BE PAID FOR UNDER THE APPROPRIATE BRIDGE RAILING ITEMS AS DENOTED IN THE PLANS.
- ALL STEEL POSTS, PLATES, OFFSET BLOCKS AND FIXTURES SHALL BE PROVIDED IN ACCORDANCE WITH SUBSECTION 732.04, UNLESS OTHERWISE NOTED, AND SHALL BE GALVANIZED AFTER FABRICATION TO CONFORM TO AASHTO M 111M/M 111.
- SEE STANDARD SHEET G-1 FOR CONNECTION OF STEEL BEAM TO OFFSET BLOCK AND OFFSET BLOCK TO BRIDGE POST.
- NEW BRIDGE RAILING POSTS SHALL BE SET NORMAL TO GRADE.

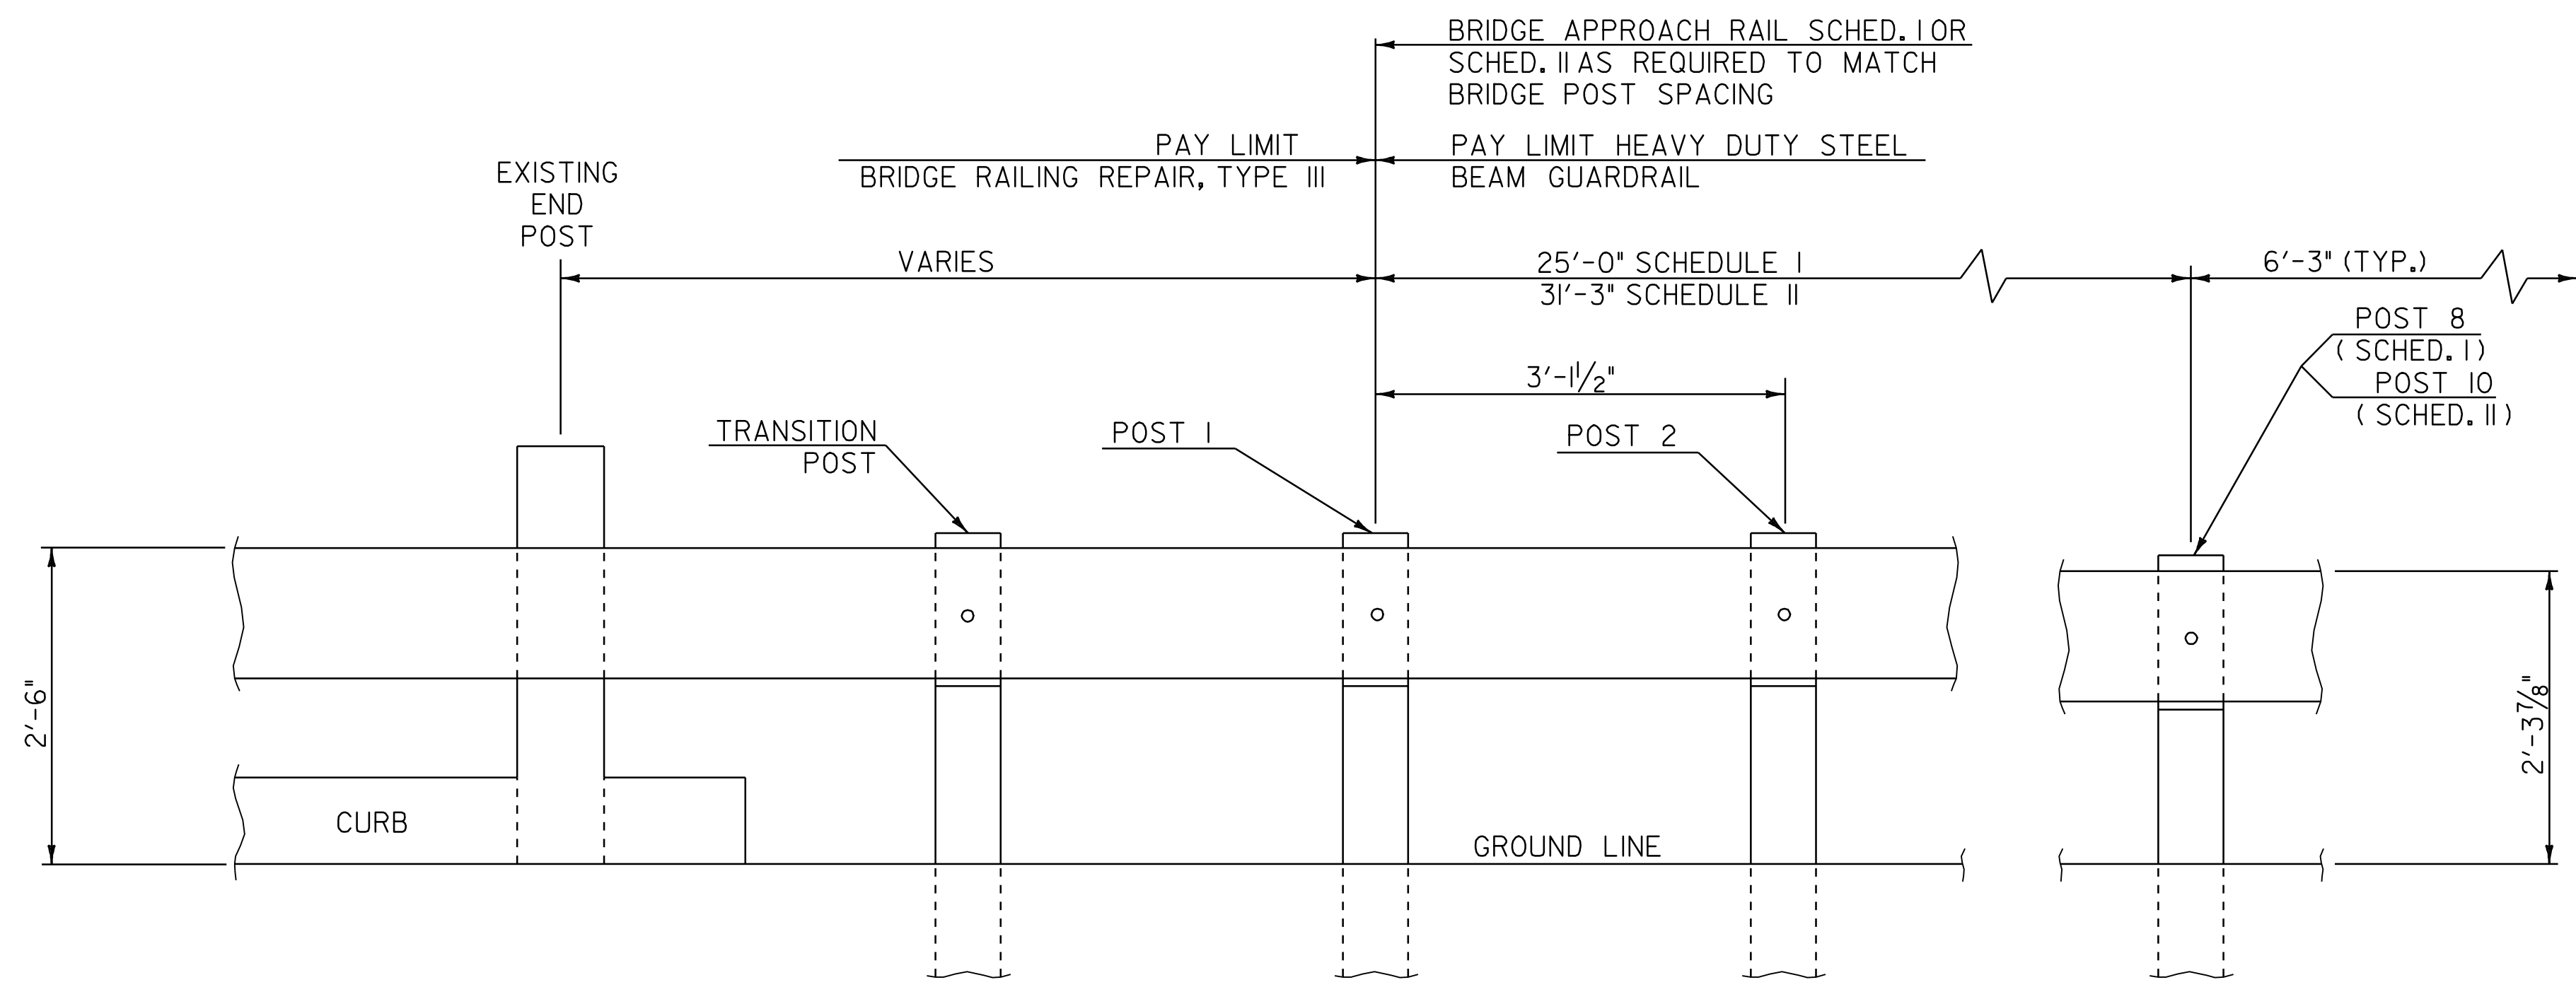

SCHEDULE I		
POST NO.	SPACING	PAYMENT FACTOR
1	3'-1 1/2"	1.4 x 12'-6"
2	3'-1 1/2"	
3	3'-1 1/2"	
4	3'-1 1/2"	
5	3'-1 1/2"	1.2 x 12'-6"
6	4'-2"	
7	4'-2"	
8	4'-2"	1.0 (TYP.)
9	6'-3" (TYP.)	
TOTAL PAY LENGTH = 32' - 6"		


SCHEDULE II		
POST NO.	SPACING	PAYMENT FACTOR
1	3'-1 1/2"	1.4 x 18'-9"
2	3'-1 1/2"	
3	3'-1 1/2"	
4	3'-1 1/2"	
5	3'-1 1/2"	
6	3'-1 1/2"	1.2 x 12'-6"
7	3'-1 1/2"	
8	4'-2"	
9	4'-2"	1.0 (TYP.)
10	4'-2"	
11	6'-3" (TYP.)	
TOTAL PAY LENGTH = 41' - 3"		

SCHEDULE I APPROACH RAILING SHALL BE USED WHEN A RAIL PANEL SPLICE OCCURS AT POST NO. 1.
 SCHEDULE II APPROACH RAILING SHALL BE USED WHEN A RAIL PANEL SPLICE OCCURS AT THE BRIDGE END POST.



BRIDGE APPROACH RAILING

NOT TO SCALE

BRIDGE DETAIL SHEET #1	PROJECT NAME: BRIDGEWATER_-_WOODSTOCK	PLOT DATE: 28-MAY-2010
	PROJECT NUMBER: NH_2611(S)_____	DRAWN BY: C.A.K.
	FILE NAME: p06b160.dgn_	CHECKED BY: D.E.G.
	DESIGNED BY: D.W.E.	SHEET 75 OF 80
	IPARM FILE: p06b160bdl.i	

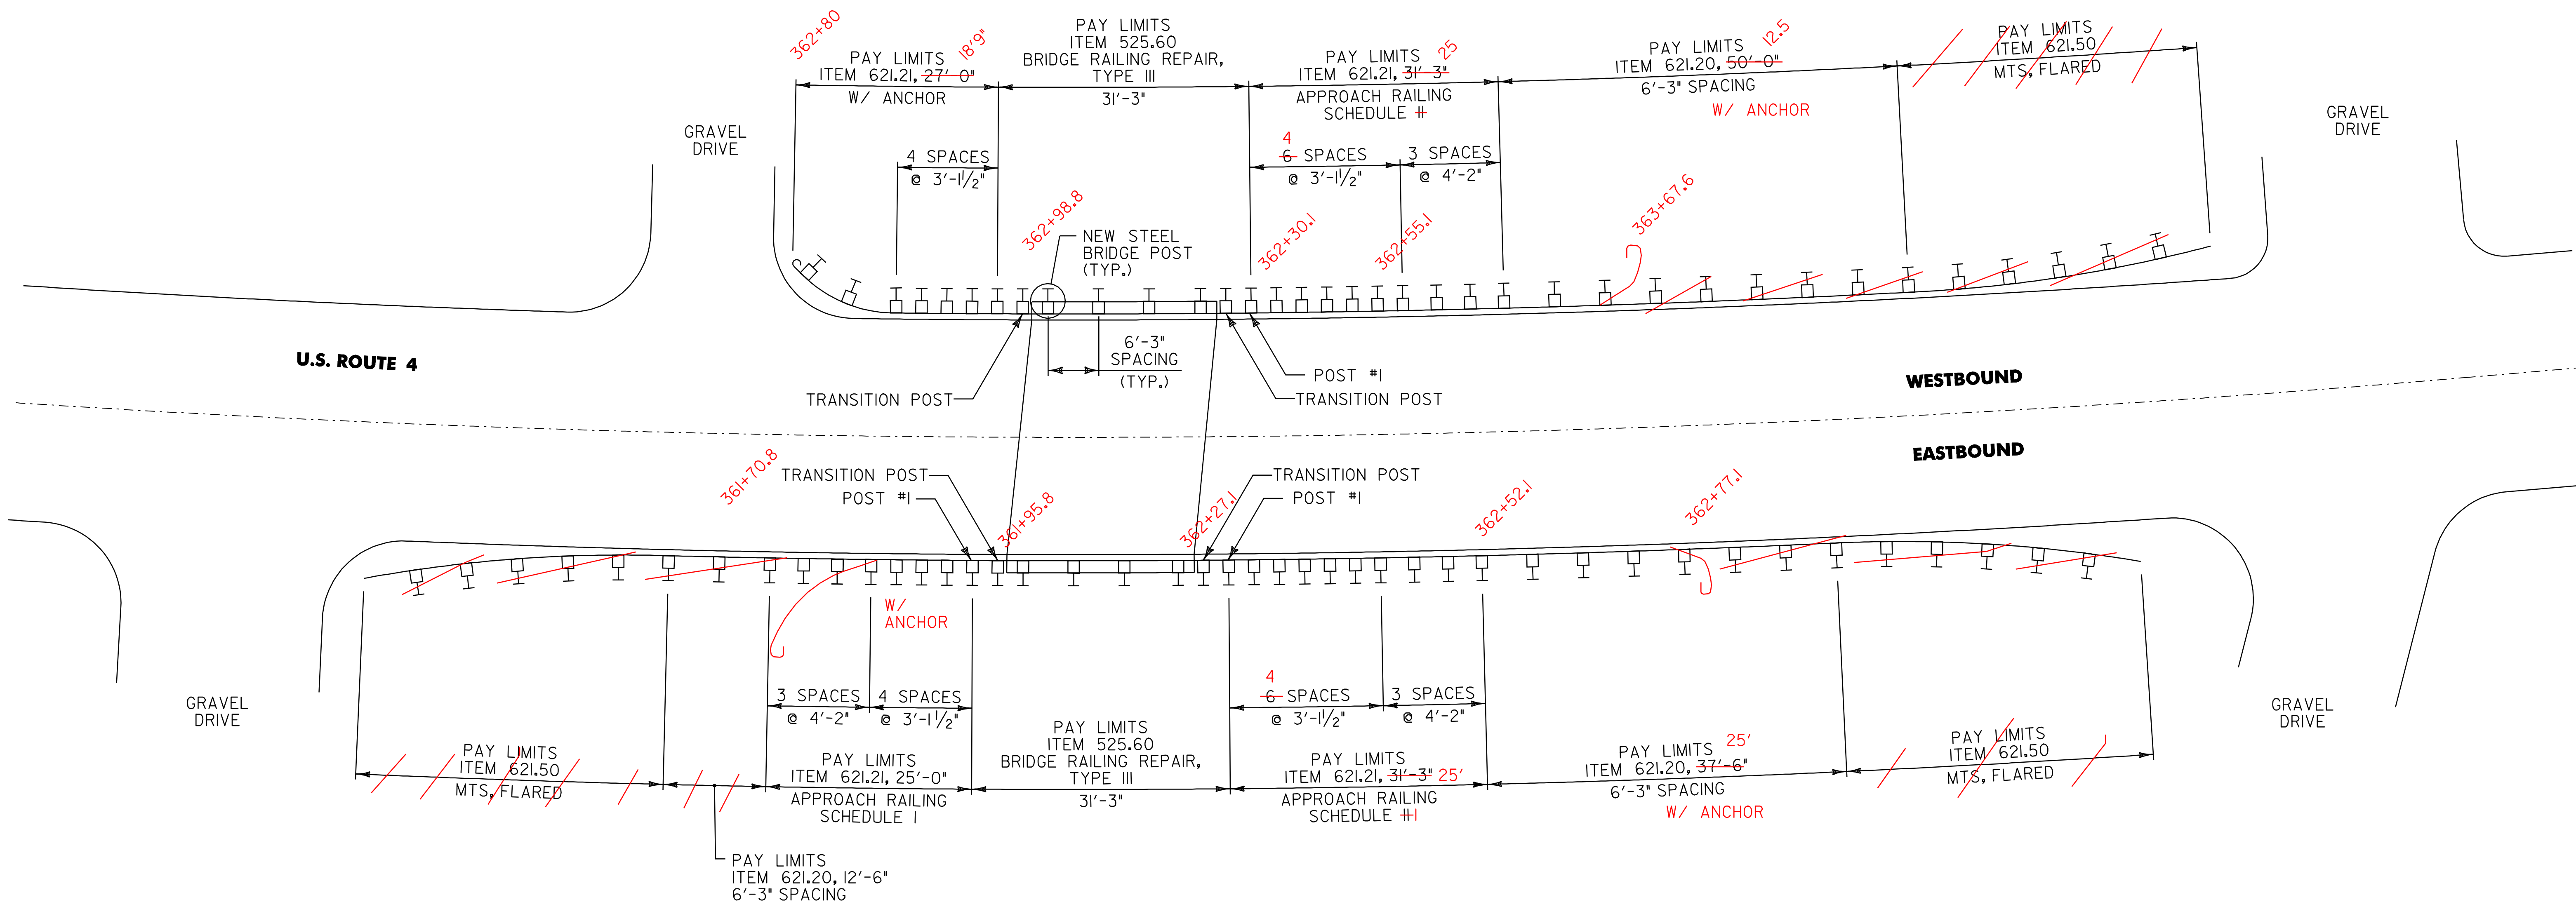

BR 46 BRIDGEWATER MM 6.859 = STA. 362+15.52

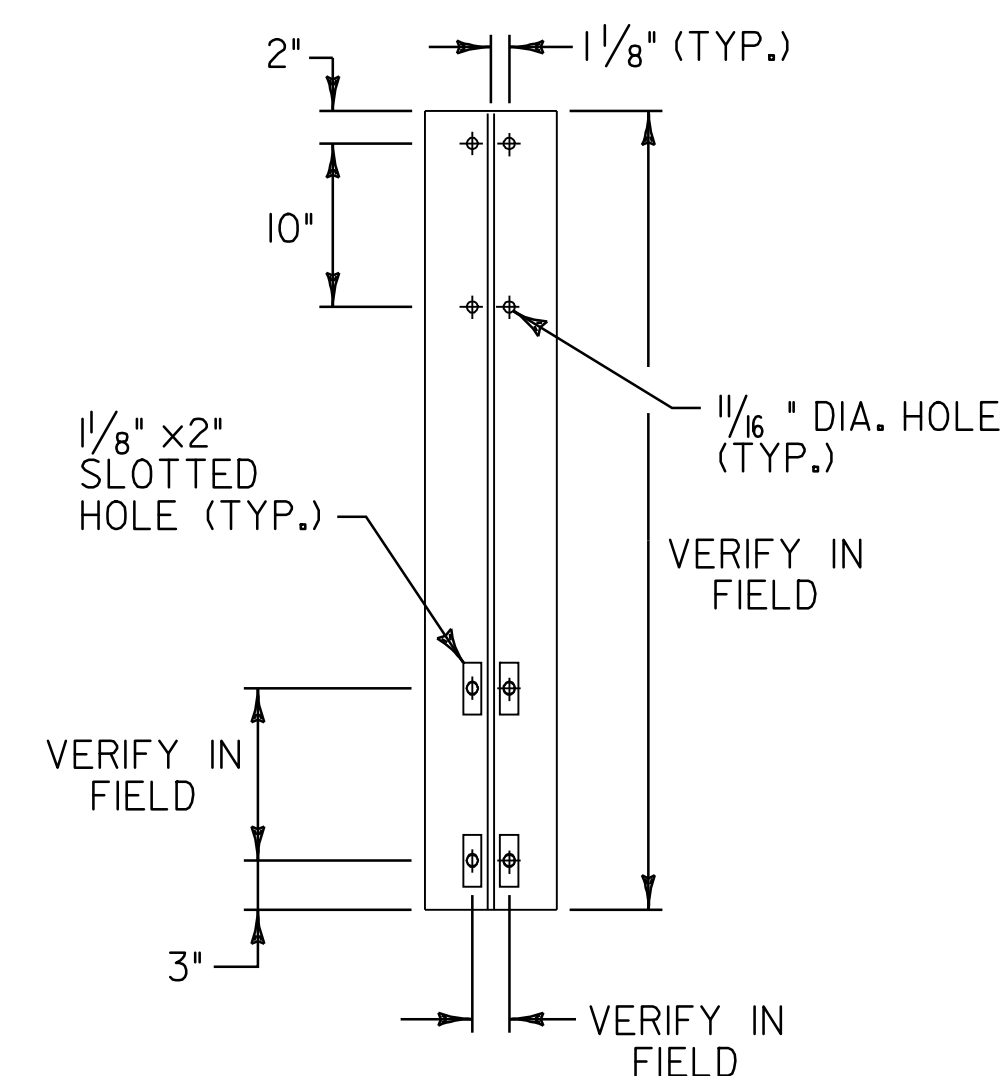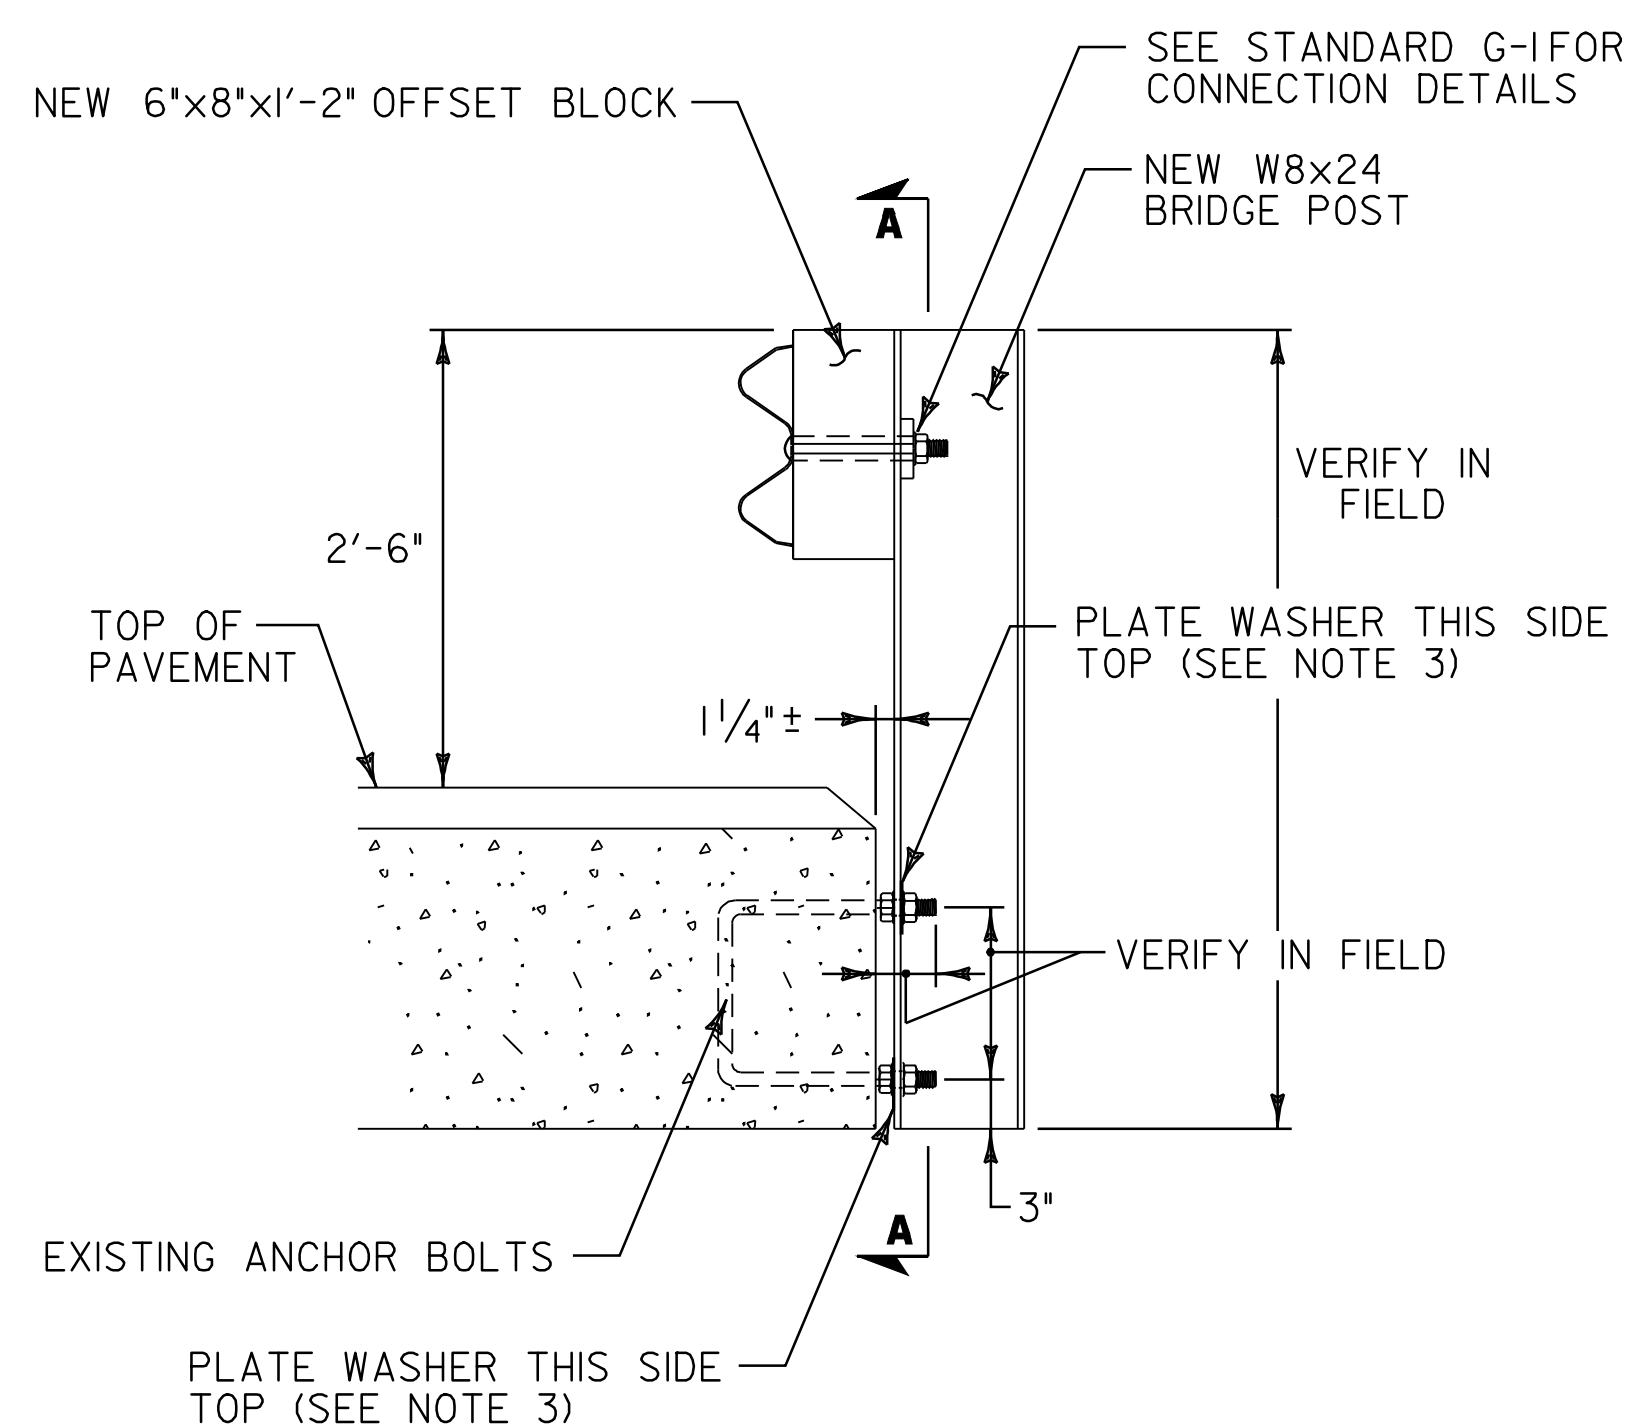

SECTION A-A

- NOTES:**
1. LOCATION OF EXISTING ANCHOR BOLTS TO BE VERIFIED IN THE FIELD BY THE CONTRACTOR PRIOR TO ORDERING BRIDGE POSTS.
 2. POSTS SHALL BE SHOP CUT AND DRILLED PRIOR TO GALVANIZING.
 3. SEE STANDARD SHEET SB-R6-82 FOR ADDITIONAL DETAILS.



NOT TO SCALE

**BRIDGE
DETAIL
SHEET #2**

PROJECT NAME: BRIDGEWATER_-_WOODSTOCK
PROJECT NUMBER: NH_2611(S)

FILE NAME: p06b160.dgn_ PLOT DATE: 28-MAY-2010
PROJECT LEADER: D.E.G. DRAWN BY: C.A.K.
DESIGNED BY: D.W.E. CHECKED BY: D.E.G.
IPARM FILE: p06b160b2.i SHEET 76 OF 80

BR 46 BRIDGE POST DETAIL

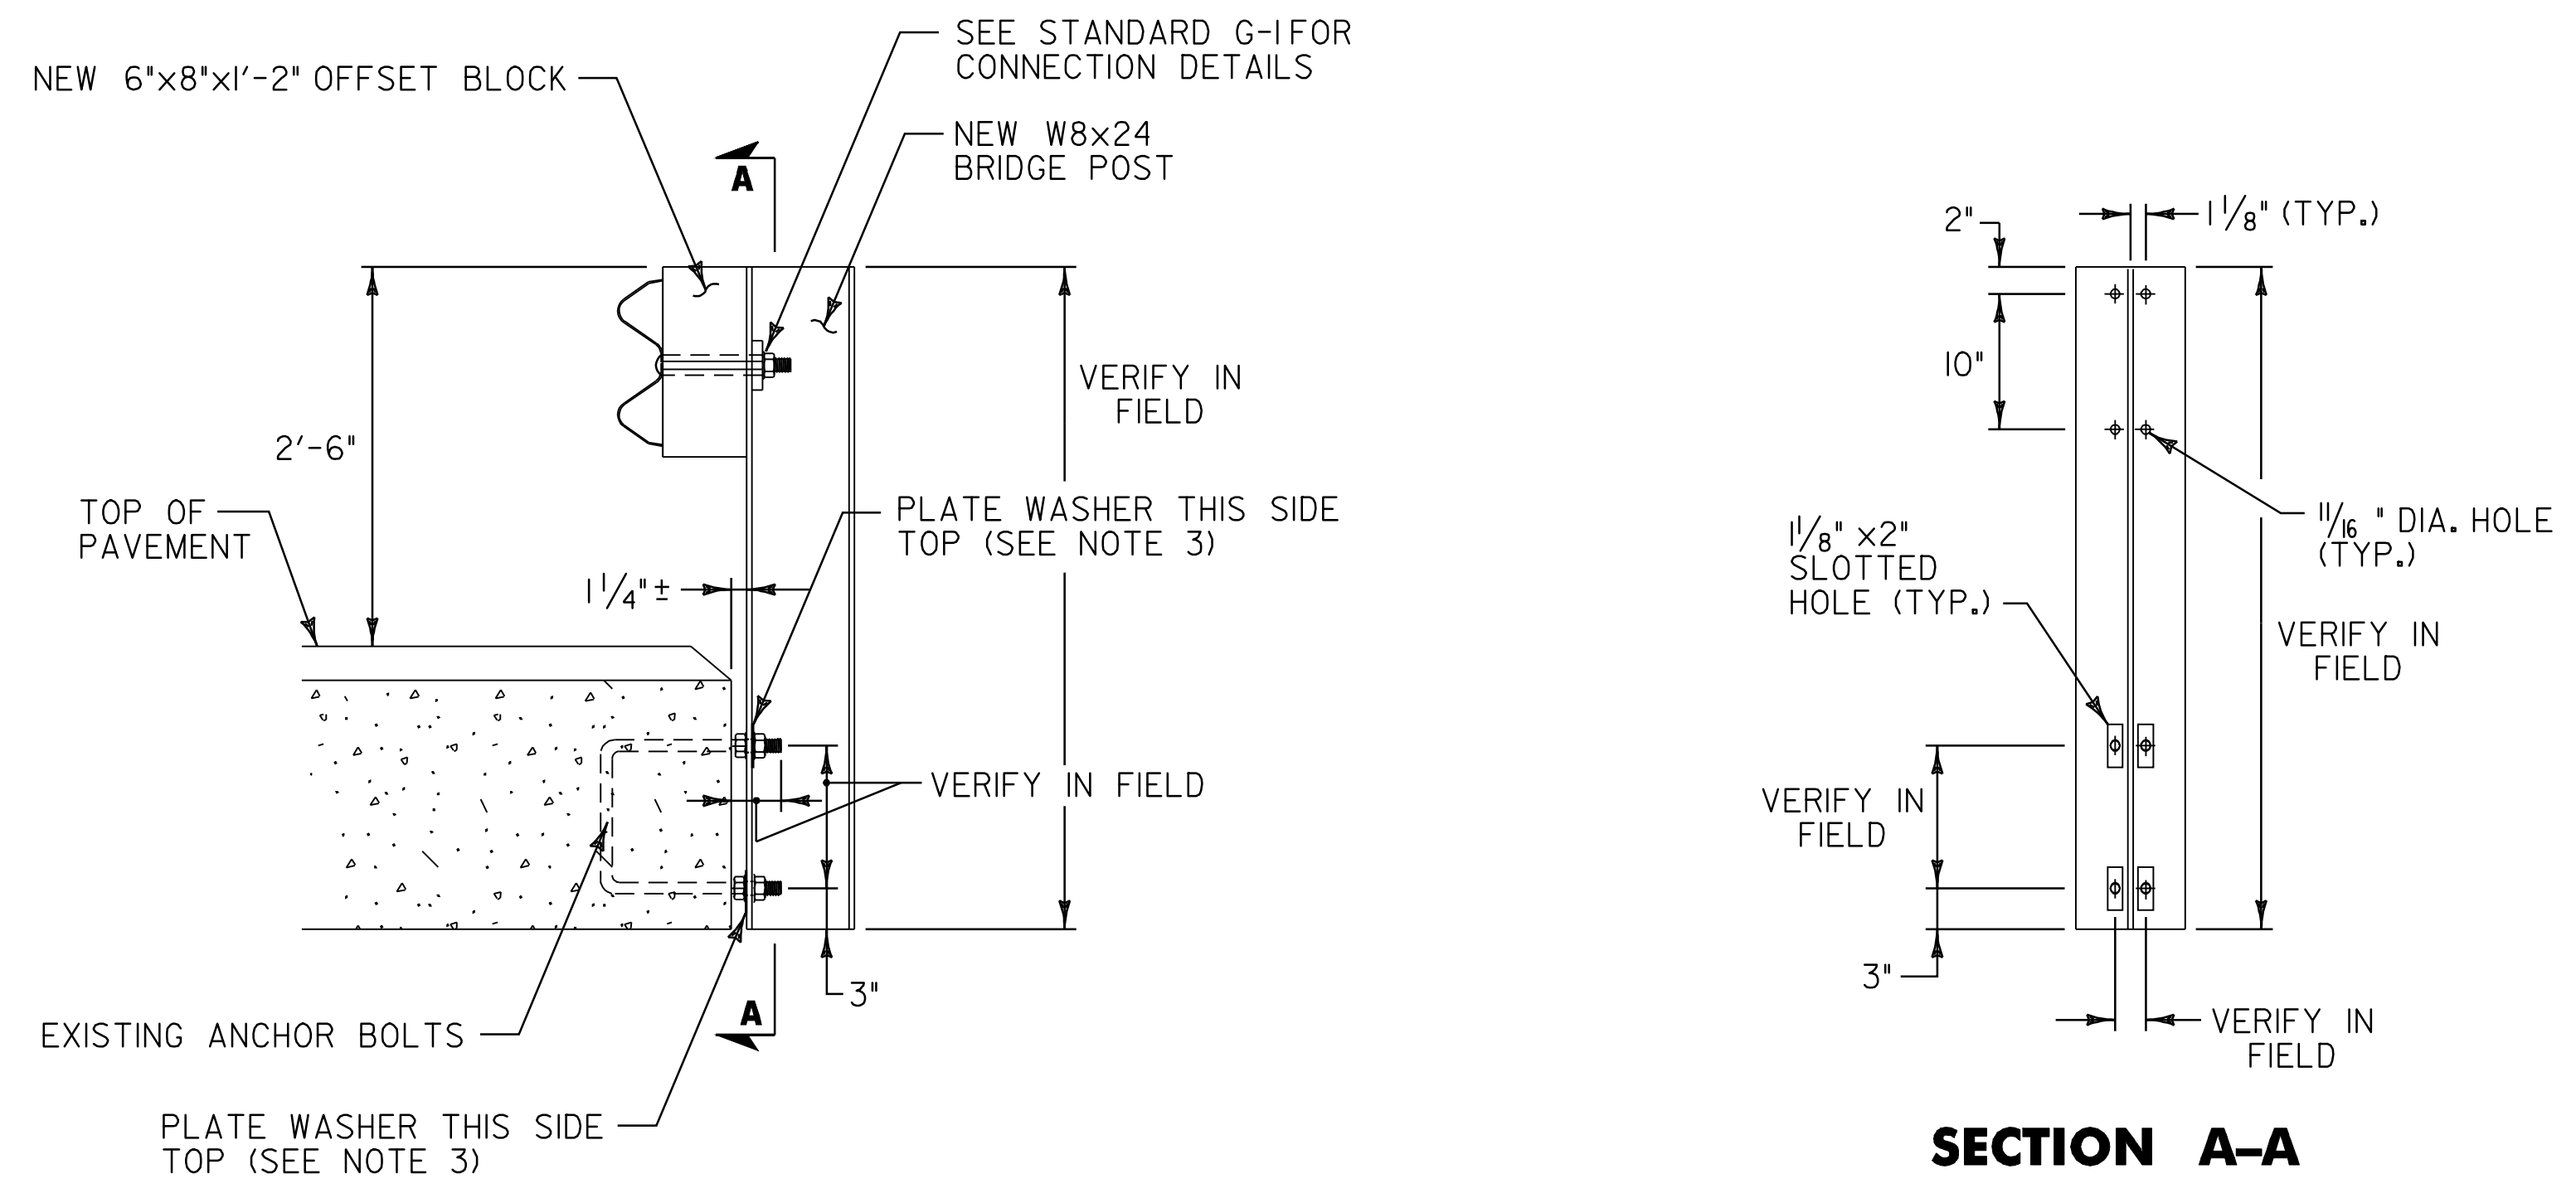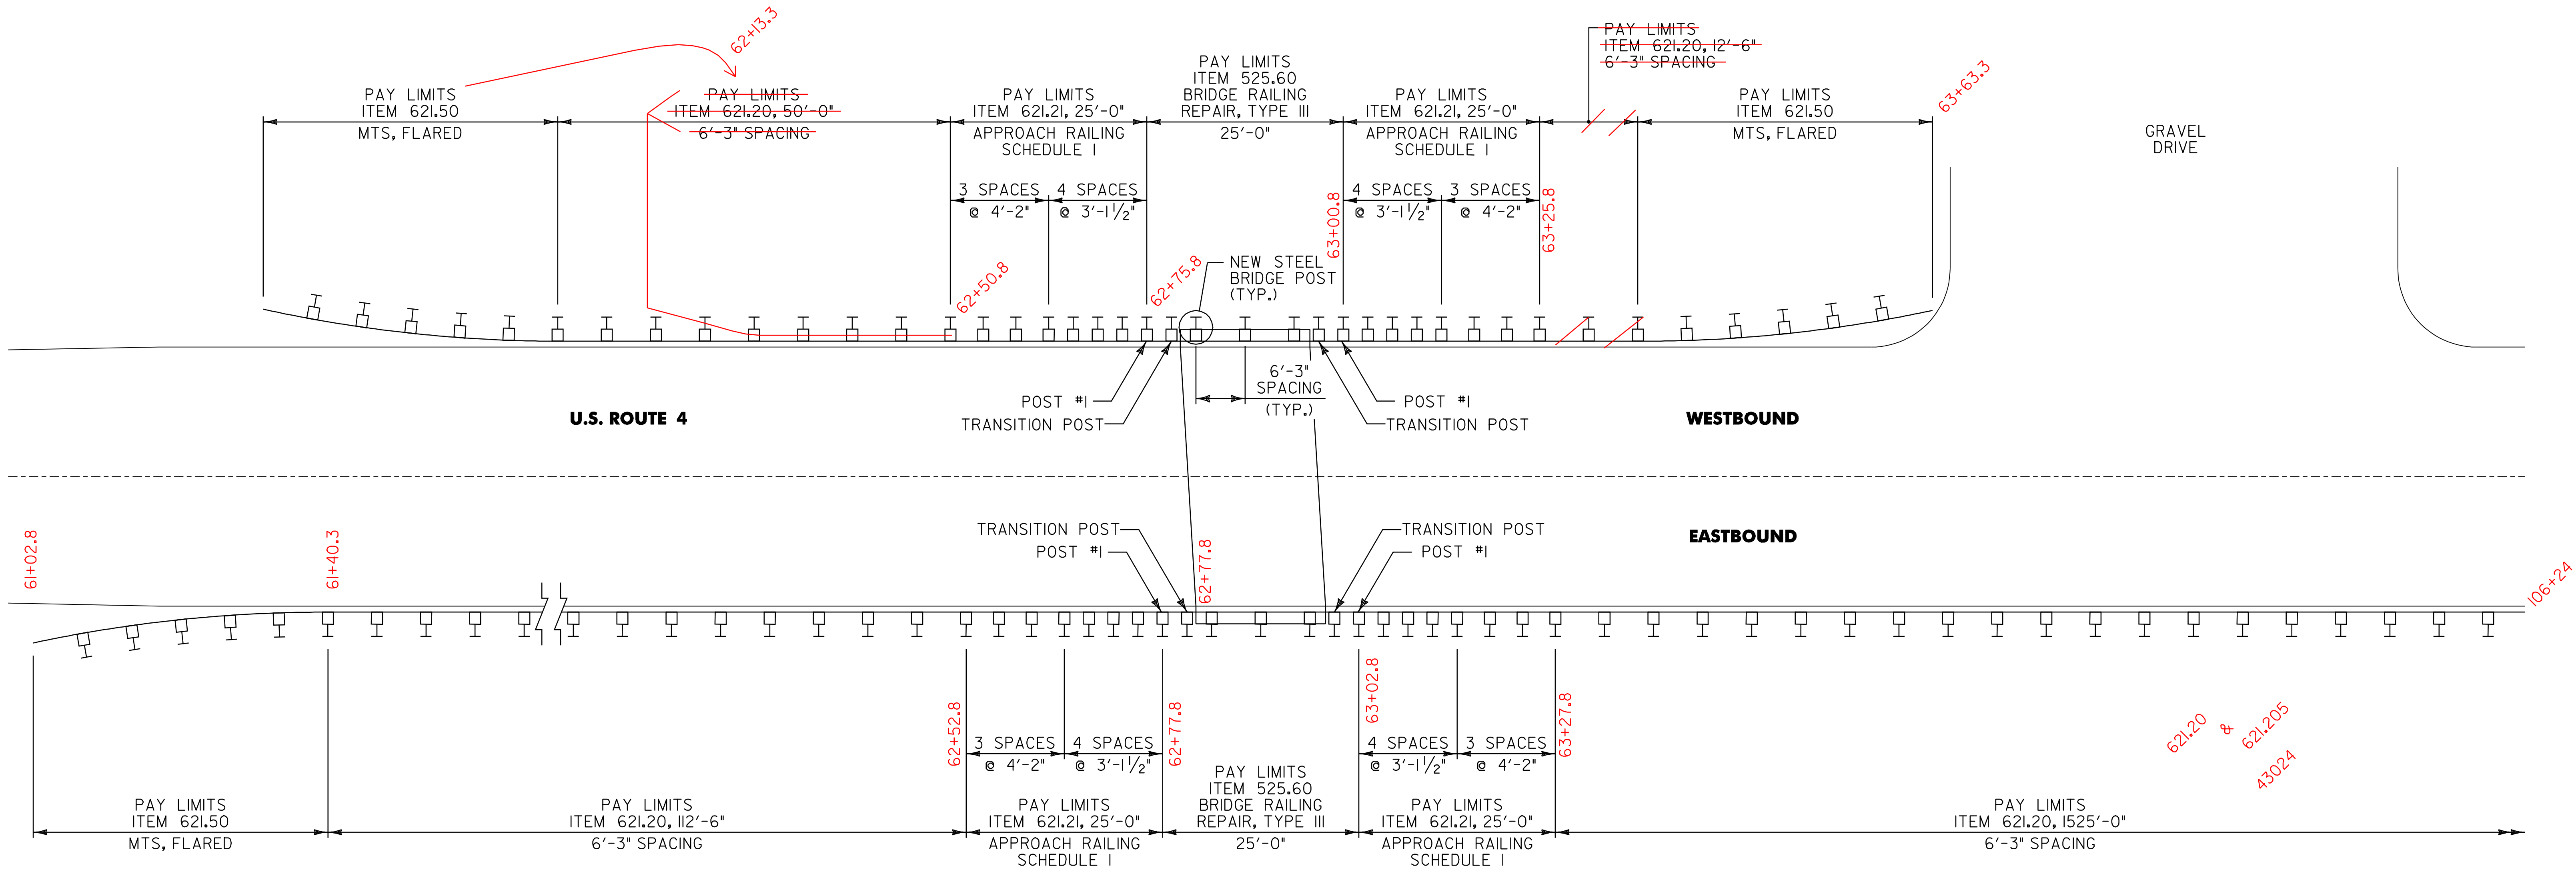

- NOTES:**
1. LOCATION OF EXISTING ANCHOR BOLTS TO BE VERIFIED IN THE FIELD BY THE CONTRACTOR PRIOR TO ORDERING BRIDGE POSTS.
 2. POSTS SHALL BE SHOP CUT AND DRILLED PRIOR TO GALVANIZING.
 3. SEE STANDARD SHEET SB-R6-82 FOR ADDITIONAL DETAILS.

BRIDGE DETAIL SHEET #3	NOT TO SCALE	
	PROJECT NAME: BRIDGEWATER - WOODSTOCK	PROJECT NUMBER: NH_2611(S)
	FILE NAME: p06b160.dgn	PLOT DATE: 28-MAY-2010
	PROJECT LEADER: D.E.G.	DRAWN BY: C.A.K.
DESIGNED BY: D.W.E.	CHECKED BY: D.E.G.	
IPARM FILE: p06b160b3.i	SHEET 77 OF 80	


BR 47 BRIDGE POST DETAIL

ASPHALT DRIVE



U.S. ROUTE 4

FIELD ACCESS

ASPHALT DRIVE

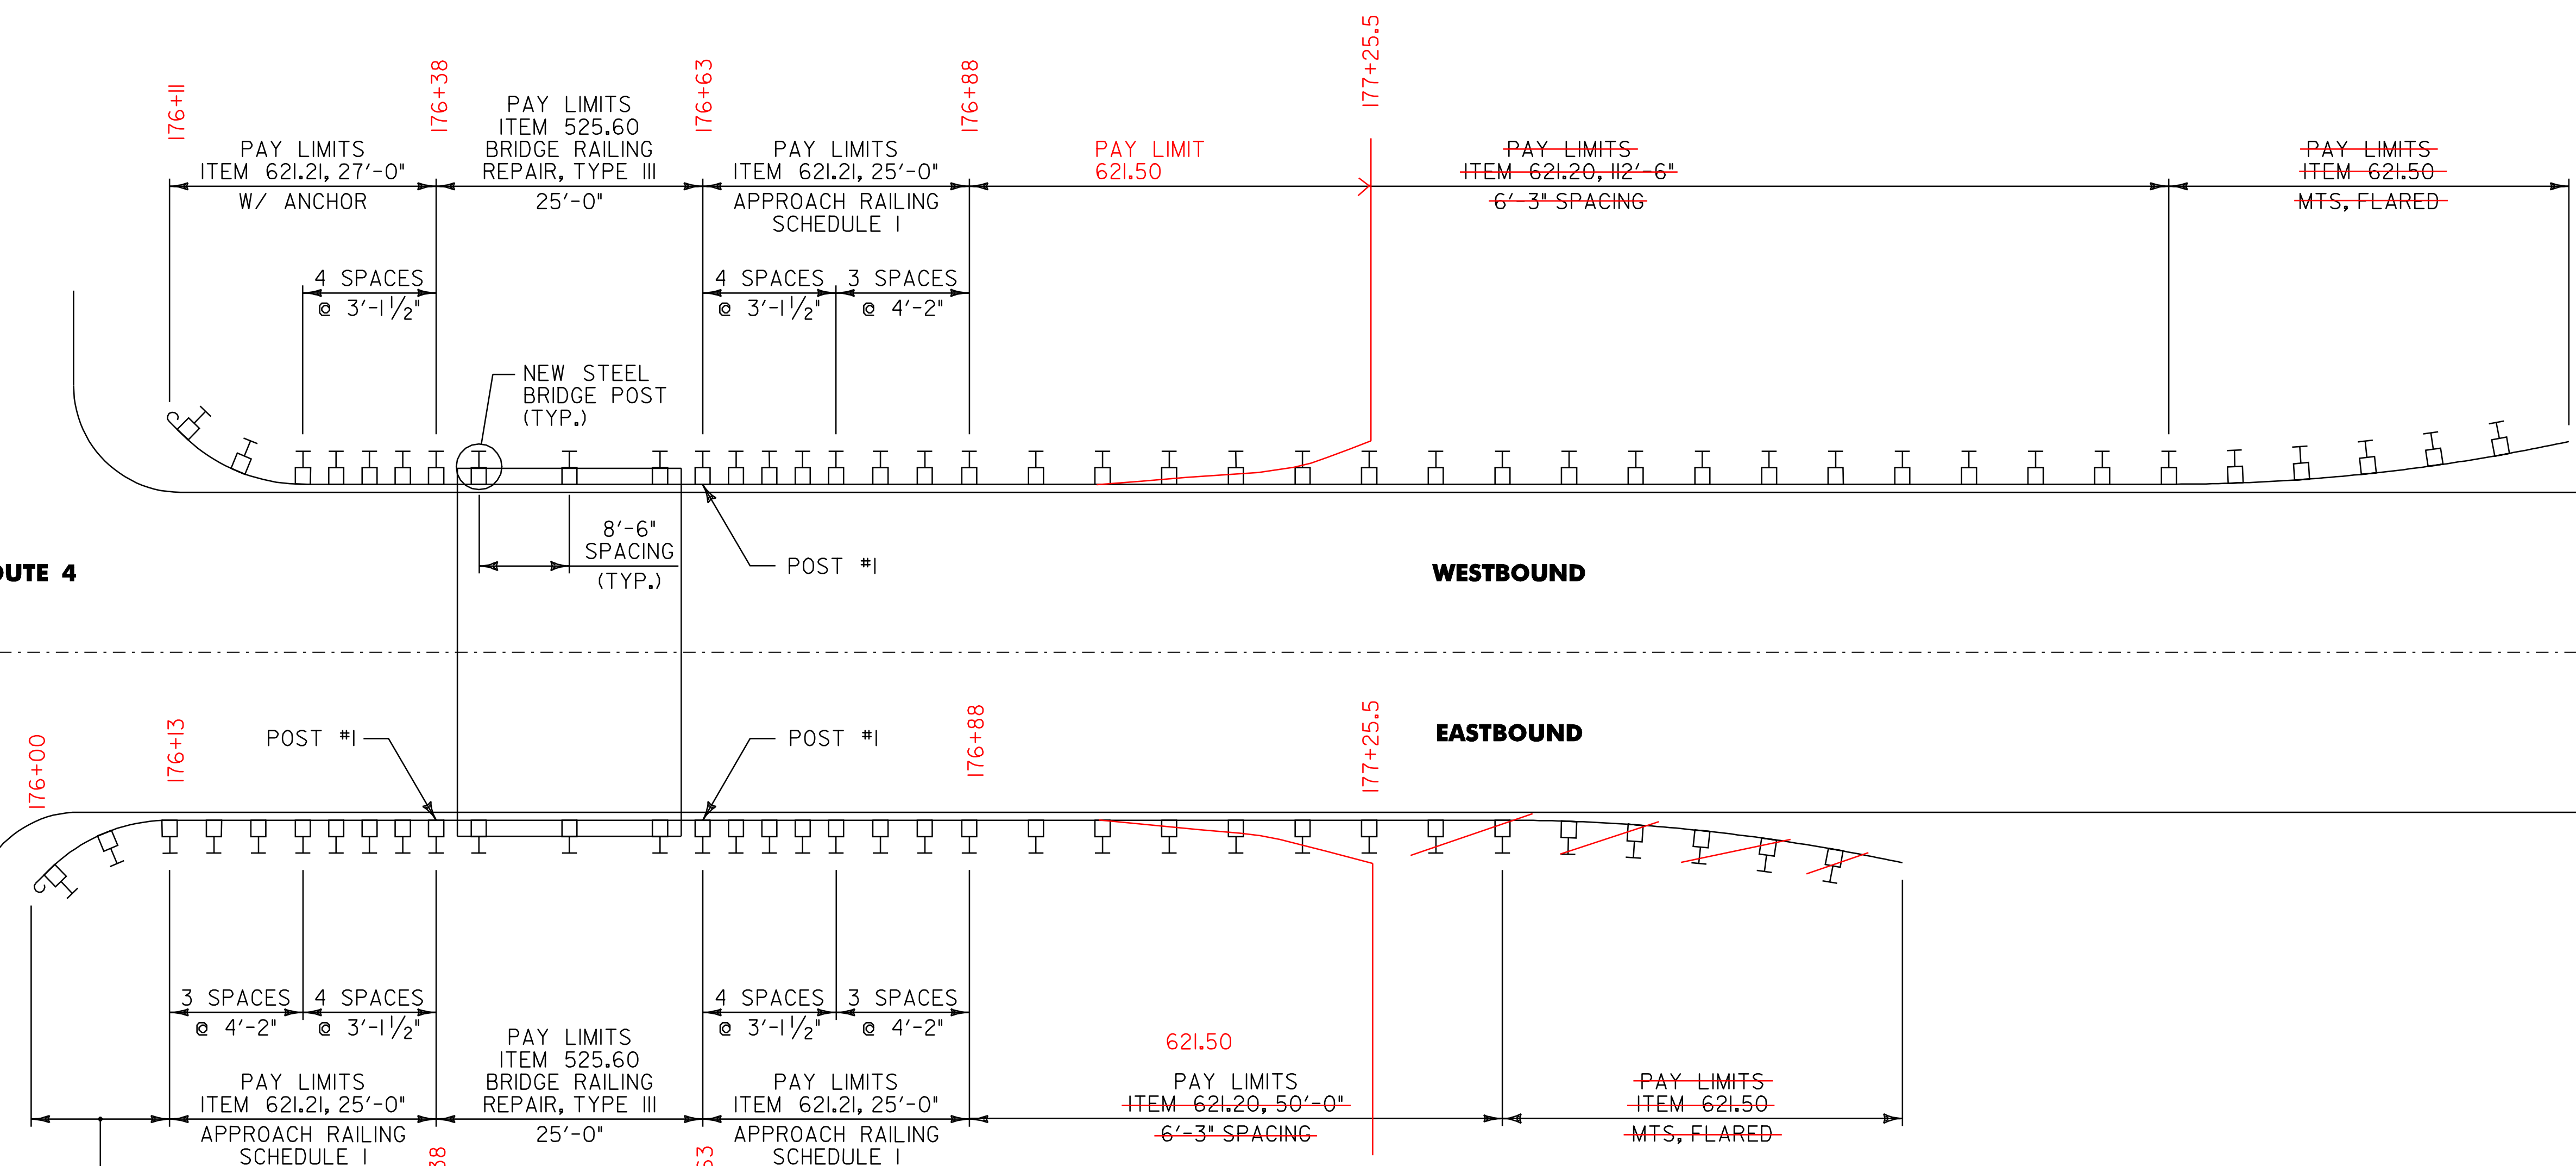

BR 48 WOODSTOCK MM 3.343 = STA. 176+51.04

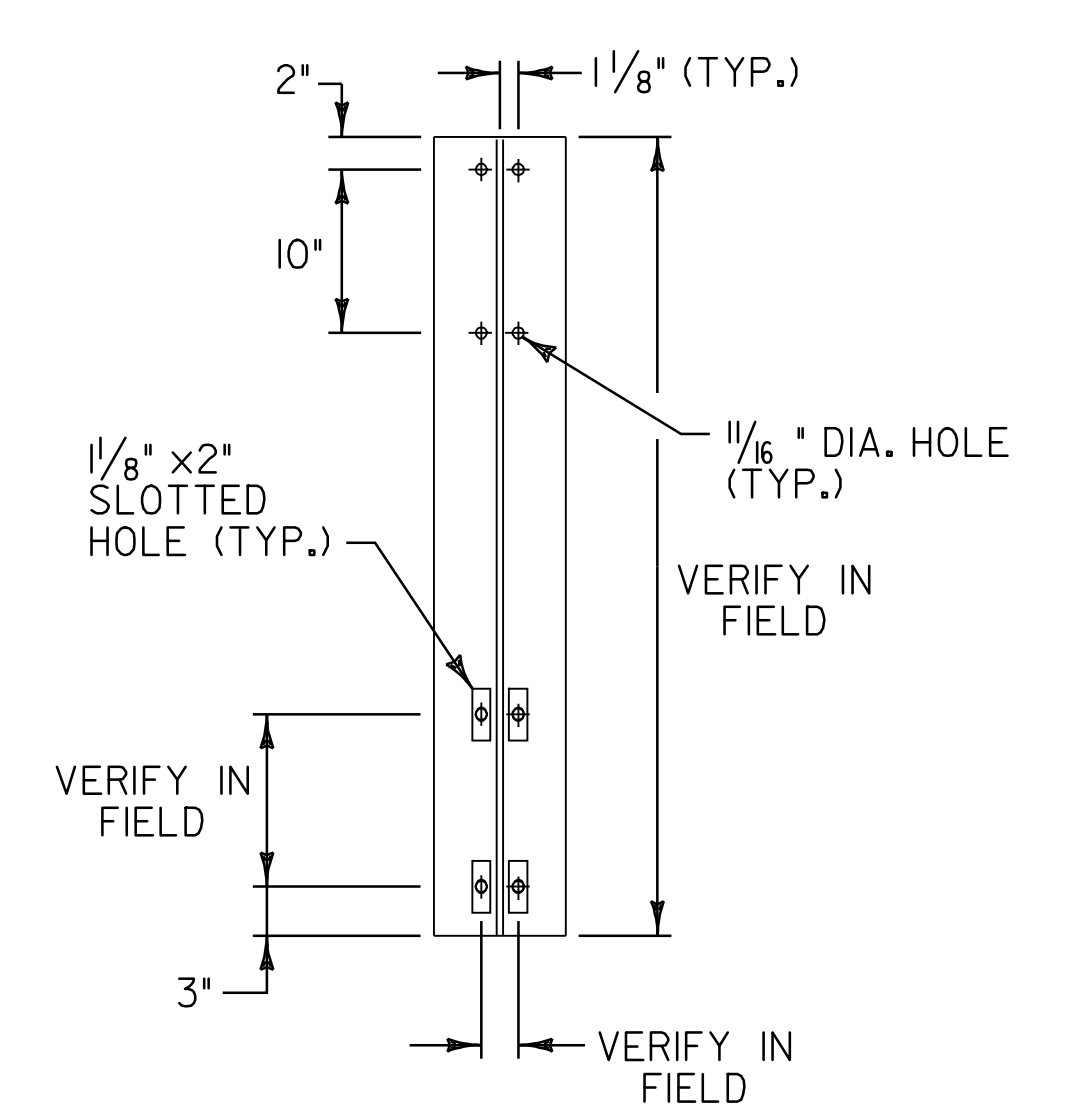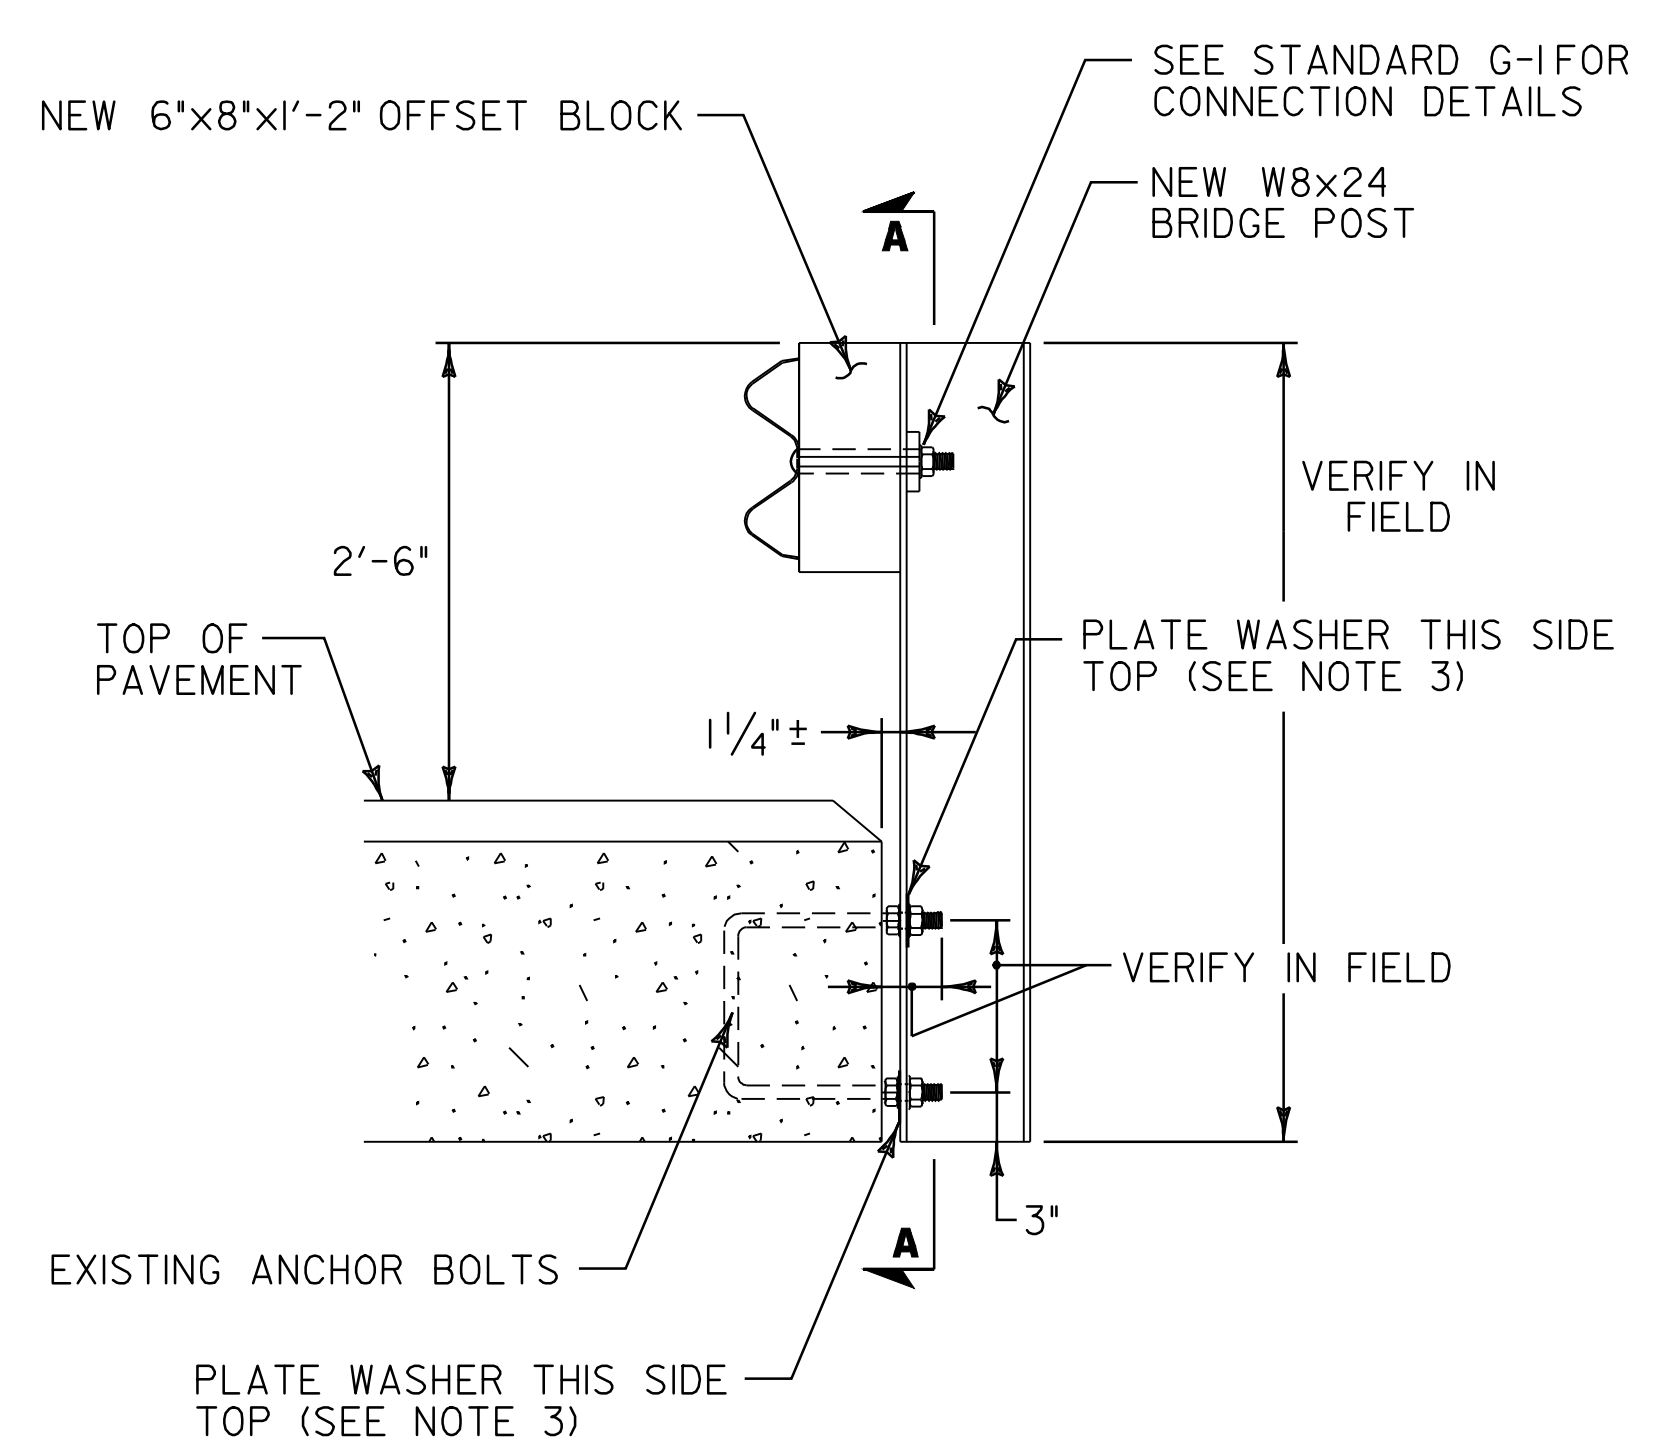


SECTION A-A

BR 48 BRIDGE POST DETAIL

- NOTES:
1. LOCATION OF EXISTING ANCHOR BOLTS TO BE VERIFIED IN THE FIELD BY THE CONTRACTOR PRIOR TO ORDERING BRIDGE POSTS.
 2. POSTS SHALL BE SHOP CUT AND DRILLED PRIOR TO GALVANIZING.
 3. SEE STANDARD SHEET SB-R6-82 FOR ADDITIONAL DETAILS.


<p>NOT TO SCALE</p> <p>BRIDGE DETAIL SHEET #4</p>	PROJECT NAME: BRIDGEWATER_-_WOODSTOCK	PLOT DATE: 28-MAY-2010
	PROJECT NUMBER: NH_2611(1)S	DRAWN BY: C.A.K.
	FILE NAME: p06b160.dgn_	DESIGNED BY: D.W.E.
	IPARM FILE: p06b160b4.i	SHEET 78 OF 80

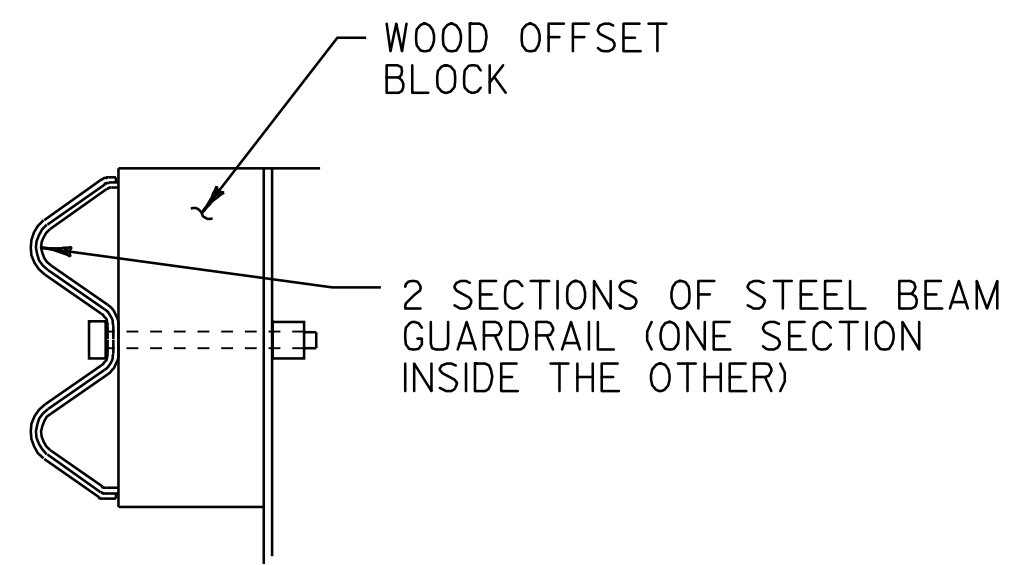

DETAIL A

NOTES

1. SEE STANDARD G-1 FOR STEEL BEAM GUARDRAIL DETAILS.
2. THIS WORK SHALL BE PAID UNDER ITEM 900.640 SPECIAL PROVISION (HD STEEL BEAM GUARDRAIL, GALVANIZED/NESTED) AT A PAY FACTOR OF 1.0.
3. THIS DETAIL TO BE USED AS INDICATED ON THE ITEM DETAIL SUMMARY SHEETS OR AS DIRECTED BY THE RESIDENT ENGINEER.

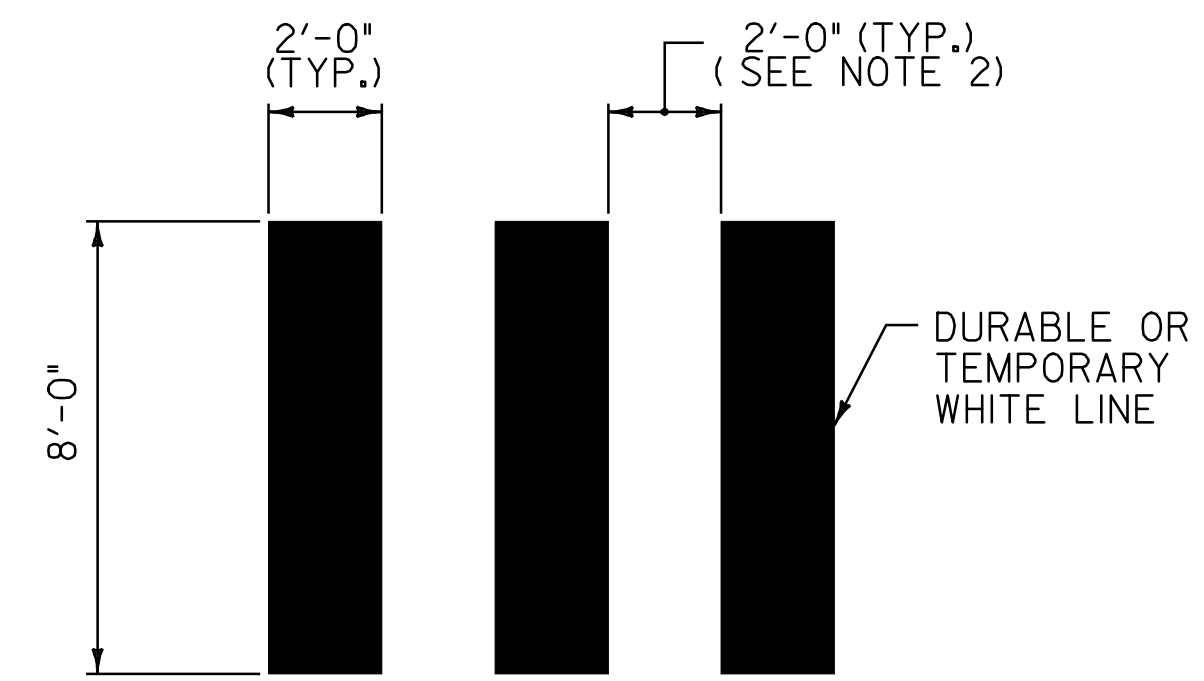


DETAIL OF CROSSWALK MARKINGS

U.S. ROUTE 4 BRIDGEWATER:
STA. 385+40.0 LT/RT


U.S. ROUTE 4 WOODSTOCK:
STA. 247+82.0 LT/RT

NOTES:

1. THE PER FOOT COST OF INSTALLED CROSSWALK, SHALL BE PAID AS ITEM 646.501 DURABLE CROSSWALK MARKING, TYPE 1 TAPE AND 646.702 TEMPORARY CROSSWALK MARKING, PAINT
2. ADJUST SPACING (12" - 24") TO AVOID WHEEL PATHS.

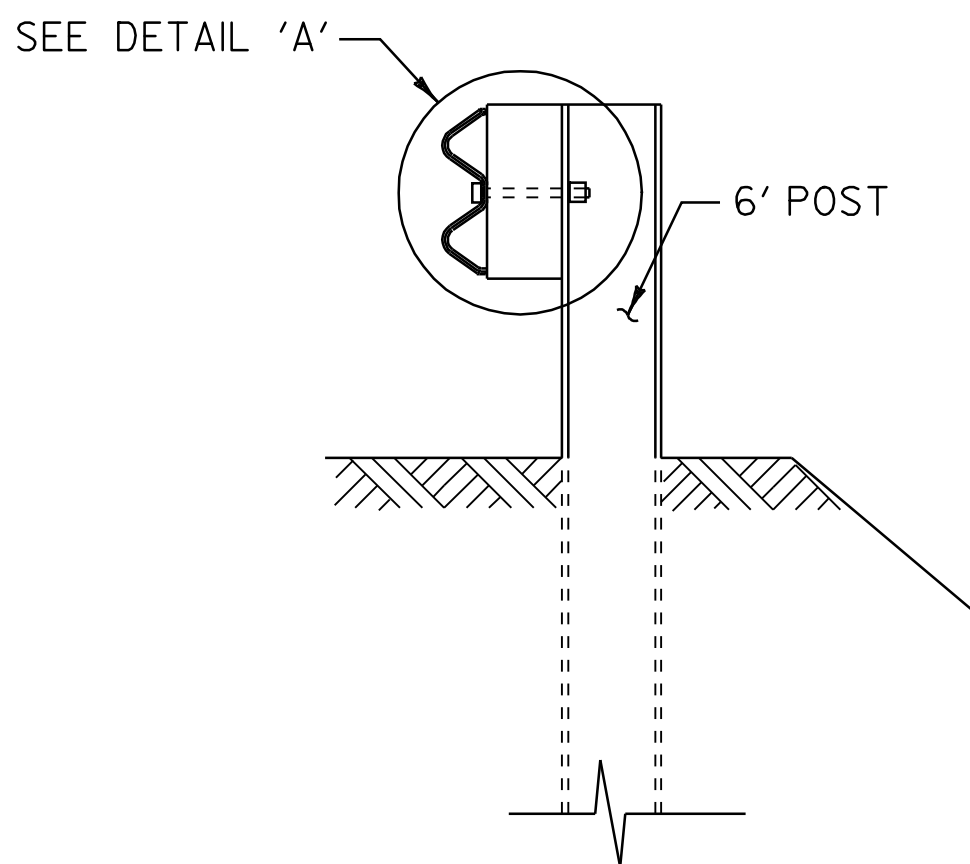


SECTION A-A

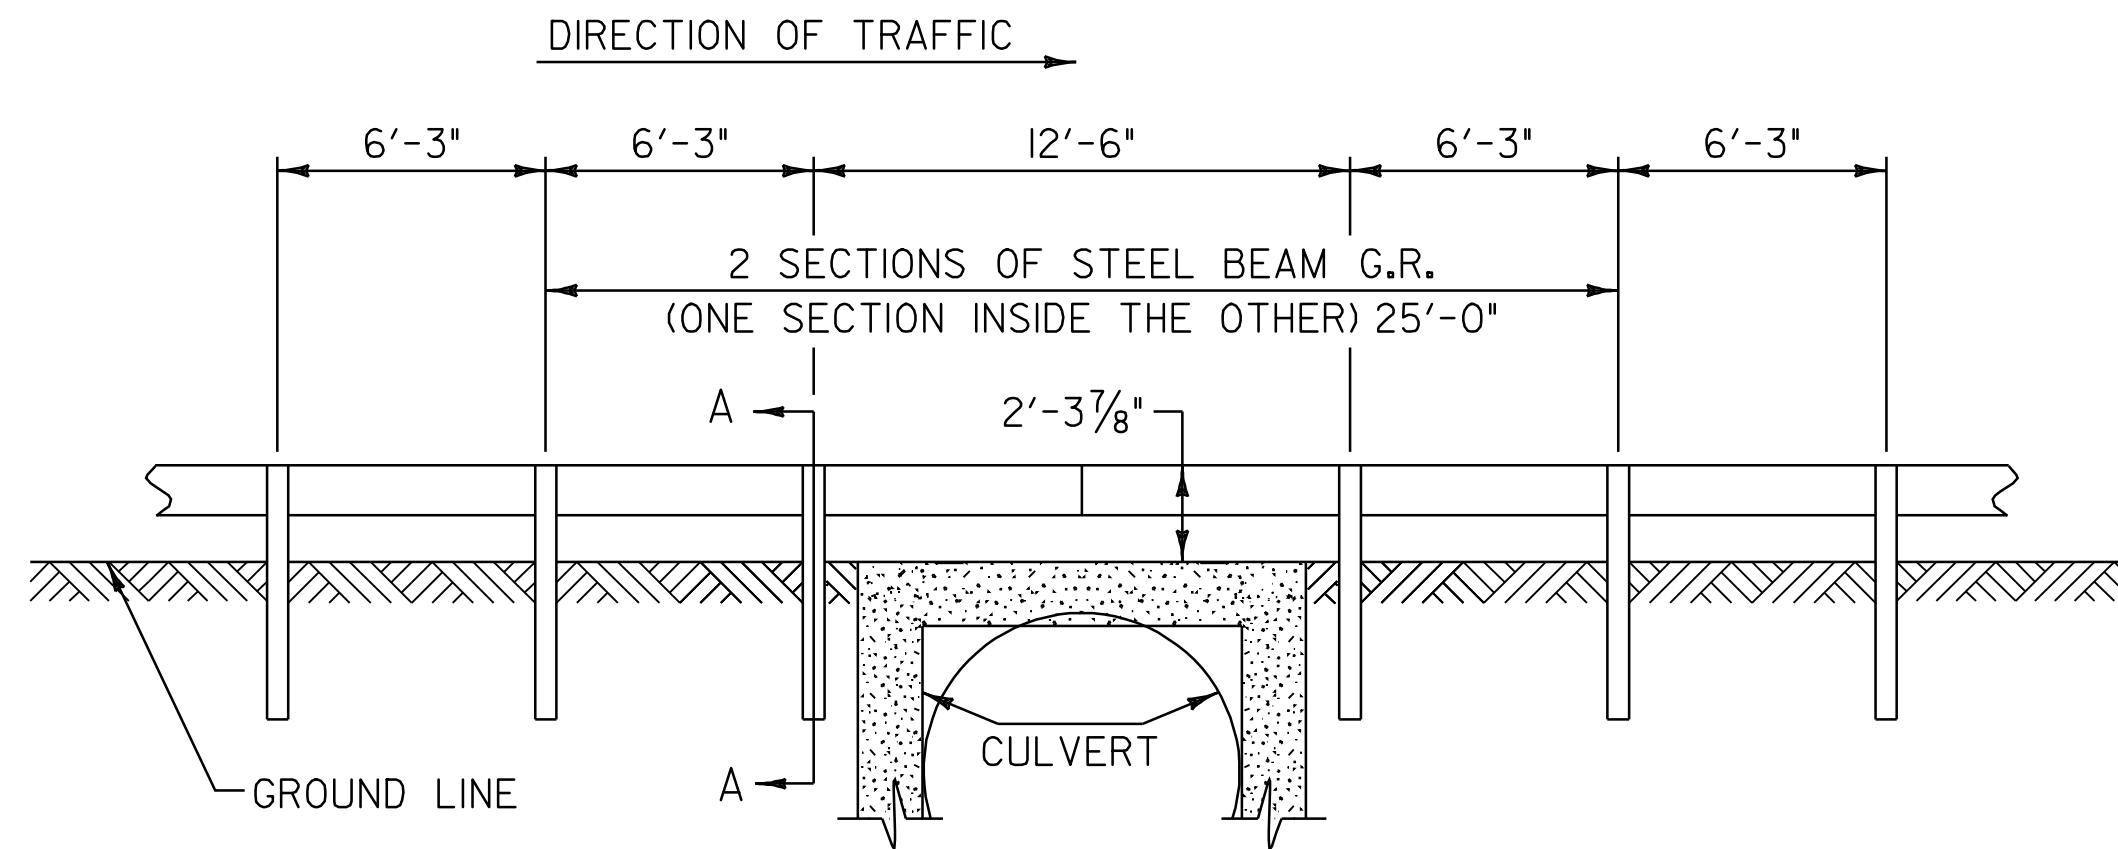


STEEL BEAM GUARDRAIL AT SMALL CULVERTS DETAIL

BR 45A
U.S. ROUTE 4 BRIDGEWATER 338+28.76 RT

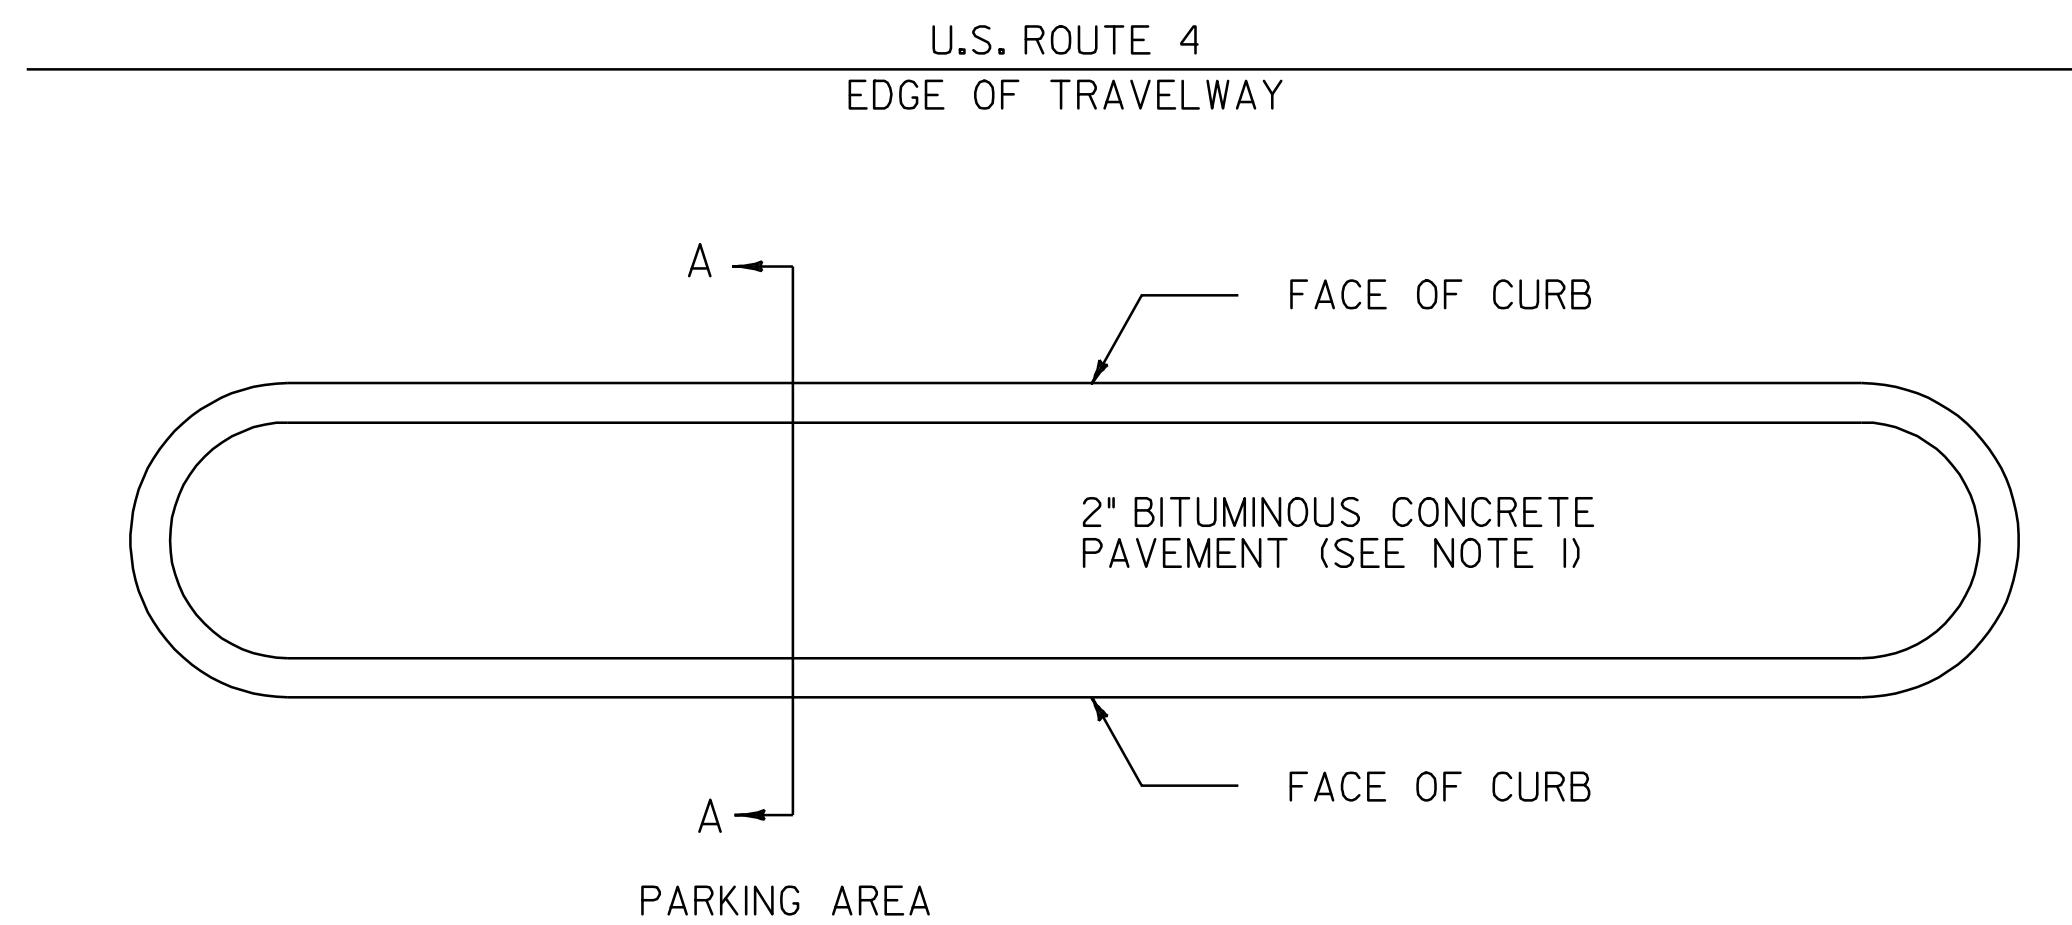

PLAN

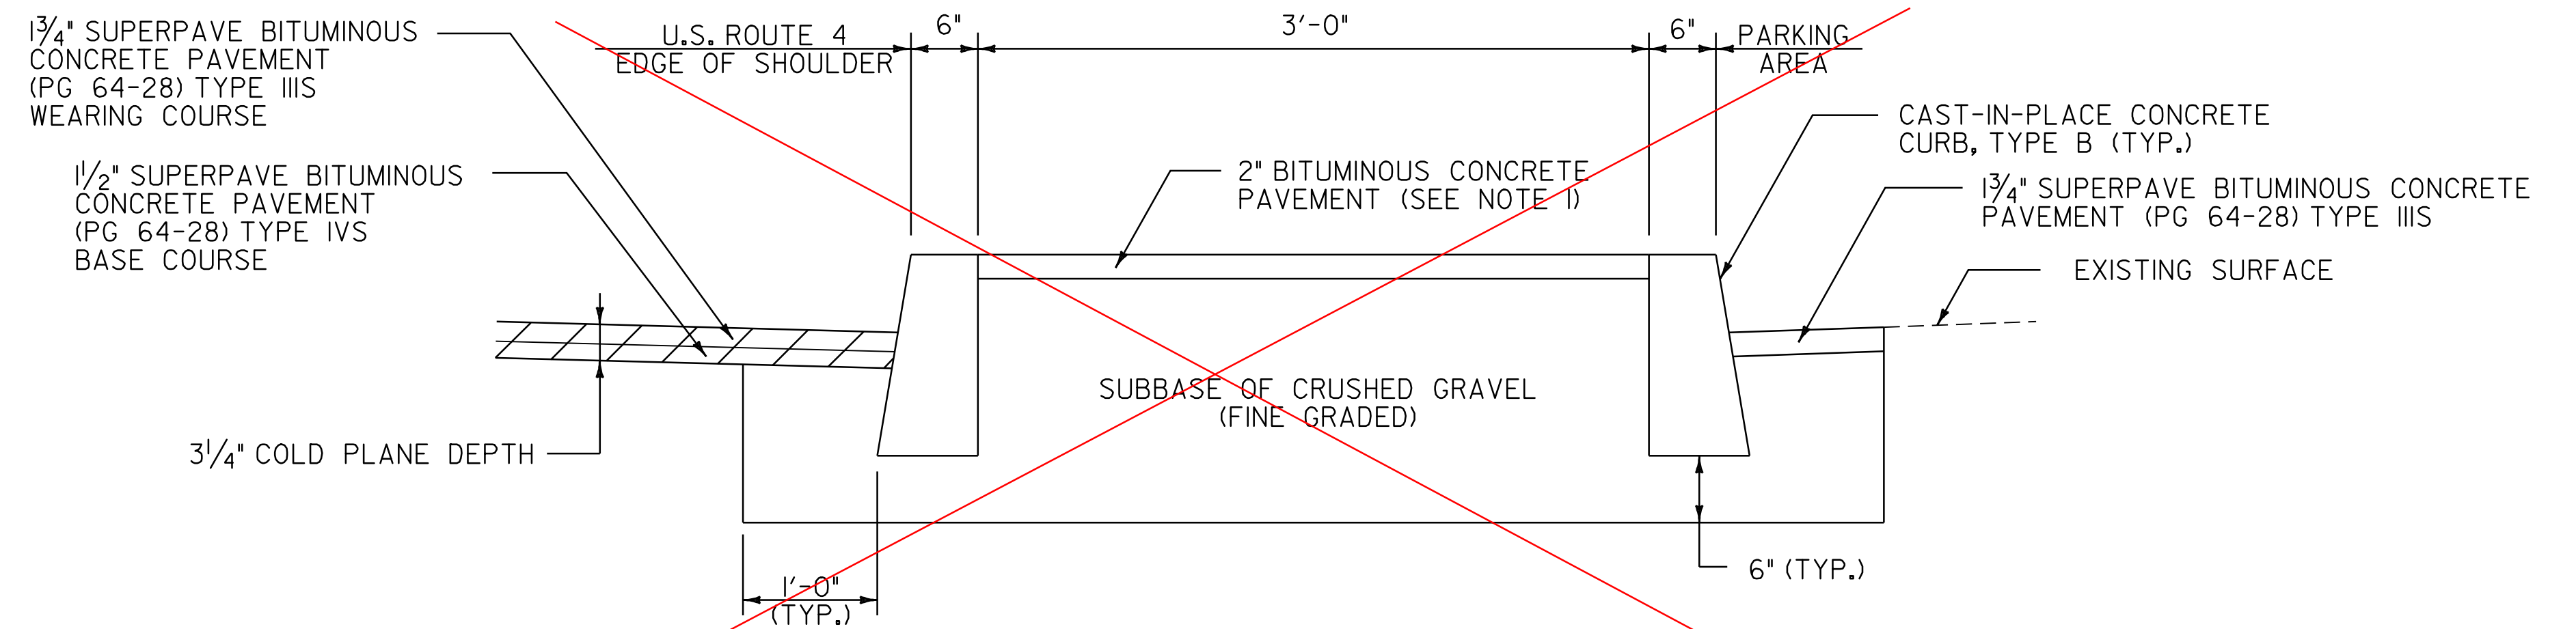

SECTION A-A

BITUMINOUS CONCRETE TRAFFIC ISLAND DETAIL

U.S. ROUTE 4 WOODSTOCK:
STA. 262+93.0 - STA. 264+94.0 RT
STA. 265+51.0 - STA. 266+79.0 RT

NOTE:

1. THE CONTRACTOR SHALL CONSTRUCT THE BITUMINOUS CONCRETE TRAFFIC ISLAND BY PLACING ONE 2" LIFT OF TYPE III SUPERPAVE BITUMINOUS CONCRETE PAVEMENT. PAYMENT SHALL BE MADE UNDER ITEM 616.47 BITUMINOUS CONCRETE GUTTERS AND TRAFFIC ISLANDS.

NOT TO SCALE


MISCELLANEOUS DETAILS SHEET

PROJECT NAME: BRIDGEWATER - WOODSTOCK
PROJECT NUMBER: NH_2611(1)S

FILE NAME: p06b160.dgn -- PLOT DATE: 28-MAY-2010
PROJECT LEADER: D.E.G. DRAWN BY: C.A.K.
DESIGNED BY: D.W.E. CHECKED BY: D.E.G.
IPARM FILE: p06b160md.i SHEET 79 OF 80

U.S. ROUTE 4
MM 6.023 = STA. 318+01.44
BEGIN PROJECT NH 2611(S)

U.S. ROUTE 4
MM 5.650 = STA. 298+32.00
END PROJECT NH 2611(S)

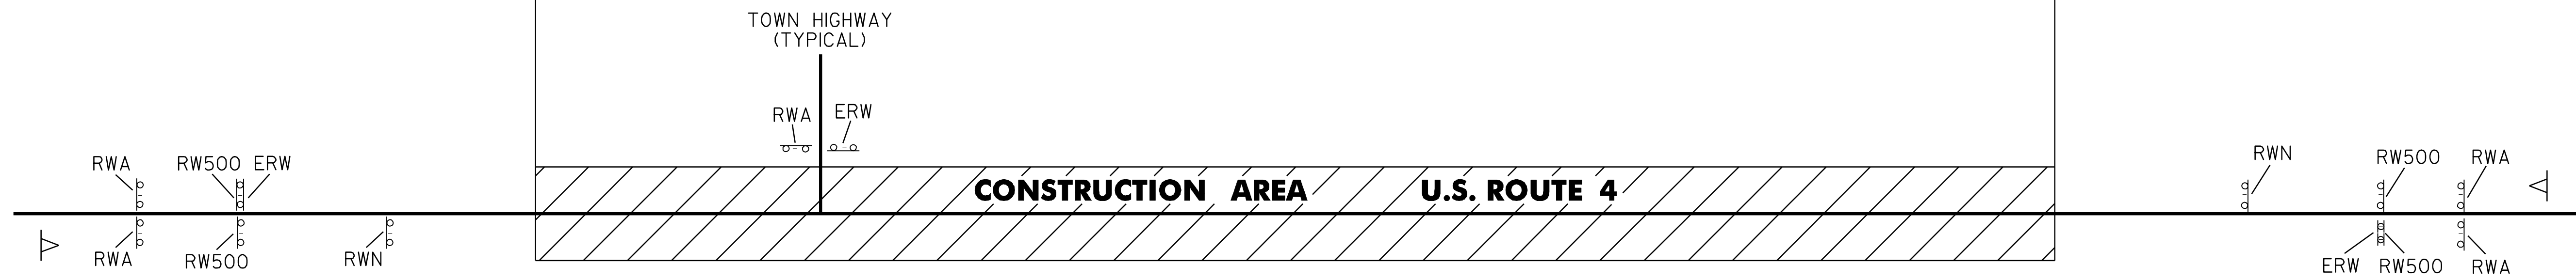

CONSTRUCTION APPROACH SIGNING

SIGN LEGEND

RWA = ROAD WORK AHEAD
RW500 = ROAD WORK 500 FEET
ERW = END ROAD WORK
RWN = ROAD WORK NEXT 7 MILES

◁ = PORTABLE CHANGEABLE MESSAGE SIGN

HIGHWAY NAME	RWA	ERW	RW500	RWN	OTHER
BRIDGEWATER:					
U.S. ROUTE 4 - BEGIN PROJECT	2	1	2	1	1-PORT. CHG. MSG. SIGN
GOLD COAST ROAD (TH-26)	1	1			
NORTH BRIDGEWATER ROAD (TH-3)	1	1			
TAYLOR FLATS ROAD (TH-26)	1	1			
WOODSTOCK:					
WOOLEN MILL DRIVE (TH-97)	1	1			
HILLSIDE ROAD (TH-13)	1	1			
TH-27	1	1			
WESTERDALE CUT-OFF (TH-28) - WEST	1	1			
FLETCHER MOUNTAIN ROAD (TH-35)	1	1			
WESTERDALE CUT-OFF (TH-28) - EAST	1	1			
GABERT ROAD (TH-17)	1	1			
WYMAN LAKE ROAD (TH-29)	1	1			
COX DISTRICT ROAD (TH-23)	1	1			
SENIOR LANE (TH-114) - WEST	1	1			
SENIOR LANE (TH-114) - EAST	1	1			
BARBERRY HILL ROAD (TH-30)	1	1			
SCHOOL DRIVEWAY	1	1			
MILL ROAD (TH-50)	1	1			
PROSPER ROAD (TH-30)	1	1			
THOMAS HILL ROAD (TH-81)	1	1			
MILL ROAD EXTENSION (TH-51)	1	1			
U.S. ROUTE 4 - END PROJECT	2	1	2	1	1-PORT. CHG. MSG. SIGN
TOTAL	24	22	4	2	2-PORT. CHG. MSG. SIGNS

NOTES:

- SEE VAOT STD. E-100 FOR ADDITIONAL SIGN PLACEMENT.
- CONSTRUCTION ZONE SIGN LAYOUT SHALL BE IN ACCORDANCE WITH SECTION 6 OF THE LATEST EDITION OF THE MANUAL ON UNIFORM TRAFFIC CONTROL DEVICES (MUTCD).
- CONSTRUCTION SIGNS SHALL BE IN NEW OR LIKE NEW CONDITION PER VAOT STANDARDS.
- DIAMOND SHAPED SIGNS SHALL BE 4' X 4' WITH BLACK LEGEND ON FLUORESCENT ORANGE BACKGROUND.
- RETROREFLECTIVE SHEETING SHALL BE TYPE VII OR BETTER.
- CONSTRUCTION ZONE SIGNS SHALL BE INSTALLED ON TWO POSTS EACH OR AS AN NCHRP 350 COMPLIANT SIGN/STAND SYSTEM.
- PORTABLE CHANGEABLE MESSAGE SIGNS ARE OPTIONAL AND ARE TO BE USED AS DIRECTED BY THE RESIDENT ENGINEER.
- PAYMENT FOR CONSTRUCTION SIGNING WILL BE MADE UNDER ITEM 641.10 TRAFFIC CONTROL.

NOT TO SCALE

**CONSTRUCTION
APPROACH
SIGNING
DETAIL SHEET**

PROJECT NAME: BRIDGEWATER_-_WOODSTOCK
PROJECT NUMBER: NH_2611(S)

FILE NAME: p06b160.dgn -- PLOT DATE: 28-MAY-2010
PROJECT LEADER: D.E.G. DRAWN BY: C.A.K.
DESIGNED BY: D.W.E. CHECKED BY: D.E.G.
IPARM FILE: p06b160cas.i SHEET 80 OF 80