


TYPICAL SECTION - PAVEMENT OVERLAY

MATERIAL ITEM	THICKNESS TOLERANCE
PAVEMENT COURSES (TOTAL DEPTH)	+/- 5


50	SURFACE COURSE, SUPERPAVE BITUMINOUS CONCRETE PAVEMENT, TYPE IIIS
15	LEVELING COURSE, SUPERPAVE BITUMINOUS CONCRETE PAVEMENT, TYPE IVS
SHOULDERS: 50	SURFACE COURSE, SUPERPAVE BITUMINOUS CONCRETE PAVEMENT, TYPE IIIS

NOTES:

- TOP 50 PAVEMENT COURSE (TYPE IIIS) SUPERPAVE BITUMINOUS CONCRETE PAVEMENT (ITEM 490.30), ON THE MAINLINE AND CROSSOVER TRAVEL WAY AND SHOULDERS, WILL BE CONSTRUCTED AS PART OF THIS CONTRACT. BASE & BINDER COURSES WERE COMPLETED UNDER PREVIOUS CONTRACTS AND THEREFORE NOT INCLUDED IN THIS CONTRACT.
- NB ϕ CARRIED AT LEFT FROM NB 8+958.0 TO 10+776.0.
- ANY DIMENSION NOTED AS "VARIES" IS REFERENCED TO ALIGNMENT PLANS/ SECTIONS FOR DETAIL.
- EMULSIFIED ASPHALT TO BE APPLIED ON EXISTING PAVEMENT, BETWEEN ALL COURSES OF SUPERPAVE BITUMINOUS CONCRETE PAVEMENT AND ON COLD PLANED SURFACES, AT THE RATE OF 0.068 Kg per m² OR AS DIRECTED BY THE ENGINEER.

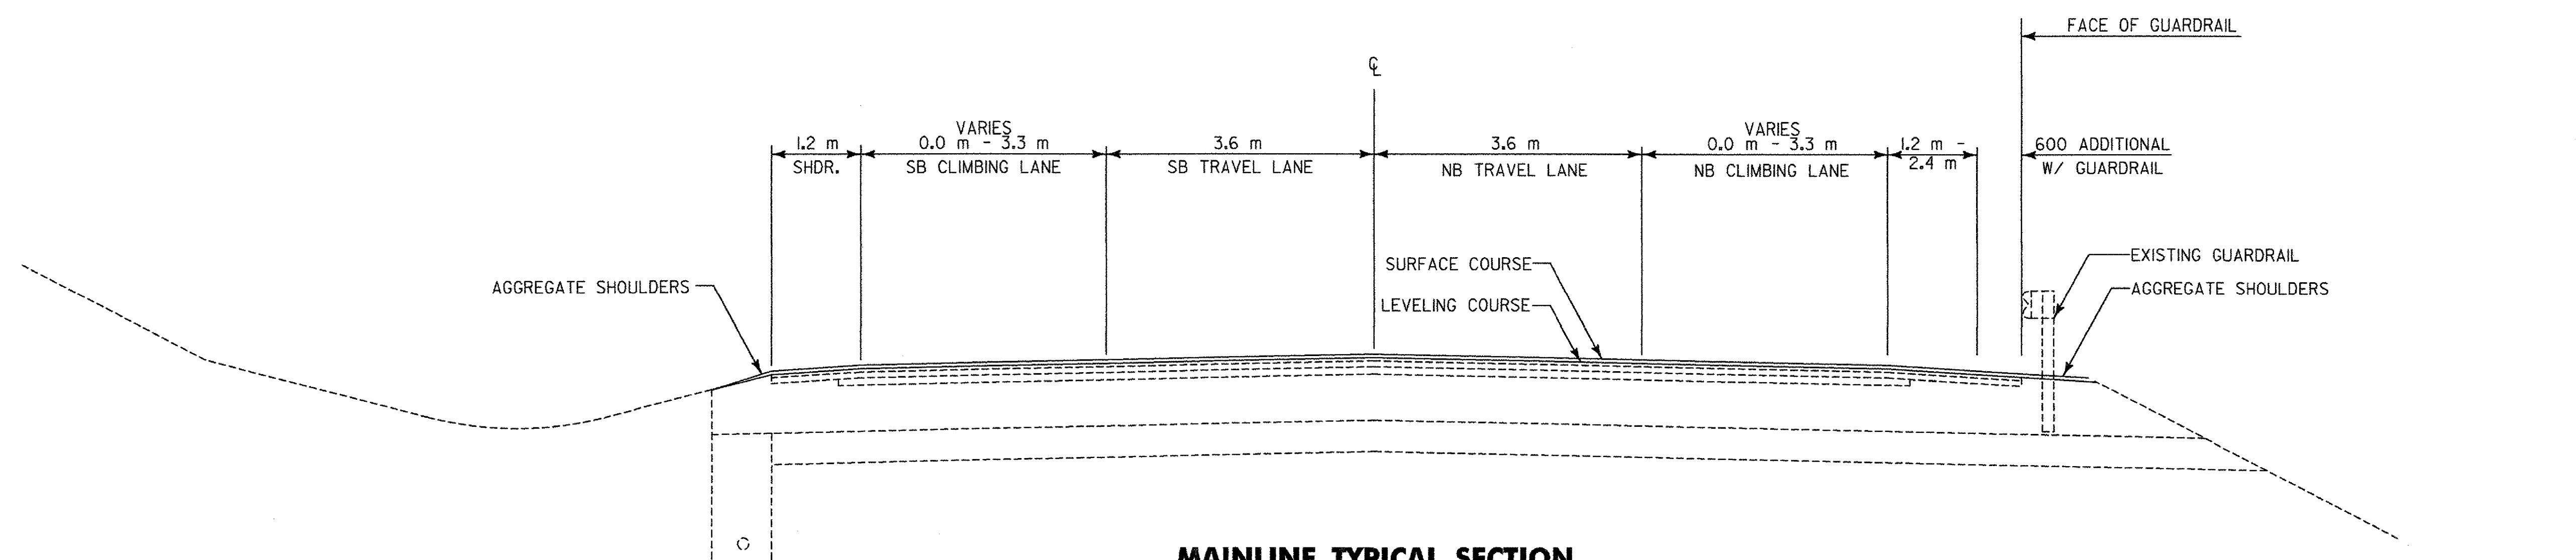

MAINLINE TYPICAL SECTION
STA. NB ~~6+540.000~~ - STA. NB ~~9+672.770~~
6+612.00 NOT TO SCALE 9+520.000

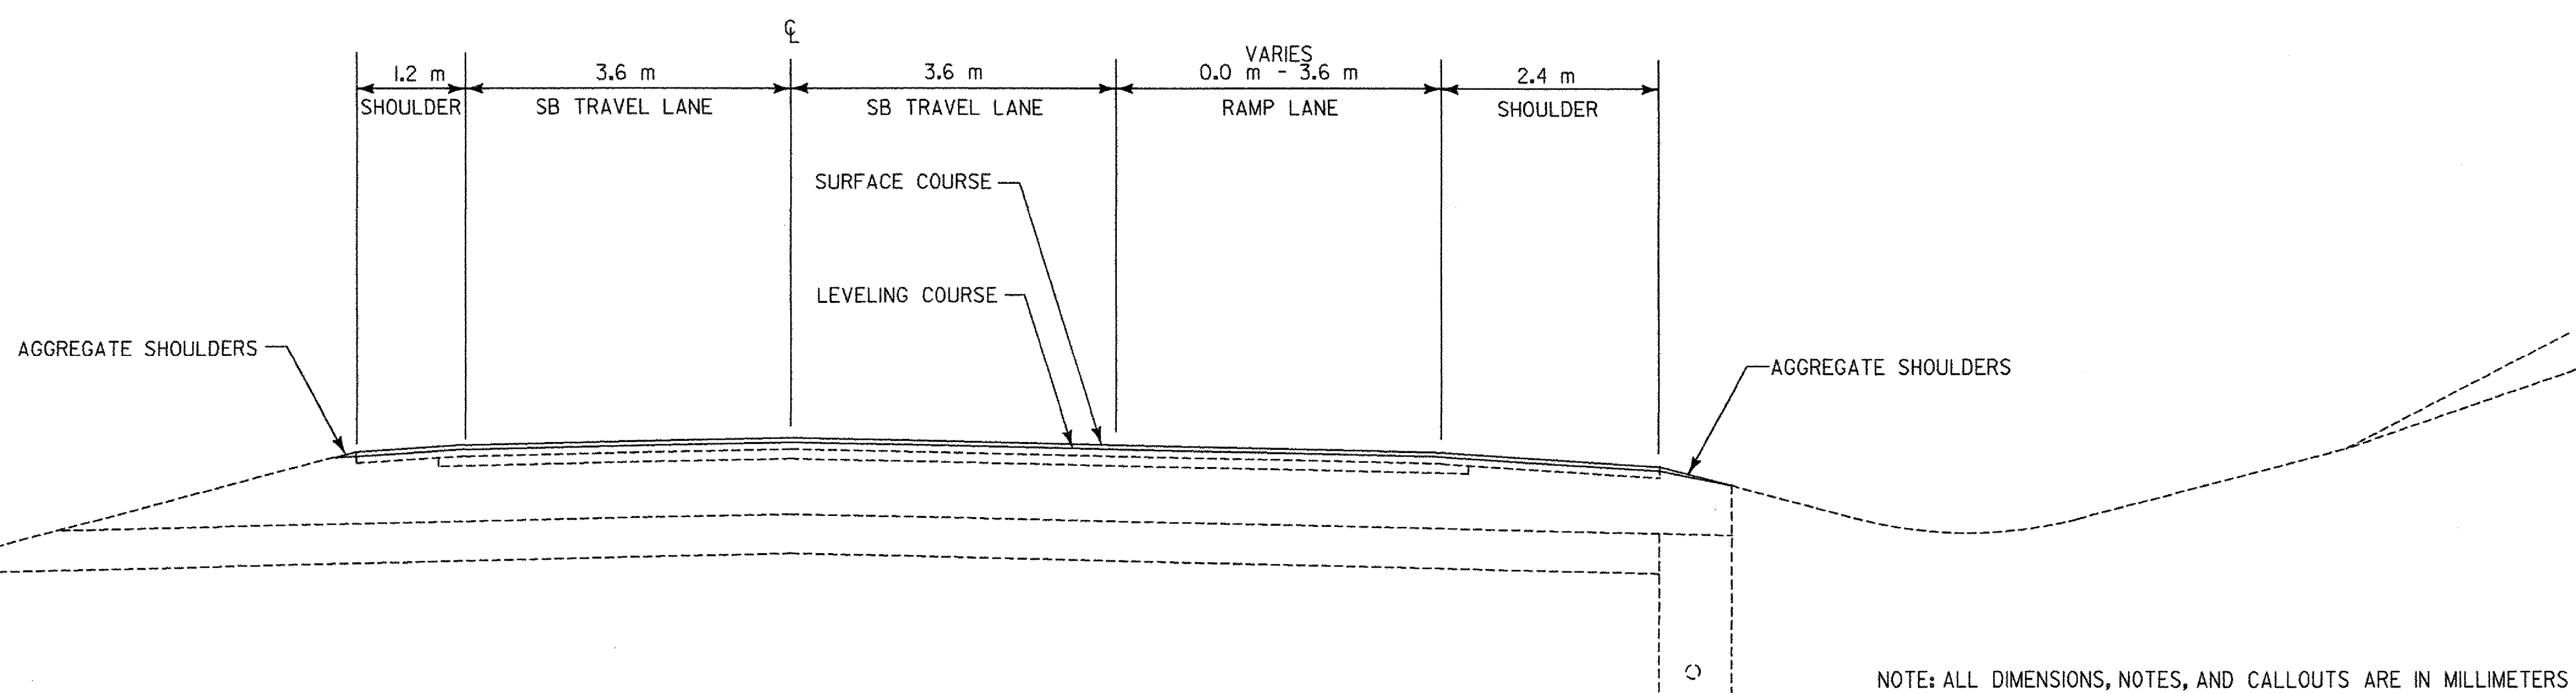

CROSSOVER TYPICAL SECTION
STA. XO 0+861.154 - STA. XO 1+578.825
 NOT TO SCALE

NOTE: ALL DIMENSIONS, NOTES, AND CALLOUTS ARE IN MILLIMETERS (mm) EXCEPT WHERE NOTED.

VERMONT AGENCY OF TRANSPORTATION



PROJECT NAME: BENNINGTON
 PROJECT NUMBER: AC NH 019-(K51)

FILE NAME: ...plot files\zd307c\typ.ppf PLOT DATE: 2/27/2009
 DESIGN SUPERVISOR: GREG EDWARDS DRAWN BY: STANTEC
 DESIGNED BY: MARC FOISY CHECKED BY: GARY SANTY
TYPICAL SECTIONS TS-01 SHEET 3 OF 367

v:\953\oct11\en\9530002\transportation\drawing\contract\plot files\zd307c\typ.ppf