

CURVE D2

Δ = 13°35'37.7" LT.
 R. = 1375.000m
 T. = 163.883m
 L. = 326.228m
 E. = 9.732m
 BANK = 0.020
 PI STA. D1+326.502
 N = 42897.6240
 E = 445165.6290
 PC N = 42739.9592
 E = 445210.3454
 PT N = 43040.3620
 E = 445085.1082

CURVE A2

Δ = 6°34'14.6" LT.
 R. = 1500.000m
 T. = 86.105m
 L. = 172.021m
 E. = 2.469m
 BANK = 0.020
 PI STA. A1+246.003
 N = 42803.8050
 E = 445136.2470
 PC N = 42720.4993
 E = 445158.0213
 PT N = 42884.0719
 E = 445105.0832

CURVE SB5

Δ = 60°16'16.5" LT.
 R. = 1820.000m
 T. = 1056.530m
 L. = 1914.516m
 E. = 284.437m
 BANK = 0.032
 PI STA. SB5+743.932
 N = 42277.9017
 E = 445532.0537
 PCC N = 41350.4354
 E = 445026.0287
 PT N = 43177.2504
 E = 444977.5929

CURVE NB5


Δ = 55°24'30.7" LT.
 R. = 1900.000m
 T. = 997.703m
 L. = 1837.417m
 E. = 246.022m
 BANK = 0.032
 PI STA. NB5+733.330
 N = 42266.8841
 E = 445508.4114
 PCC N = 41372.0092
 E = 445067.2651
 PT N = 43138.0842
 E = 445022.1796

DATUM

VERTICAL	NAVD 88
HORIZONTAL	NAD 83 (1992)

LINES SHOWN ON THIS PLAN AS EXISTING PROPERTY LINES P/L ARE BELIEVED TO BE ACCURATE BUT SHOULD NOT BE RELIED UPON FOR PURPOSES UNRELATED TO THE STATE OF VERMONT'S ACQUISITION OF LAND AND RIGHTS FOR THIS PROJECT.

THIS SHEET TO BE USED FOR RIGHT-OF-WAY INFORMATION ONLY

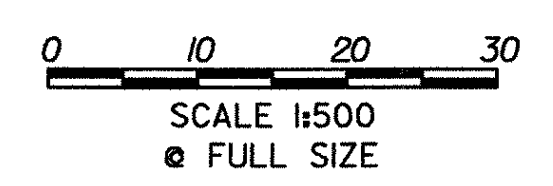

R.O.W. PLAN ROW-6	PROJECT NAME: BENNINGTON	PROJECT NUMBER: AC NH 019-1(51)
	DESIGN FILE NAME: c:\ndh\bennington\row	PLOT DATE: 1-26-09
	PROJECT LEADER: JDP	DRAWN BY: MBB CHECKED BY: GAK
SHEET: 32 OF 367		