



### MAINLINE TIE DATA

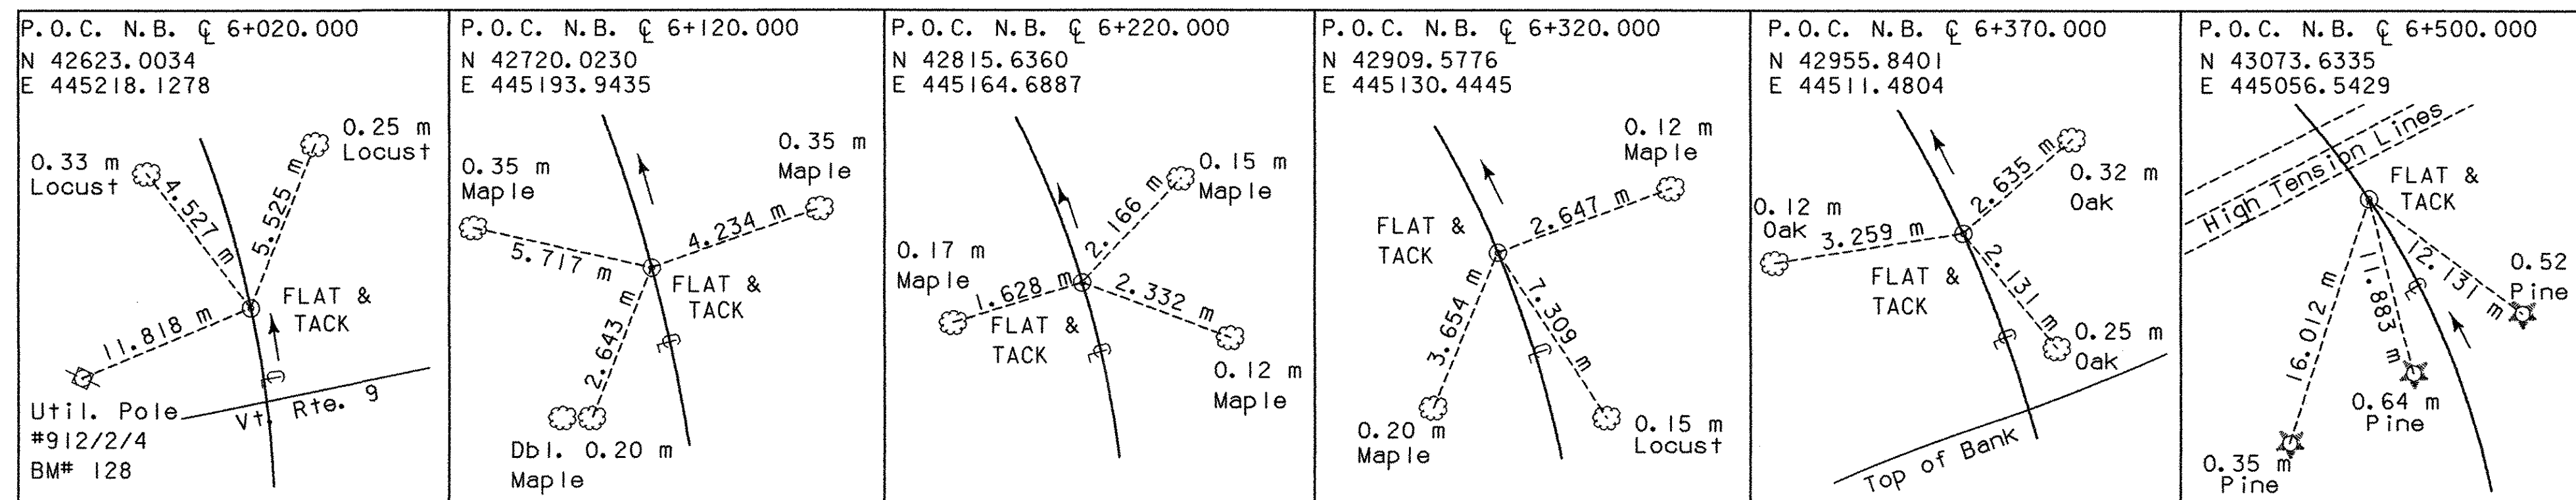

### G.P.S. TIE DATA

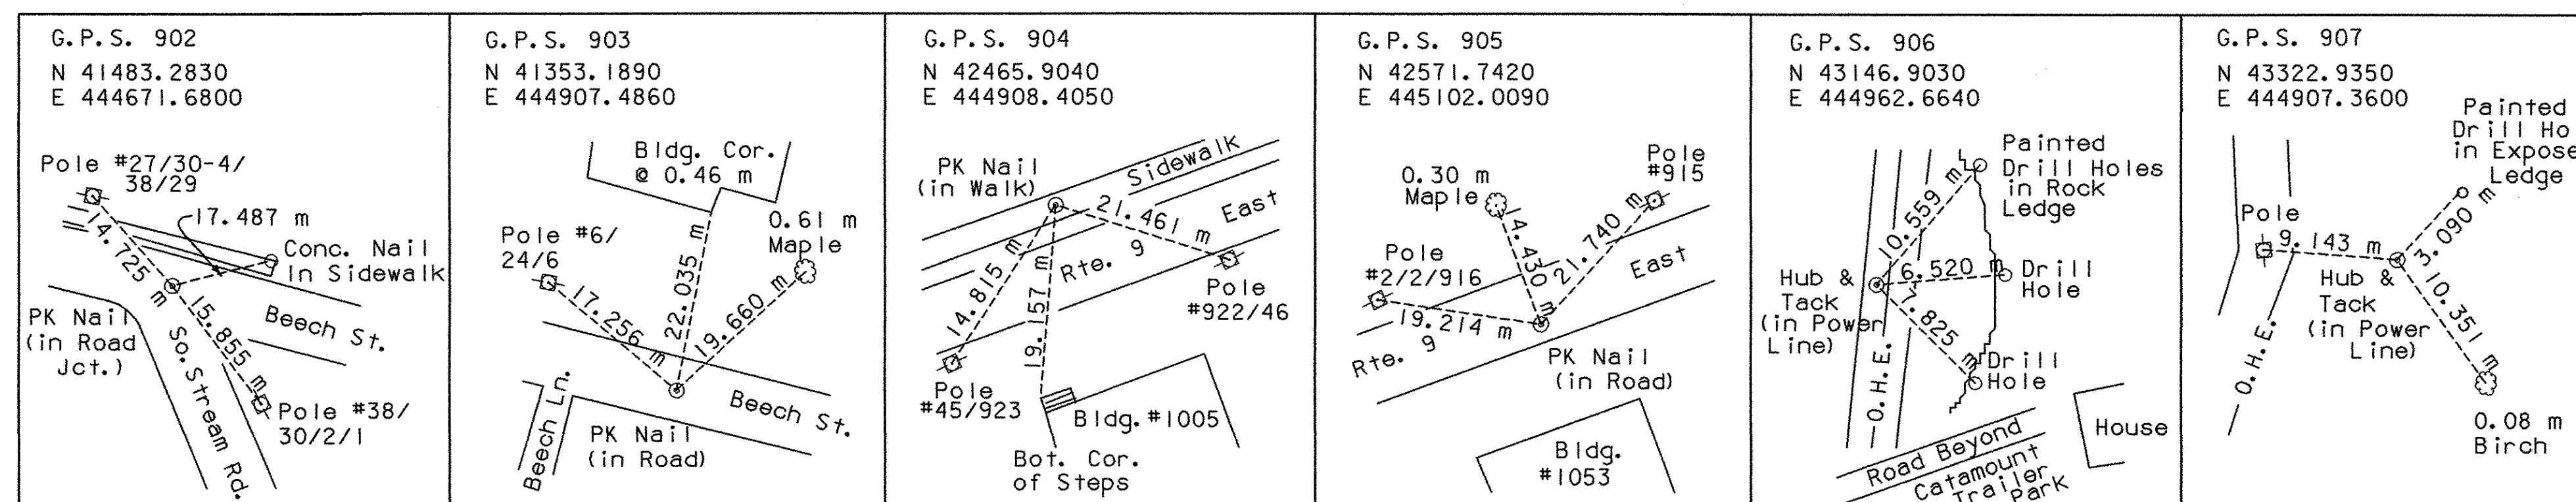

V:\953\active\9530002\transportation\drawing\contractor\plot\_files\z4307cties.prf

<b>VERMONT AGENCY OF TRANSPORTATION</b>	
	PROJECT NAME: BENNINGTON PROJECT NUMBER: AC NH 019-(51)
	FILE NAME: ...plot_files\z4307cties.prf PLOT DATE: 1/30/2009 DESIGN SUPERVISOR: GREG EDWARDS DRAWN BY: STANTEC DESIGNED BY: MARC FOISY CHECKED BY: GARY SANTY <b>CONTROL TIE SHEET CT-01</b> SHEET 40 OF 367