
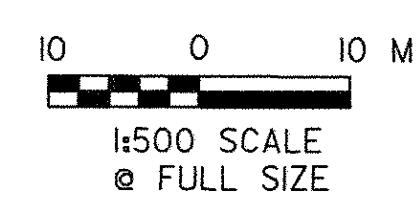


CURVE NB7	
Δ	= 90° 45' 02.2" LT
R.	= 575.000m
T.	= 582.583m
L.	= 910.741m
E.	= 243.552m
BANK	= 0.078
PI STA.	NB 8+360.674
N	= 44859.7020
E	= 444732.6710
PC STA.	NB 7+778.091
N	= 44277.1693
E	= 444725.0391
PT STA.	NB 8+688.832
N	= 44859.7019
E	= 444150.0883

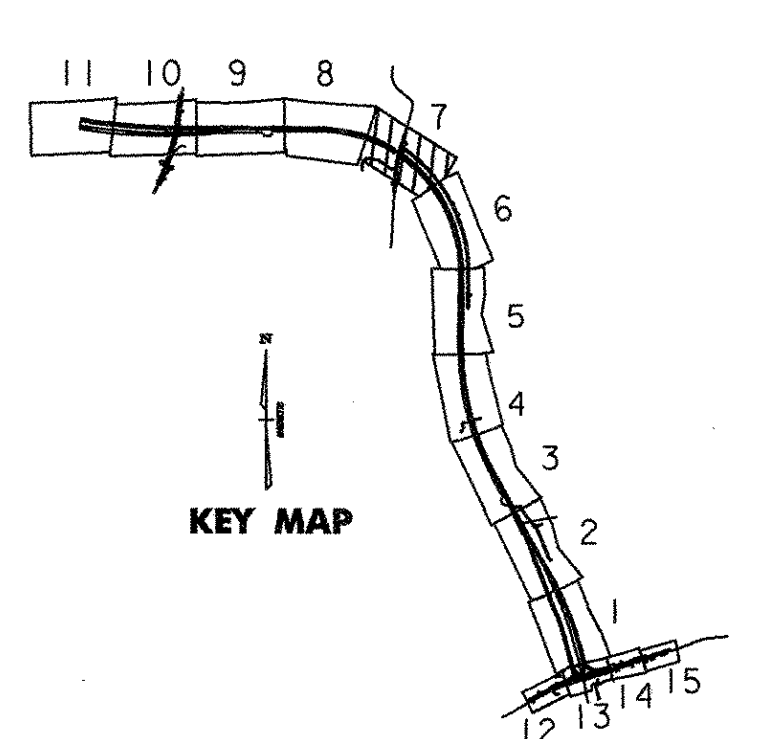

VERMONT AGENCY OF TRANSPORTATION	
	PROJECT NAME: BENNINGTON
	PROJECT NUMBER: AC NH 019-(K51)
FILE NAME: ...vd307clalg_plans_500.pptf	PLOT DATE: 2/2/2009
DESIGN SUPERVISOR: GREG EDWARDS	DRAWN BY: STANTEC
DESIGNED BY: MARC FOISY	CHECKED BY: GARY SANTY
ALIGNMENT PLAN A-07	SHEET 47 OF 367

v:\953\active\9530002\transportation\drawing\contract\plot_files\vd307clalg_plans_500.pptf