
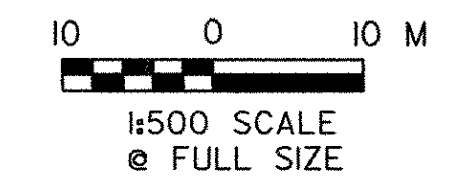


MATCH LINE
STA. NB 8+500
SEE SHEET A-07

MATCH LINE STA. NB 8+840,
SEE SHEET A-09

CURVE NB7	
Δ	= 90° 45' 02.2" LT.
R.	= 575.000m
T.	= 582.583m
L.	= 910.741m
E.	= 243.552m
BANK	= 0.078
PI STA. NB	8+360.674
N	= 44859.7020
E	= 444732.6710
PC STA. NB	7+778.091
N	= 44277.1693
E	= 444725.0391
PT STA. NB	8+688.832
N	= 44859.7019
E	= 444150.0883

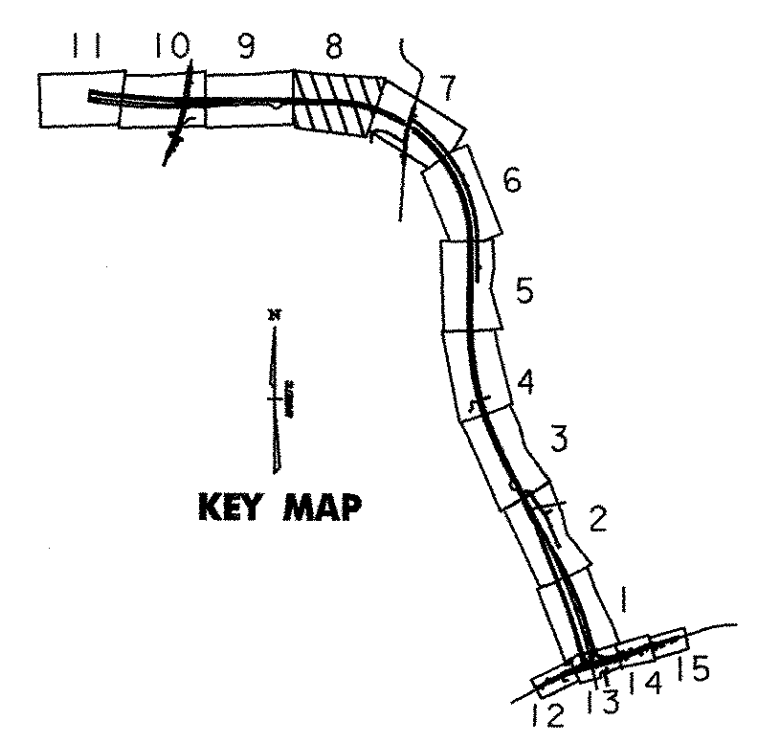

VERMONT AGENCY OF TRANSPORTATION



PROJECT NAME:	BENNINGTON	DESIGN SUPERVISOR:	GREG EDWARDS	FILE NAME:	...vzd307clalg_plans_500.ppt	PLOT DATE:	1/30/2009
PROJECT NUMBER:	AC NH 019-(K51)	DESIGNED BY:	MARC FOISY	DRAWN BY:	STANTEC	CHECKED BY:	GARY SANTY
ALIGNMENT PLAN A-08						SHEET 48 OF 367	

V:\953\active\95310002\transportation\drawing\contract_A\plot_files\z307clalg_plans_500.ppt