


POC STA. NB 6+013.726 =  
 POT STA. VT 1+444.106

**STA. NB 6+082.145**  
**BEGIN PROJECT AC NH 019-1(51)**

PVI NB 5+894.000  
 ELEV= 263.671  
 L = 203.538 m  
 M.O. = 0.656  
 K = 79

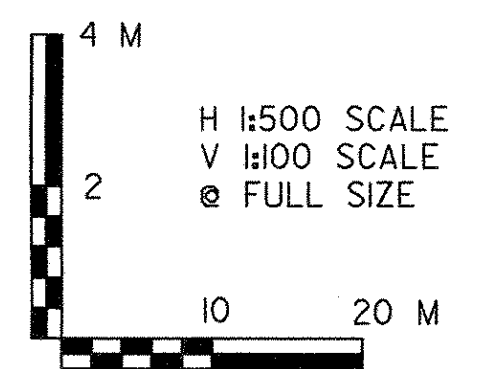

**VERMONT AGENCY OF TRANSPORTATION**

PROJECT NAME: BENNINGTON  
 PROJECT NUMBER: AC NH 019-1(51)

FILE NAME: ...vd307clpro\_m\_01.plt  
 DESIGN SUPERVISOR: GREG EDWARDS  
 DESIGNED BY: MARC FOISY  
**NORTHBOUND - PR-01**

PLOT DATE: 2/2/2009  
 DRAWN BY: STANTEC  
 CHECKED BY: GARY SANTY  
 SHEET 56 OF 367

va\1953\active\19530002\transportation\drawing\contract\_in\plot\_files\vd307clpro\_m\_01.plt