


NOTES:
 1. STA. A 1+460.000 - STA A 1+760.000 EXISTING GRADES SHOWN AS CONSTRUCTED UNDER PROJECT AC NH 019-1 (52)
 2. STA A 1+563.423 - STA A 1+760.000 FINISH GRADES ARE SHOWN 50 MM ABOVE EXISTING GRADES.
 3. SUPERELEVATION TO MATCH THE CROSS SLOPE AS CONSTRUCTED UNDER AC NH 019-1 (52)



VERMONT AGENCY OF TRANSPORTATION

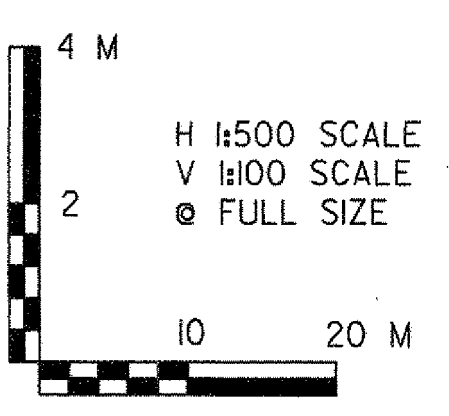

PROJECT NAME: BENNINGTON
 PROJECT NUMBER: AC NH 019-1(51)
 FILE NAME: ...zd307clpro_ramp.d.ppf PLOT DATE: 2/2/2009
 DESIGN SUPERVISOR: GREG EDWARDS DRAWN BY: STANTEC
 DESIGNED BY: MARC FOISY CHECKED BY: GARY SANTY
 RAMP A - PR-05 SHEET 60 OF 367

V:\1953\ref\19530002\transportation\drawing\contract\1\plot_files\zd307clpro_ramp.d.ppf